

AS-BUILT APRIL 2007

**MKEC**  
ENGINEERING  
CONSULTANTS, INC.  
411 N. WEBB ROAD  
WICHITA, KS. 67206  
316-684-9600


SANITARY SEWER PLANS FOR  
**SALVATION ARMY**  
HIAWATHA CAMPUS

**LINE 1**  
SHEET TITLE  
PROJECT NUMBER  
06635

ISSUED  
December 2006  
DESIGN BY  
DM  
DRAWN BY  
MAB  
CHECKED BY

REVIS  
2/28/07 PROFILE RAISE 2'  
REMOVE FLOWABLE FILL


SHEET NO.  
6 of 10

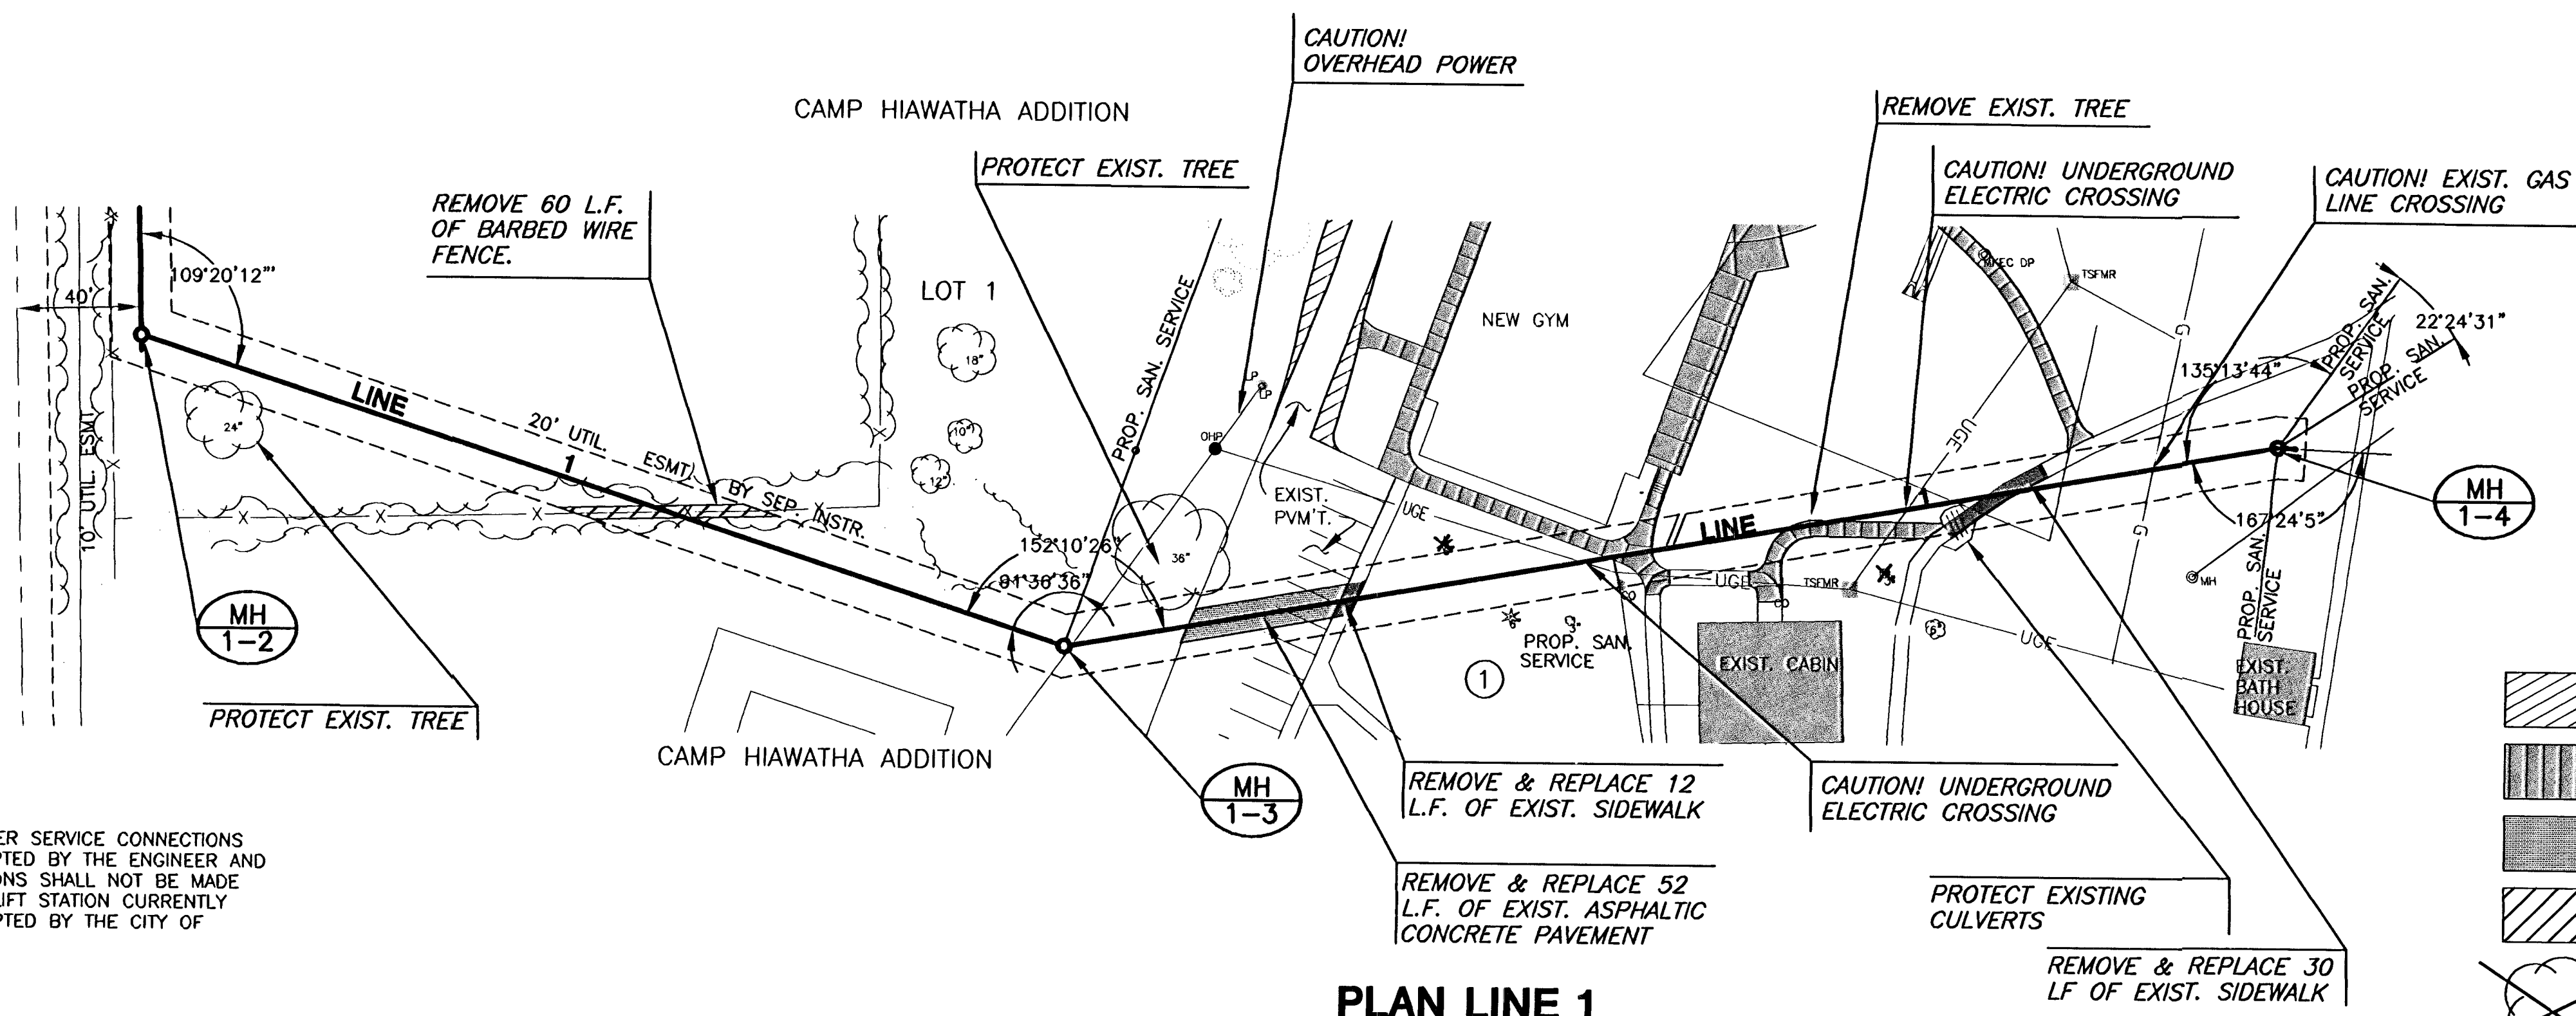

PLAN LINE 1

PROFILE LINE 1

SCALE: HORIZ. 1"=40'  
SCALE: VERT. 1"=6'

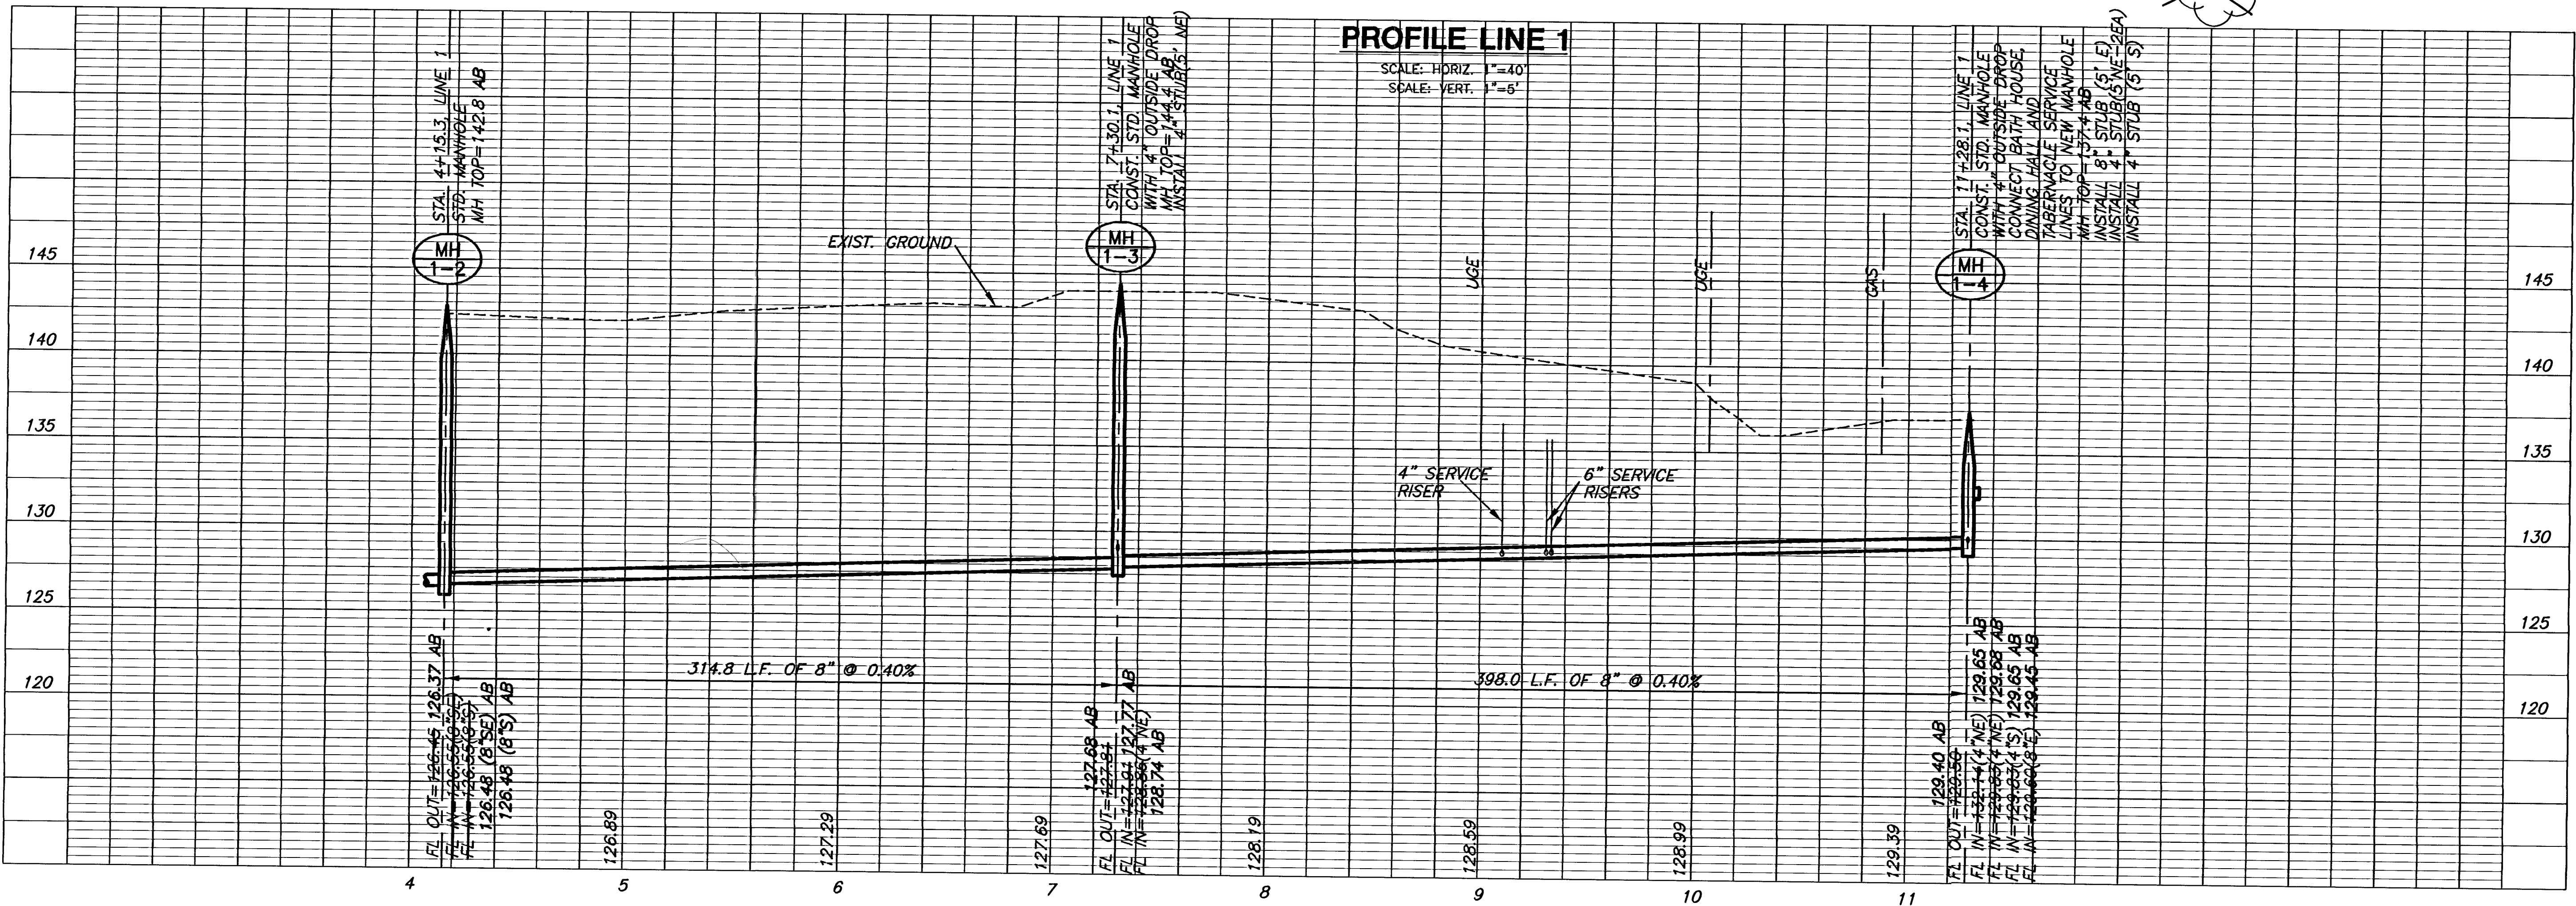

J:\CWL\06635\DWG\SAN\AS-BUILT\06635B2.DWG

PLOTTED: Wednesday, April 04, 2007 9:06:00AM