


9TH & GROVE SIGNAL PLAN
1"=10'

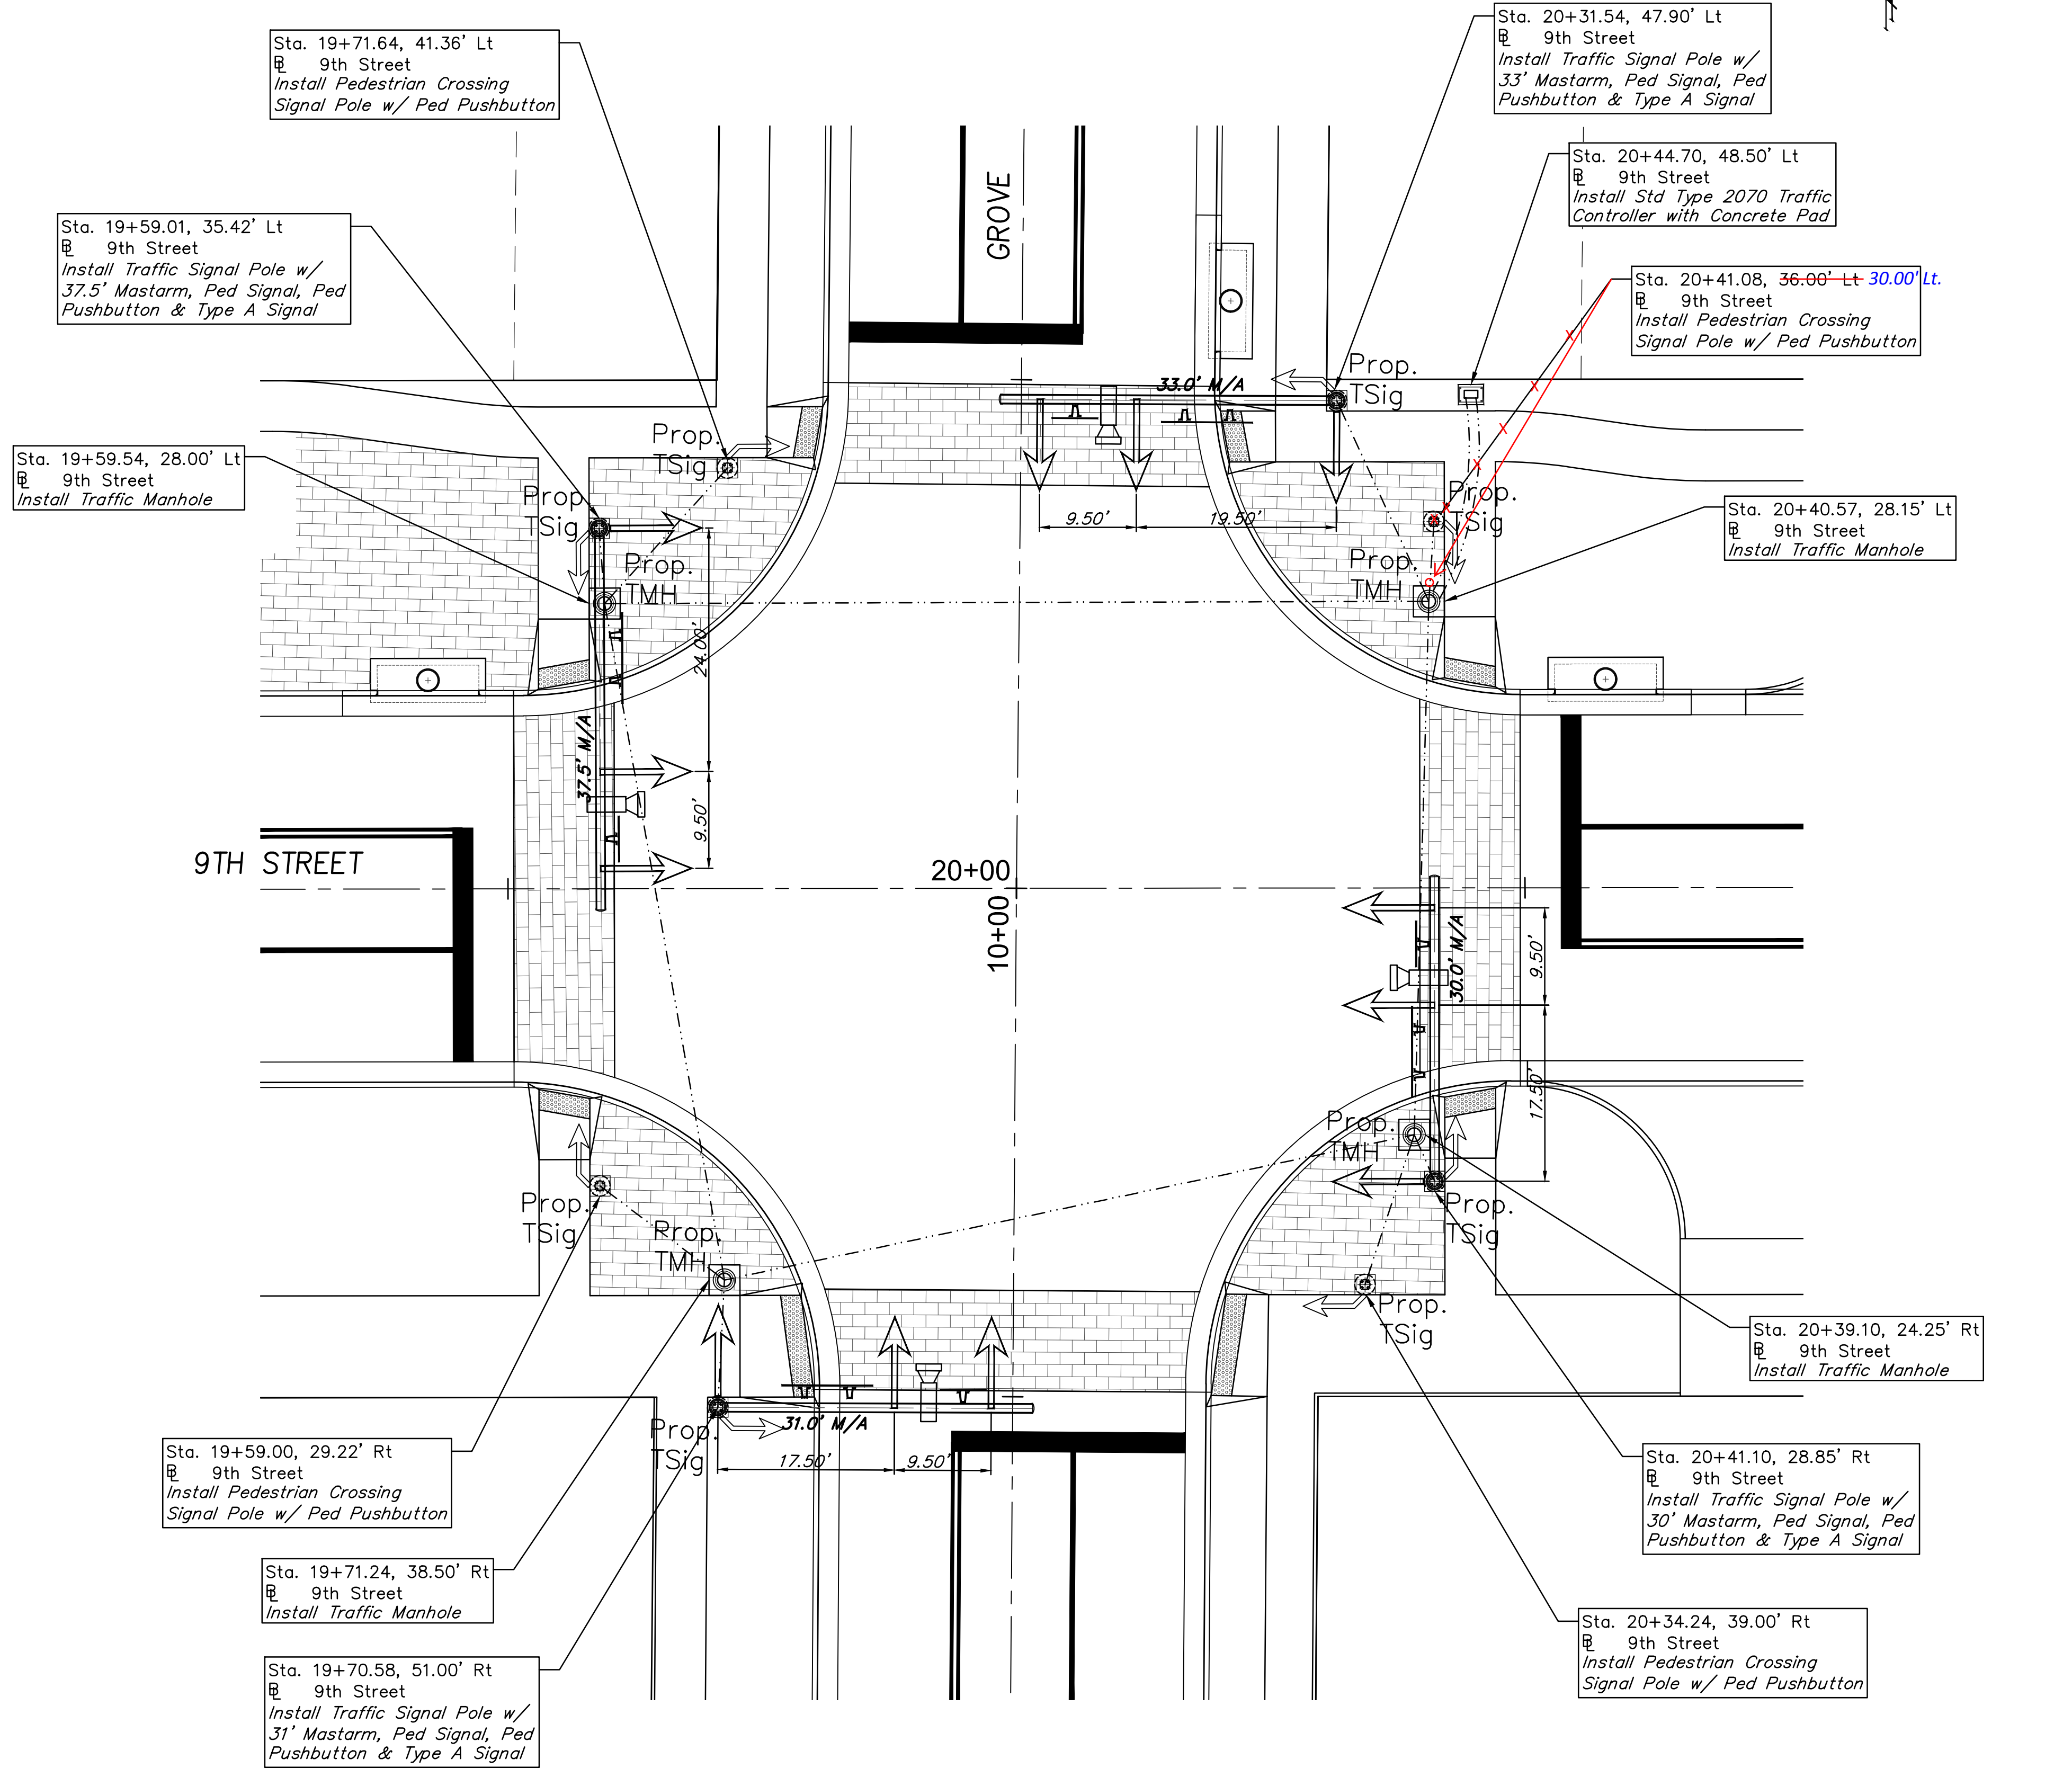


NOTE: See Signal Details for Installation of Traffic Structures

SCALE: 1" = 10'
0 10

Sims Electric - Contractor
G. Baalman - City of Wichita, Field Project Engineer
S. May - City of Wichita, Inspector
As-built
Release Date: 7/12/2018
pdf: 1/17/2019 apr

SCALE: 1" = 8'
0 8

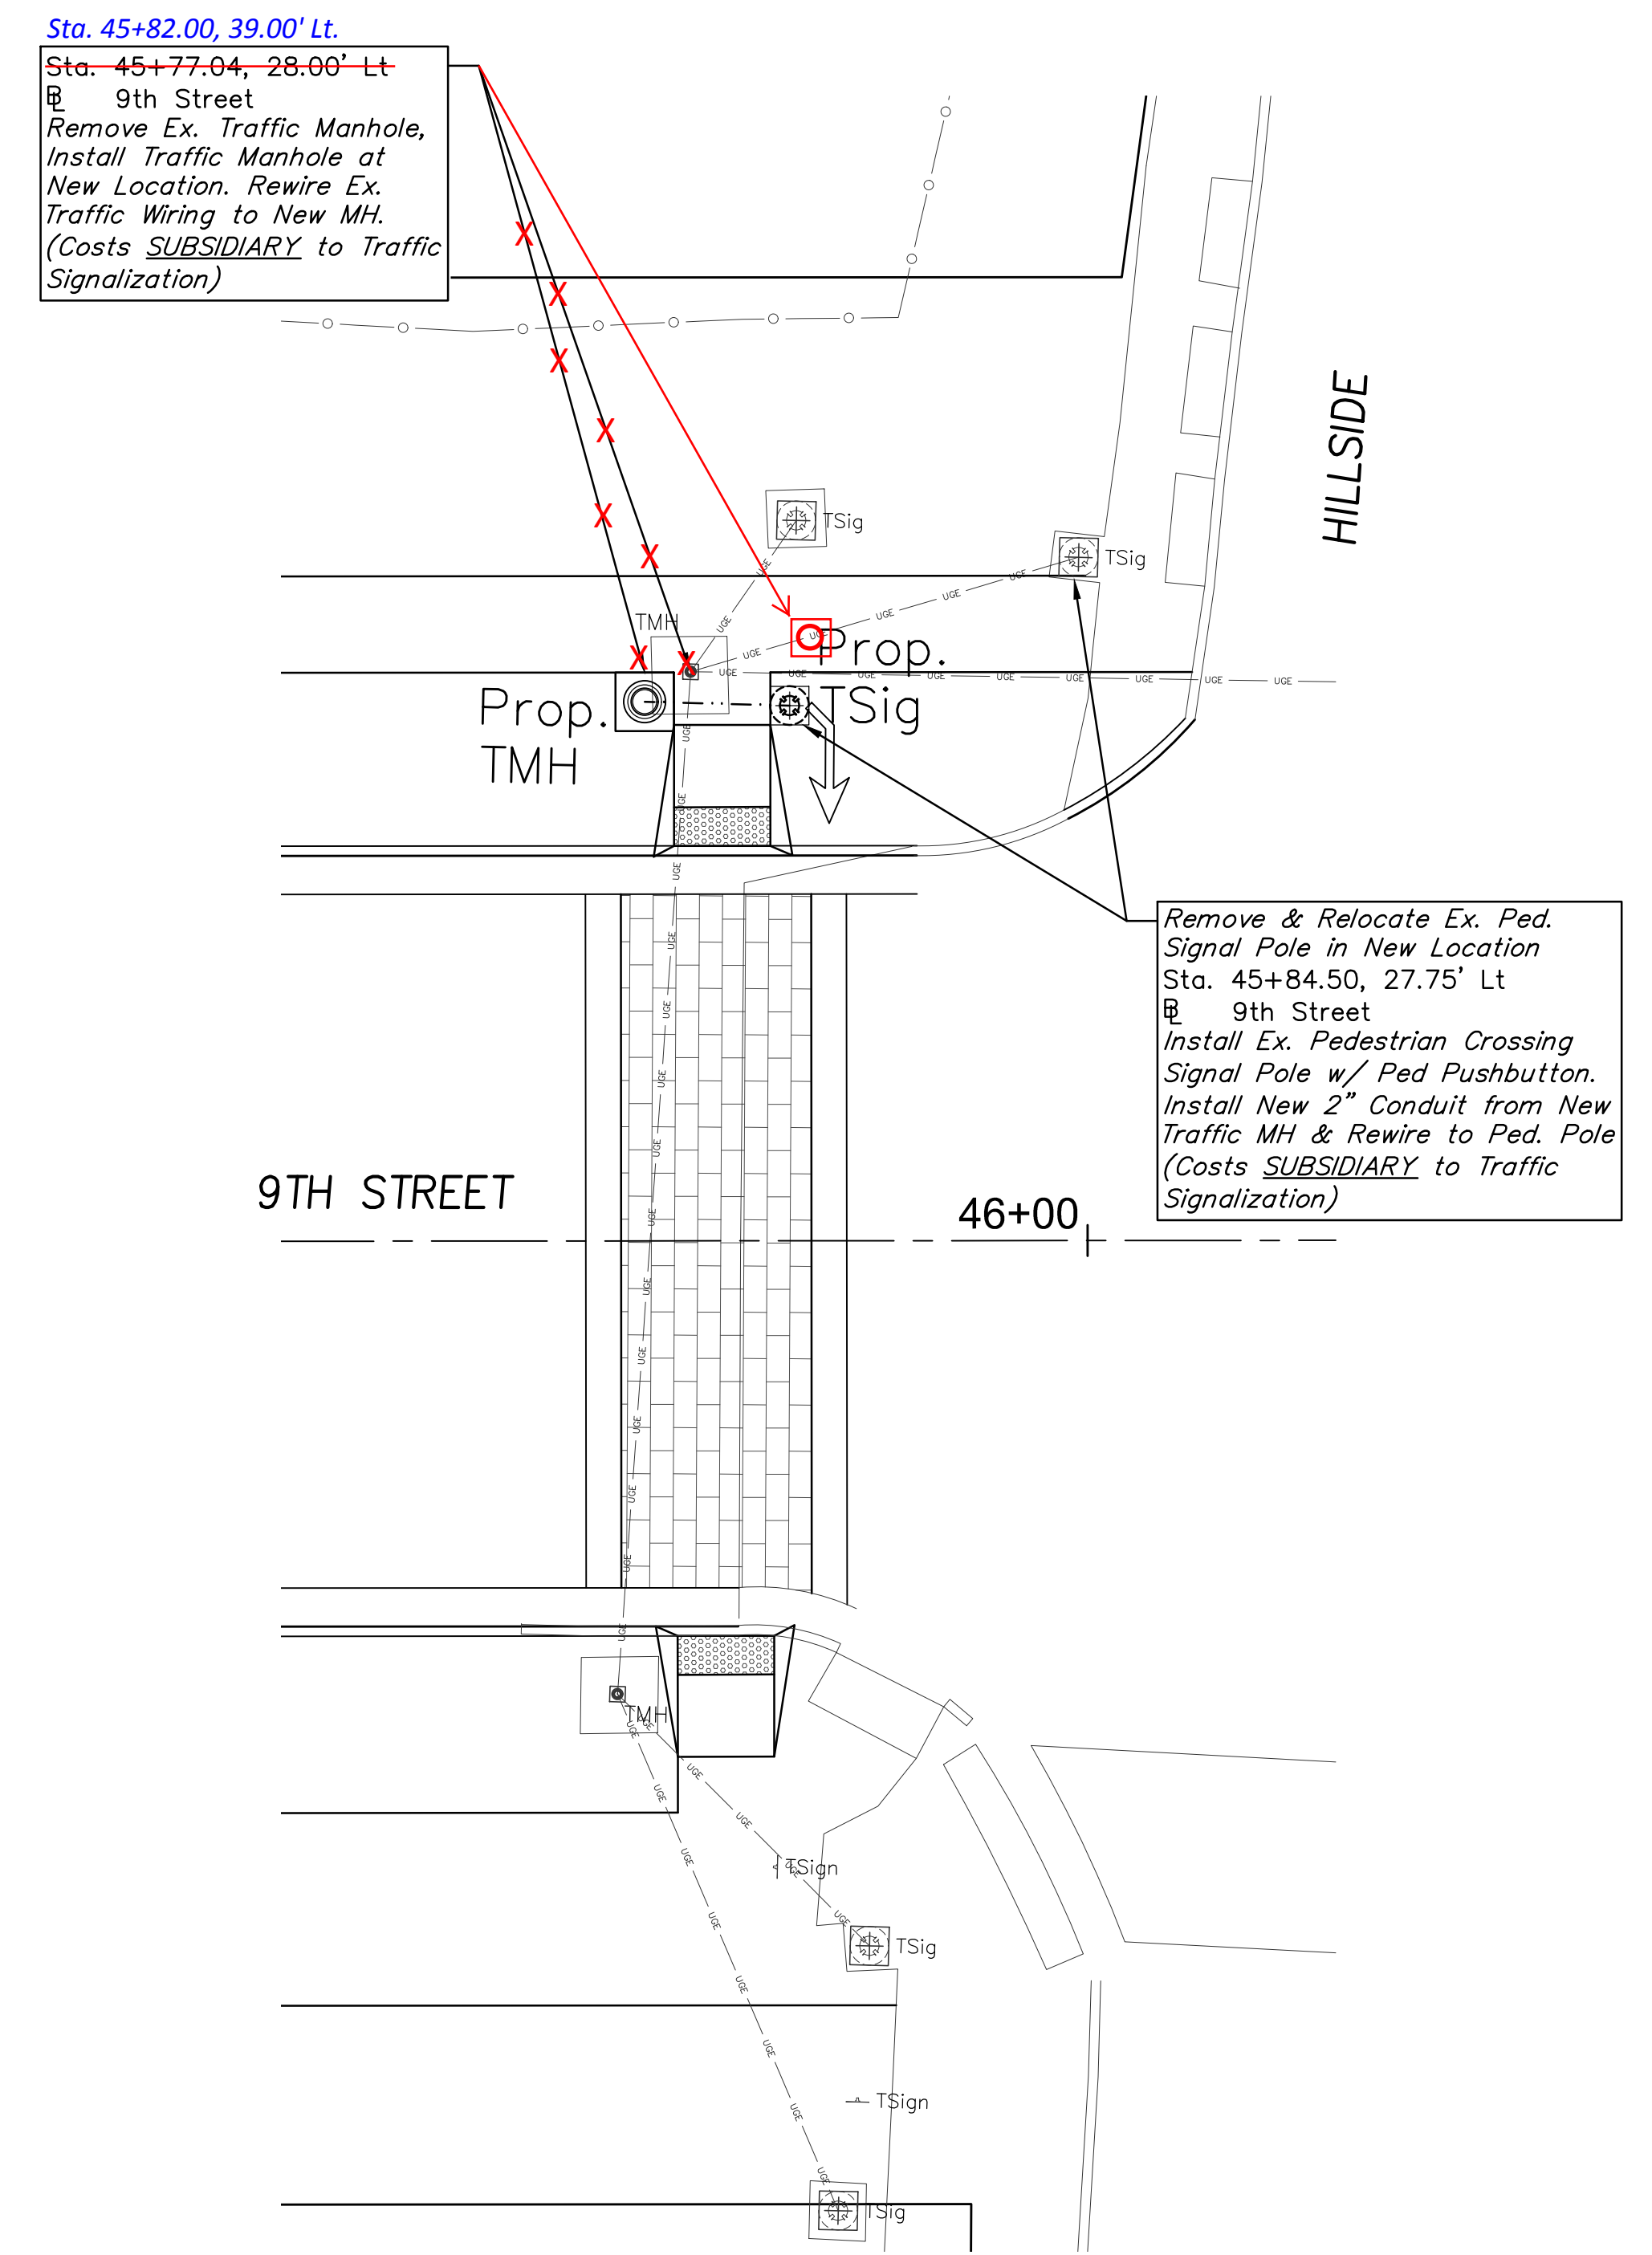

9TH & HILLSIDE SIGNAL RELOCATION
1"=8'