




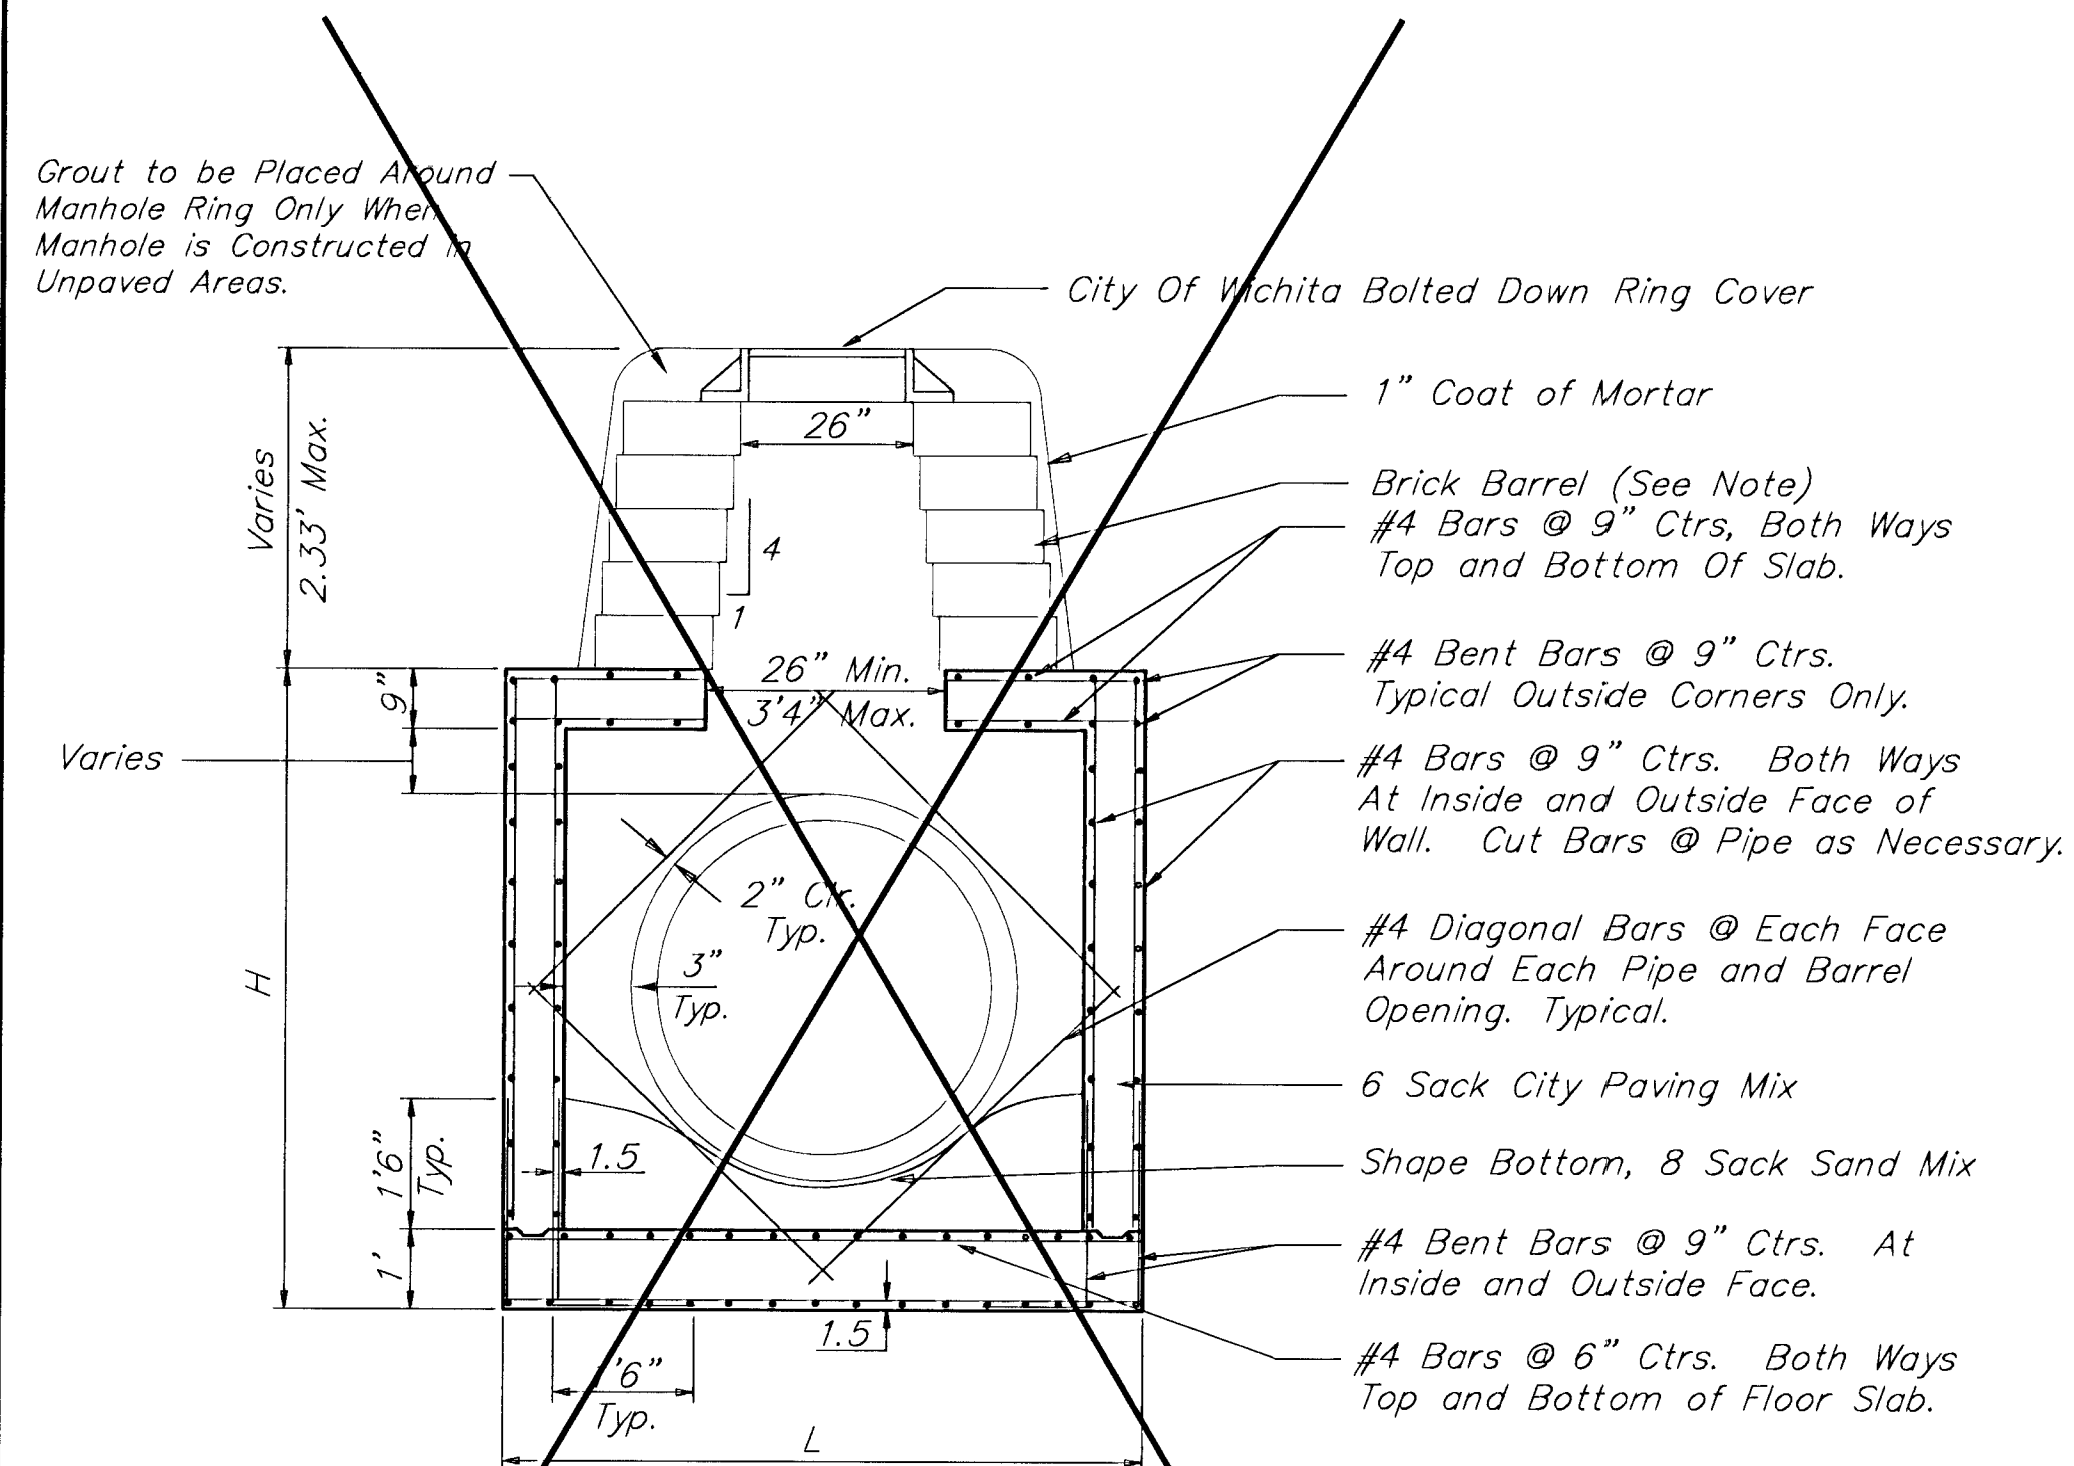


~~REINFORCED CONCRETE MANHOLE~~
~~DEPTH OF STACK: 0' TO 2.33'~~

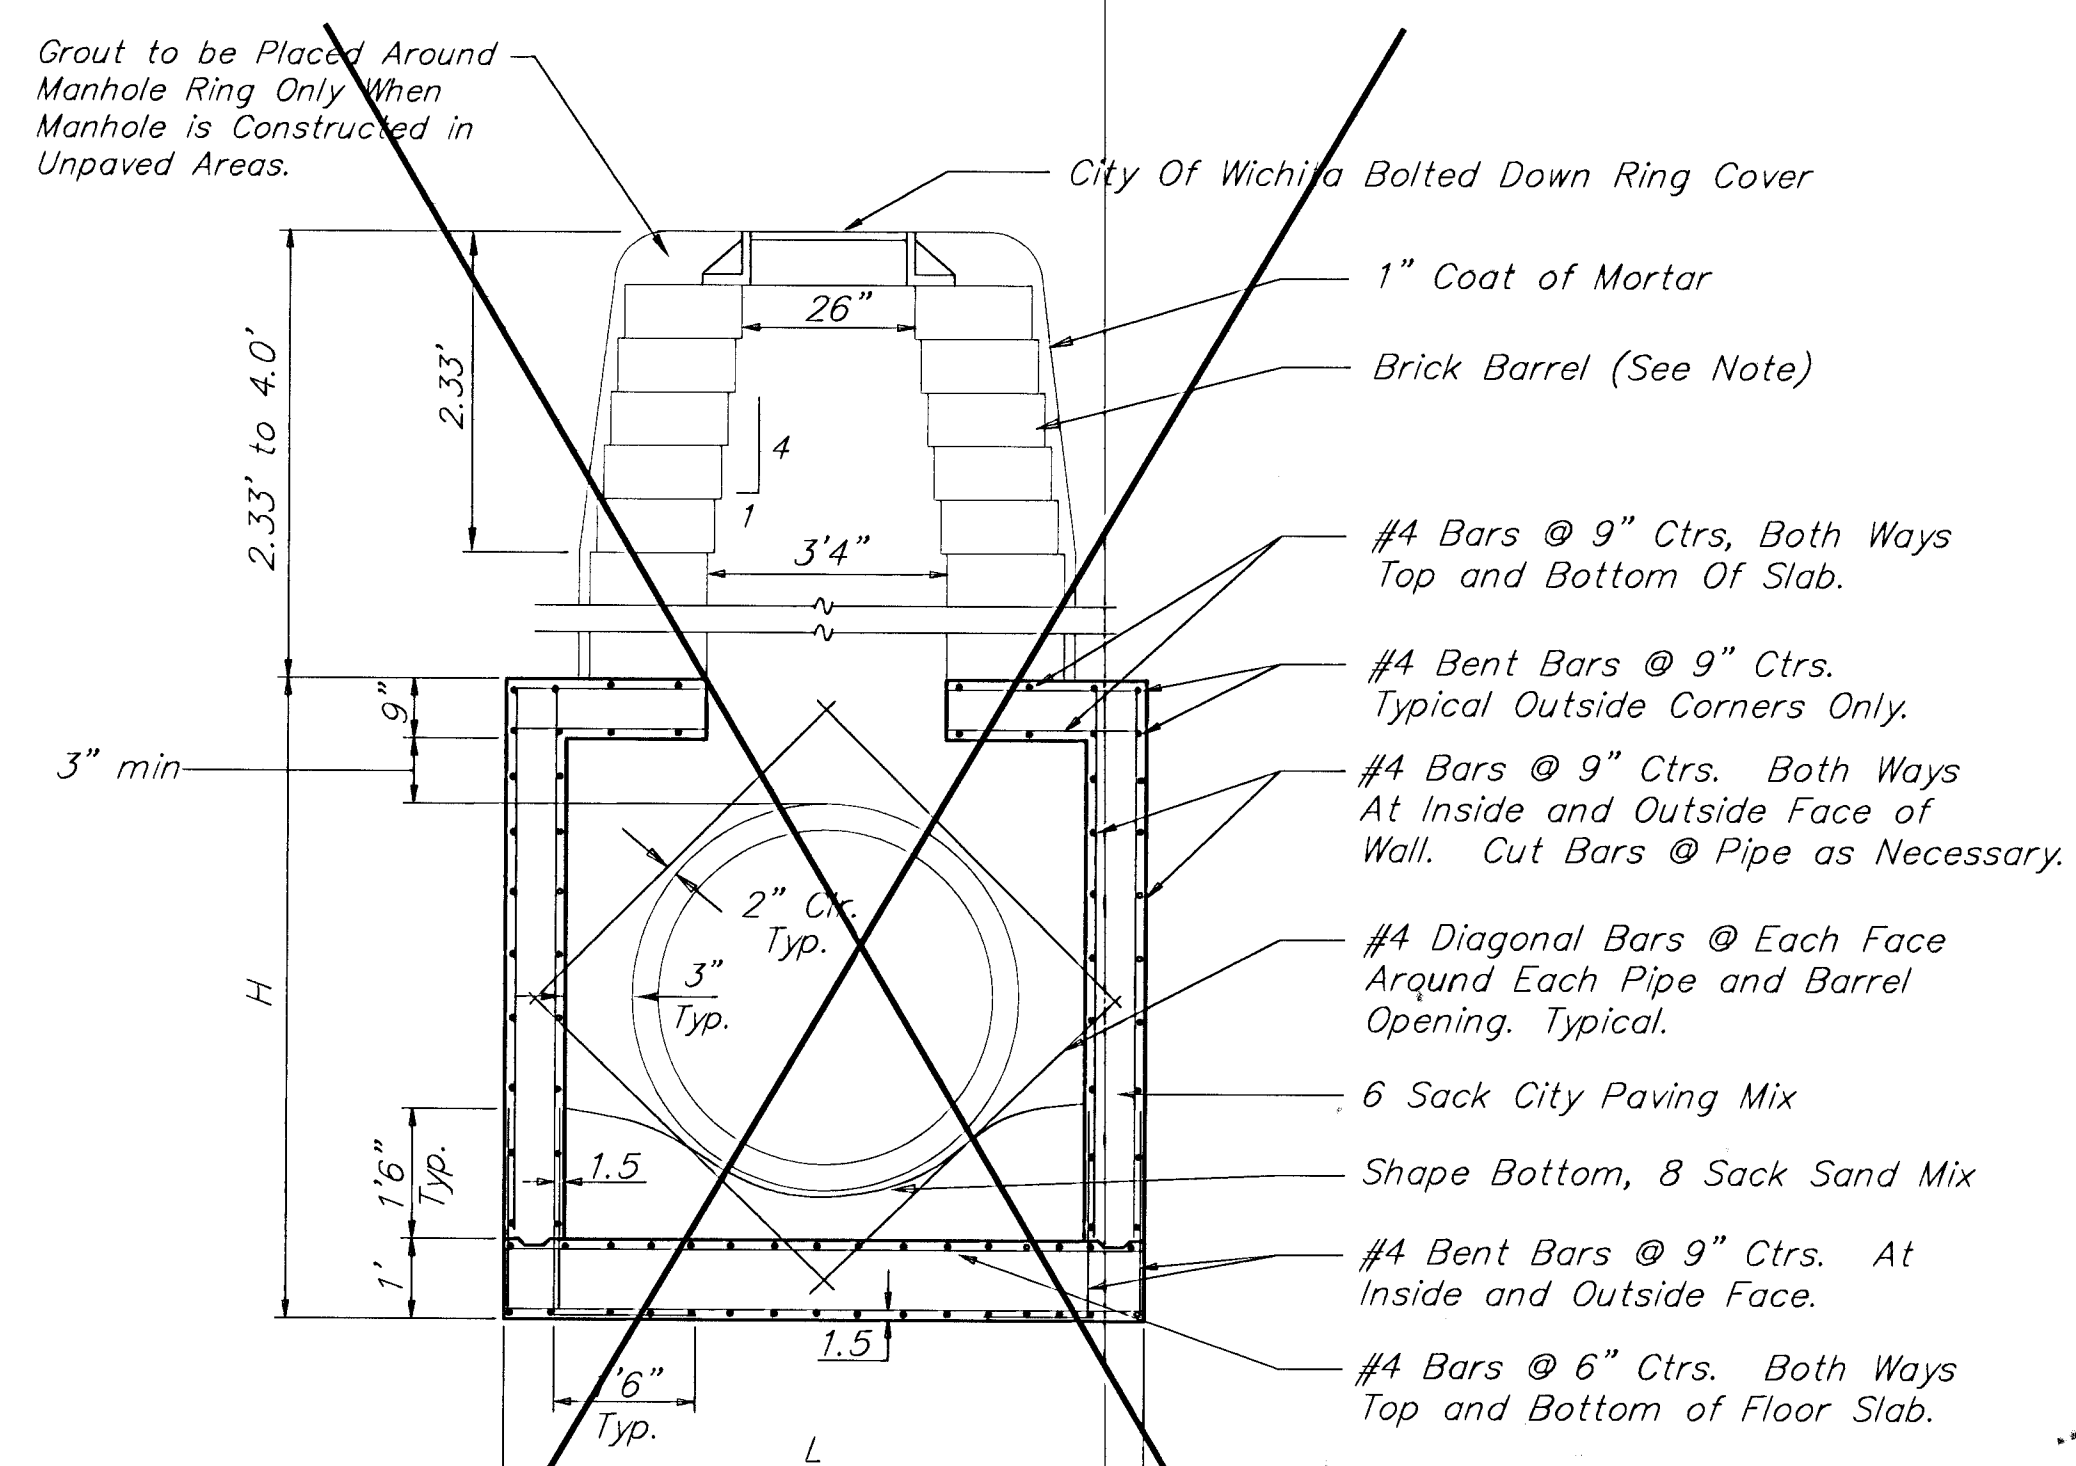


~~REINFORCED CONCRETE MANHOLE~~
~~DEPTH OF STACK: 2.33' TO 4.0'~~

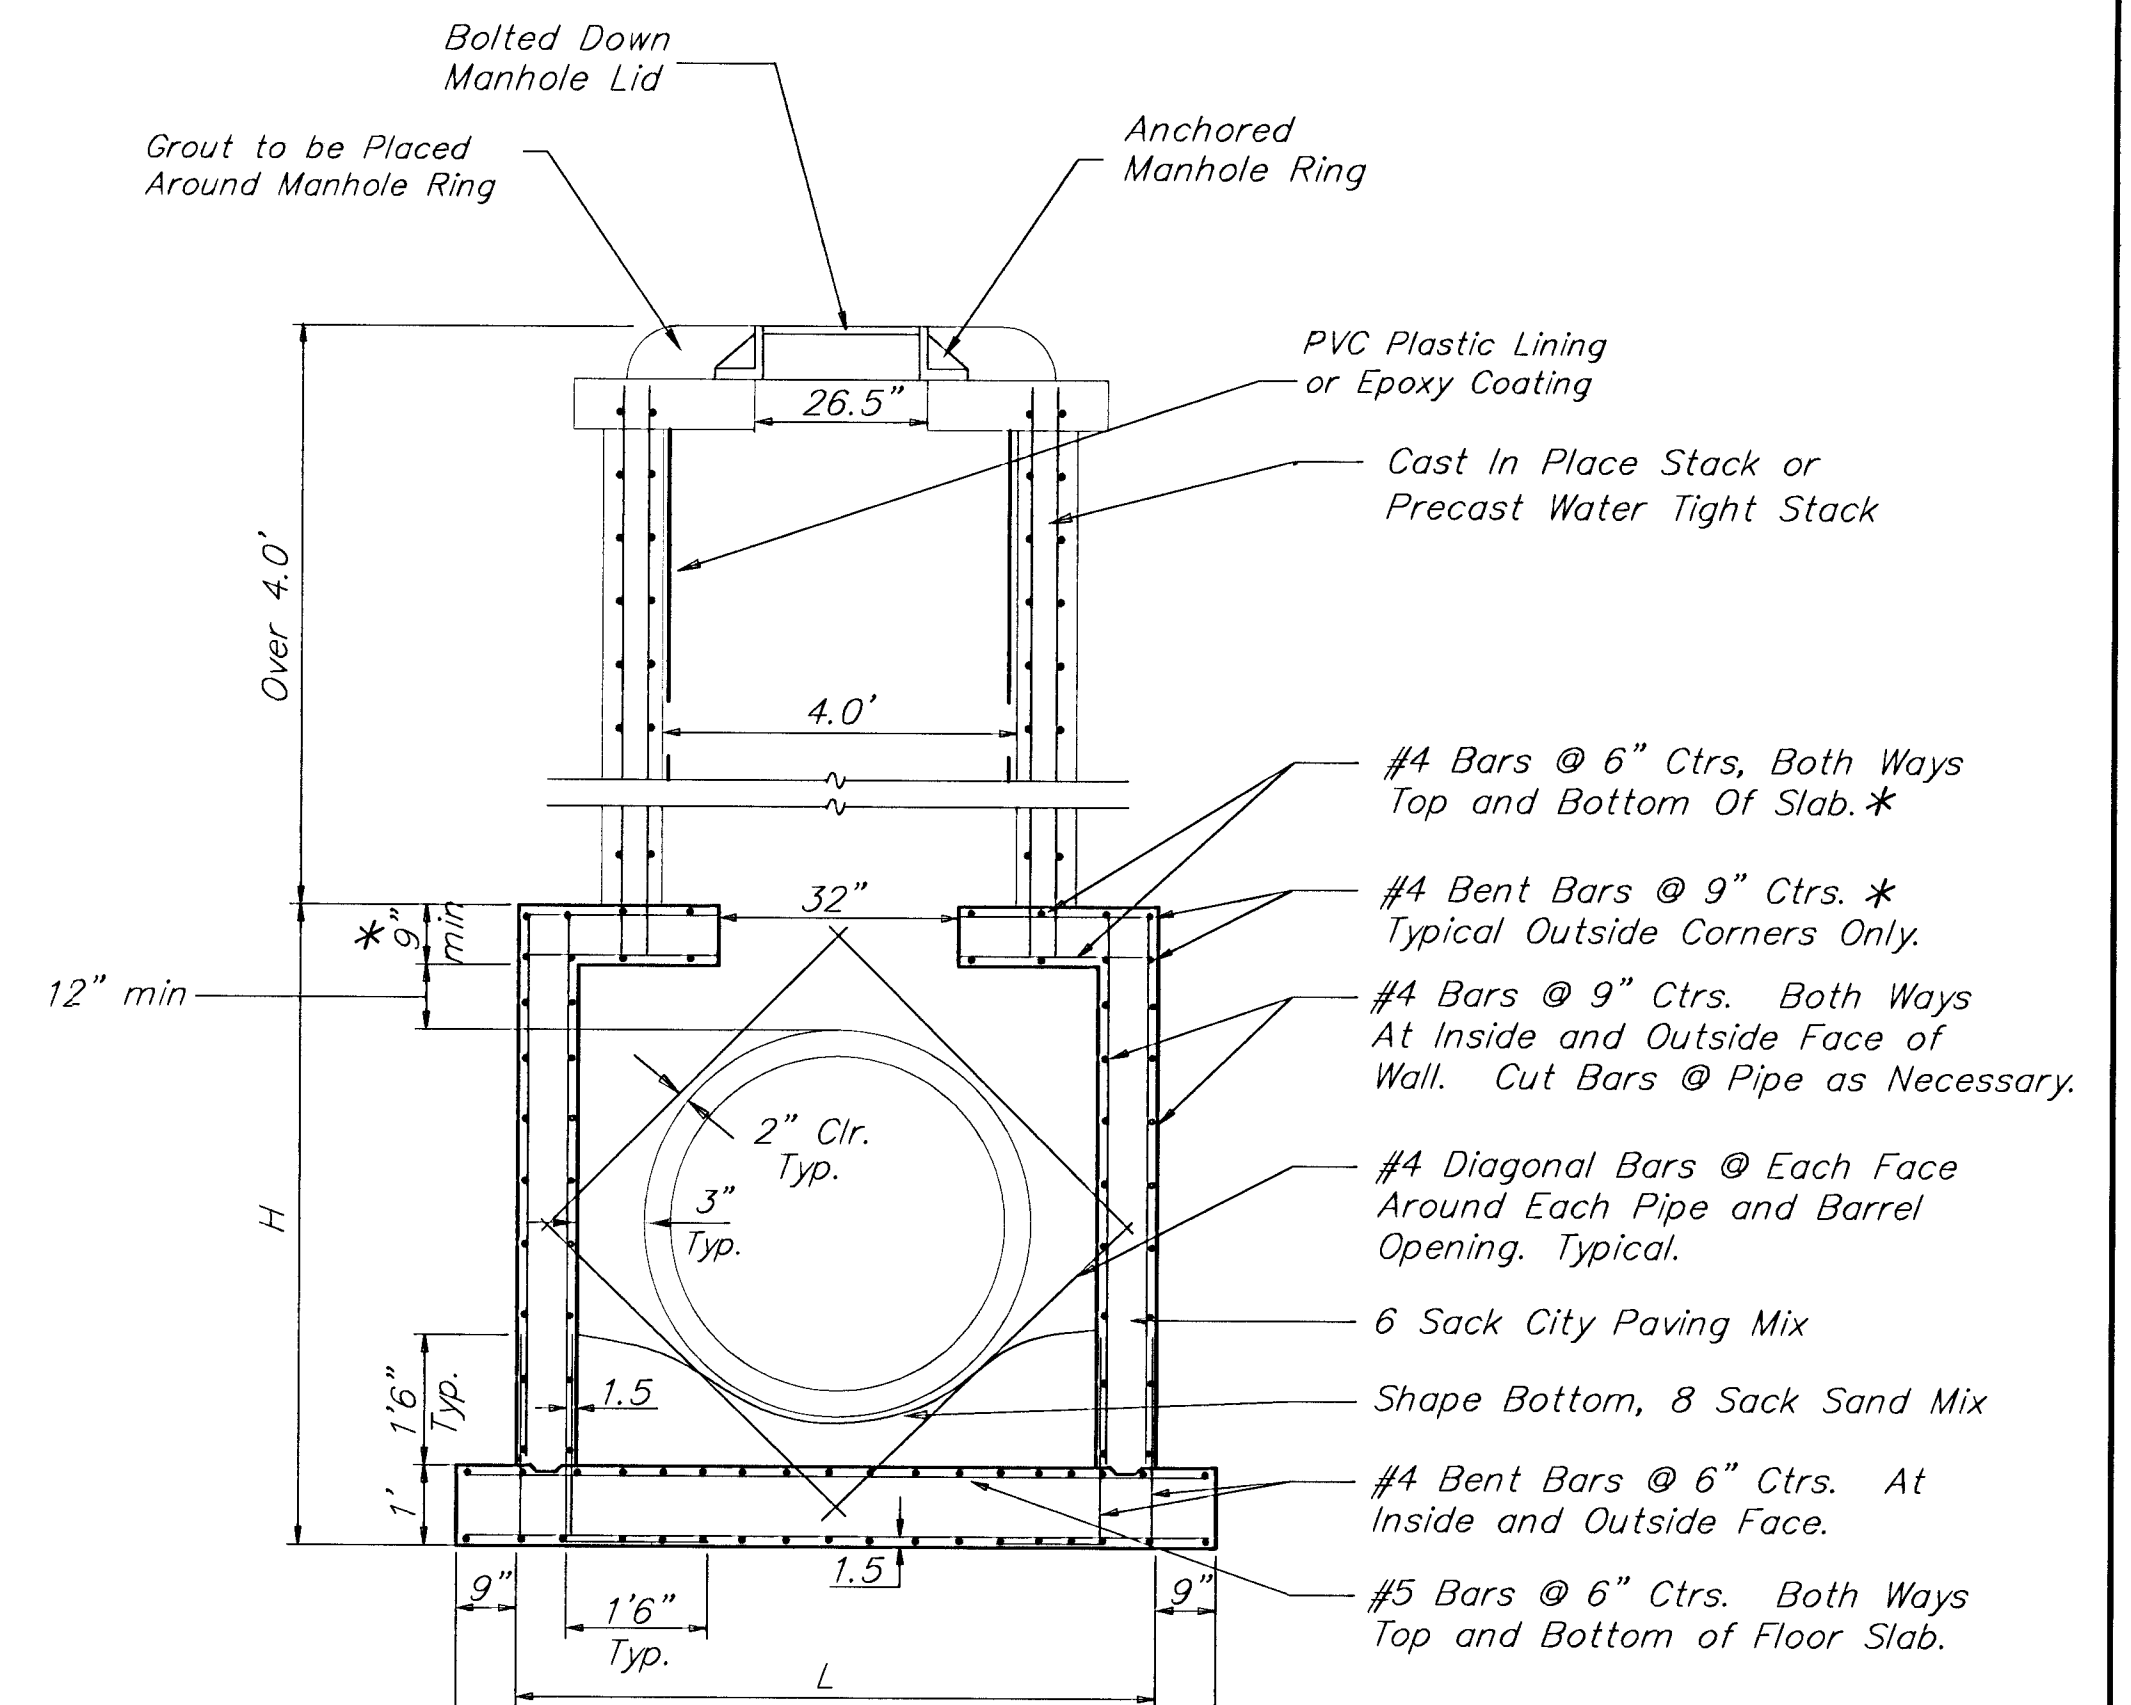

REINFORCED CONCRETE MANHOLE
DEPTH OF STACK: OVER 4.0'

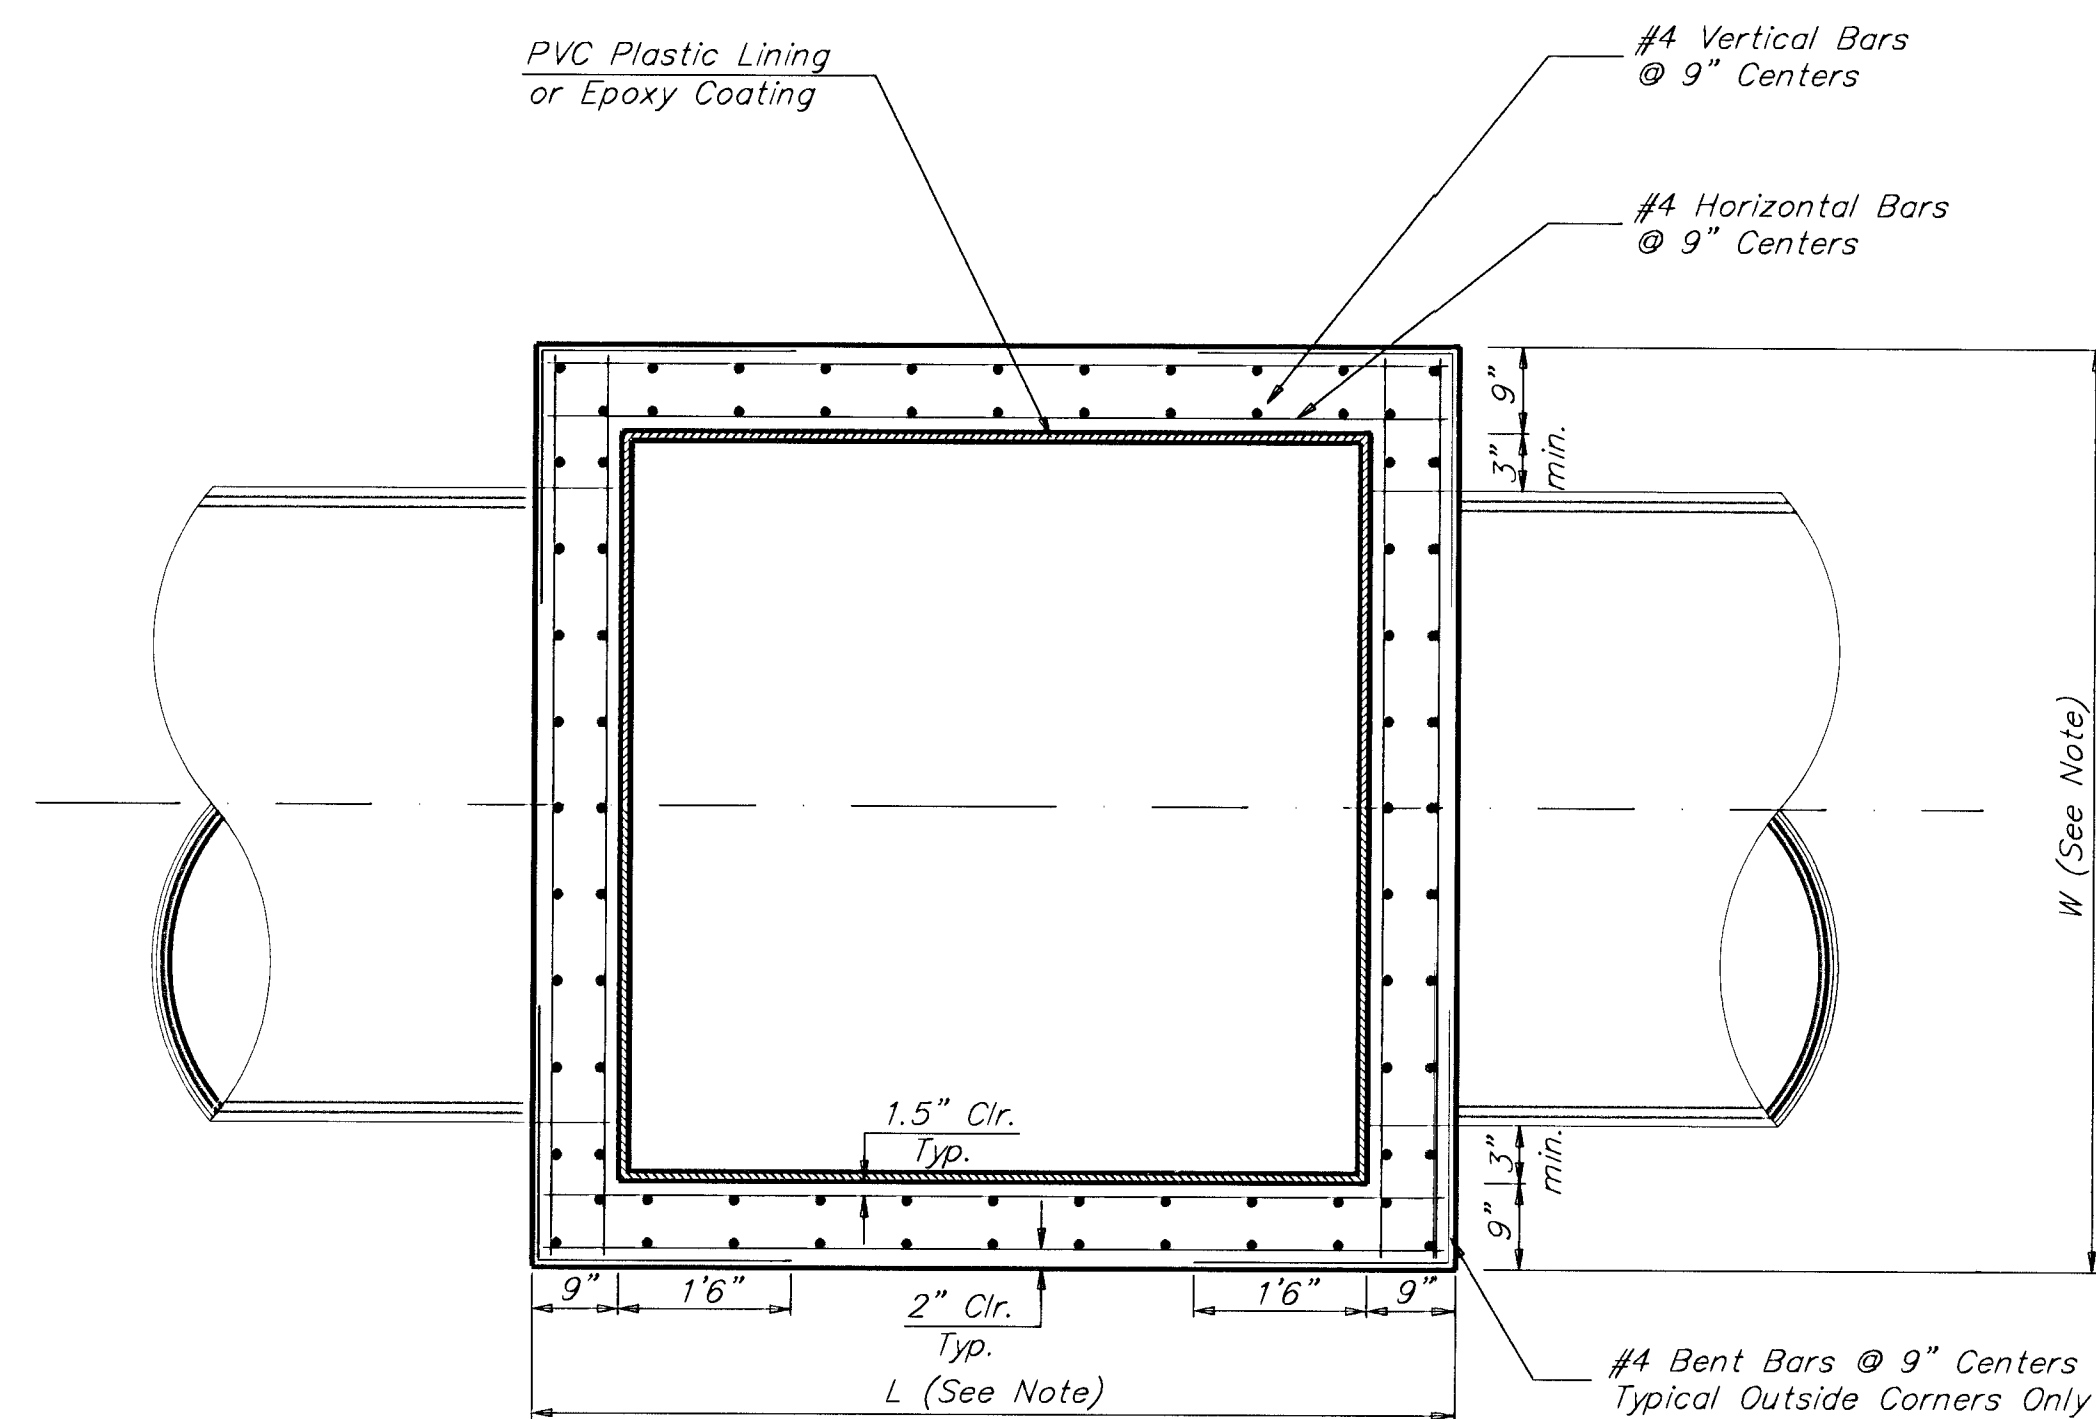

TOP VIEW

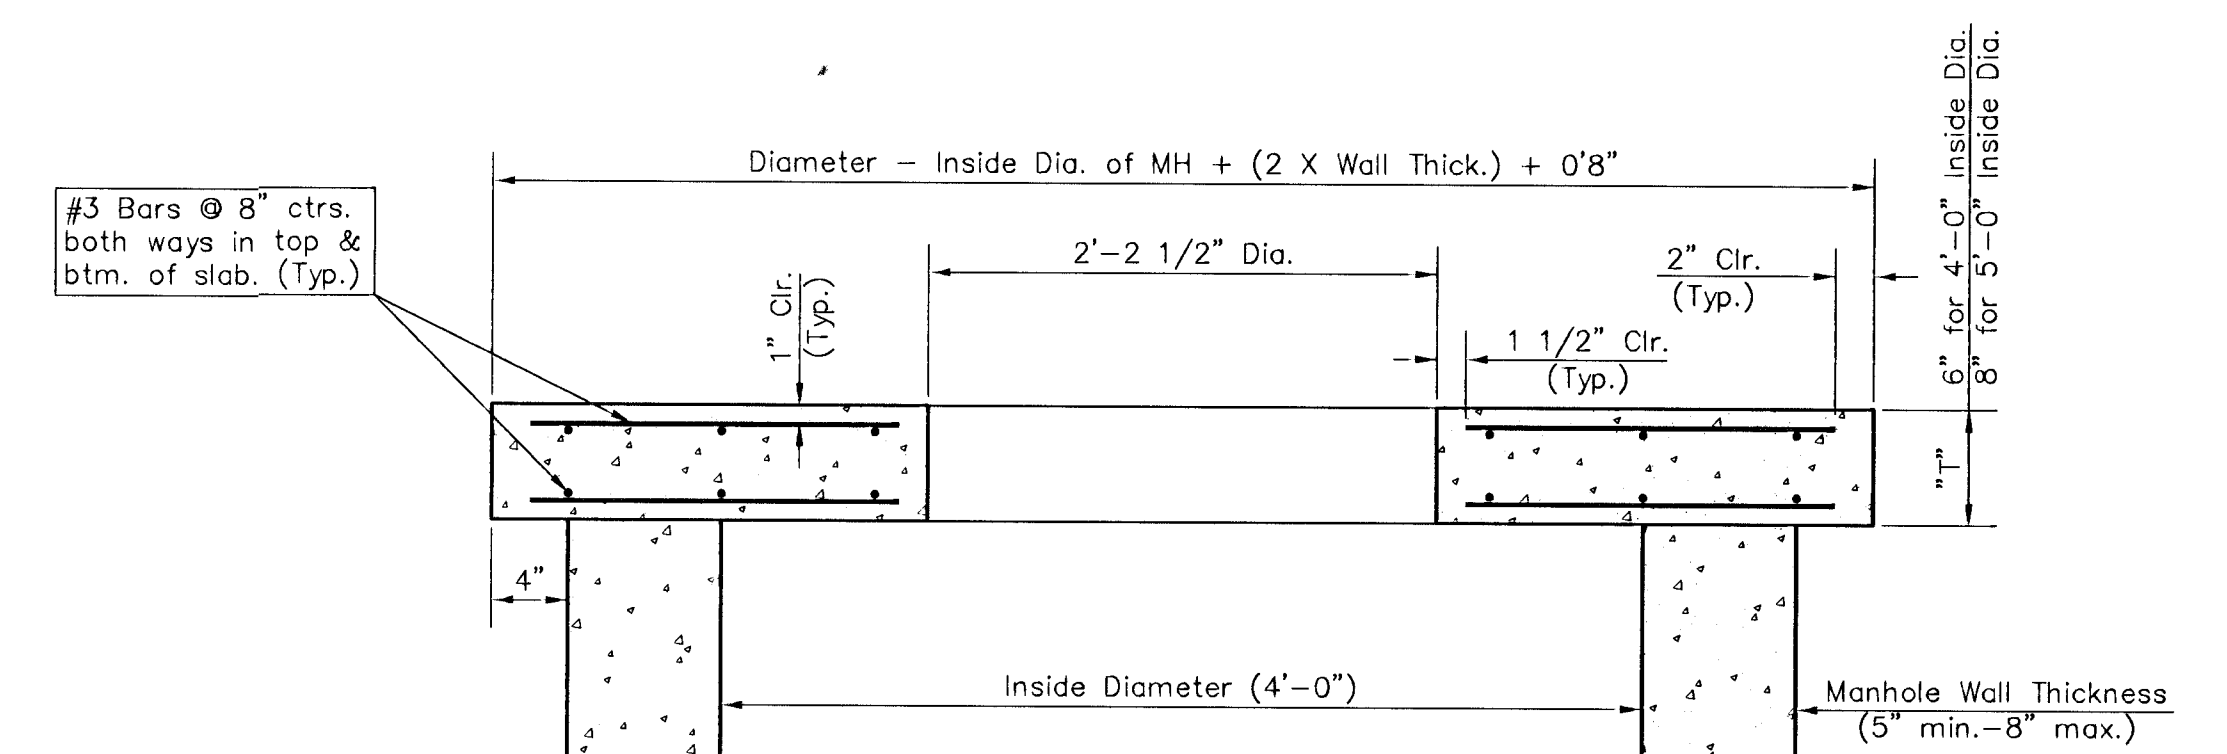

FLAT CONCRETE SLAB DETAILS

NOTES:

Contractor may construct Rein. Cast-in-Place or Precast Concrete Stack above Manhole structure. Precast stack must be anchored externally to manhole structure and be completely water-tight. Shop Drawings will be required for all Precast structures.

All areas that may be exposed to sewer gas including manhole tops shall require epoxy coating. (See General Notes)

* Additional Top Slab Thickness and/or reinforcement configuration may be required for oversized Concrete Manhole Structures.

PROJECT NUMBER 472-76-245-83324		SHEET NAME RCMH		ENGINEERING DIRECTORY F:\Hydraulic\KTA	
DESIGN C.O.W.	DRAWN STAFF	APPROVED	DATE FEB 2001	SCALE NONE	BAUGHMAN NO 99-09-E453

CAPITAL IMPROVEMENT PROJECT

REINFORCED CONCRETE MANHOLE

HYDRAULIC AVENUE PAVING - INCIDENTAL DRAINAGE IMPROVEMENTS - PHASE 1

BAUGHMAN COMPANY, P.A.
ENGINEERING, SURVEYING, & PLANNING
316-262-7271 * 315 ELLIS * WICHITA, KANSAS 67211