

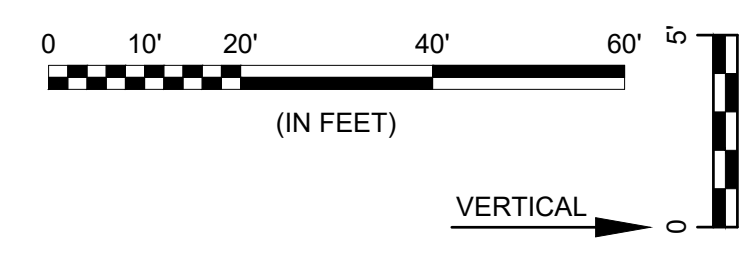


File: L:\2020\20T41002 - Cowtown and MWTP Water Lines\Drawings\C3D\Sheets\WATERLINE 4.dwg, Last Save: 12/3/2020 4:52 PM, Last saved by: DRS\andrich  
 Last plotted by: Standrich, Daryl R., Plot Style: ---, Plot Scale: 1:2.585, Plot Date: 12/11/2020 11:26 AM, Plotter used: None

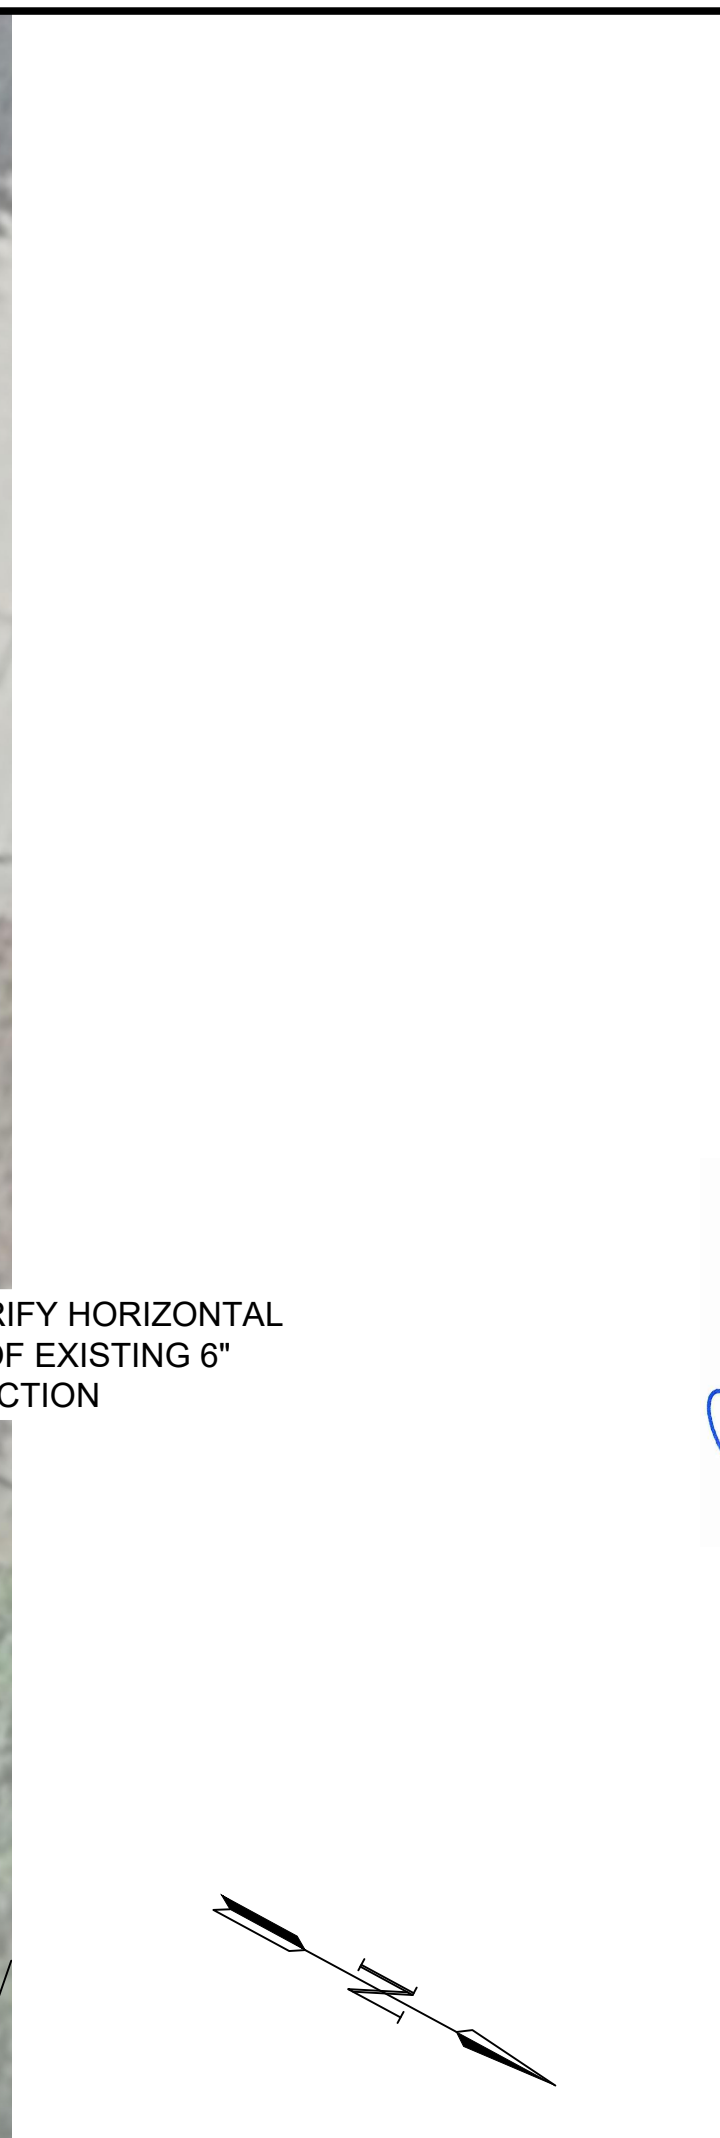


NOTE:  
 CONTRACTOR TO VERIFY LOCATION  
 AND ELEVATION OF EXISTING WATER  
 LINES PRIOR TO CONSTRUCTION.

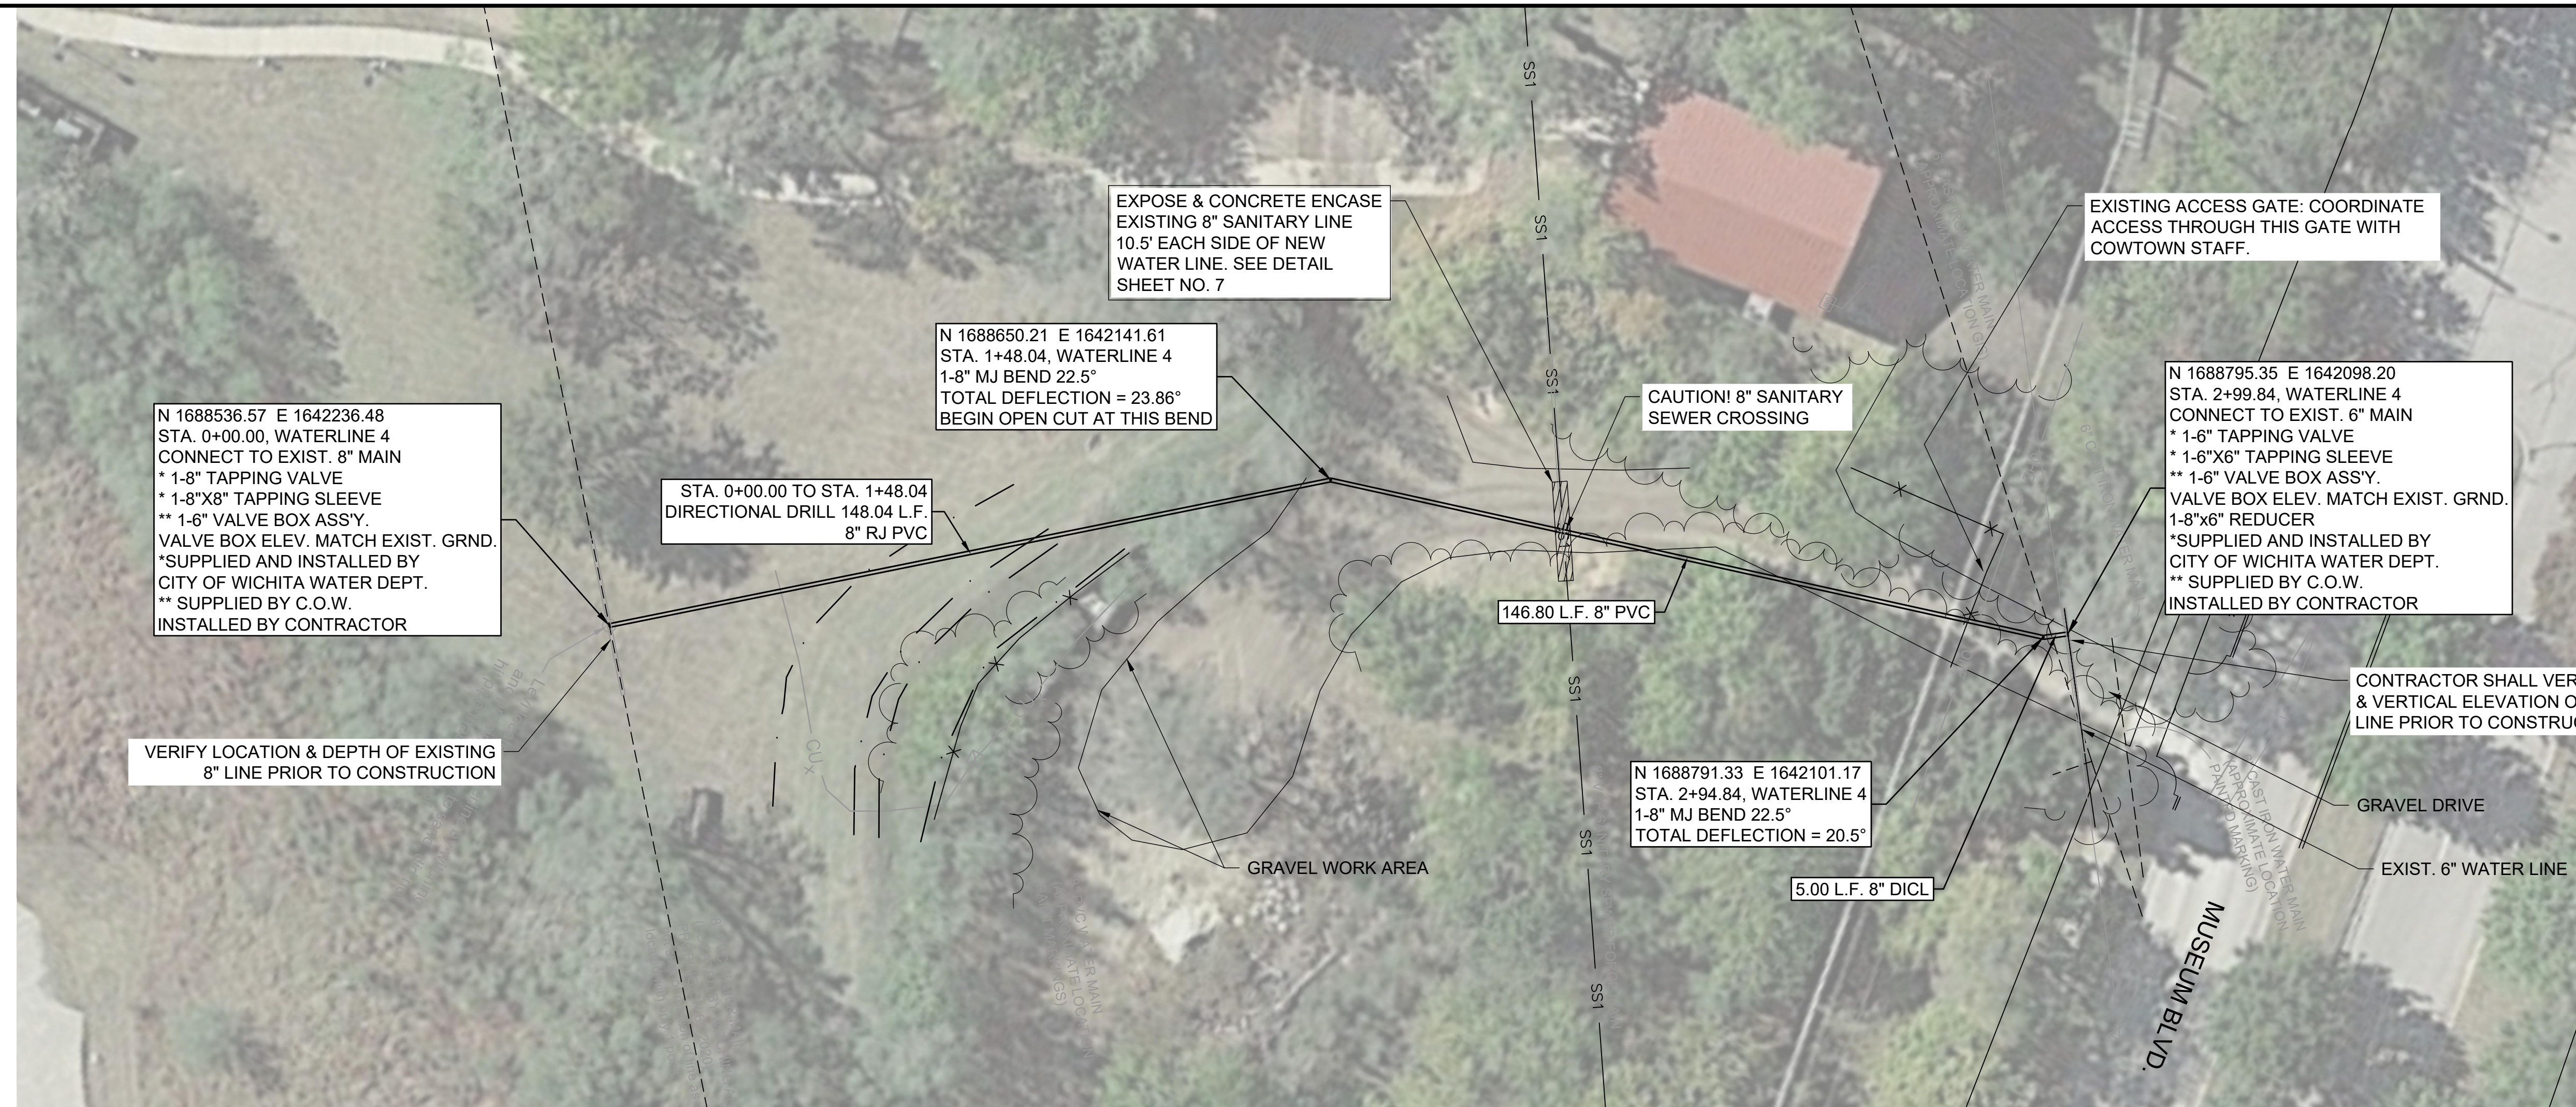

© 2020 GARVER, LLC  
 THIS DOCUMENT, ALONG WITH THE  
 IDEAS AND DESIGNS CONVEYED  
 HEREIN, SHALL BE CONSIDERED  
 INSTRUMENTS OF PROFESSIONAL  
 SERVICE AND ARE PROPERTY OF  
 GARVER, LLC. ANY USE,  
 REPRODUCTION, OR DISTRIBUTION  
 OF THIS DOCUMENT, ALONG WITH  
 THE IDEAS AND DESIGN CONTAINED  
 HEREIN, IS PROHIBITED UNLESS  
 AUTHORIZED IN WRITING BY  
 GARVER, LLC OR EXPLICITLY  
 ALLOWED IN THE GOVERNING  
 PROFESSIONAL SERVICES  
 AGREEMENT FOR THIS WORK.

8535 E. 21st St. N.  
 Suite 130  
 Wichita, KS 67206  
 (316) 264-8008

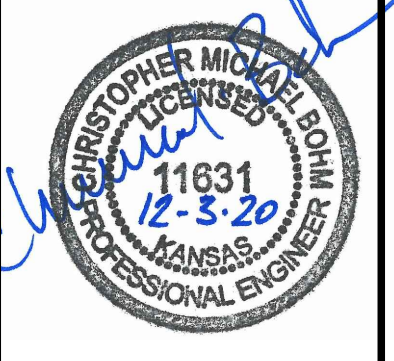

REV.	DATE	DESCRIPTION	BY



CITY OF WICHITA  
 WICHITA, KANSAS  
 COWTOWN & MWTP  
 WATER LINES

WATERLINE 4

JOB NO.: 20T41002  
 DATE: DEC. 2020  
 DESIGNED BY: .  
 DRAWN BY: .

BAR IS ONE INCH ON  
 ORIGINAL DRAWING  
 0 1"  
 IF NOT ONE INCH ON THIS SHEET,  
 ADJUST SCALES ACCORDINGLY.

DRAWING NUMBER

SHEET  
 NUMBER **11** OF **13**