


BENCH MARK #1: "□" cut on top of curb
50.4' N. of N.W. corner of Lot 17 on Washington,
Mathewson's 2nd Addition Elev. 109.65

SRB

SCALE: 1" = 20'

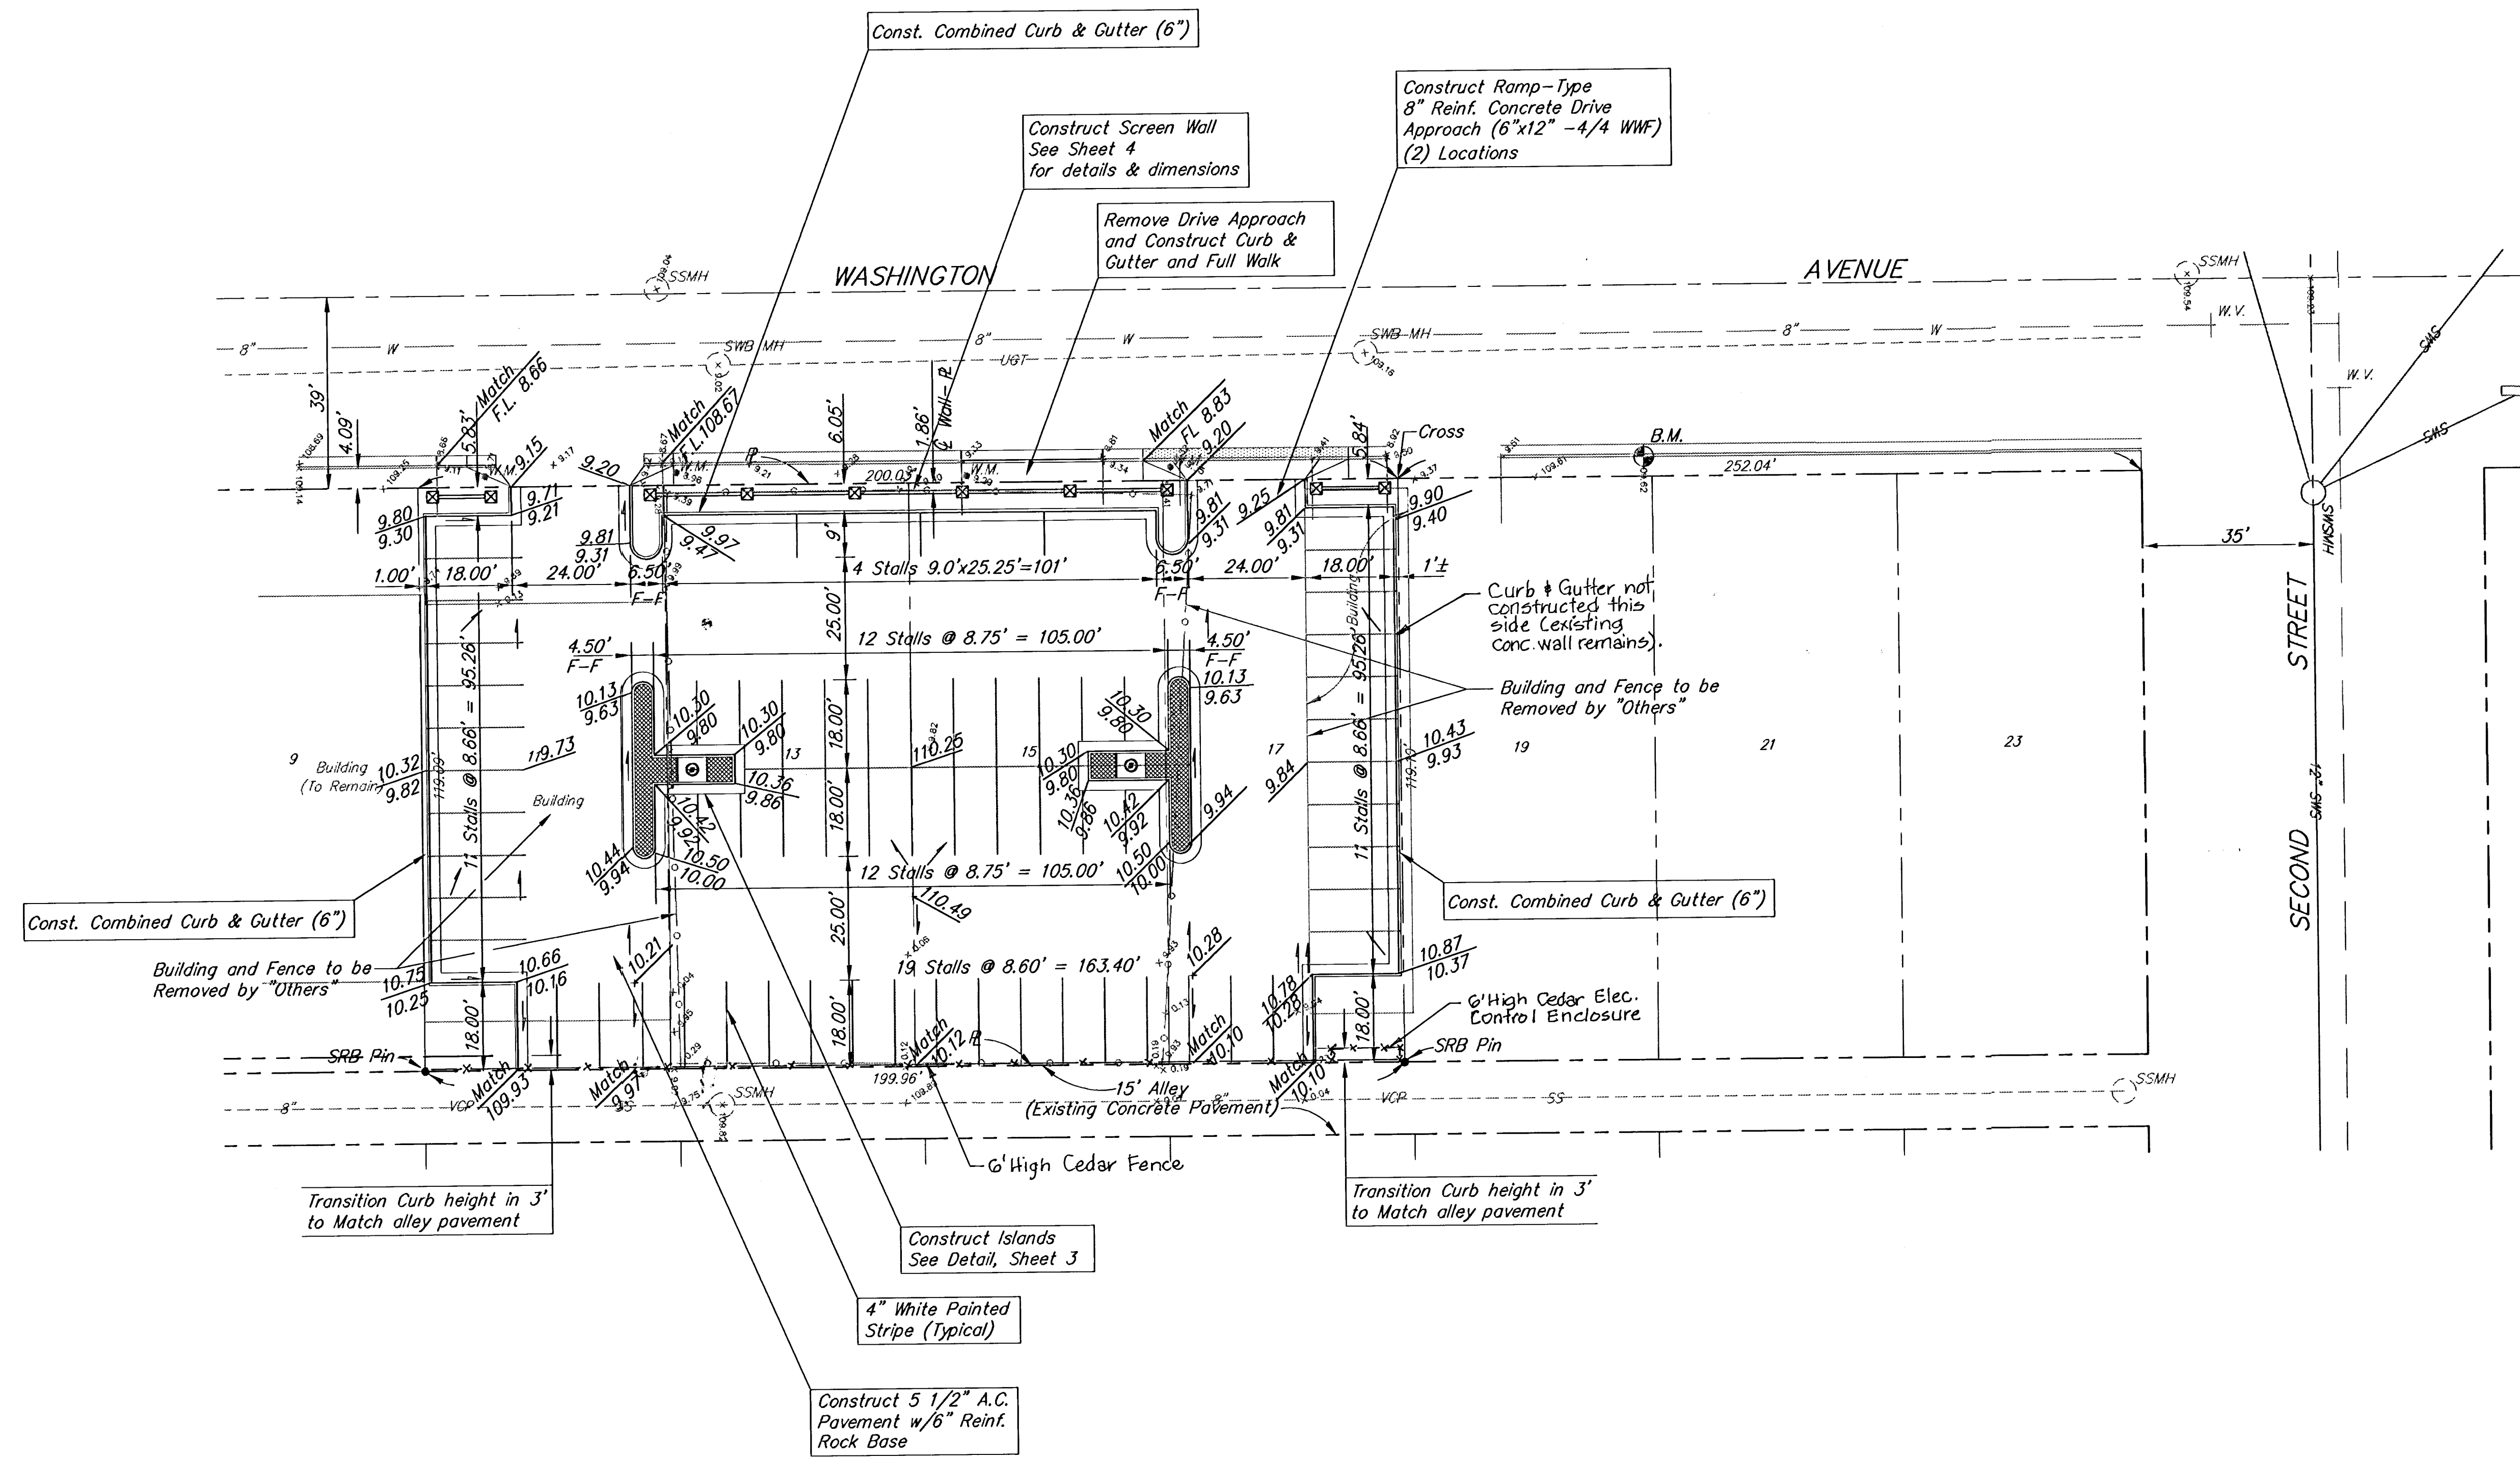

NOTE:
Dimensions are to face of curb except where noted otherwise.

LEGAL DESCRIPTION:
Lots 11, 13, 15, and 17, Washington Avenue, in Mathewson's 2nd Addition
to the City of Wichita, Sedgwick County, Kansas, except the West nine
(9) feet thereof.

SITE PLAN - PARKING LOT #9 OLD TOWN PARKING DISTRICT					
SRB		841 SOUTH HILLSIDE WICHITA, KANSAS 67211		316-852-7754 FAX 652-7932	
SAVOY, RUGGLES & BOHM, P. A. ENGINEERING & SURVEYING					
PROJECT NUMBER					
DRAWN T. Brooks	DESIGN T. Ruggles	REVIEW	DATE 2-23-94	UTILITY	SRB JOB 101E
REVISED 7-11-94 RECORD COPY					5 14