


FEEDER SCHEDULE					
(THIS SHEET ONLY)					
FEEDER IDENT.	CONDUCTORS			GROUND	ISOLATED
	SETS	QUANT. PER SET	SIZE	SIZE PER SET	GROUND SIZE PER SET
1	1	4	#10	#10	---
2	1	5	#10	#10	---
3	1	2	#10	#10	---


NOTE: FEEDERS ARE LISTED ON THE BASIS OF USING METALLIC CONDUITS IF P.V.C. IS USED FOR UNDERGROUND FEEDERS, AN EQUIPMENT GROUND CONDUCTOR SIZED PER N.E.C. MUST BE ROUTED IN CONDUIT WITH CIRCUIT CONDUCTORS. CONDUIT SIZE AS LISTED MUST BE INCREASED AS REQUIRED.

PLAN NOTES


1. REFER TO RELATED DRAWINGS FOR ALL CONTROL AND DISTRIBUTION REQUIREMENTS, AND ALL LIGHT FIXTURES AND BASES.
2. ALL CONDUCTORS TO BE CLEARLY AND PERMANENTLY MARKED AT ALL ENDS AND JUNCTION POINTS WITH PANEL DESIGNATION AND CIRCUIT NUMBER.

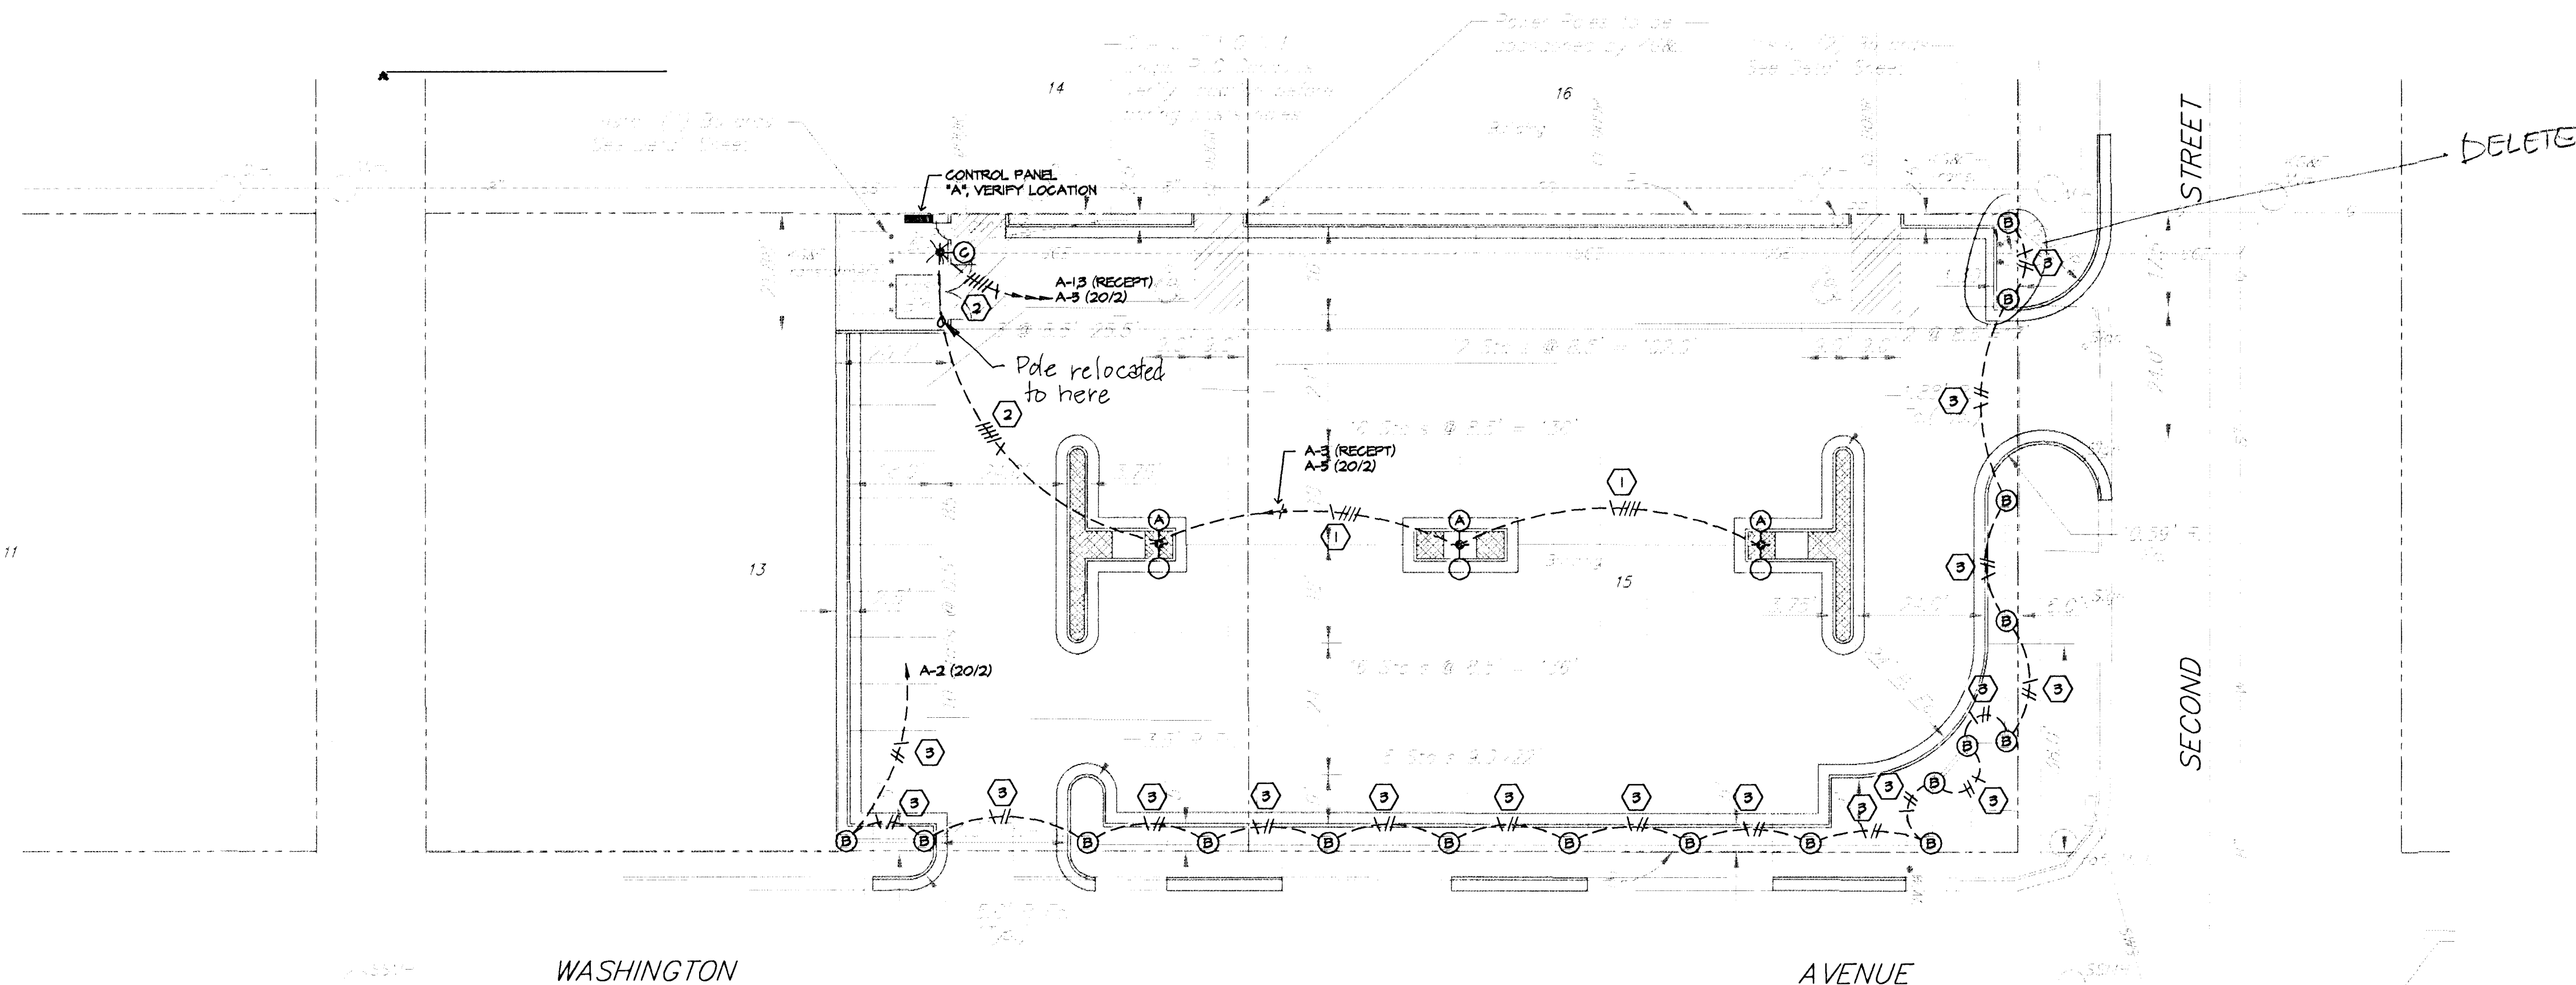

LIGHTING FOR PARKING LOT #10
SCALE: 1" = 20' - 0"

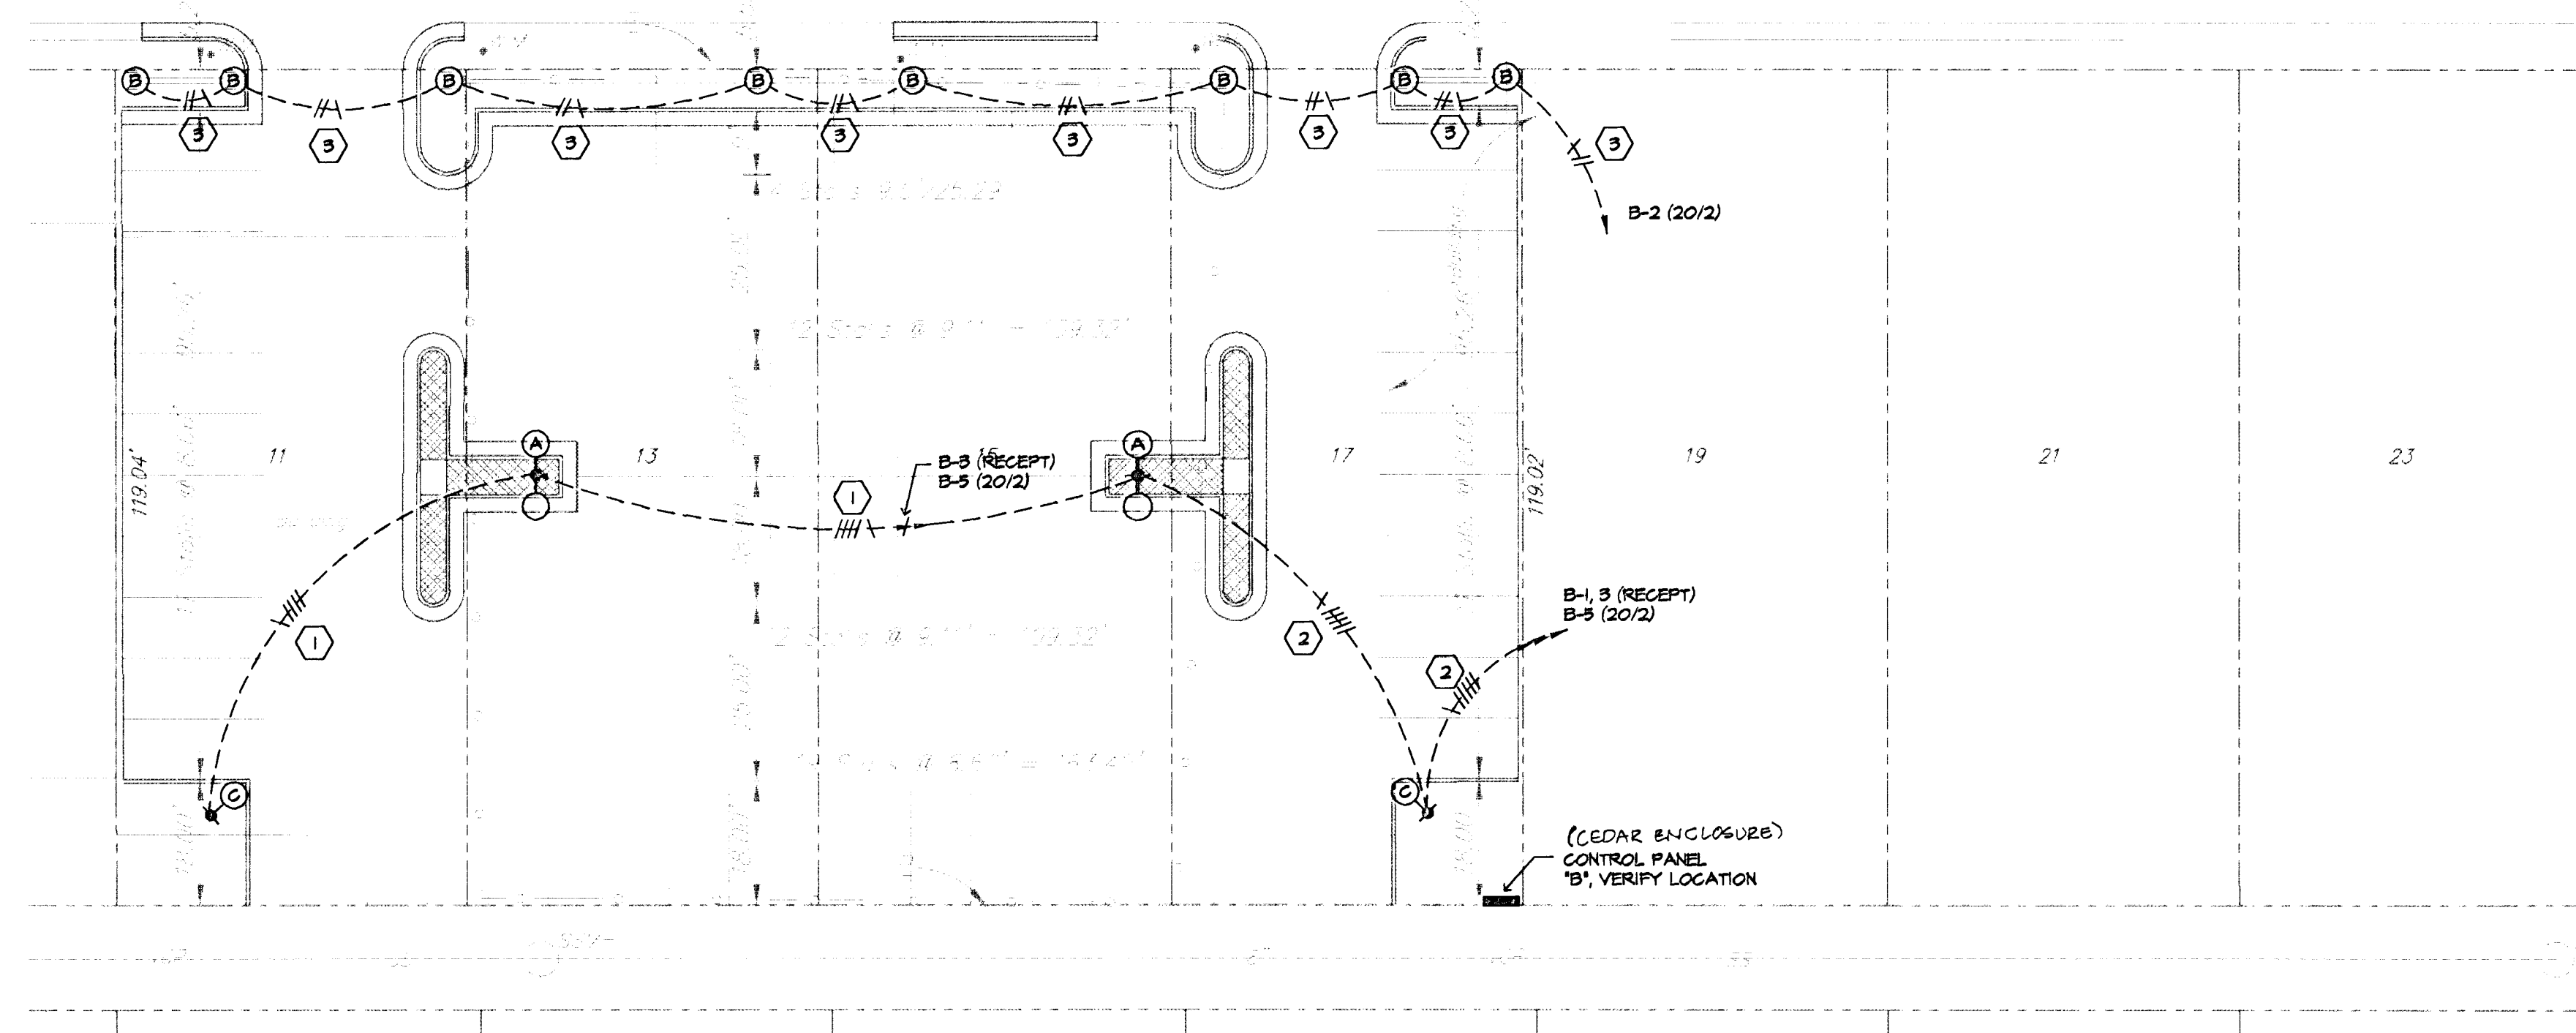

LIGHTING FOR PARKING LOT #9
SCALE: 1" = 20' - 0"

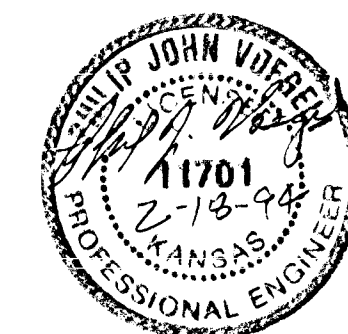

Electrical Engineering
and Design
626 N. Broadway, Suite B
Wichita, KS 67214-3887
(316) 264-3061
FAX: (316) 264-3042

RECORD COPY - REVISED 7-11-94

OLD TOWN PARKING LOTS
LOTS #9 AND #10

SRB 841 SOUTH HILLSIDE 316-652-7754
WICHITA, KANSAS 67211 FAX 652-7932
SAVOY, RUGGLES & BOHM, P. A.
ENGINEERING & SURVEYING

PROJECT NUMBER

DRAWN SVA	DESIGN SVA	REVIEW SVA	DATE 2/18/94	UTILITY	SRB JOB 113E
--------------	---------------	---------------	-----------------	---------	-----------------

REVISED

9

14

DWG FILE
4023E03