


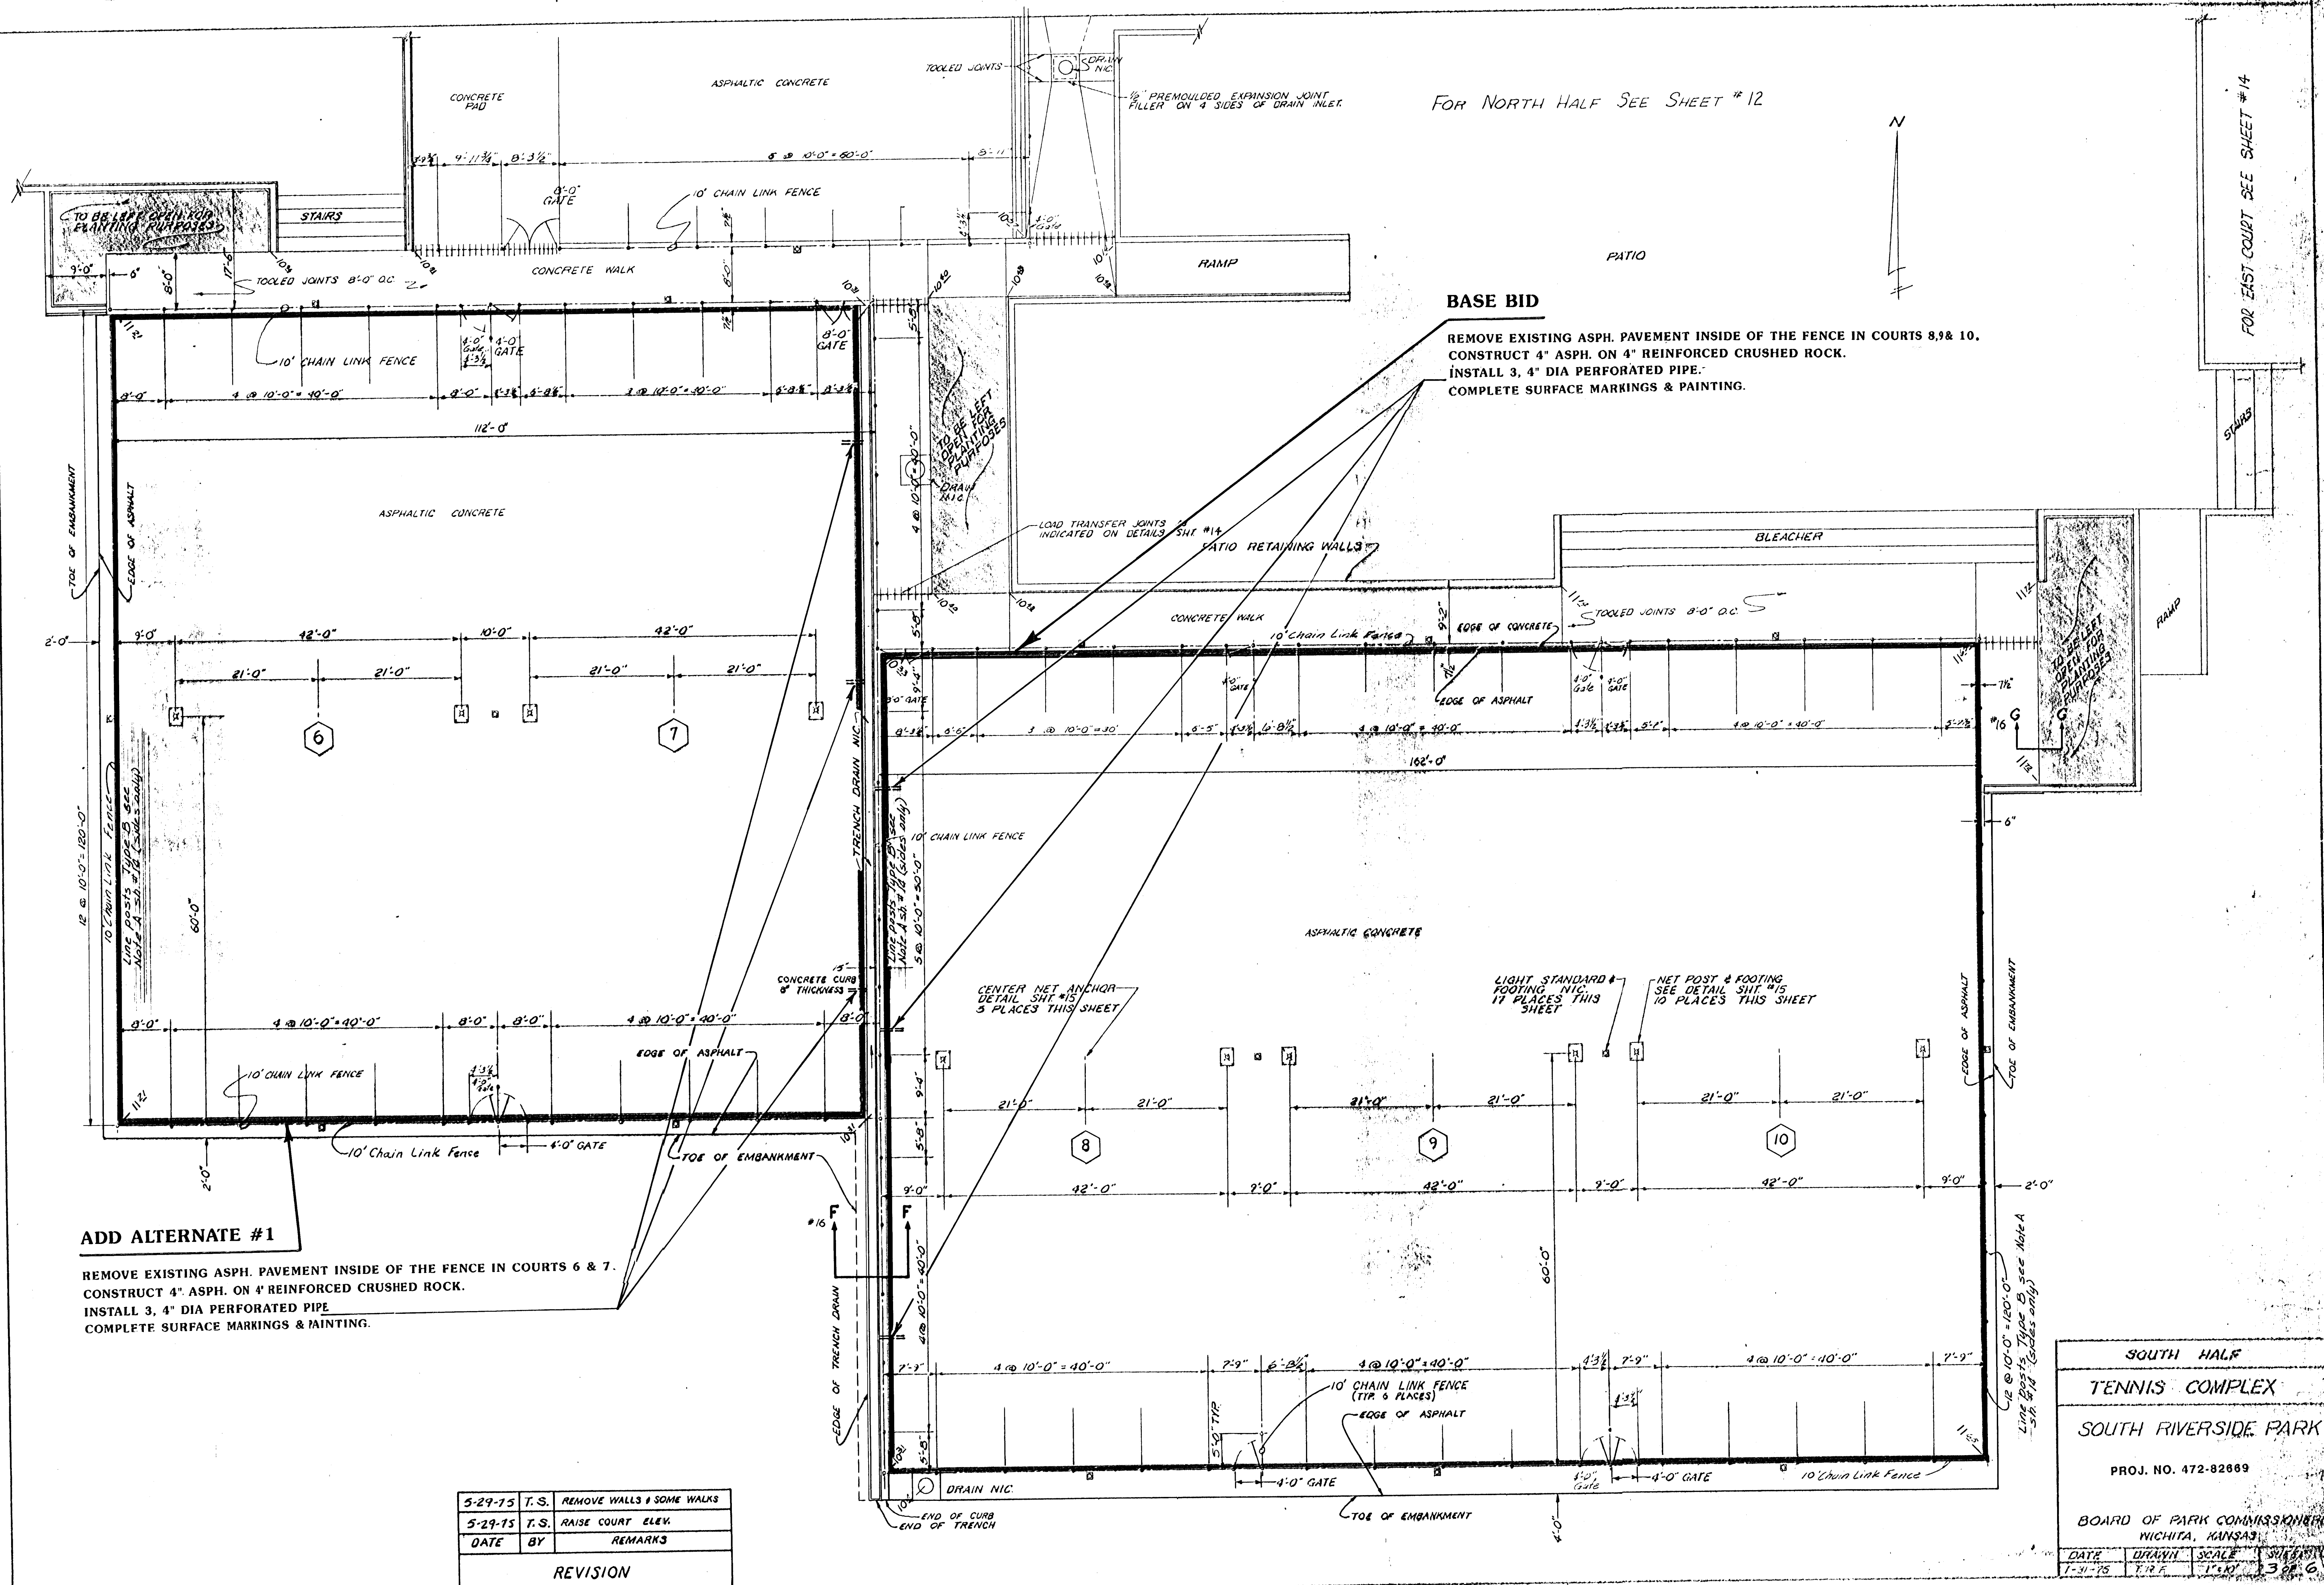

FOR NORTH HALF SEE SHEET #12

FOR EAST COURT SEE SHEET #14

BASE BID

REMOVE EXISTING ASPH. PAVEMENT INSIDE OF THE FENCE IN COURTS 8,9 & 10.
CONSTRUCT 4" ASPH. ON 4" REINFORCED CRUSHED ROCK.
INSTALL 3, 4" DIA PERFORATED PIPE.
COMPLETE SURFACE MARKINGS & PAINTING.

ADD ALTERNATE #1

REMOVE EXISTING ASPH. PAVEMENT INSIDE OF THE FENCE IN COURTS 6 & 7.
CONSTRUCT 4" ASPH. ON 4" REINFORCED CRUSHED ROCK.
INSTALL 3, 4" DIA PERFORATED PIPE
COMPLETE SURFACE MARKINGS & PAINTING.

5-29-75	T.S.	REMOVE WALLS & SOME WALKS
5-29-75	T.S.	RAISE COURT ELEV.
DATE	BY	REMARKS
REVISION		

SOUTH HALF

TENNIS COMPLEX

SOUTH RIVERSIDE PARK

PROJ. NO. 472-82889

BOARD OF PARK COMMISSIONERS
NICHITA, KANSAS

DATE	DRAWN	SCALE	SHEET NO.
1-31-75	T.R.F.	1"=10'	3 OF 6