
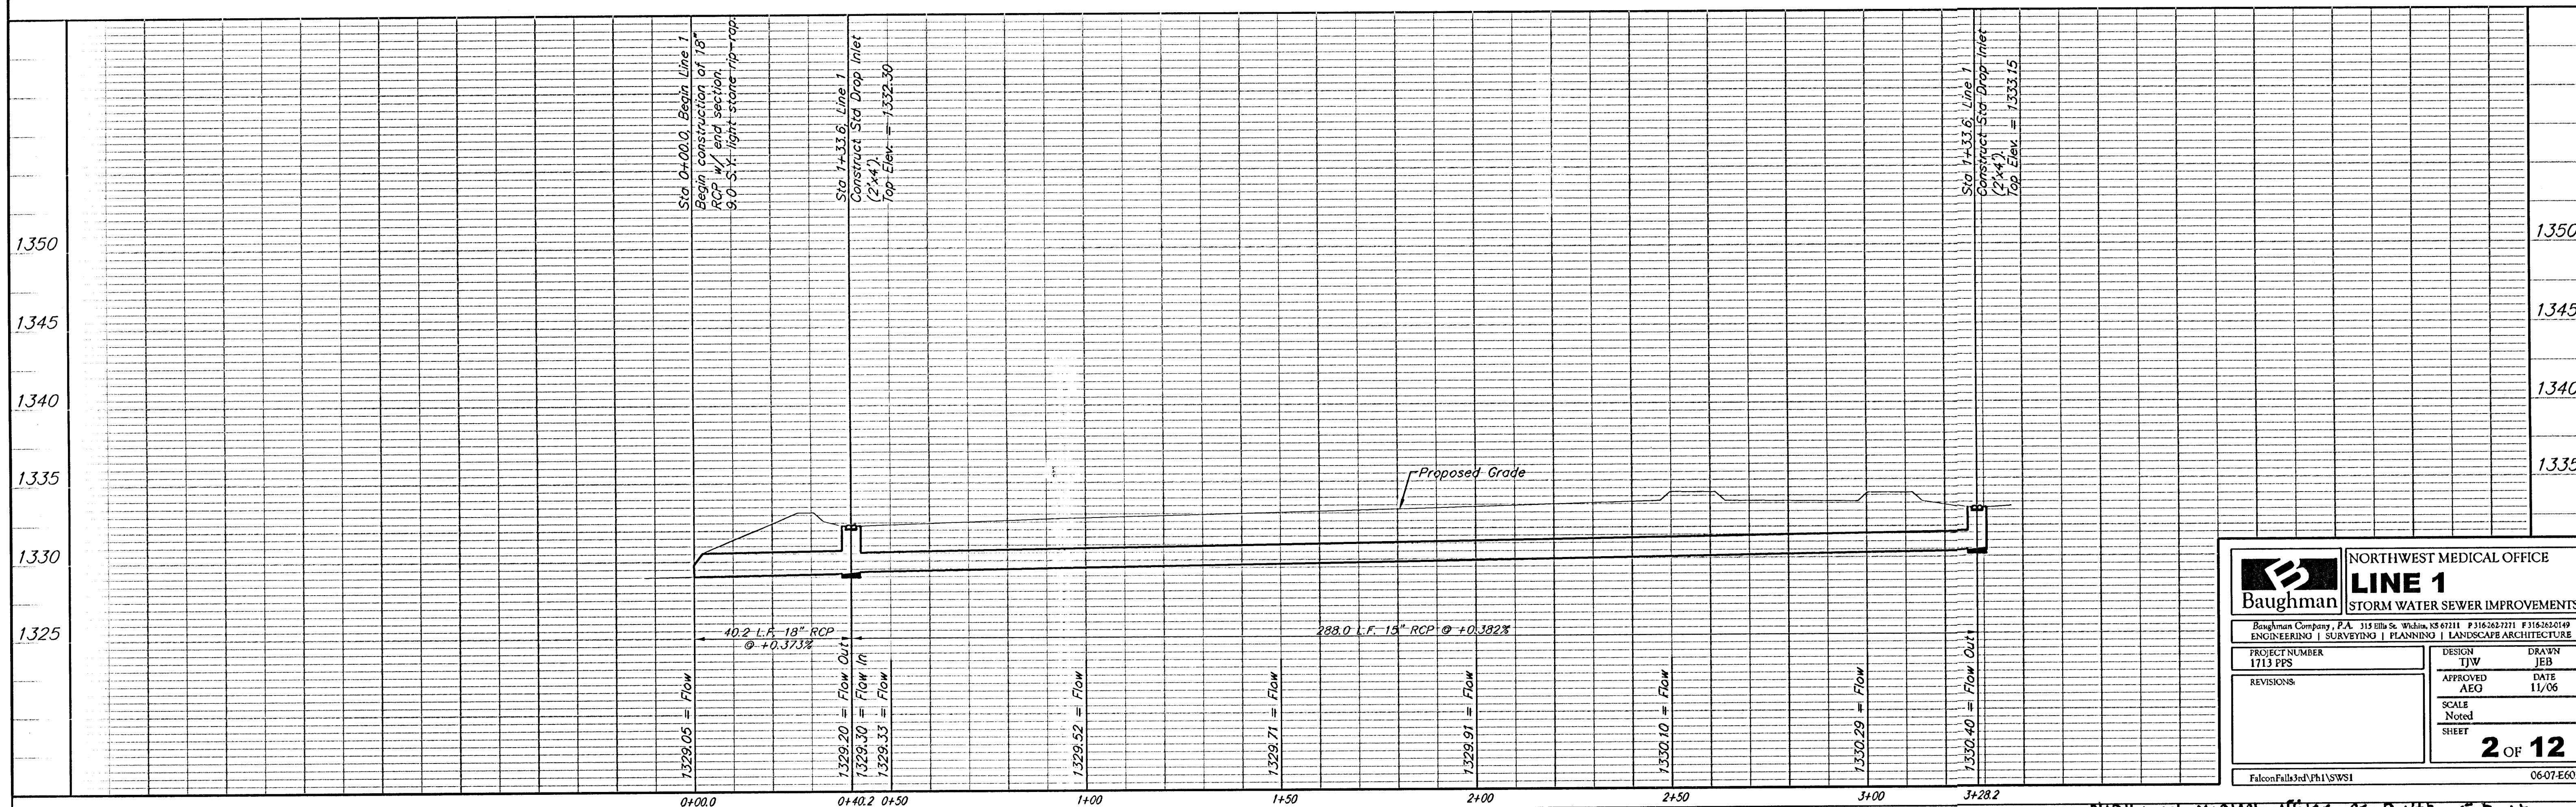


BENCHMARK:
Railroad Spike in East Face of
Power Pole, East of the NE Corner
of Lot 3, Northridge Plaza Addition
on East Side of Ridge Road
Elev. = 1335.05 M.S.L.

Scale: 1" = 20' Horizontal
1" = 5' Vertical
● = Iron

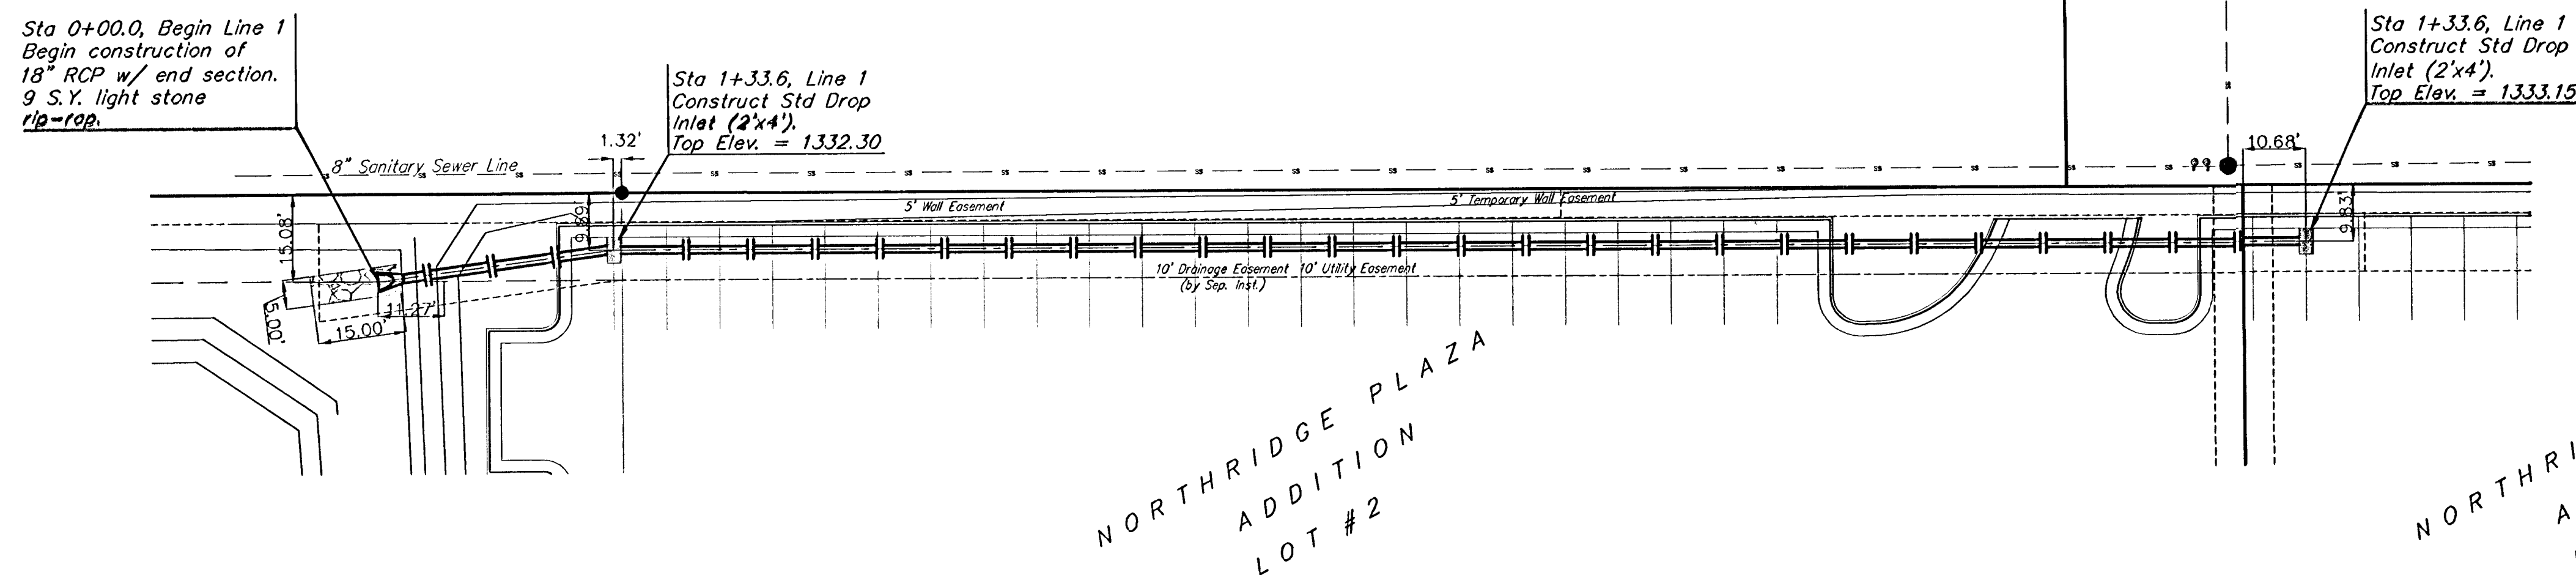

		NORTHWEST MEDICAL OFFICE	
Baughman		LINE 1	
STORM WATER SEWER IMPROVEMENTS			
Baughman Company, P.A. 315 Hills St. Wichita, KS 67211 P 3162627271 F 3162620149			
ENGINEERING SURVEYING PLANNING LANDSCAPE ARCHITECTURE			
PROJECT NUMBER 1713 PPS	DESIGN TJW	DRAWN JEB	
REVISIONS:	APPROVED AEG	DATE 11/06	
	SCALE Noted		
		2 OF 12	
Falcon Falls 3rd Ph1 SWS1		06-07-E602	

NORTHWEST MEDICAL OFFICE AS-BUILT 3-7-07
T.H./CED