

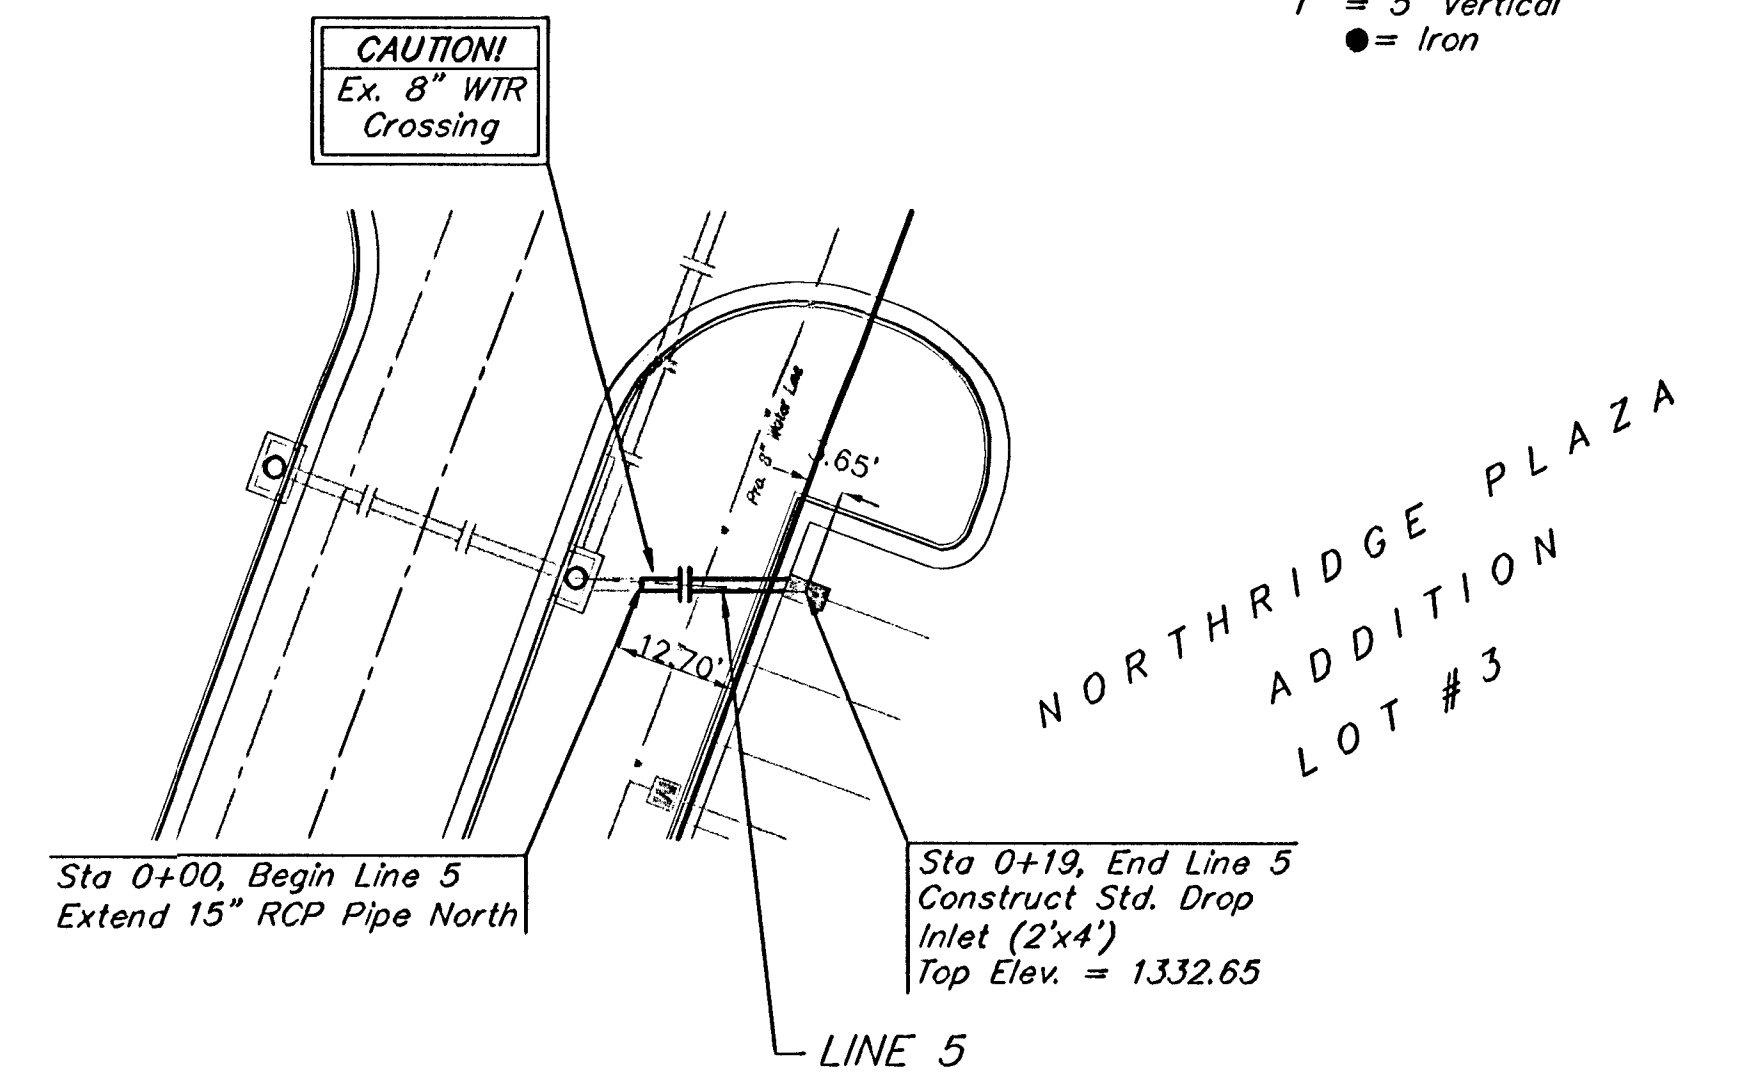
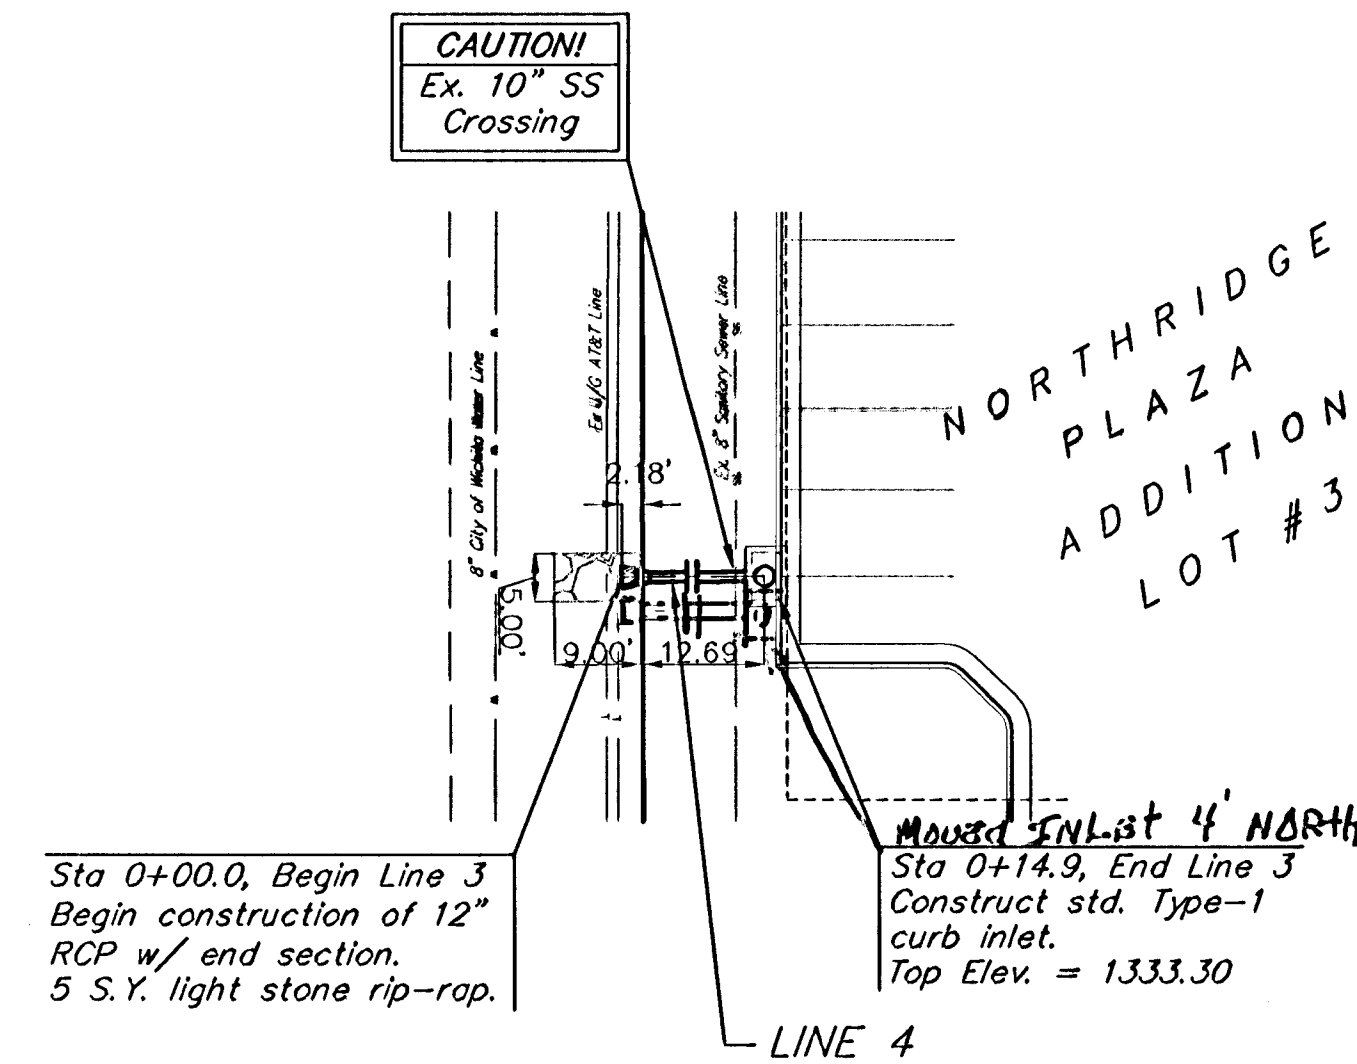
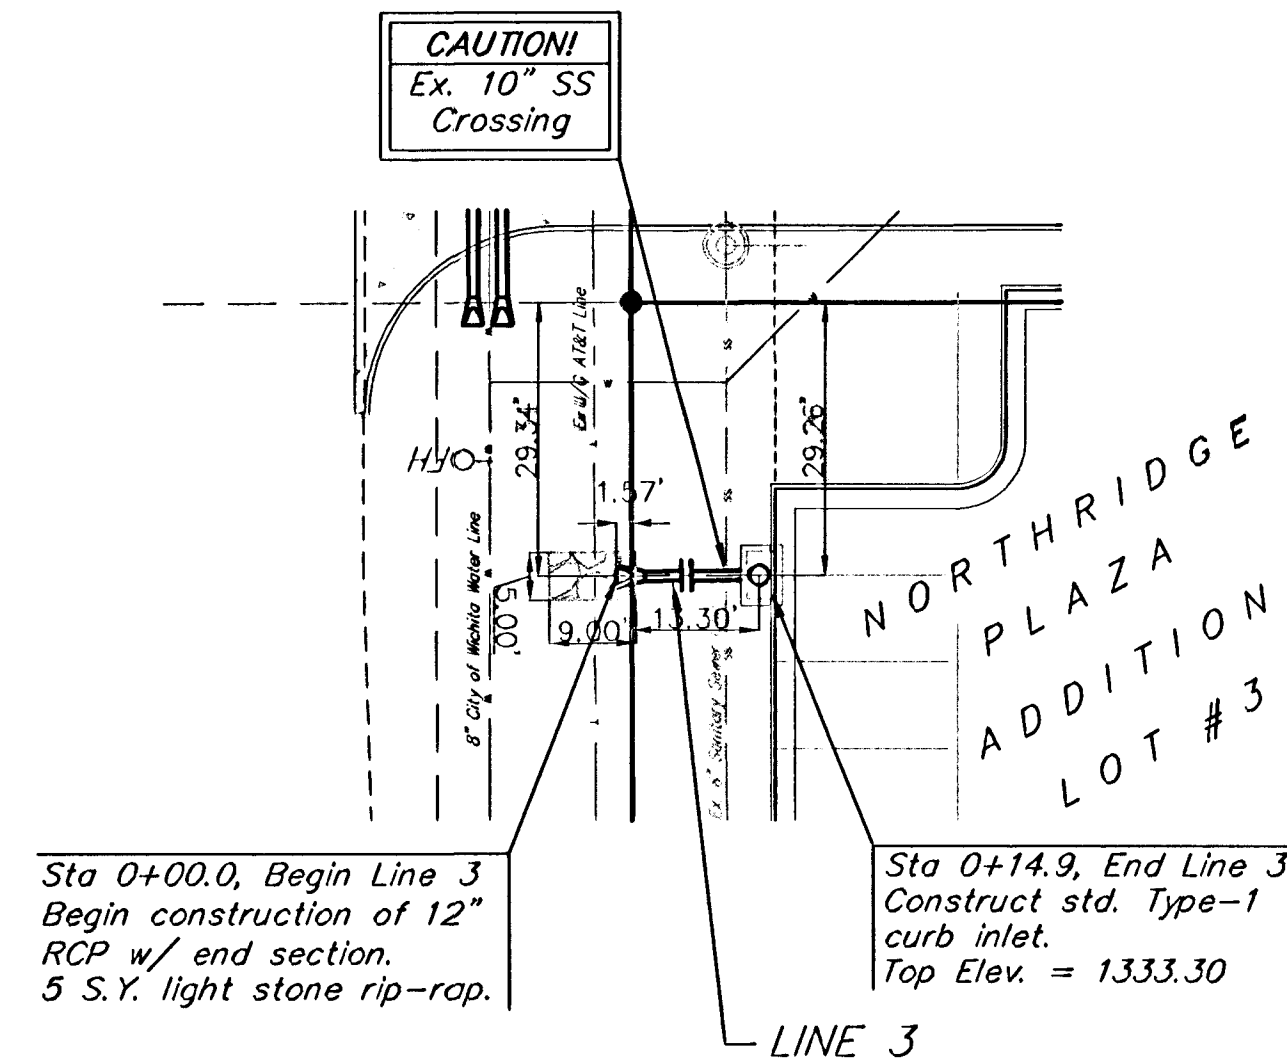


BENCHMARK:
Railroad Spike in East Face of
Power Pole, East of the NE Corner
of Lot 3, Northridge Plaza Addition
on East Side of Ridge Road
Elev. = 1335.05 M.S.L.

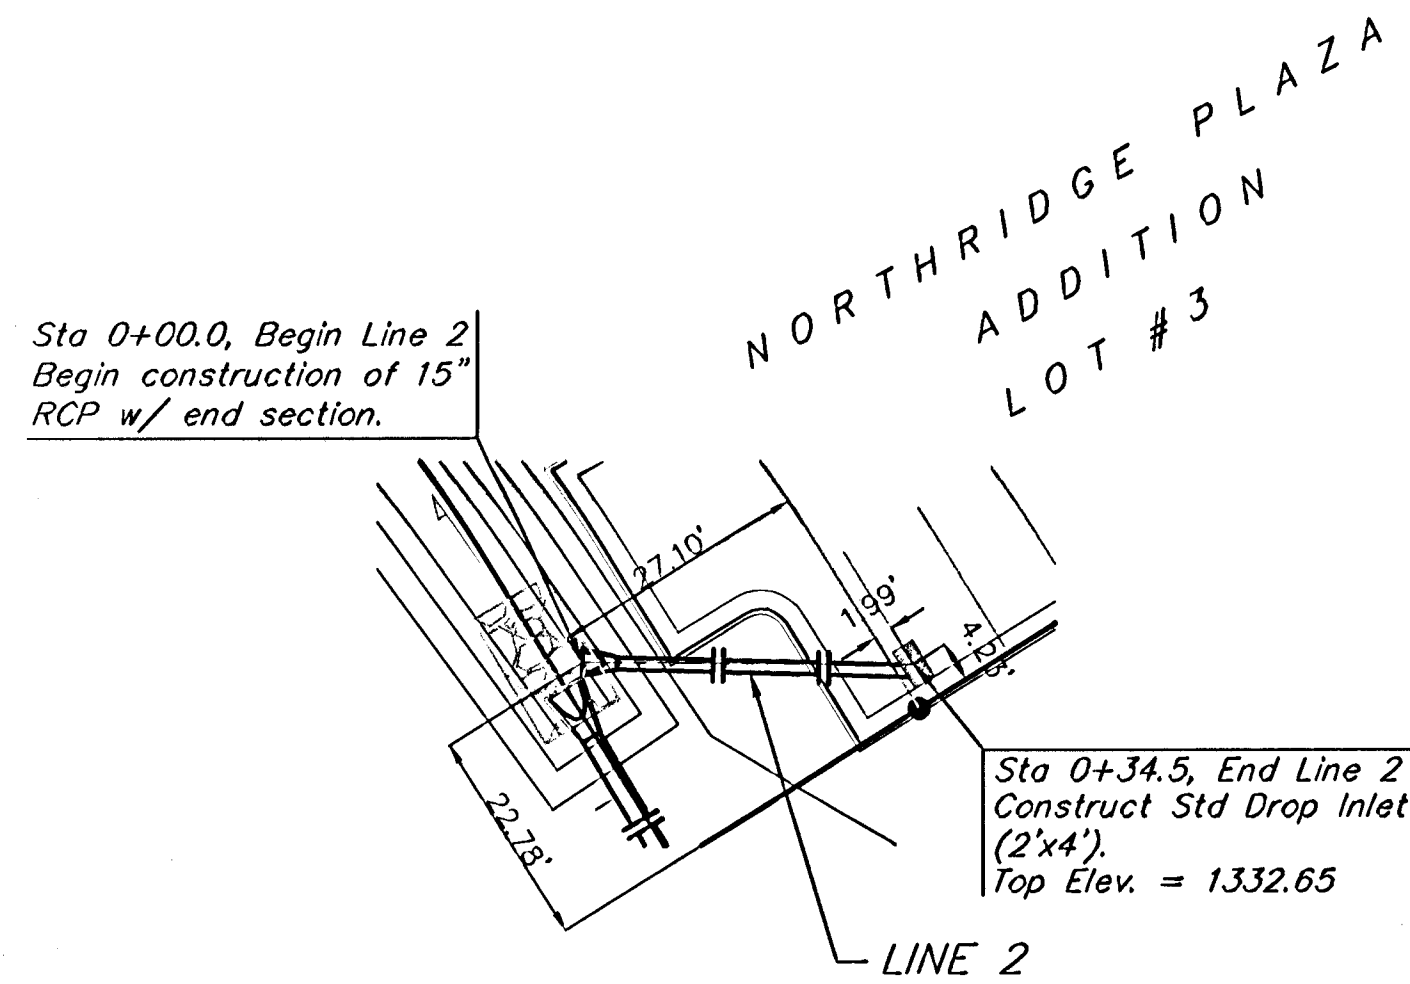

Scale: 1" = 20' Horizontal
1" = 5' Vertical
● = Iron

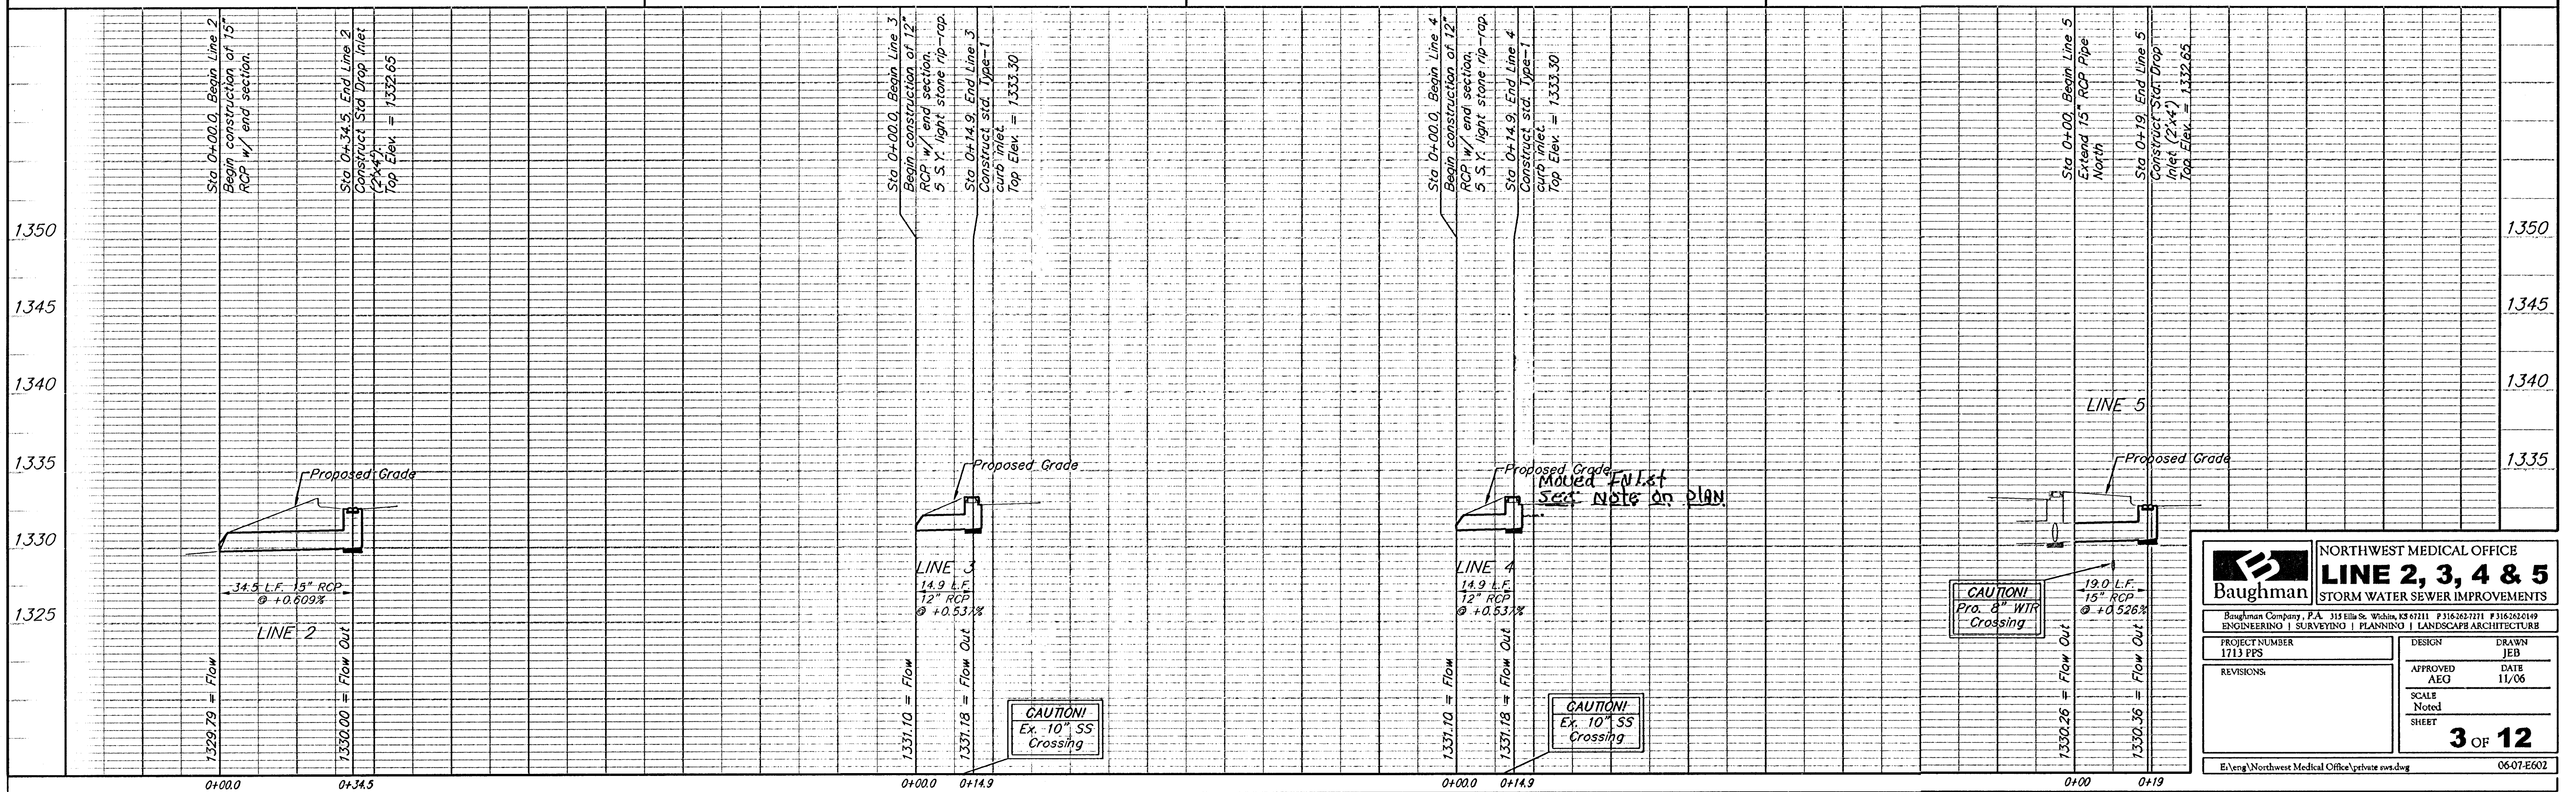

		NORTHWEST MEDICAL OFFICE	
LINE 2, 3, 4 & 5		STORM WATER SEWER IMPROVEMENTS	
Baughman Company, P.A. 315 Ella St. Wichita, KS 67211 P 316-262-7271 F 316-262-0149 ENGINEERING SURVEYING PLANNING LANDSCAPE ARCHITECTURE			
PROJECT NUMBER 1713 PPS	DESIGN JEB	DRAWN JEB	DATE 11/06
REVISIONS	APPROVED AEO	SCALE Noted	SHEET
			3 OF 12
E:\Veng\Northwest Medical Office\private swn.dwg			06-07-E602

NORTHWEST MEDICAL OFFICE AS-BUILTS 5-7-07
T.H./CED