




HAWTHORNE ADDITION

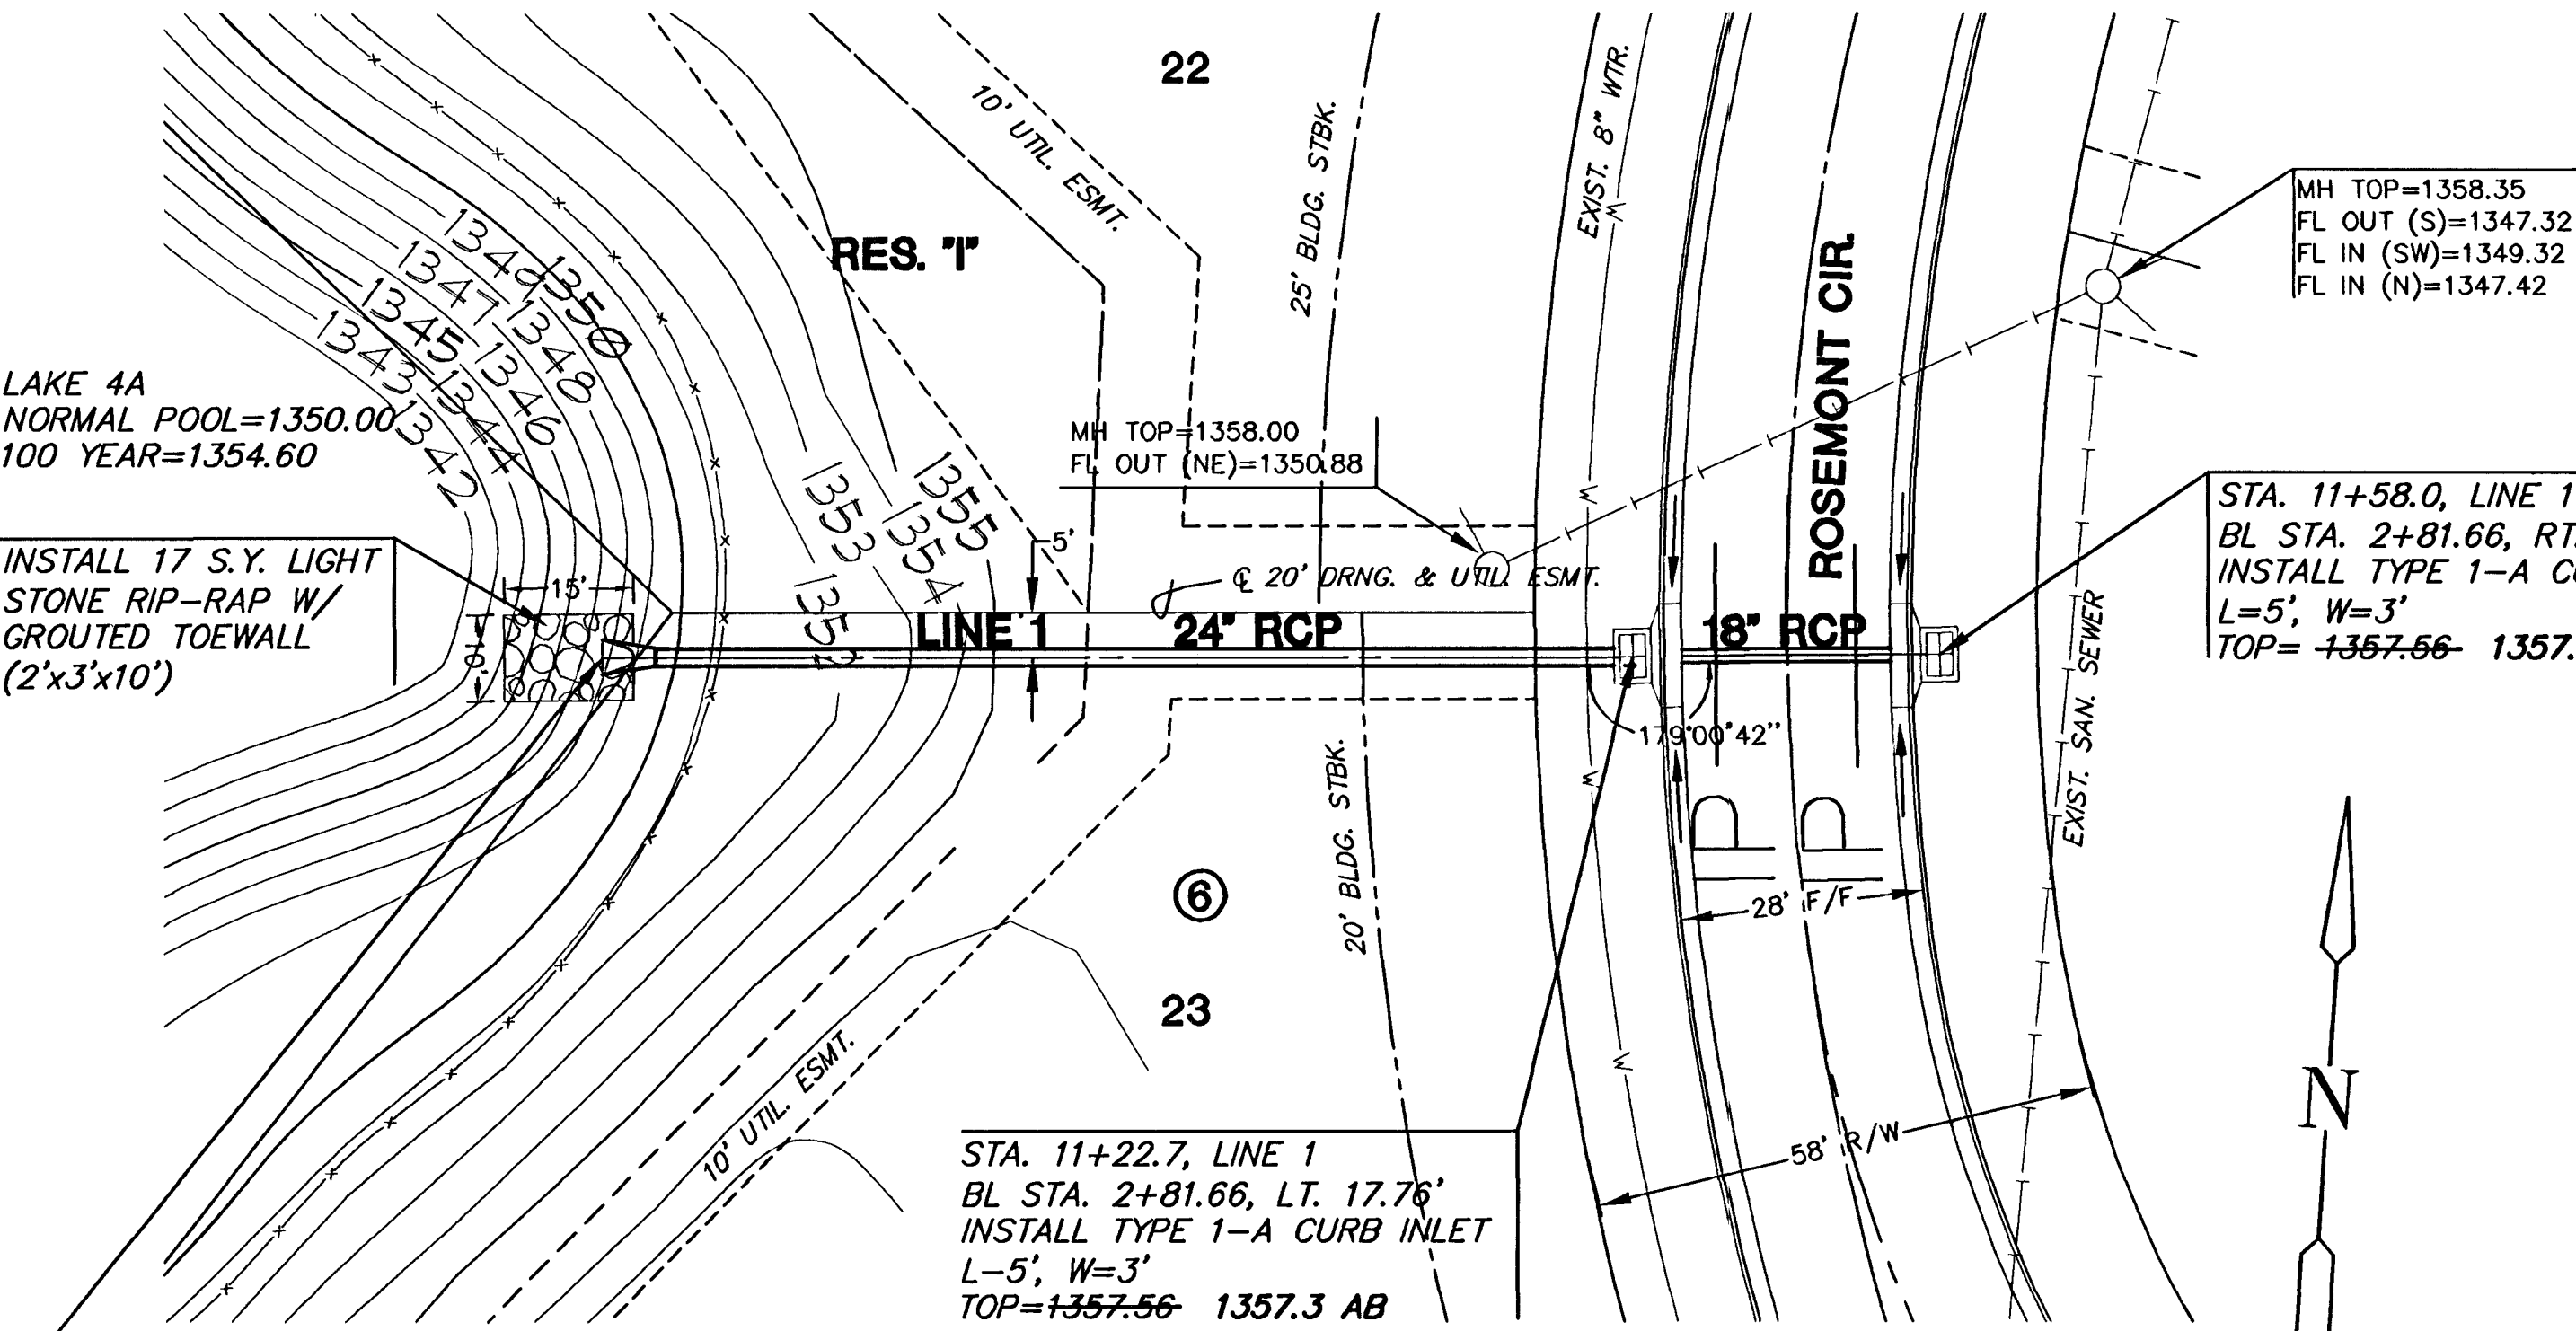

HAWTHORNE ADDITION

PLAN LINE 1


SCALE: 1"=20'

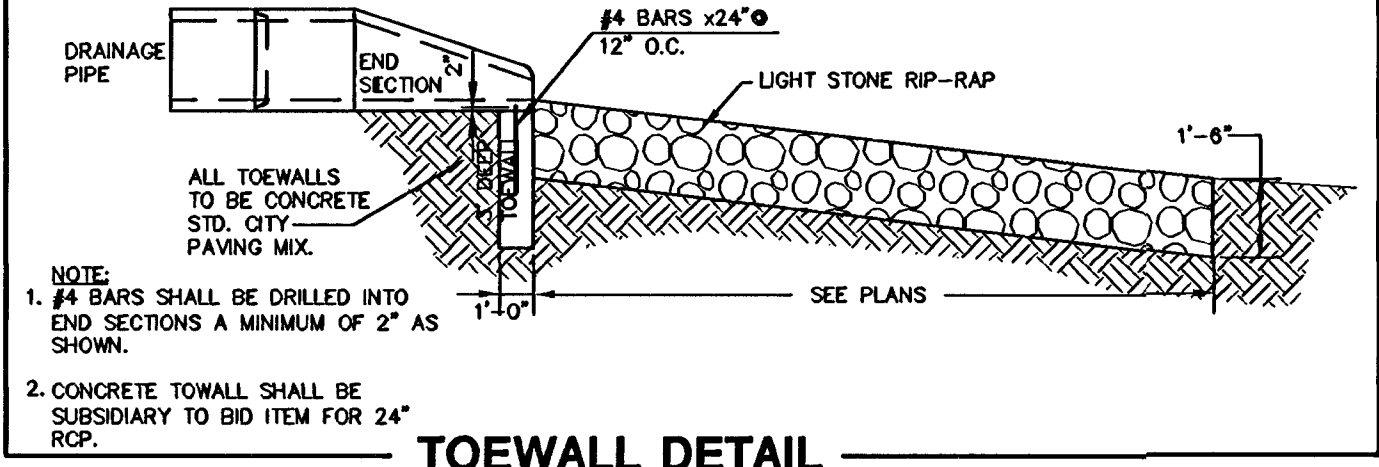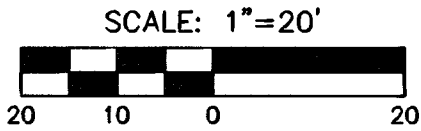

TOEWALL DETAIL

PROJECT NO. 141PPP
OCA NO. 607879

HAWTHORNE ADDITION
ROSEMONT CIRCLE
STORM WATER SEWER PLANS

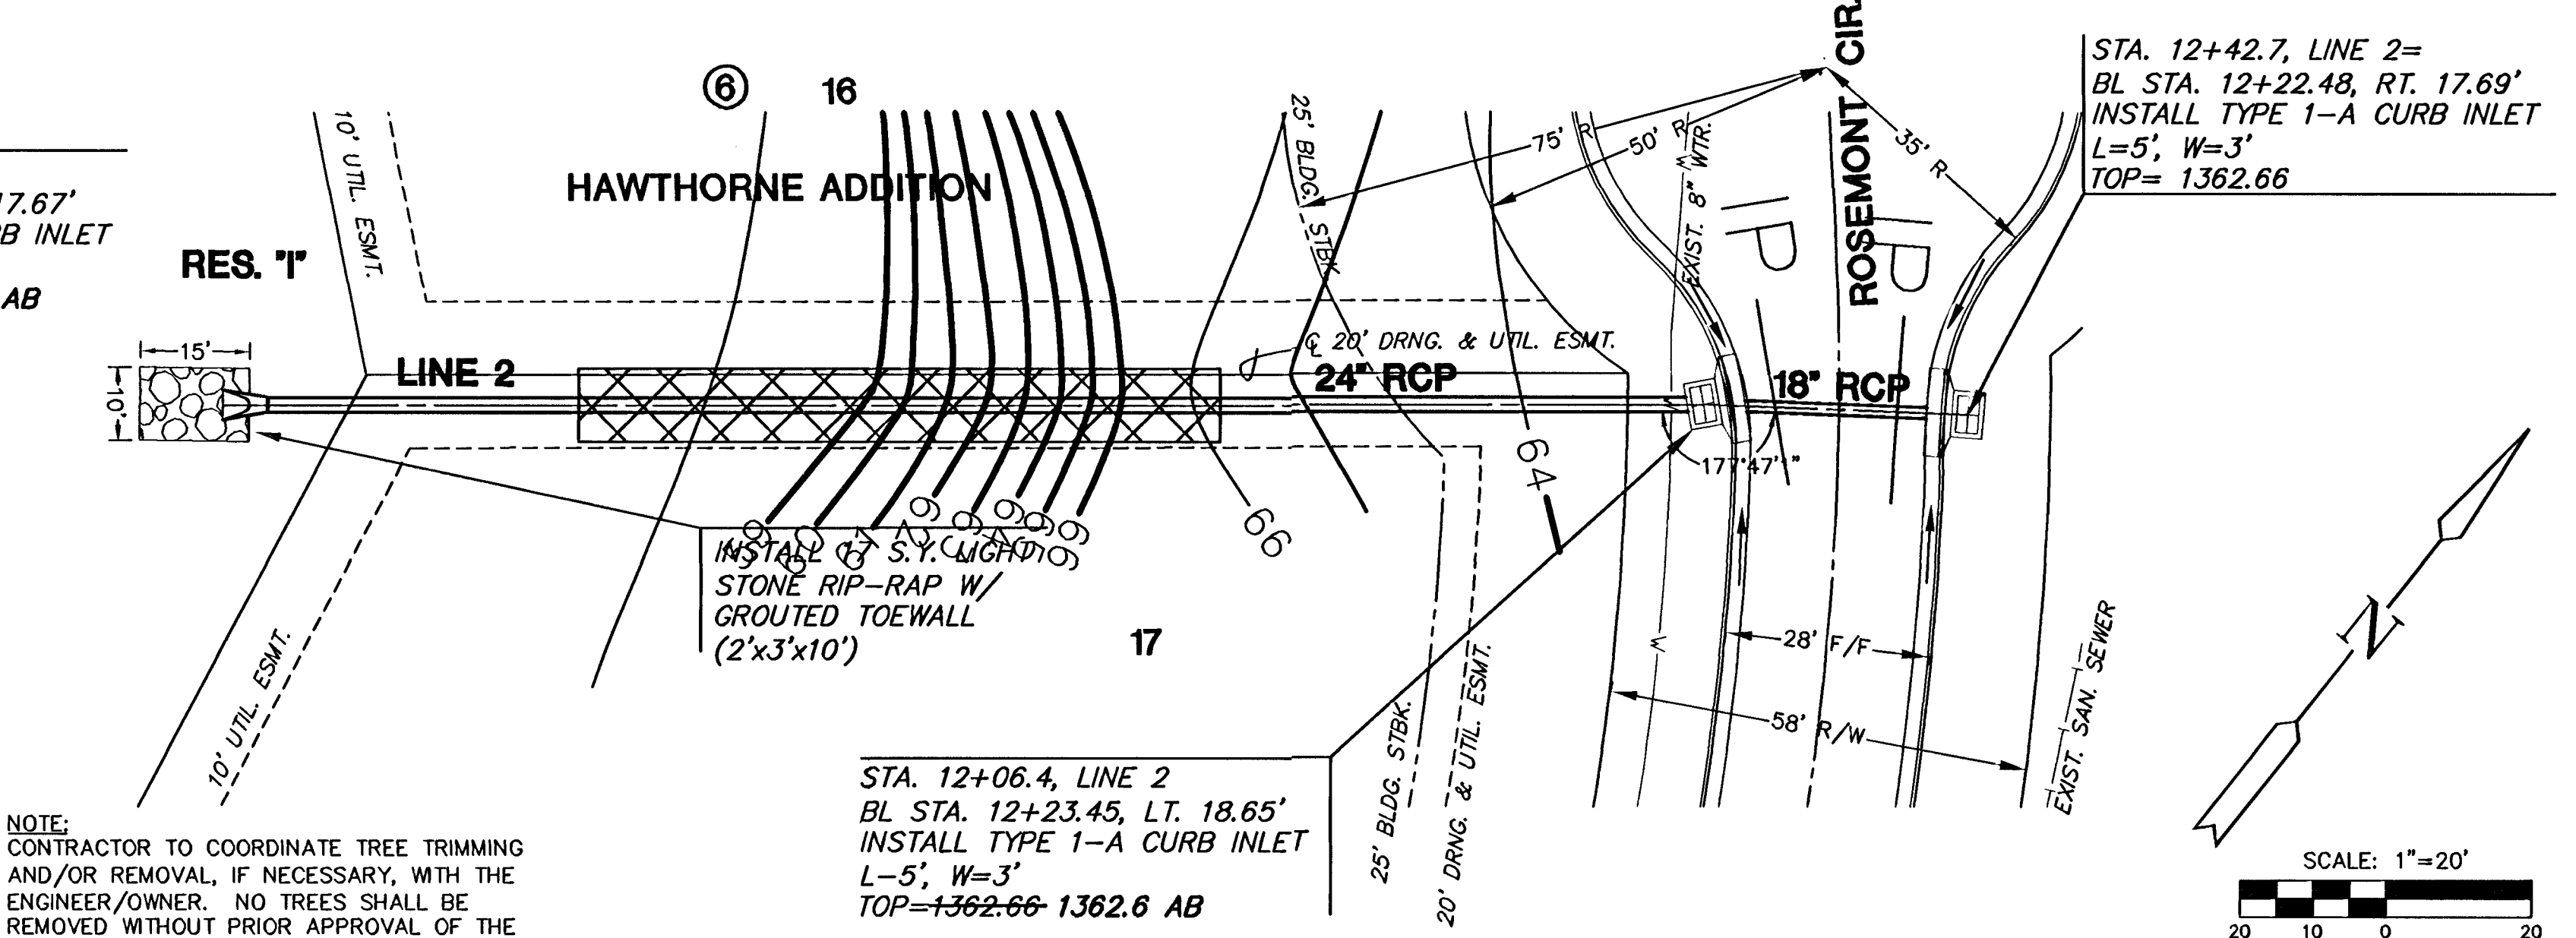


NOTE: CONTRACTOR TO COORDINATE TREE TRIMMING AND/OR REMOVAL, IF NECESSARY, WITH THE ENGINEER/OWNER. NO TREES SHALL BE REMOVED WITHOUT PRIOR APPROVAL OF THE ENGINEER OR OWNER.

- TREE REMOVAL


PLAN LINE 2

SCALE: 1"=20'

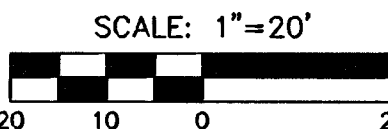


PROFILE LINE 1

SCALE: HORIZ. 1"=20'
SCALE: VERT. 1"=5'

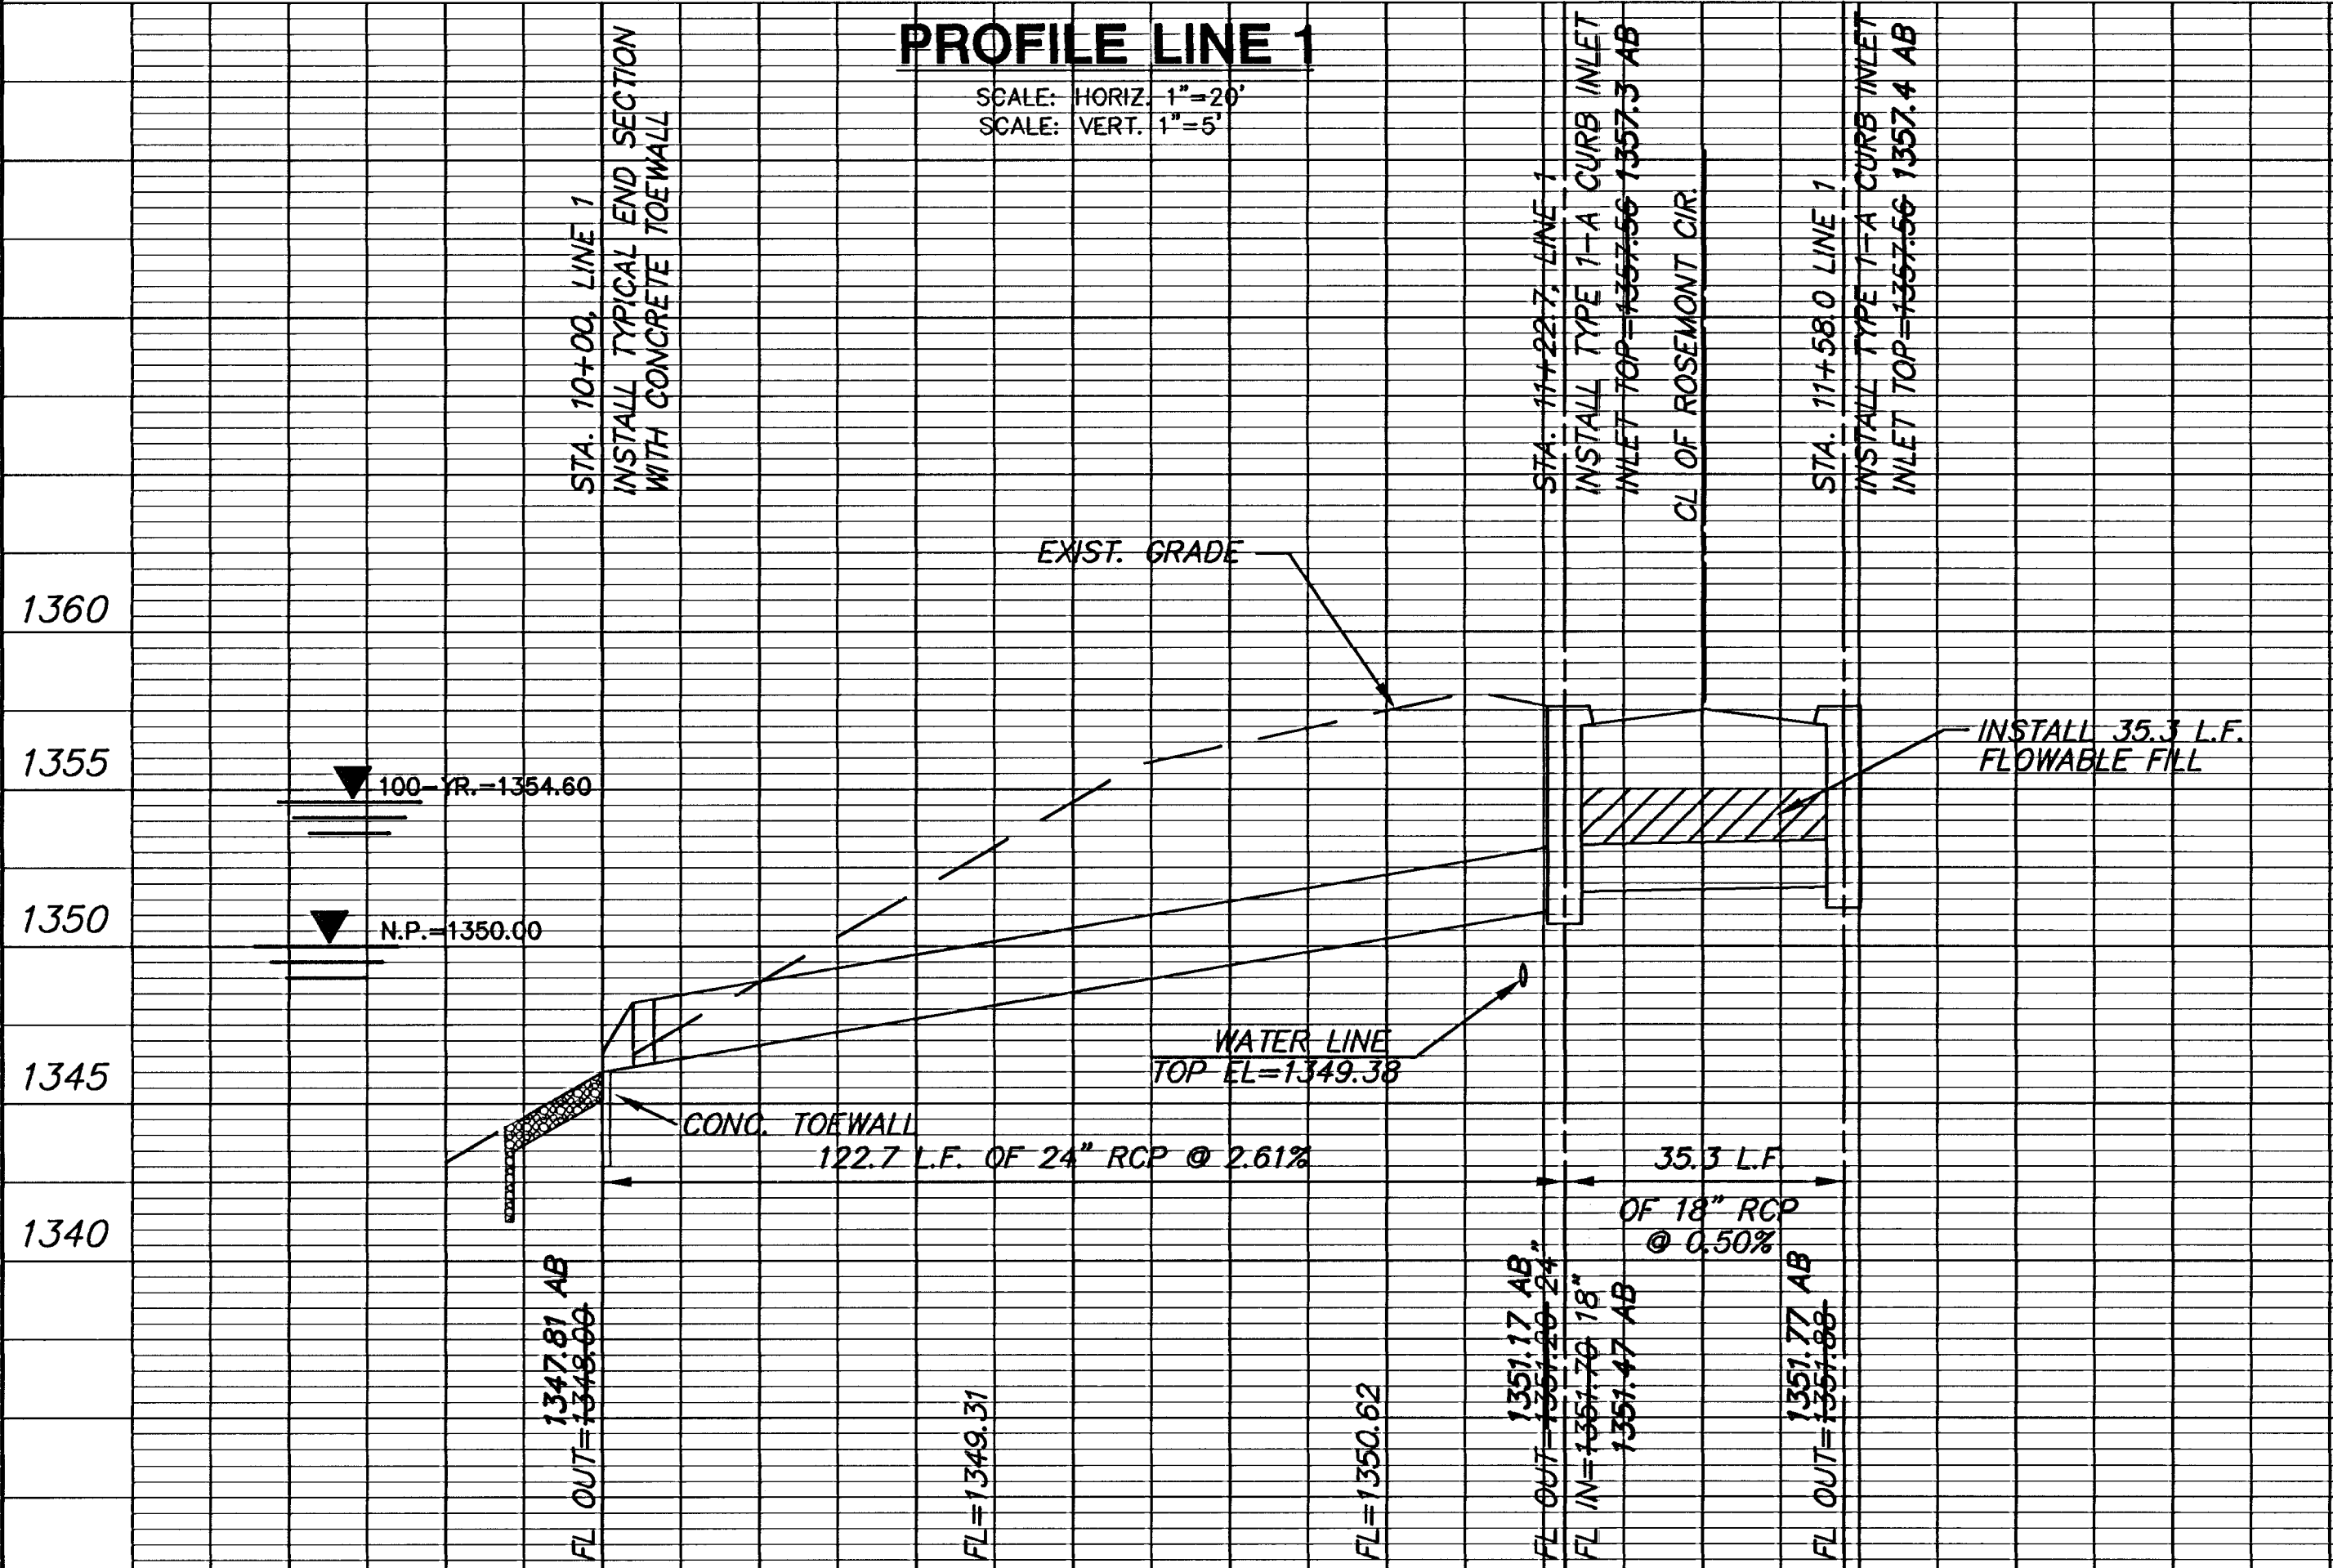

PROFILE LINE 2

SCALE: HORIZ. 1"=20'
SCALE: VERT. 1"=5'

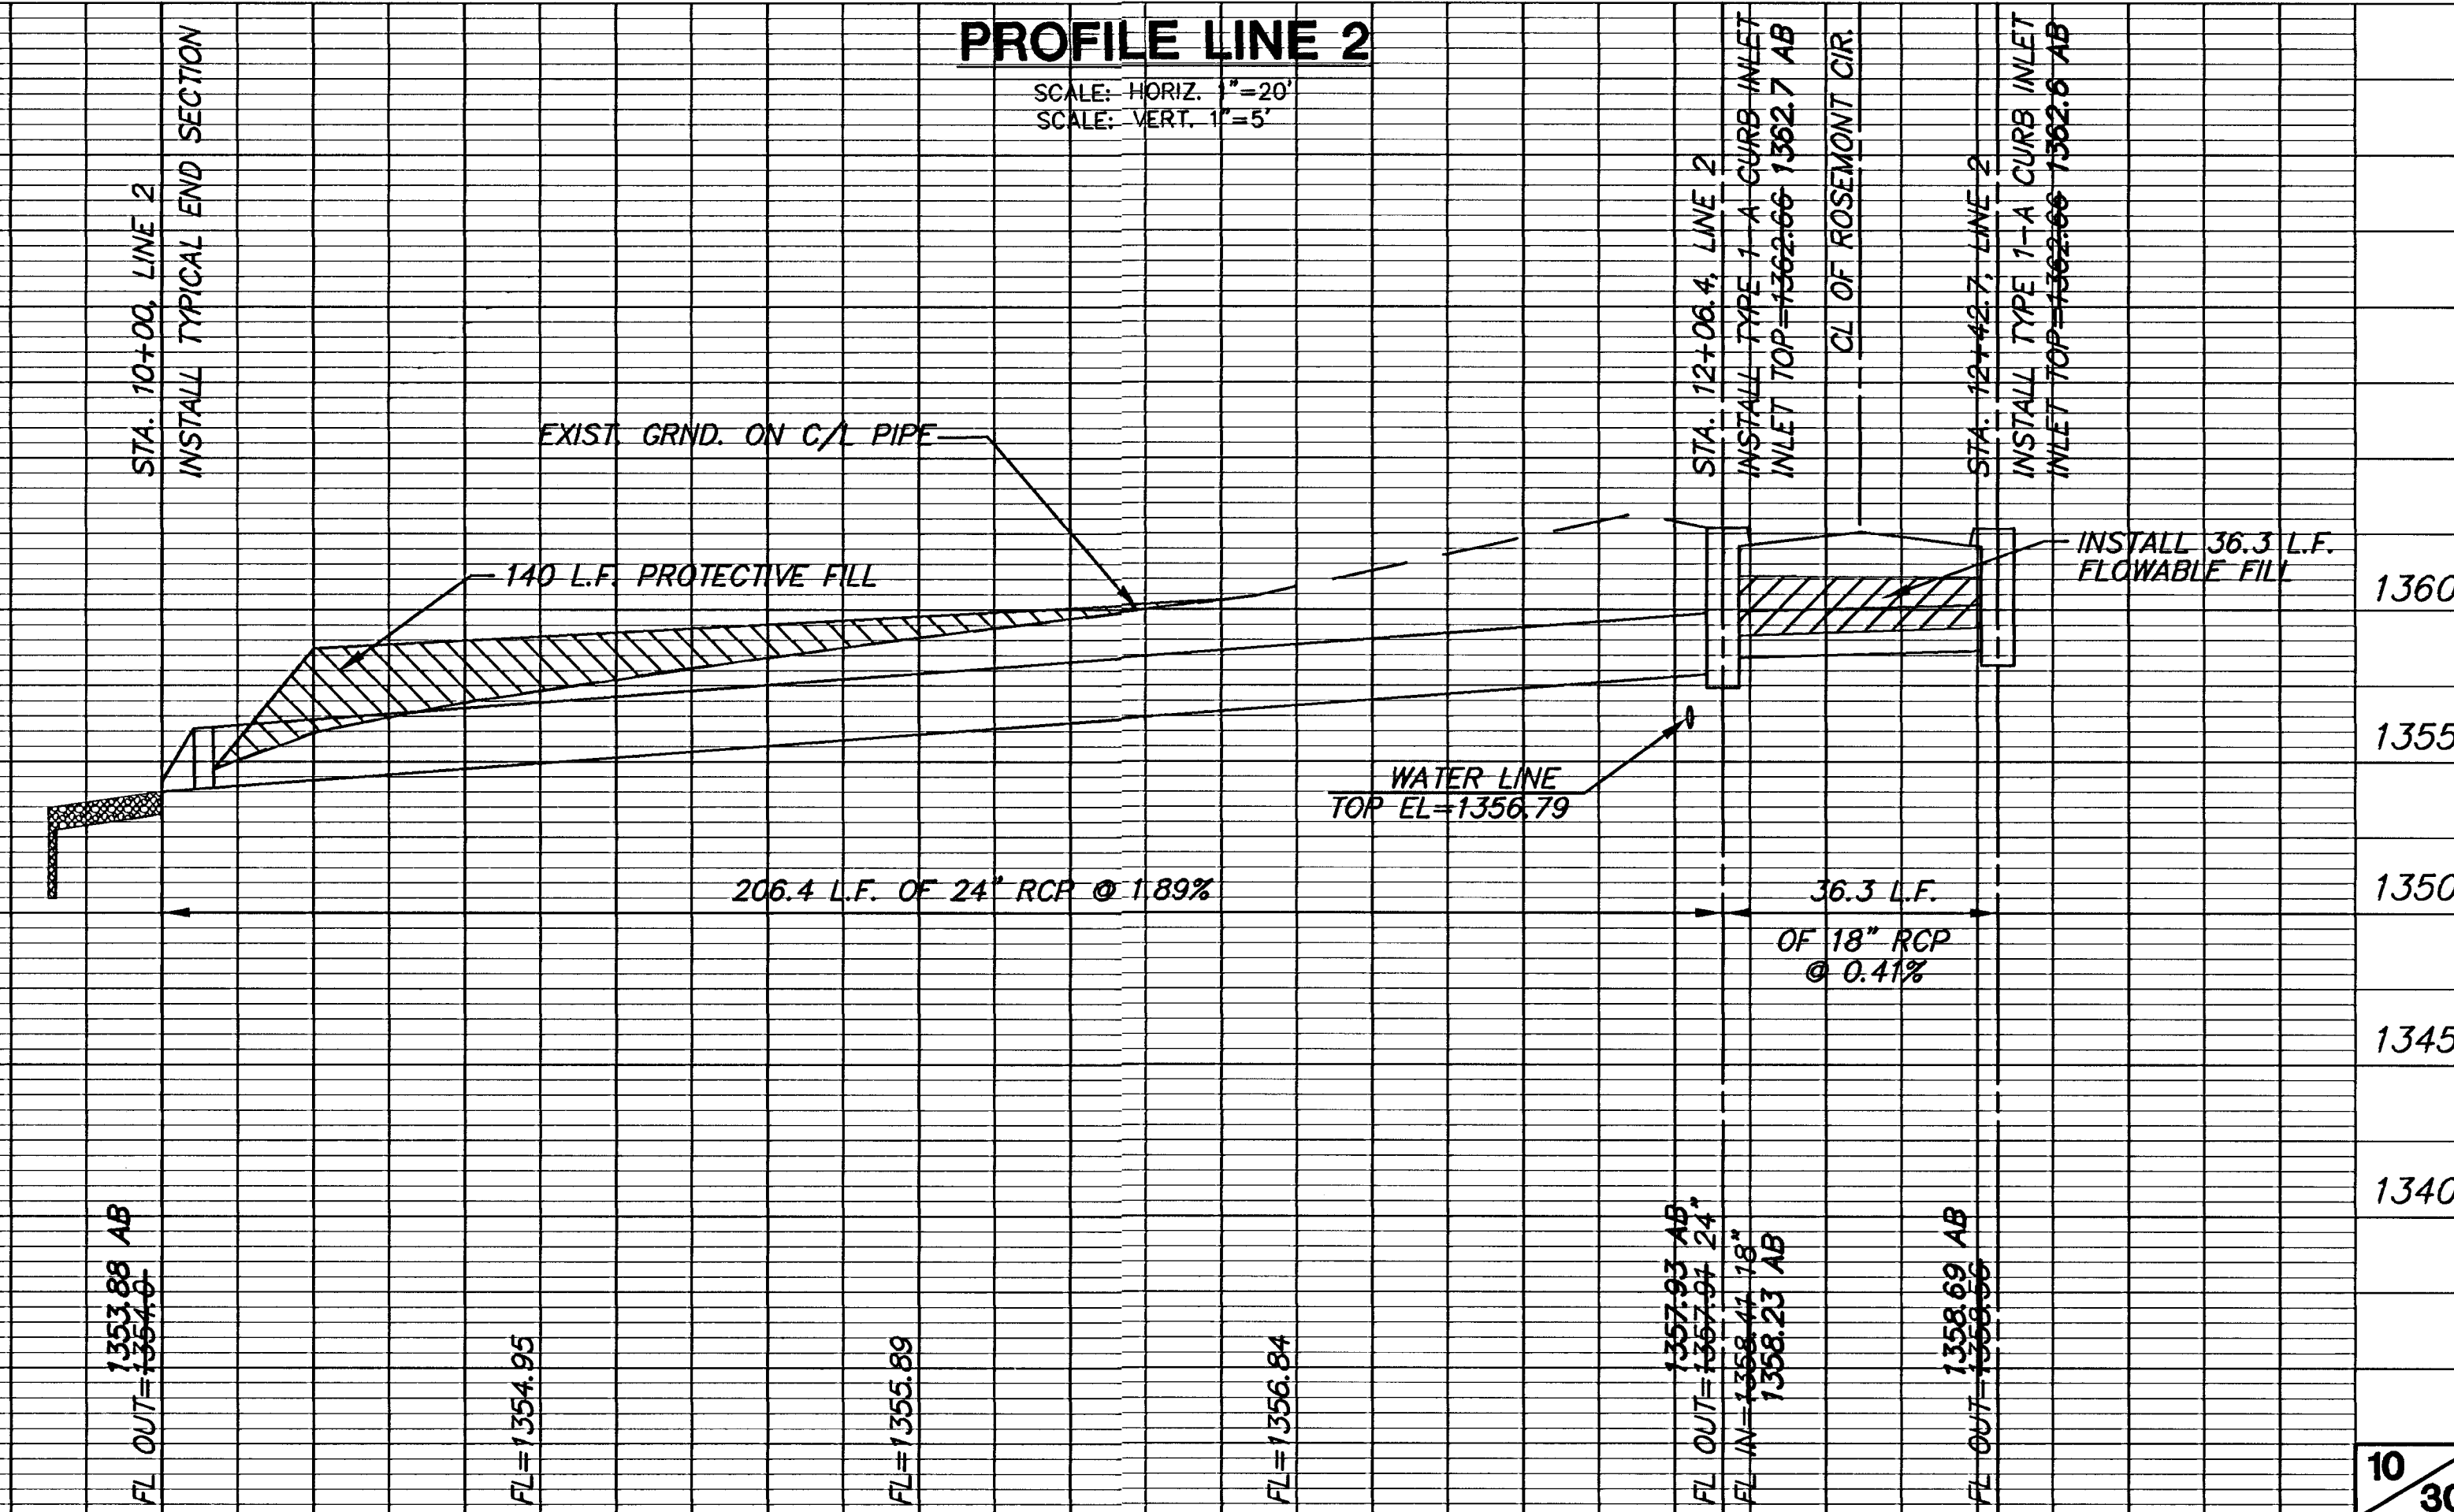

AS-BUILT MAY 2007