


TO SERVE

PALMETTO-FROM THE S.L. OF LOT 27, BLOCK 4 TO THE N.L. OF LOT 6, BLOCK 3
HAVENHURST-FROM THE E.L. OF PALMETTO TO THE E.L. OF LOT 1, BLOCK 3
SIDEWALK-ALONG THE EAST LINE OF PALMETTO AND THE S.L. OF HAVENHURST

CITY OF WICHITA PROJECT NO. 472-83838

JAMES L. ARMOUR, P.E. - CITY ENGINEER

THE COST OF THE BENCH MARK DISC, INCLUDING INSTALLATION, SHALL BE INCIDENTAL TO THE CURB

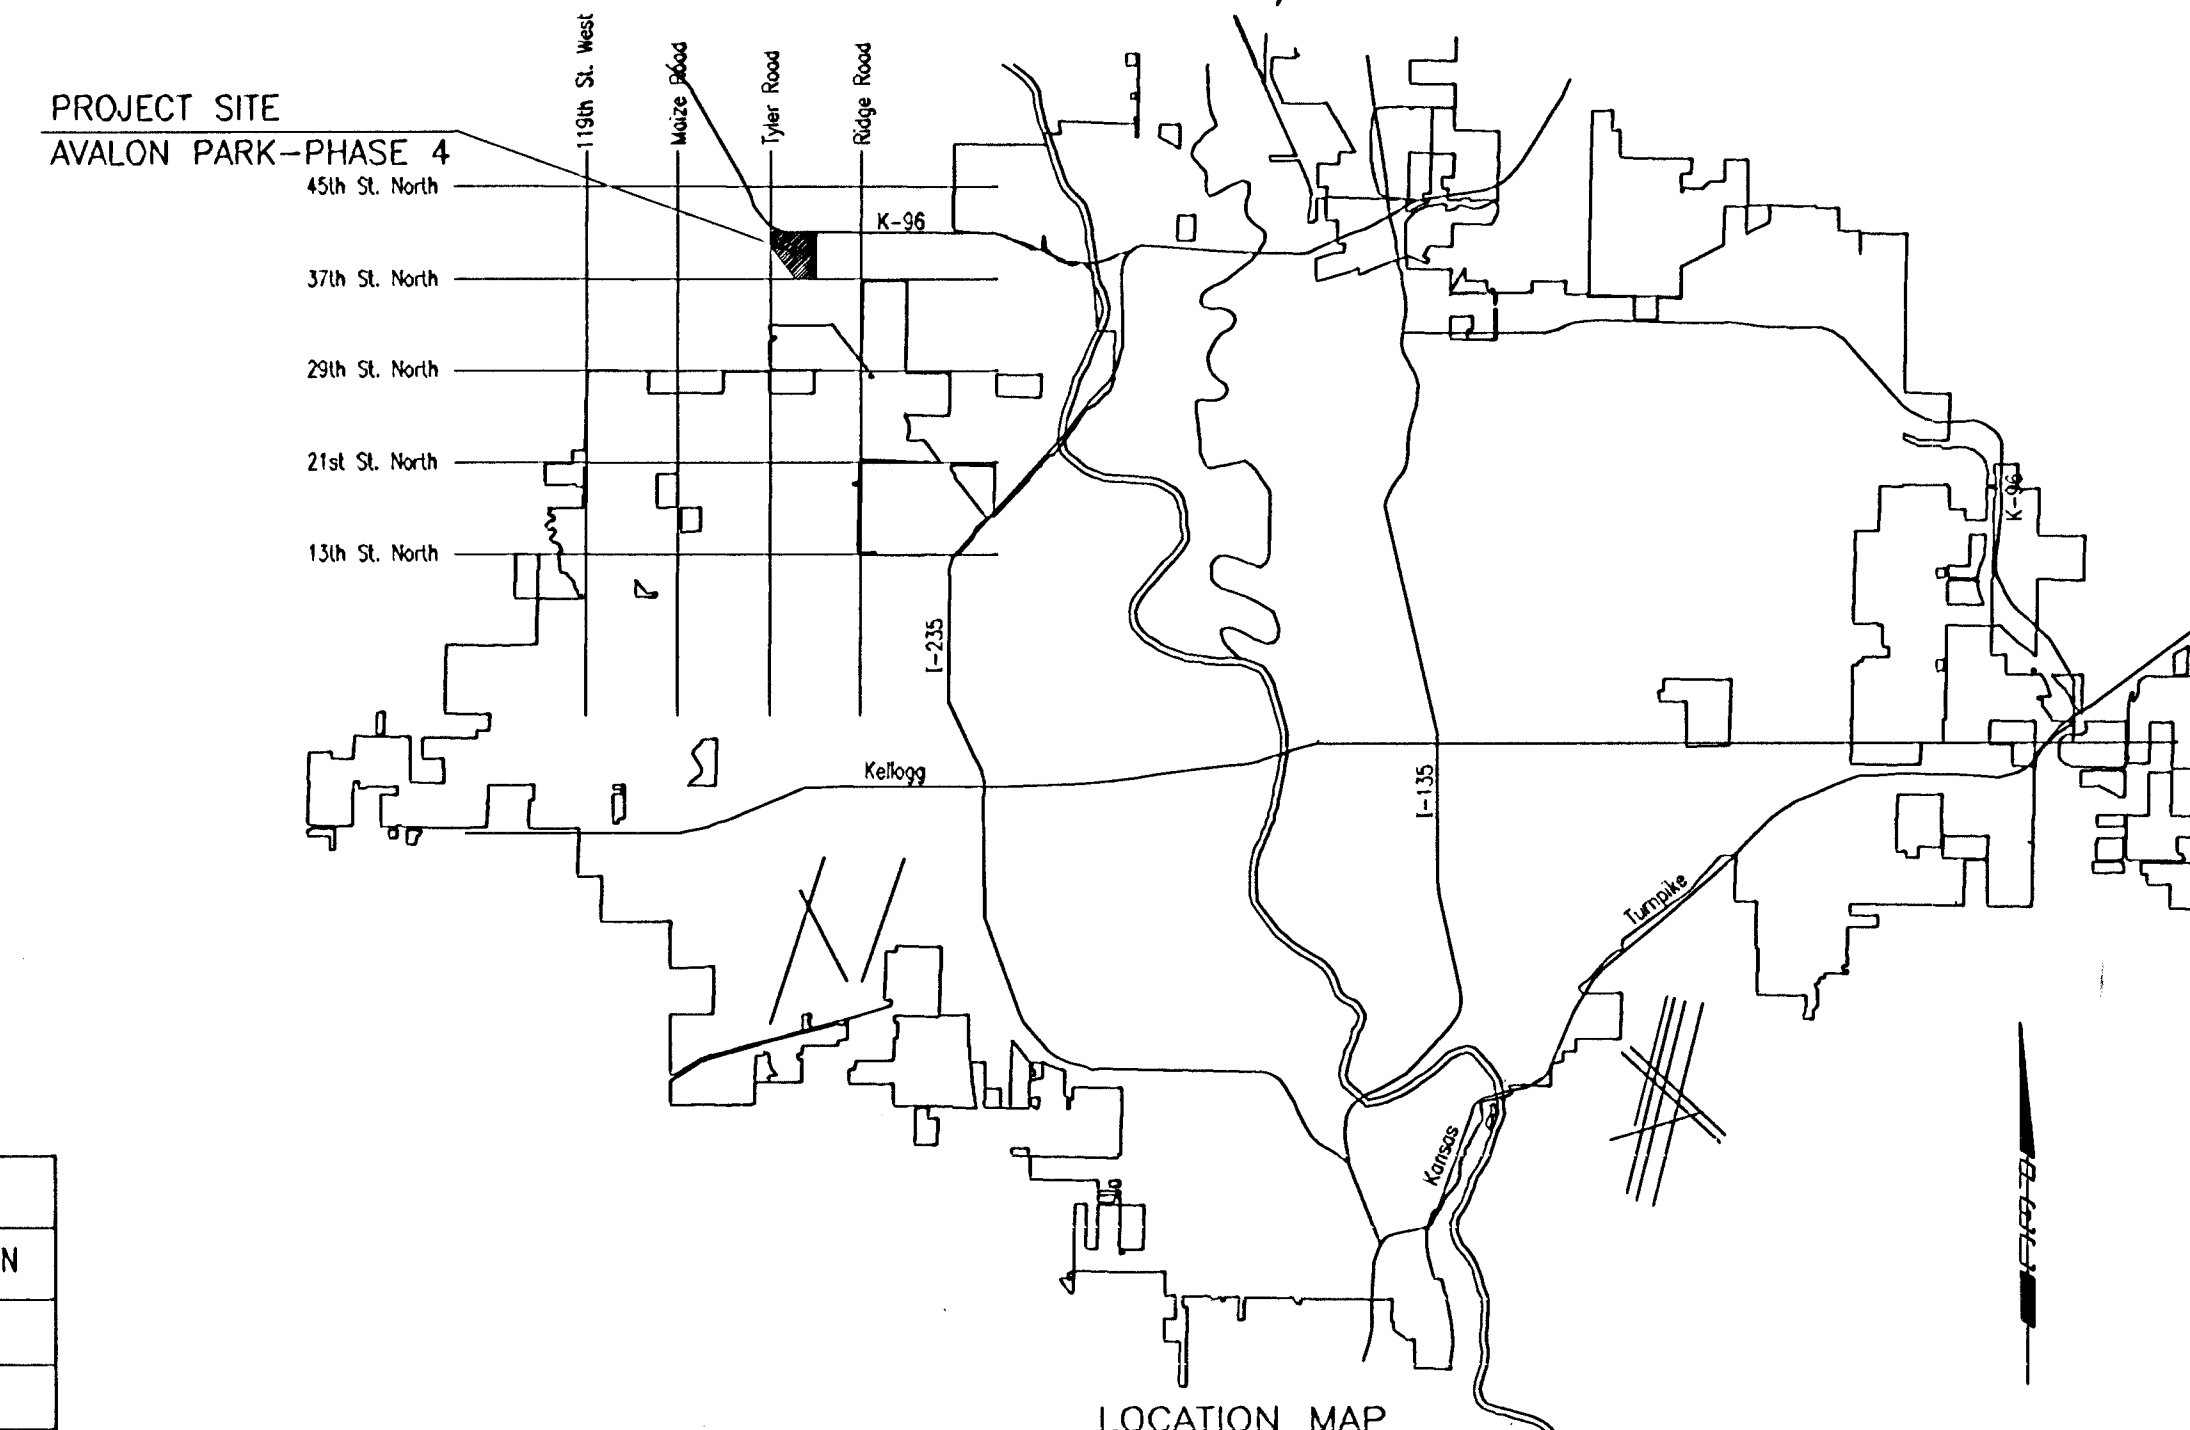

PLANS PREPARED BY

PROFESSIONAL ENGINEERING CONSULTANTS, P.A.
ENGINEERS
WICHITA, KANSAS

1. TITLE SHEET
2. KEY MAP AND GENERAL NOTES
3. PLAT
4. FOUR CORNER LOT GRADING PLAN
5. SITE GRADING PLAN
6. TYPICAL 35' BK.-BK. PAVEMENT DETAILS
- 7-8. PAVING PLAN-PALMETTO
9. PAVING PLAN-HAVENHURST
10. VALLEY GUTTER DETAILS
11. MISCELLANEOUS PAVING DETAILS
12. EROSION CONTROL PLAN
- 13-16. EROSION CONTROL DETAILS
17. SIGNING DETAILS
- 18-22. CROSS SECTIONS

STORM WATER DRAINS NO. 264 AND 265
(468-84011 SWD NO. 264; 468-84012 SWD NO. 265)
THE CONTRACTOR SHALL SEQUENCE HIS WORK TO COMPLETE STORM WATER DRAINS NO. 264
AND 265 BY OCTOBER 19, 2005.

RECORD DRAWING

