



SCALE: 1"=20'

WATER VALVE BOX ELEVATIONS			
STREET	STATION	OFFSET	PROPOSED ELEVATION
PALMETTO	60+54.06	23.0' LT.	152.6
PALMETTO	60+57.06	26.0' LT.	152.7

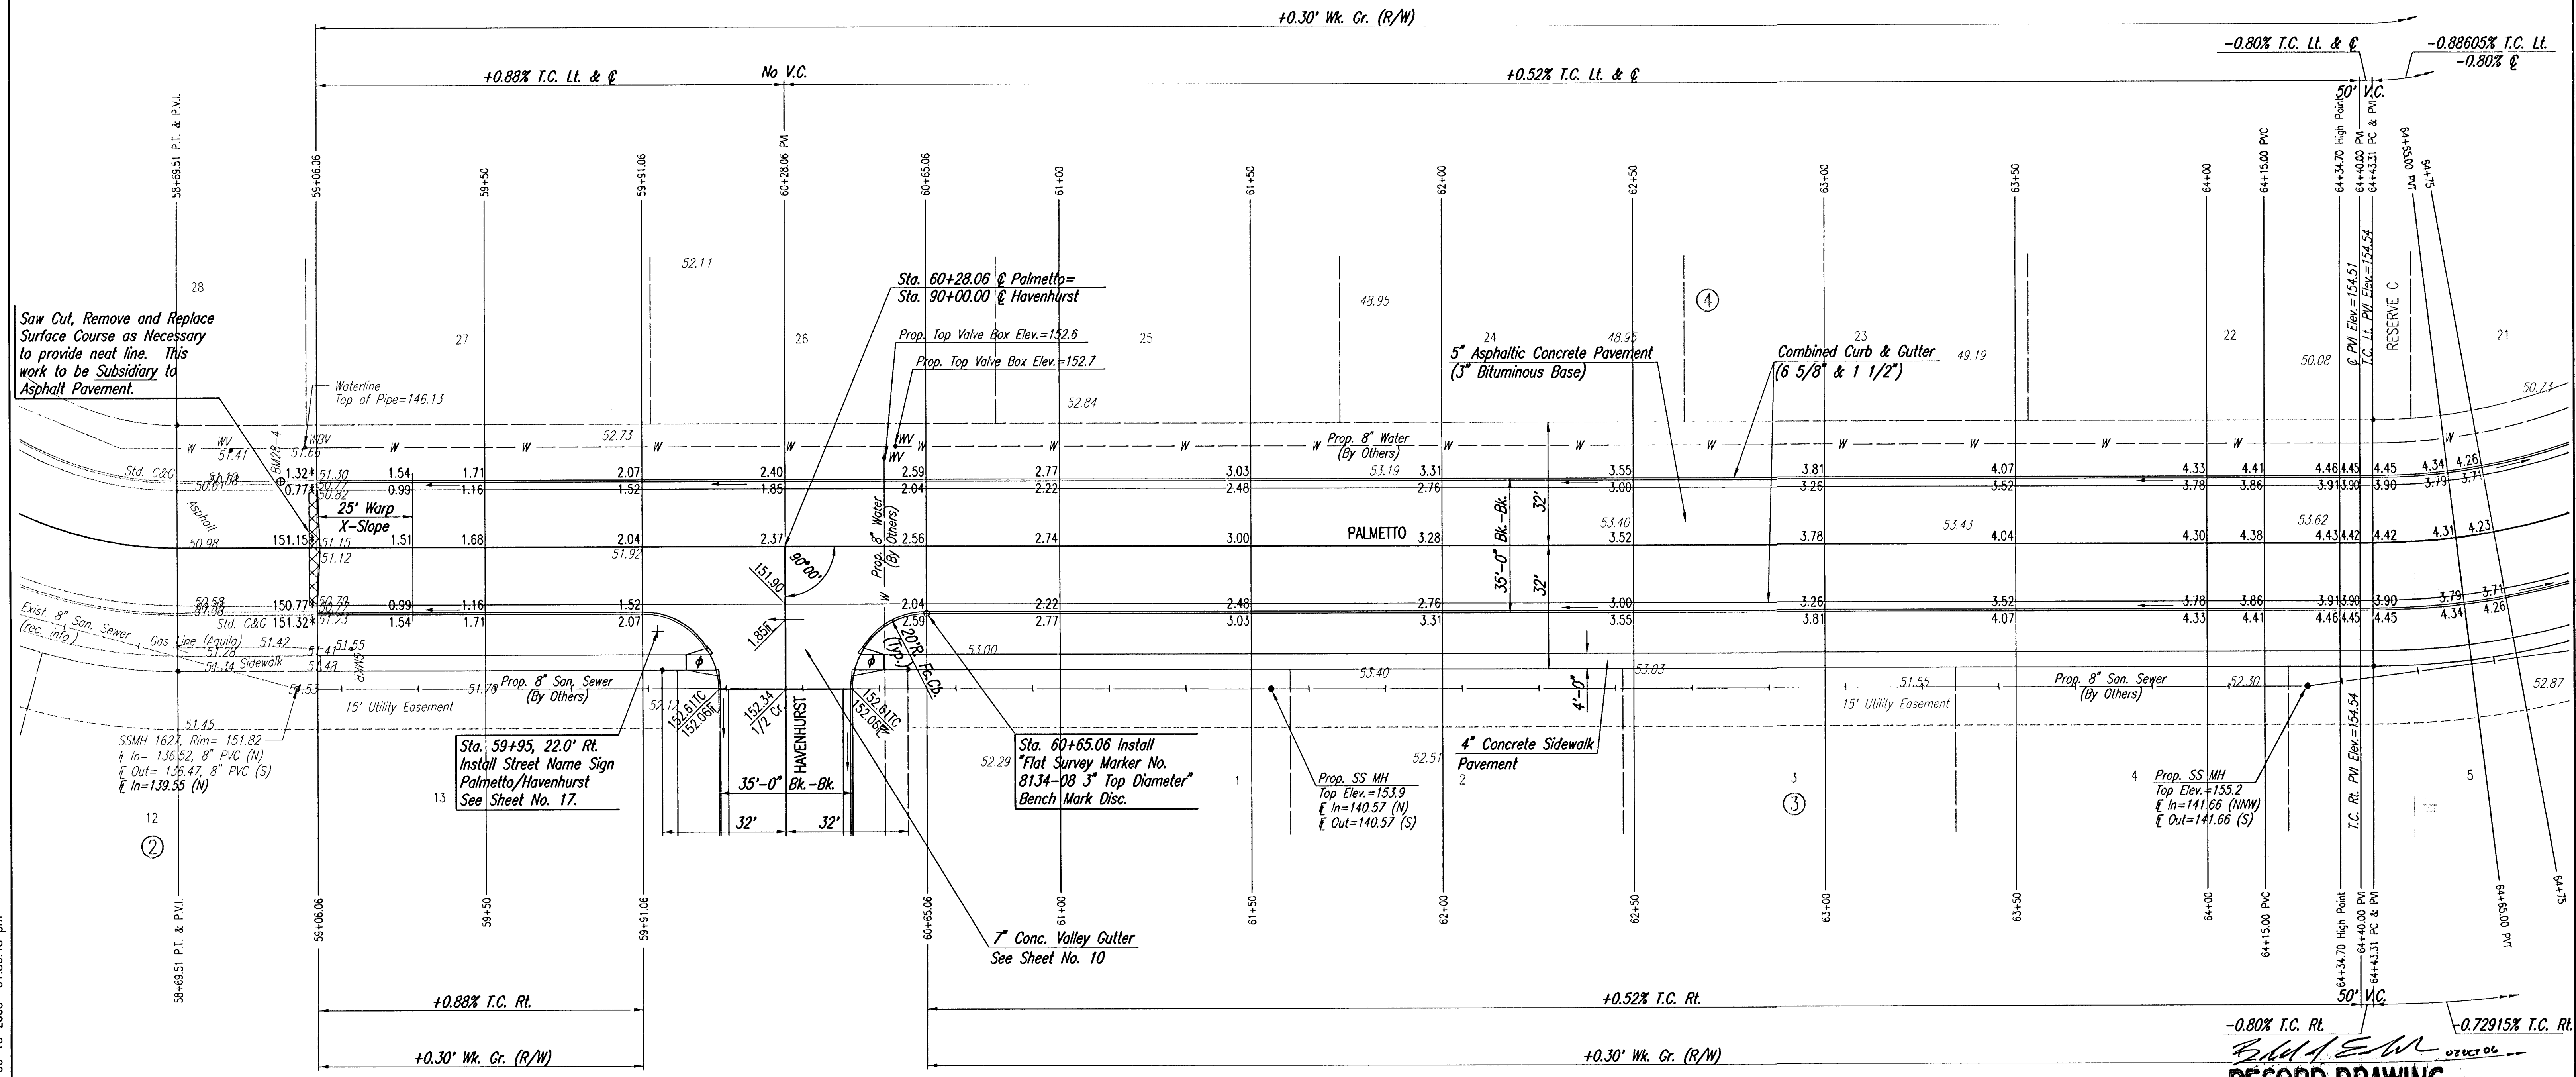

RECORD DRAWING

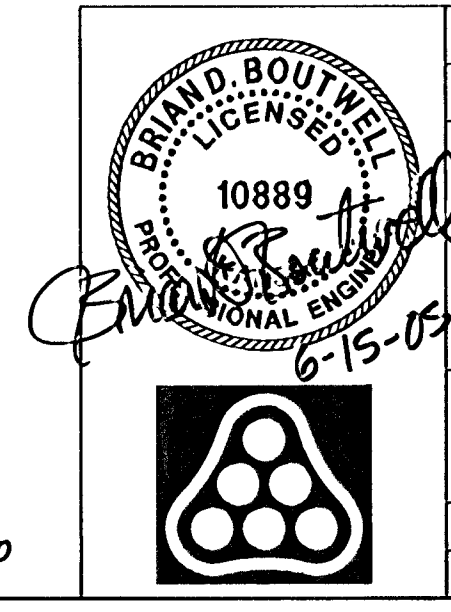

Revision		By	Date
AVALON PARK-PHASE 4			
PALMETTO			
STA. 59+06.06 TO STA. 64+43.31			
JAMES L. ARMOUR, P.E.-CITY ENGINEER			
CITY OF WICHITA PROJECT NO. 472-83838			
Professional Engineering Consultants, P.A.			
303 S. TOPEKA • WICHITA, KANSAS 67202			
316-262-2691 • FAX 316-262-3003			
Designed by	BDB, BLB	Job No.	35-05059-000
Drawn by	BJS	Date	February 2005
		Sheet	7 of 22

* Match Existing
* Construct Std. Wheelchair Ramp