



CONTRACTION JOINT
(C.J.)

4" WALK DETAILS

(TYPE A)
STANDARD WHEELCHAIR RAMP
WITH DETECTABLE WARNING
CONSTRUCTION DETAIL FOR STREETS
WITH COMBINED CURB & GUTTER

NOTE: RAMPS TO COMPLY WITH LATEST ADAAG GUIDELINES. 

PAVESTONE DETECTABLE WARNING PAVERS (OR AN APPROVED EQUAL) SHALL BE USED IN ALL WHEELCHAIR RAMPS. THE RED PAVER SHALL BE INSTALLED USING A BASKET WEAVE/PARQUET PATTERN. OTHER PATTERNS MAY BE USED WITH APPROVAL OF ENGINEER. SAND FILL JOINTS. ALIGN DOMES IN THE DIRECTION OF PEDESTRIAN TRAVEL.


SECTION B-B

DOME DETAIL

TYPICAL WHEELCHAIR RAMP DETAILS

AUGUST 4, 2003

E. M. Shaw
02 047 20
RECORD DRAWING

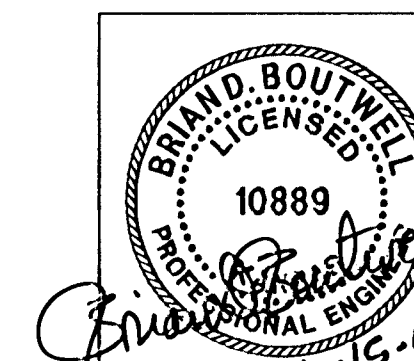

No.	Revision	By	Date
AVALON PARK-PHASE 4			
MISCELLANEOUS PAVING DETAILS			
JAMES L. ARMOUR, P.E.-CITY ENGINEER CITY OF WICHITA PROJECT NO. 472-83838			
<u>Professional Engineering Consultants, P.A.</u>			
303 S. TOPEKA • WICHITA, KANSAS 67202 316-262-2691 • FAX 316-262-3003			
Designed by	BDB, BLB	Job No.	35-05059-000
Drawn by	BJS	Date	February 2005
			Sht. 11 of 22