


PLAN	CHECKED	BY	DATE
	CHECKED		

PROFILE	CHECKED	BY	DATE
	CHECKED		

DSNR: BLB OPER. BUS SCALE: 1"=20.00
Q:\2005\05160\000\05160-000-C-SWSLINE 06-13-2005 09:48:47 am

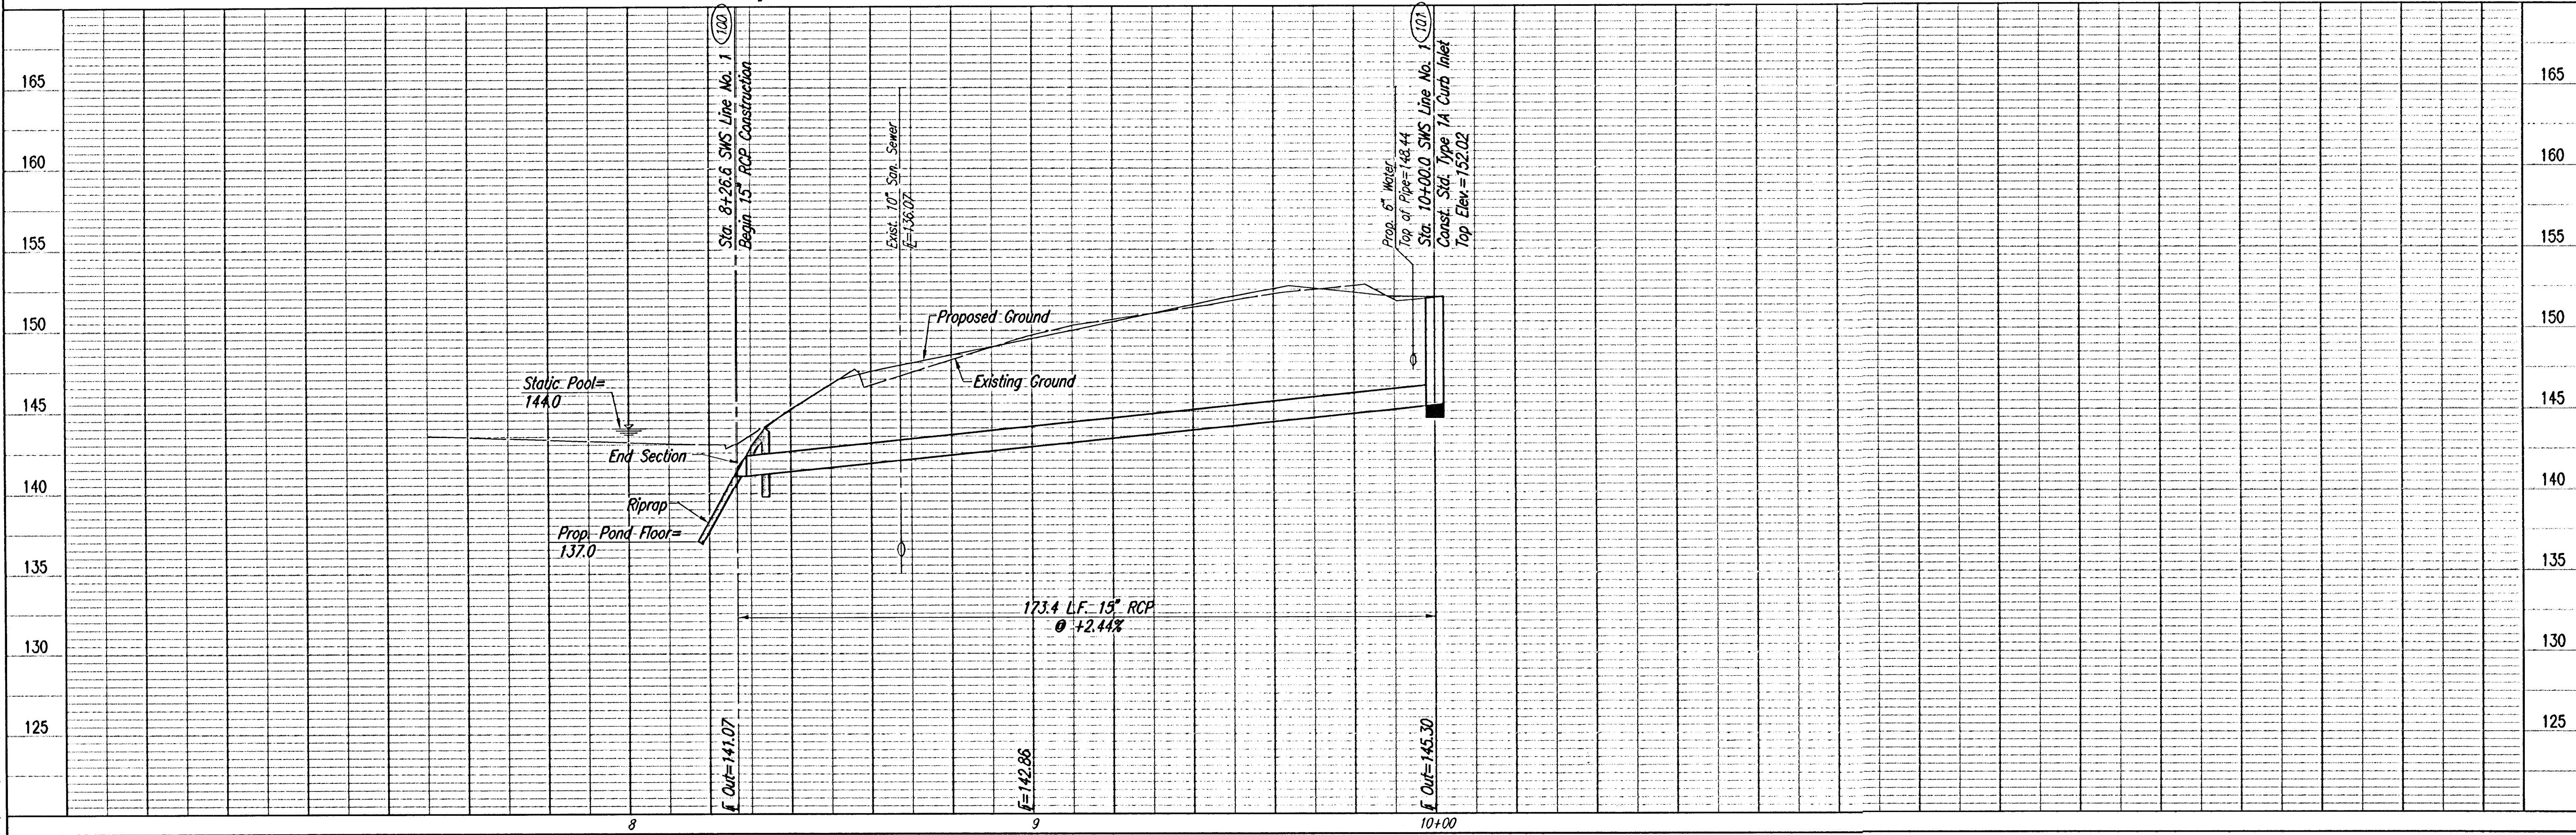

SWD #265 (By Others)
(COW Proj. No. 468-84012)
Static Pool=144.0
DWS₁₀₀=146.6

Install 16 S.Y.
Light Stone Riprap
See Sheet No. 11.

Sta. 71+32.27 @ Palmetto Cir.=
Ctr. of Cul-de-sac

CAUTION !!!
Existing 10" San. Sewer
City of Wichita

CAUTION !!!
Proposed 6" Water
City of Wichita

Sta. 10+00.0 SWS Line No. 1
Const. Std. Type 1A Curb Inlet
L=5'-0", W=3'-0"
Top Elev.=152.02
See Sheet No. 9.

Excavate Only as Necessary for Installation
of RCP and Riprap. At Contractor's option,
timing of Riprap placement may be Coordinated
with SWD #265 Contractor.

See Title Sheet for Construction
Schedule/Sequence Note.

COORDINATE LIST		
POINT	NORTH	EAST
100	10,955.2641	11,074.6436
101	11,094.1245	11,178.4961

(100) = COORDINATE POINT NO.
SEE SHEET NO. 3 FOR PLAT COORDINATES

RECORD DRAWING
6-15-05
BRIAN D. BOUTWELL
10889
LICENSED PROFESSIONAL ENGINEER

AVALON PARK-PHASE 3
SWS LINE NO. 1

Professional Engineering Consultants, P.A.
303 S. TOPEKA • WICHITA, KANSAS 67202
316-262-2691 • FAX 316-262-3003

JAMES L. ARMOUR, P.E.-CITY ENGINEER
CITY OF WICHITA PROJECT NO. 477-3337

Designed By: BDB, BLB
Drawn By: BUS
Job No.: 35-05160-000
Date: February 2005