



BENCHMARKS:
 BM #1: "□" Cut in top of curb, east return of SE corner of Lotus & Parkridge.
 Elev. = 145.99 (City Datum)
 BM #2: "X" Cut on walk at NW corner of Lot 1, Block F, Flat Creek Addition.
 Elev. = 146.22 (City Datum)
 BM #3: "□" Cut in top of curb at the NW corner of Lot 1, Block B, Hunter's Ridge Addition.
 Elev. = 146.63 (City Datum)

FLAT CREEK ADDITION

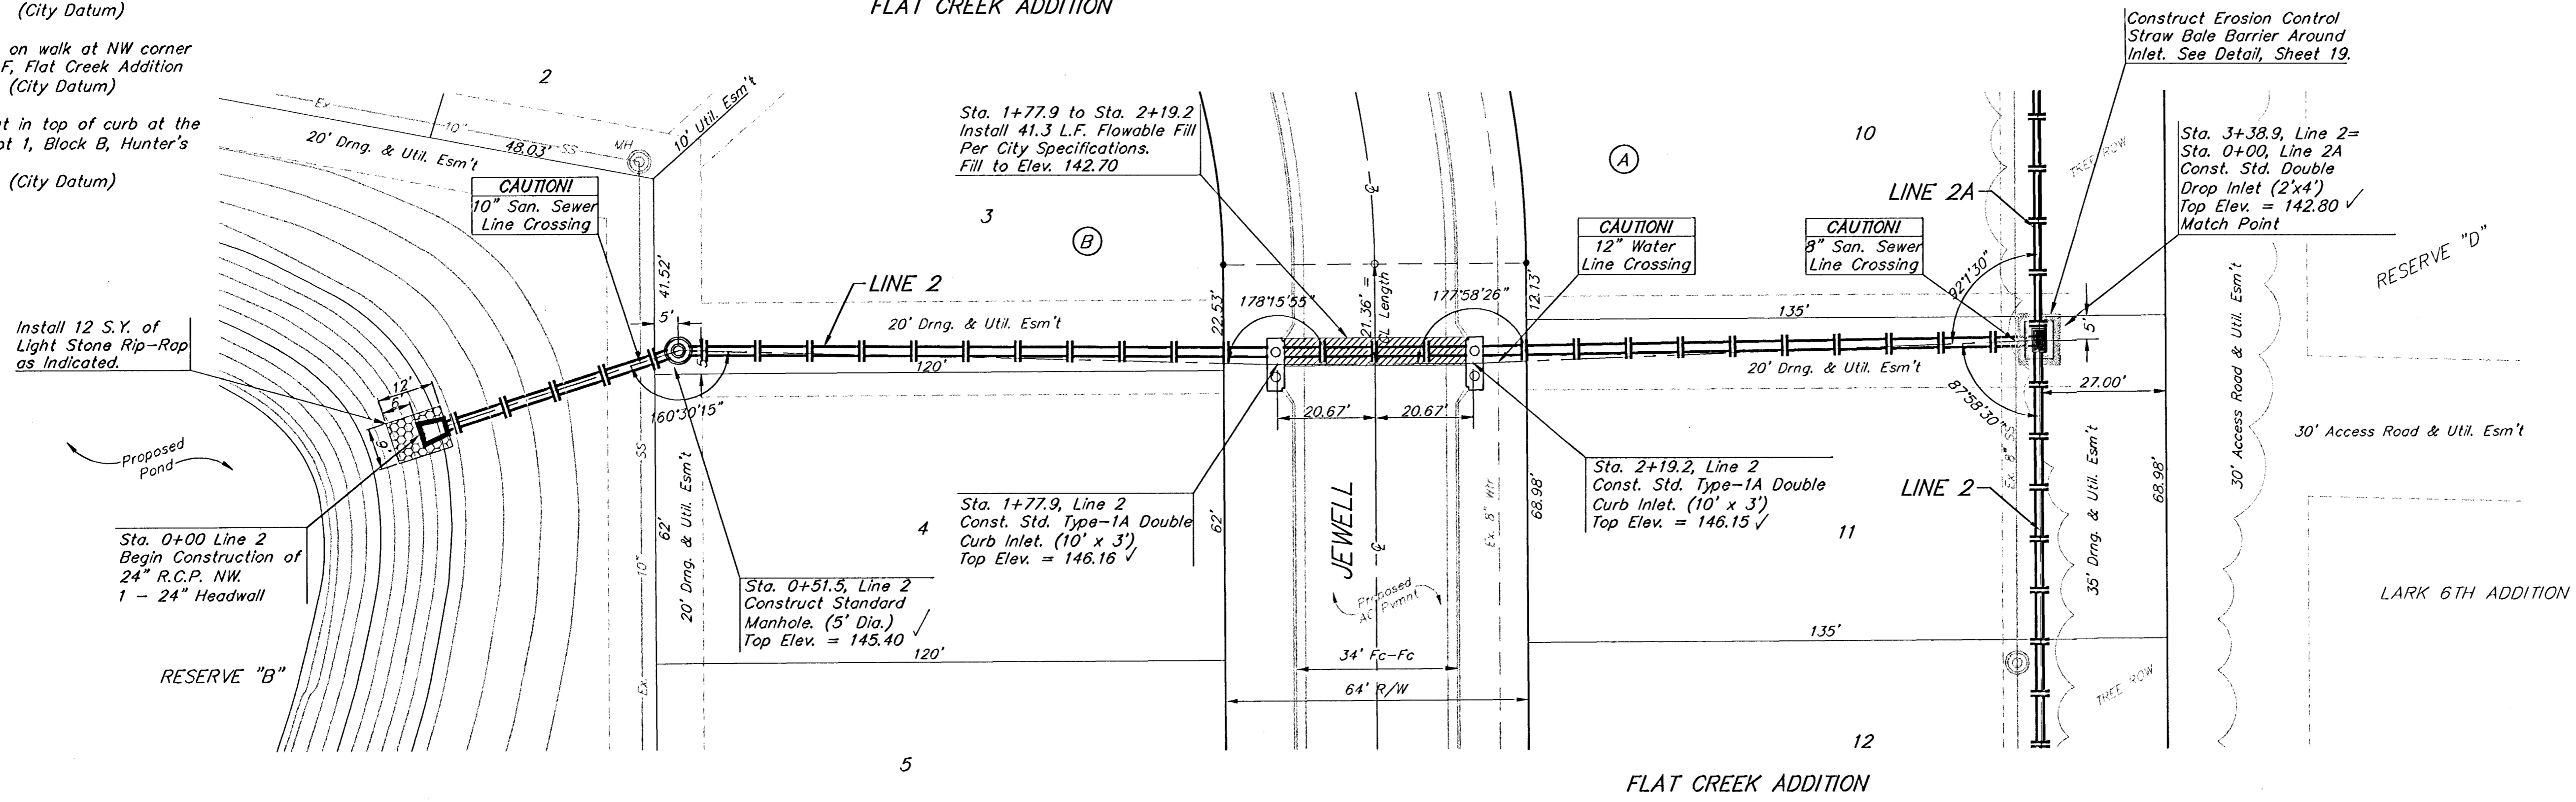

SCALE:
 1" = 20' HORIZONTAL
 1" = 5' VERTICAL
 • = IRON

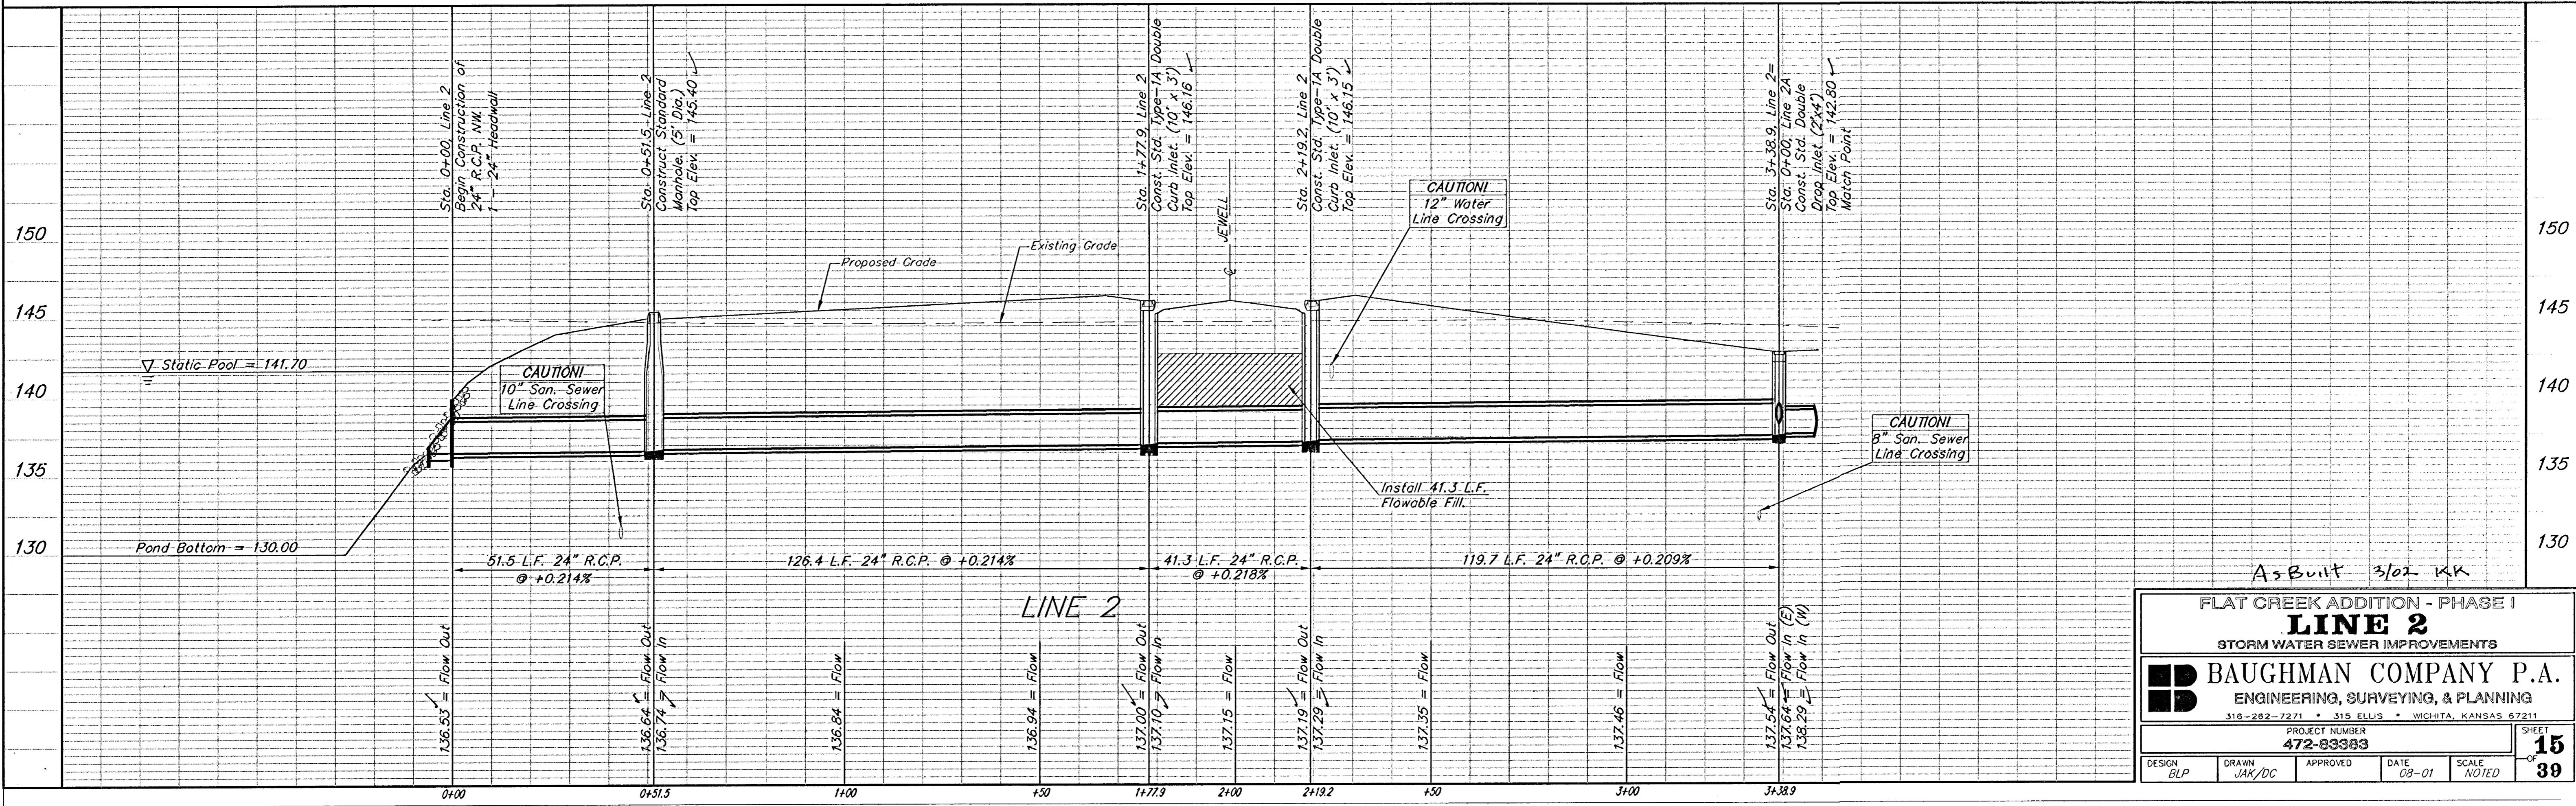

As Built 3/02 MK

FLAT CREEK ADDITION - PHASE I
LINE 2
 STORM WATER SEWER IMPROVEMENTS

BAUGHMAN COMPANY P.A.
 ENGINEERING, SURVEYING, & PLANNING
 316-282-7271 • 315 ELLIS • WICHITA, KANSAS 67211

PROJECT NUMBER: 472-83383

DESIGN: BLP	DRAWN: JAK/DC	APPROVED:	DATE: 08-01	SCALE: NOTED
-------------	---------------	-----------	-------------	--------------

SHEET 15 OF 39