



**BENCHMARKS:**  
 BM#1: "□" Cut in top of curb, east return of SE corner of Lotus & Parkridge.  
 Elev. = 145.99 (City Datum)

BM #2: "X" Cut on walk at NW corner of Lot 1, Block F, Flat Creek Addition  
 Elev. = 146.22 (City Datum)

BM #3: "□" Cut in top of curb at the NW corner of Lot 1, Block B, Hunter's Ridge Addition.  
 Elev. = 146.63 (City Datum)

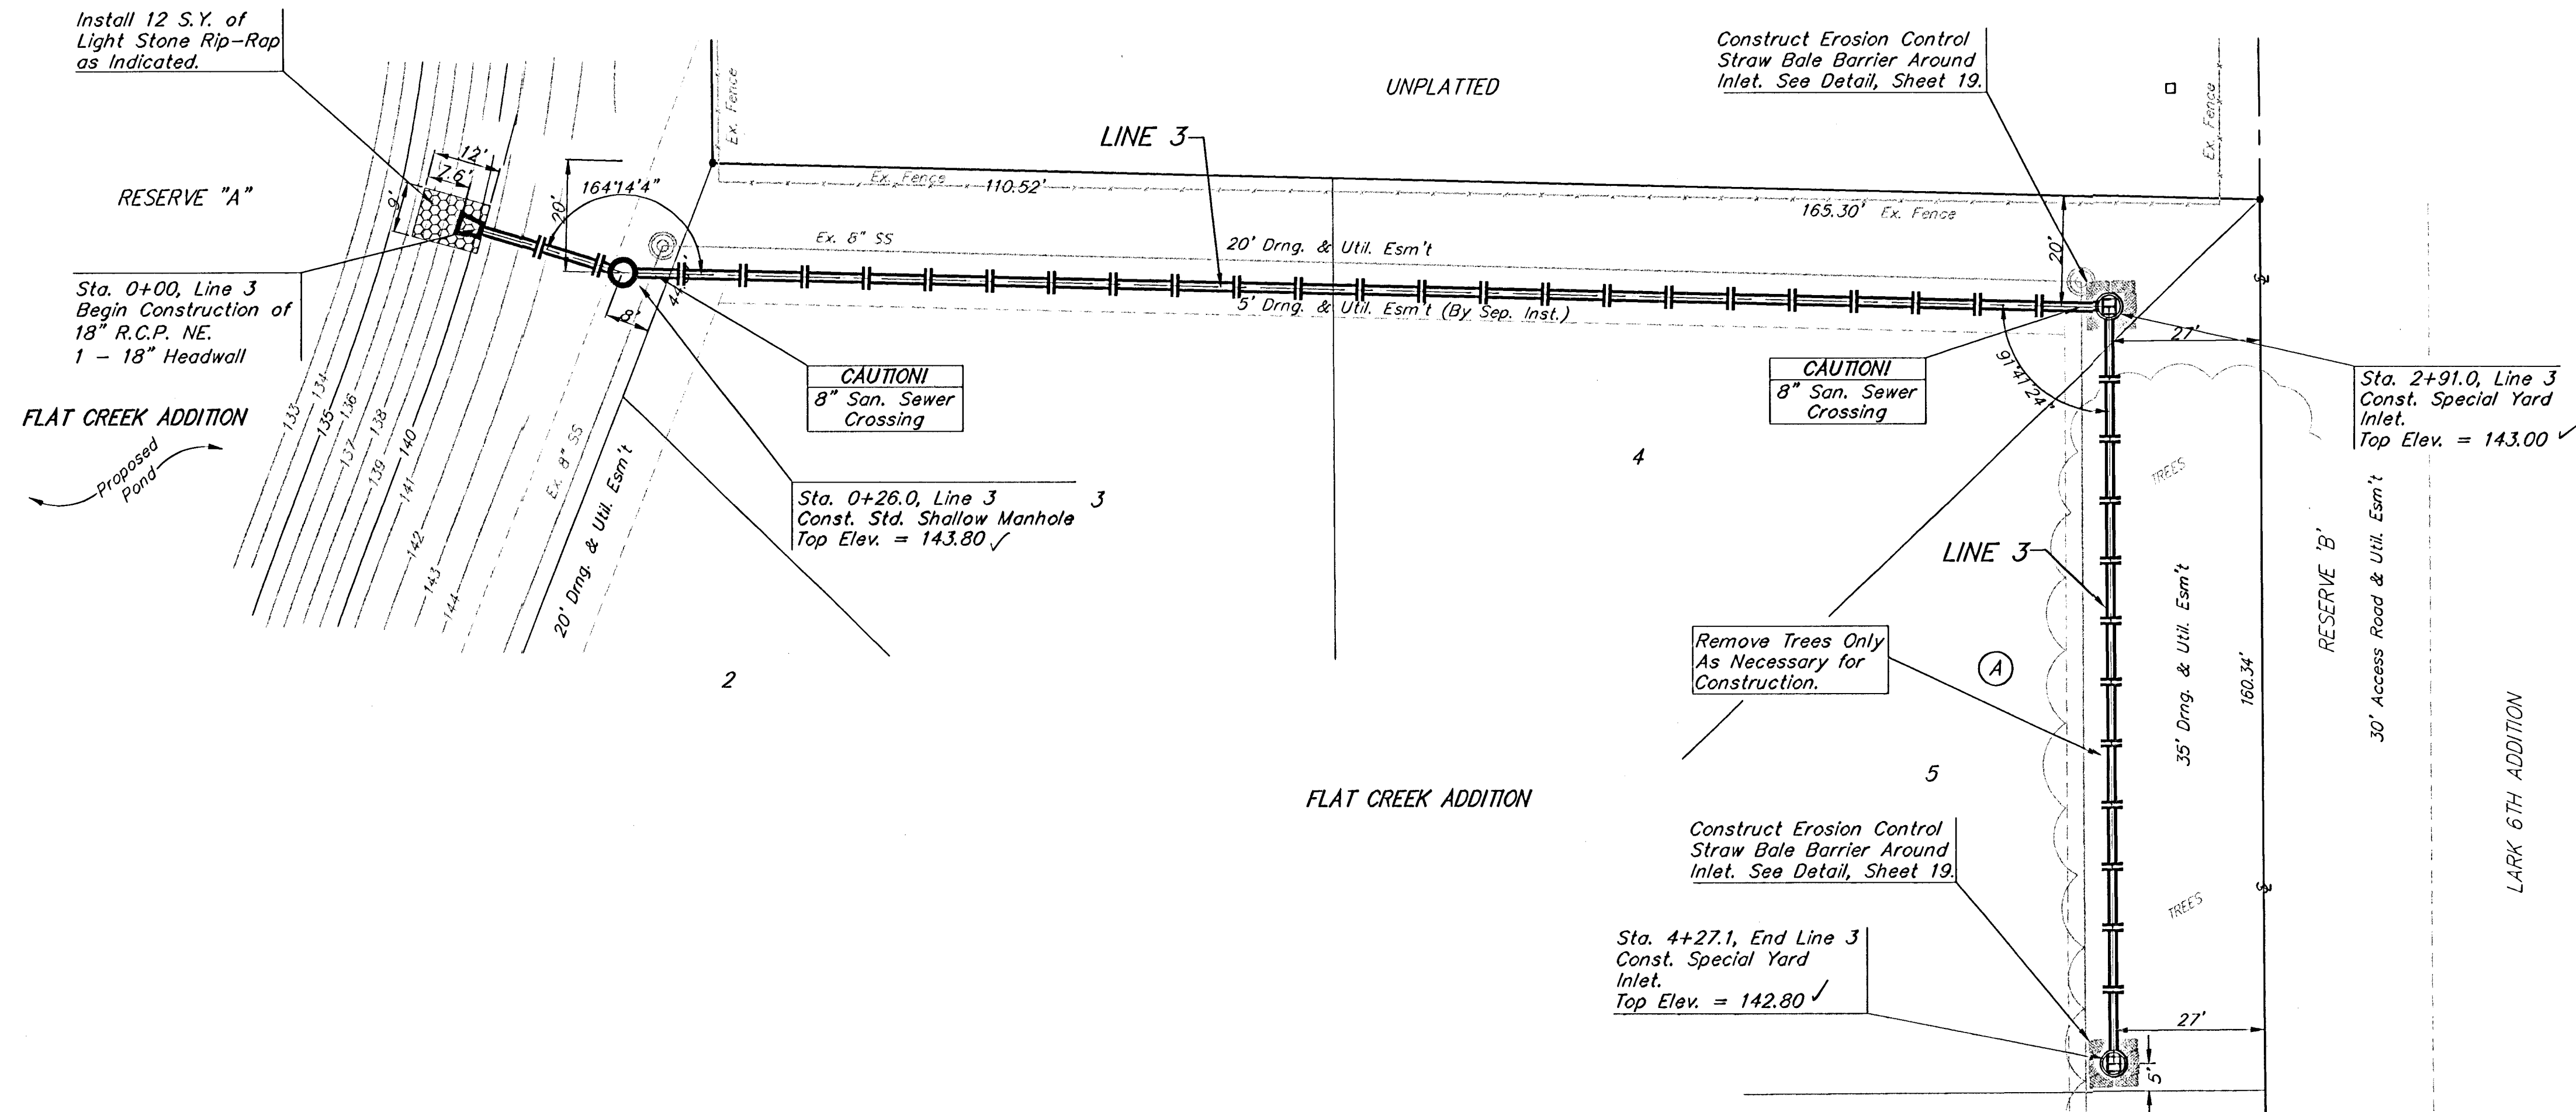

SCALE:  
 1" = 20' HORIZONTAL  
 1" = 5' VERTICAL  
 • = IRON

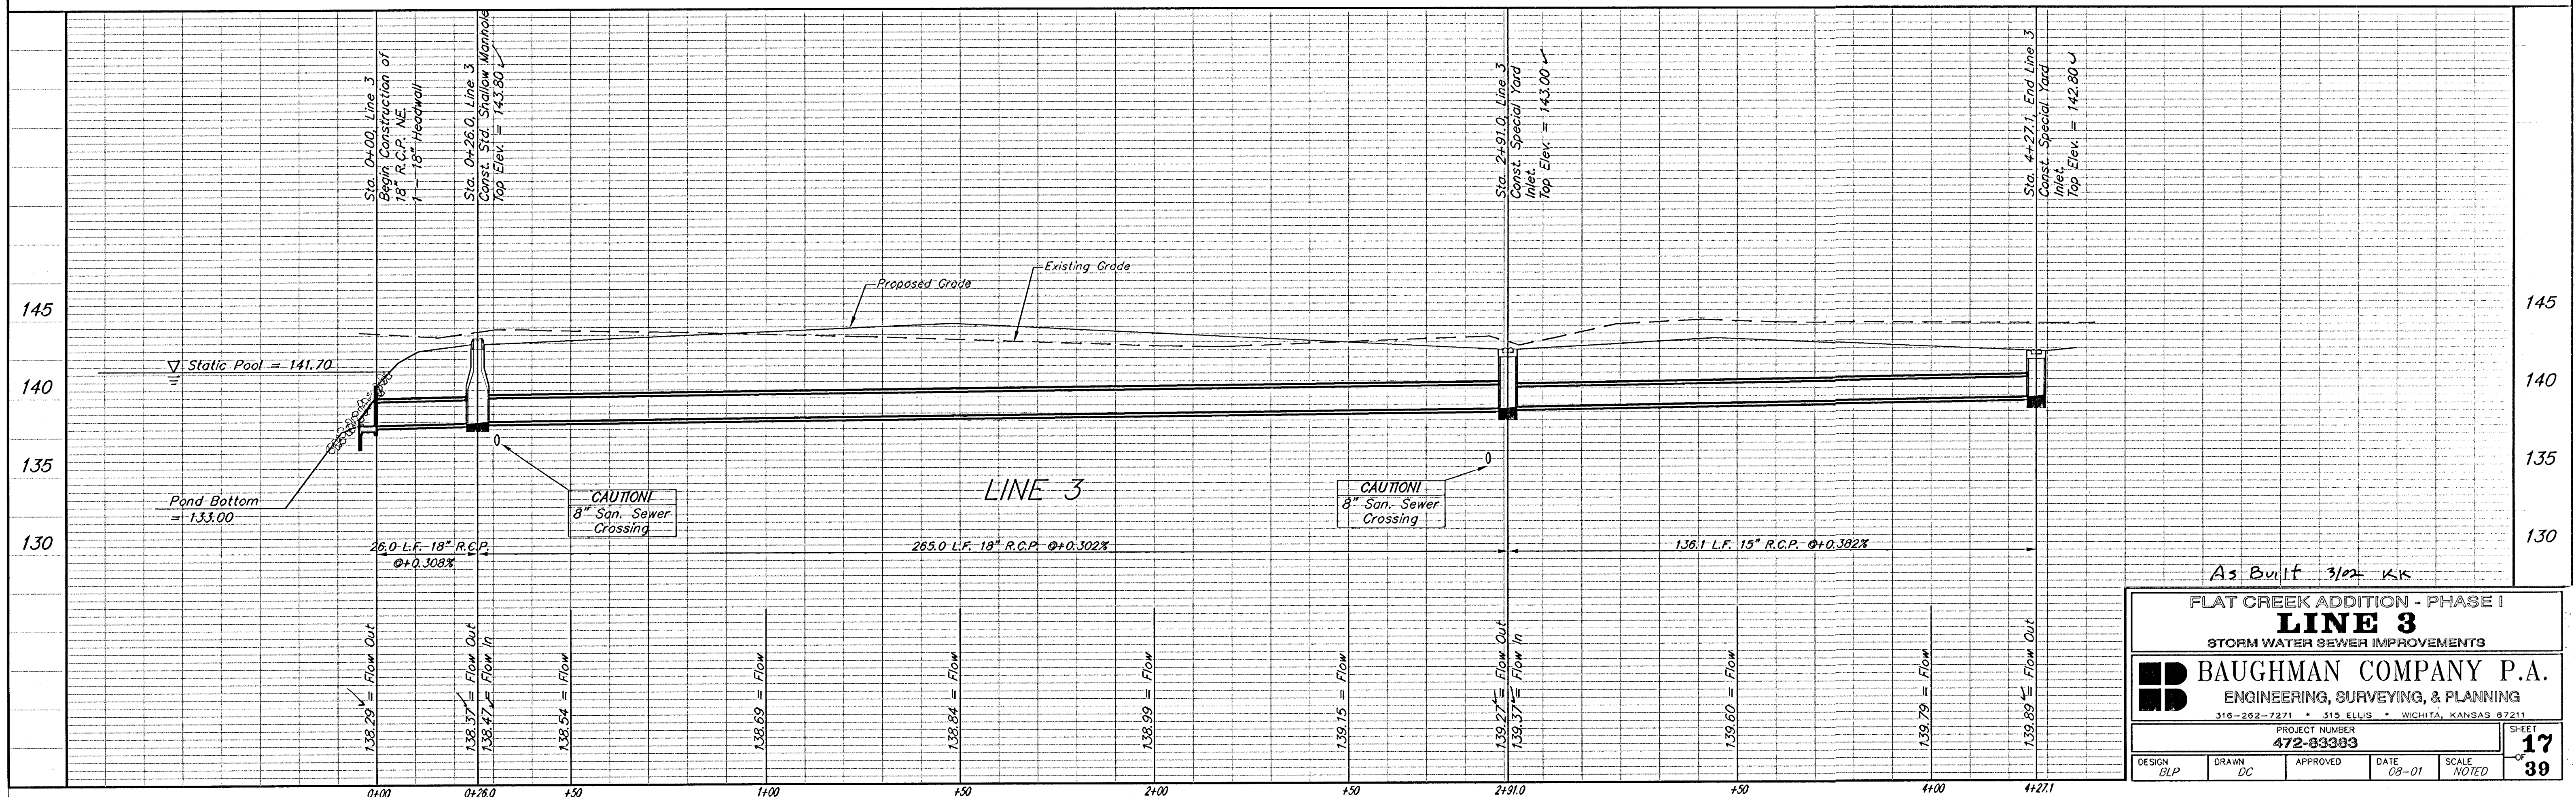

FLAT CREEK ADDITION - PHASE I  
**LINE 3**  
 STORM WATER SEWER IMPROVEMENTS

**BAUGHMAN COMPANY P.A.**  
 ENGINEERING, SURVEYING, & PLANNING  
 316-262-7271 • 315 ELLIS • WICHITA, KANSAS 67211

PROJECT NUMBER  
**472-83383**

DESIGN BLP DRAWN DC APPROVED DATE 08-01 SCALE NOTED

SHEET **17** OF **39**