
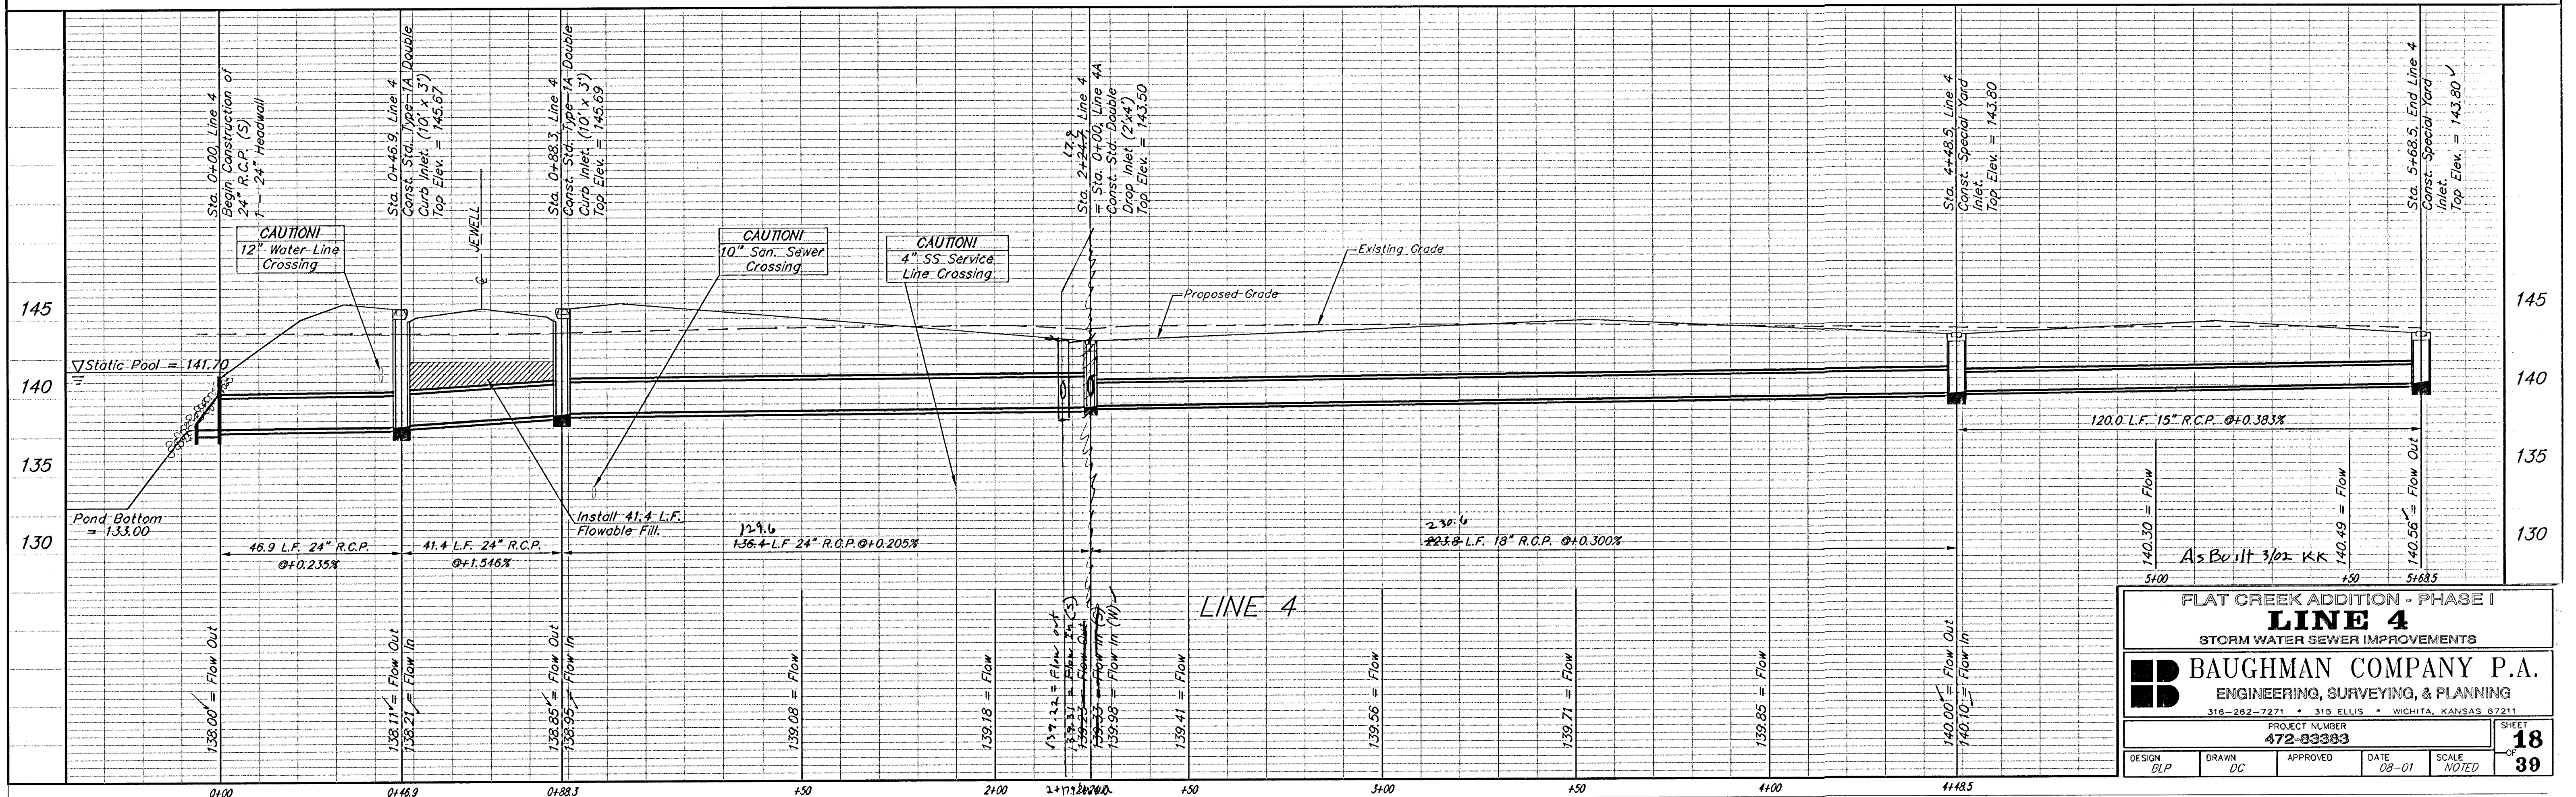


BENCHMARKS:
 BM #1: "□" Cut in top of curb, east
 return of SE corner of Lotus &
 Parkridge.
 Elev. = 145.99 (City Datum)

BM #2: "X" Cut on walk at NW corner
 of Lot 1, Block F, Flat Creek Addition
 Elev. = 146.22 (City Datum)

BM #3: "□" Cut in top of curb at the
 NW corner of Lot 1, Block B, Hunter's
 Ridge Addition.
 Elev. = 146.63 (City Datum)

SCALE:
 1" = 20' HORIZONTAL
 1" = 5' VERTICAL
 • = IRON

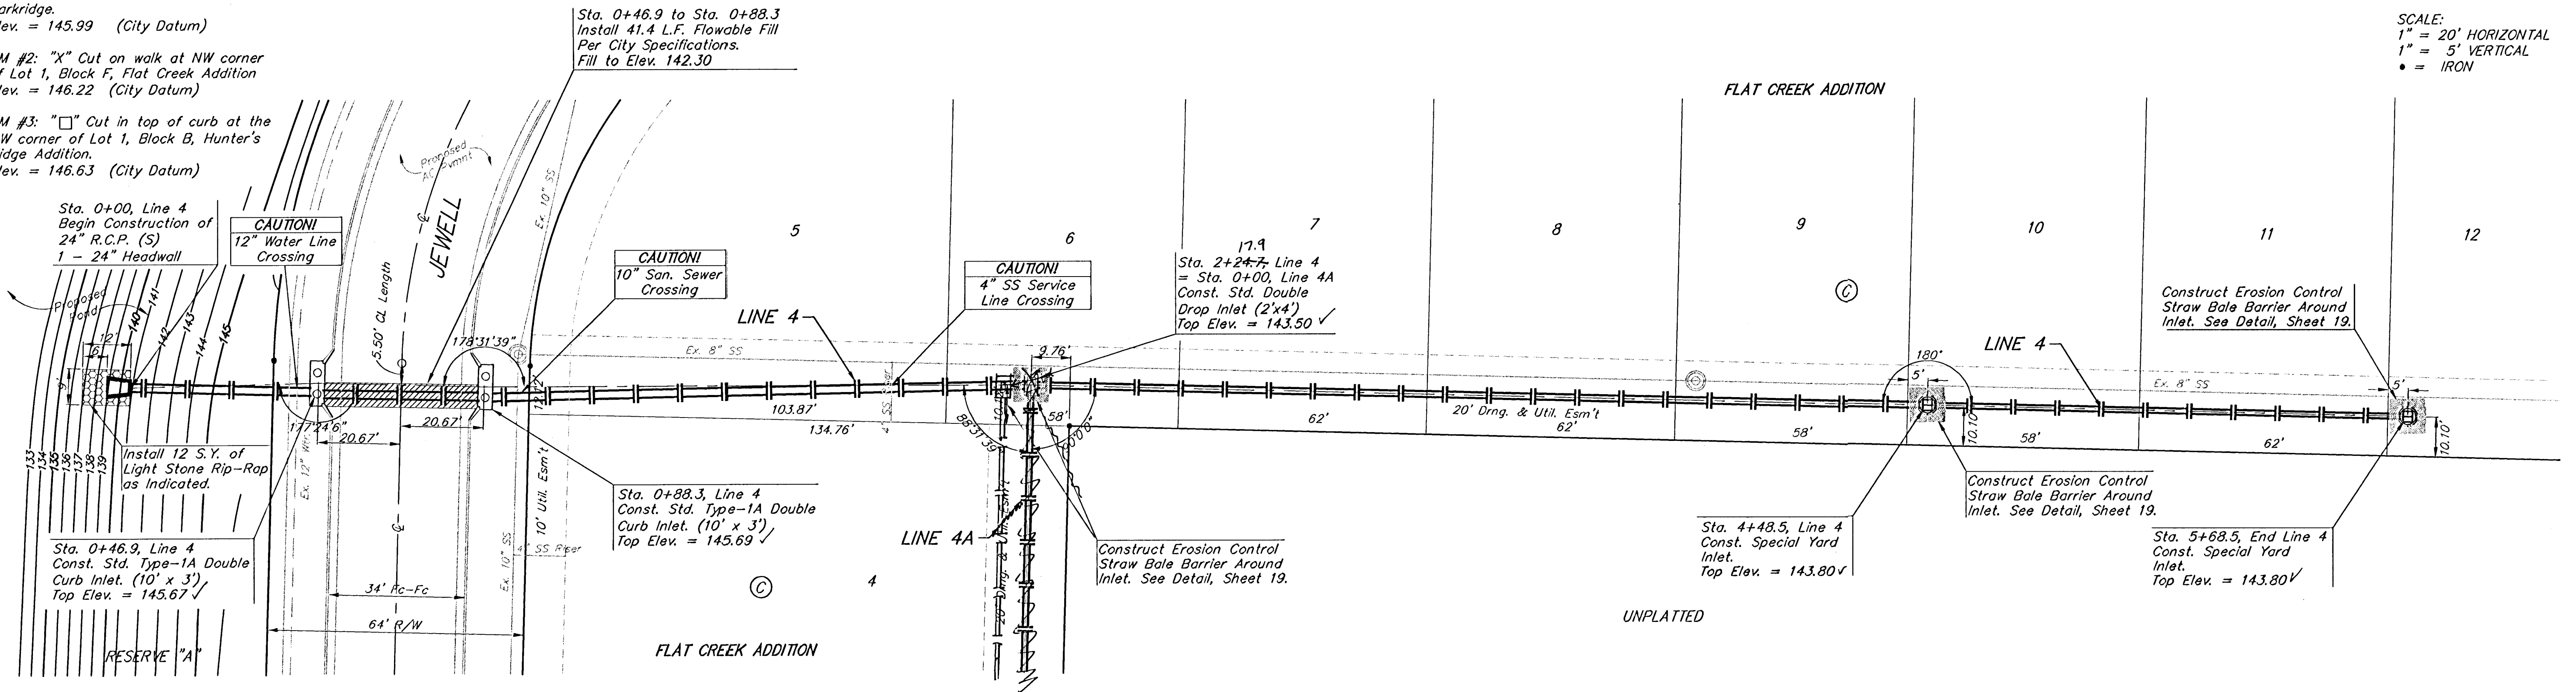

FLAT CREEK ADDITION - PHASE I
LINE 4
 STORM WATER SEWER IMPROVEMENTS

BAUGHMAN COMPANY P.A.
 ENGINEERING, SURVEYING, & PLANNING

PROJECT NUMBER
472-83383

DESIGN BLP DRAWN DC APPROVED DATE 08-01 SCALE NOTED

SHEET **18** OF **39**