

MAIN 20 SOUTHWEST INTERCEPTOR SEWER

CITY OF WICHITA, KANSAS


JIM L. ARMOUR, P.E. - CITY ENGINEER

SHEET INDEX

- 1 TITLE, LOCATION MAP, SHEET INDEX & LEGEND
- 2 KEY MAP & GENERAL NOTES
- 3-9 PLAN & PROFILE
- 10-11 MANHOLE DETAILS
- 12-14 EROSION CONTROL BMP DETAILS



Mies Construction, Inc. - Contractor
Shaarer, City - Inspector
Released 9/30/05
As-Built
Stubs
.pdf by JDL 3/14/06

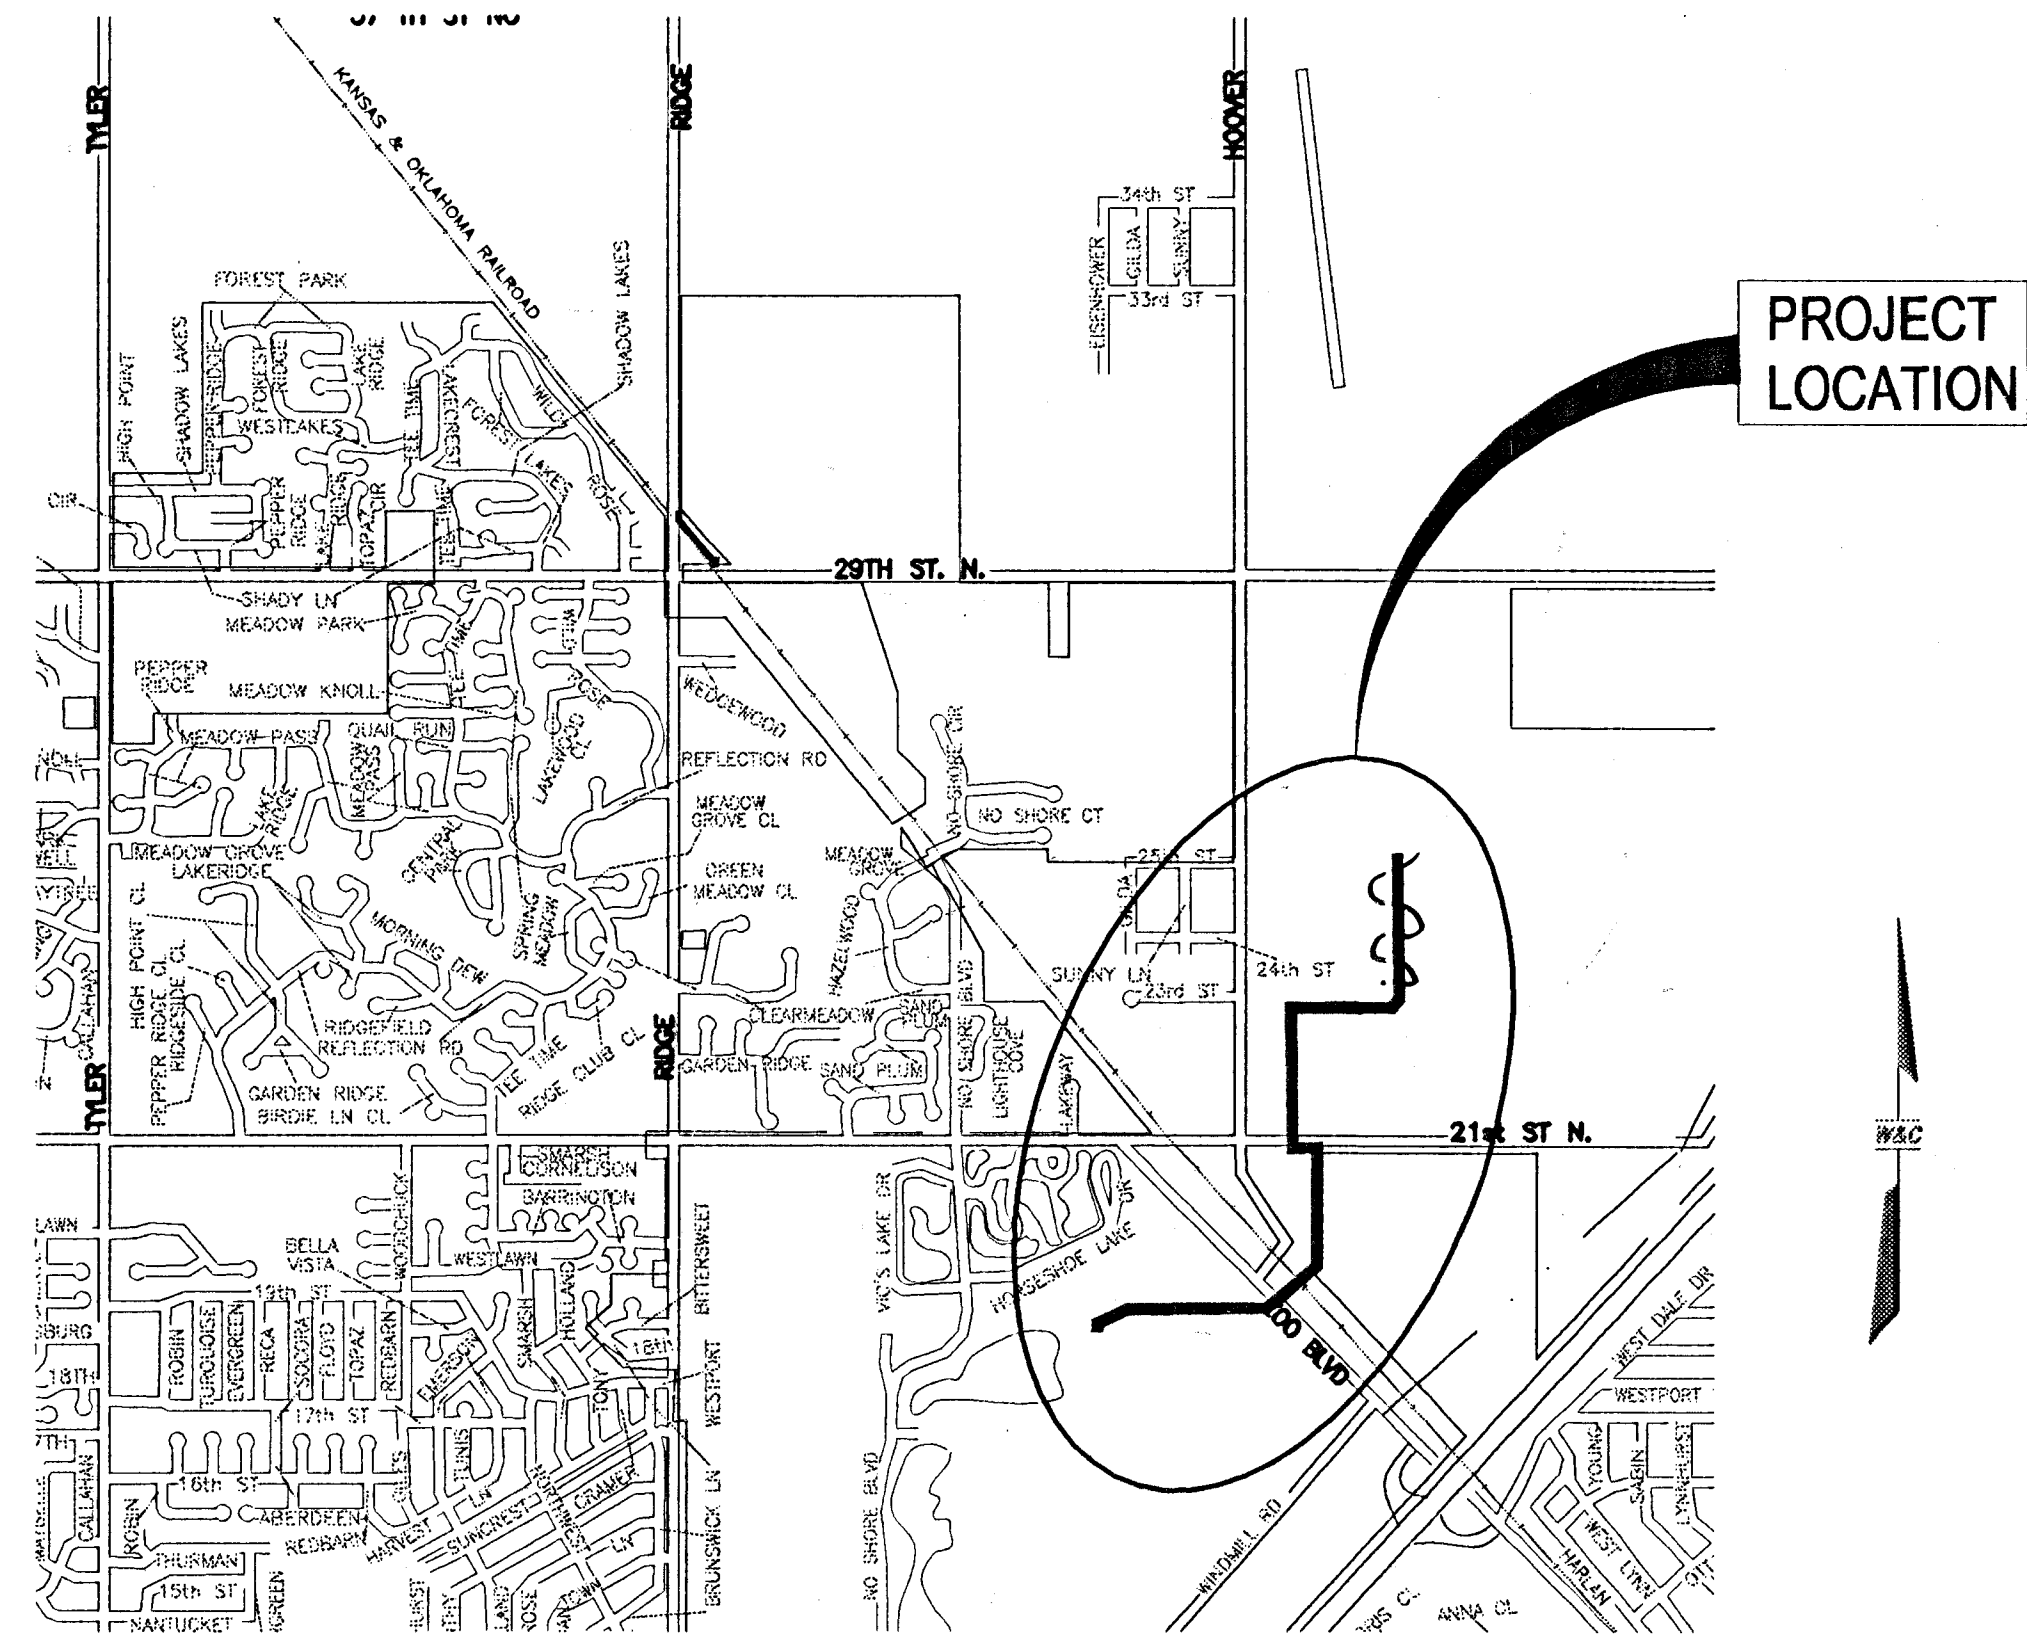

LOCATION MAP

NOT TO SCALE

OCA NO. 744056
CITY OF WICHITA
PROJECT NO. 468-83796
APRIL 2004

LEGEND

SYMBOL	DESCRIPTION
	BUILDING / STRUCTURE
	RAILROAD TRACKS
	EDGE OF PAVEMENT
	CURB AND GUTTER
	GRAVEL SURFACING
	WATER LINE
	WATER METER
	WATER VALVE
	FIRE HYDRANT
	GAS LINE
	GAS REGULATOR
	GAS VALVE
	STORM WATER SEWER LINE
	STORM WATER INLET
	MANHOLE
	CULVERT PIPE
	SANITARY SEWER LINE
	SANITARY SEWER FORCE MAIN
	UNDERGROUND TELEPHONE LINE
	UNDERGROUND ELECTRIC LINE
	OVERHEAD ELECTRIC LINE
	FIBER OPTIC LINE
	UTILITY POLE
	TELEPHONE PEDESTAL
	UTILITY DEADMAN/GUY WIRE
	CABLE TELEVISION LINE
	BUSH
	TREE
	TREE LINE EDGE
	SIGN POST
	ROADWAY GUARD RAIL
	STREAM FLOW DIRECTION
	SPOT ELEVATION
	SOIL BORING LOCATION
	WOOD FENCE
	WROUGHT IRON FENCE
	BARBED WIRE FENCE
	CHAIN LINK FENCE
	PROPERTY LINE / RIGHT-OF-WAY LINE
	LOT LINE
	EASEMENT LINE (EXISTING)
	EASEMENT LINE (PROPOSED)



WILSON & COMPANY
Engineers & Architects

Revised 4/12/05 P.Y.