
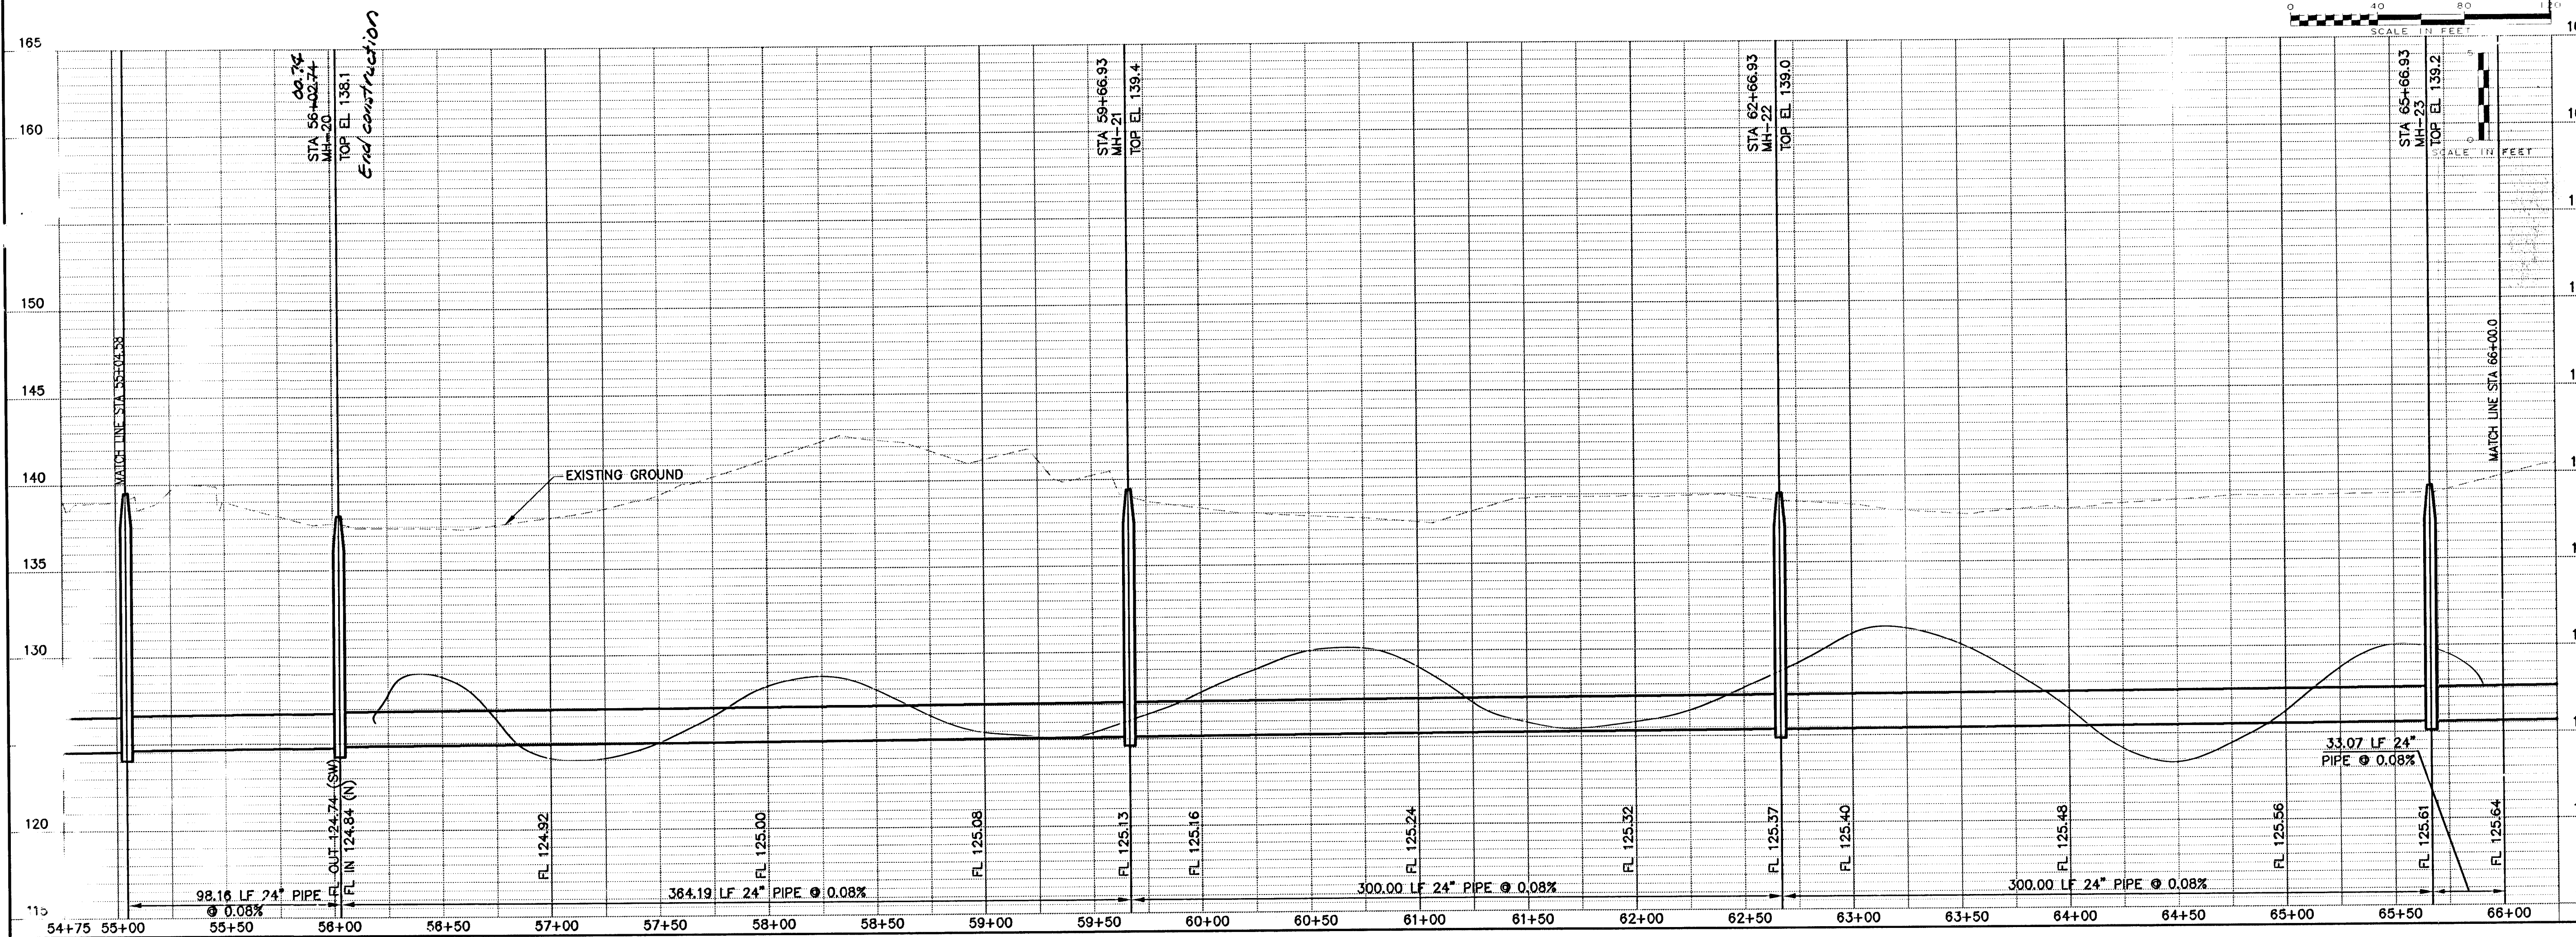


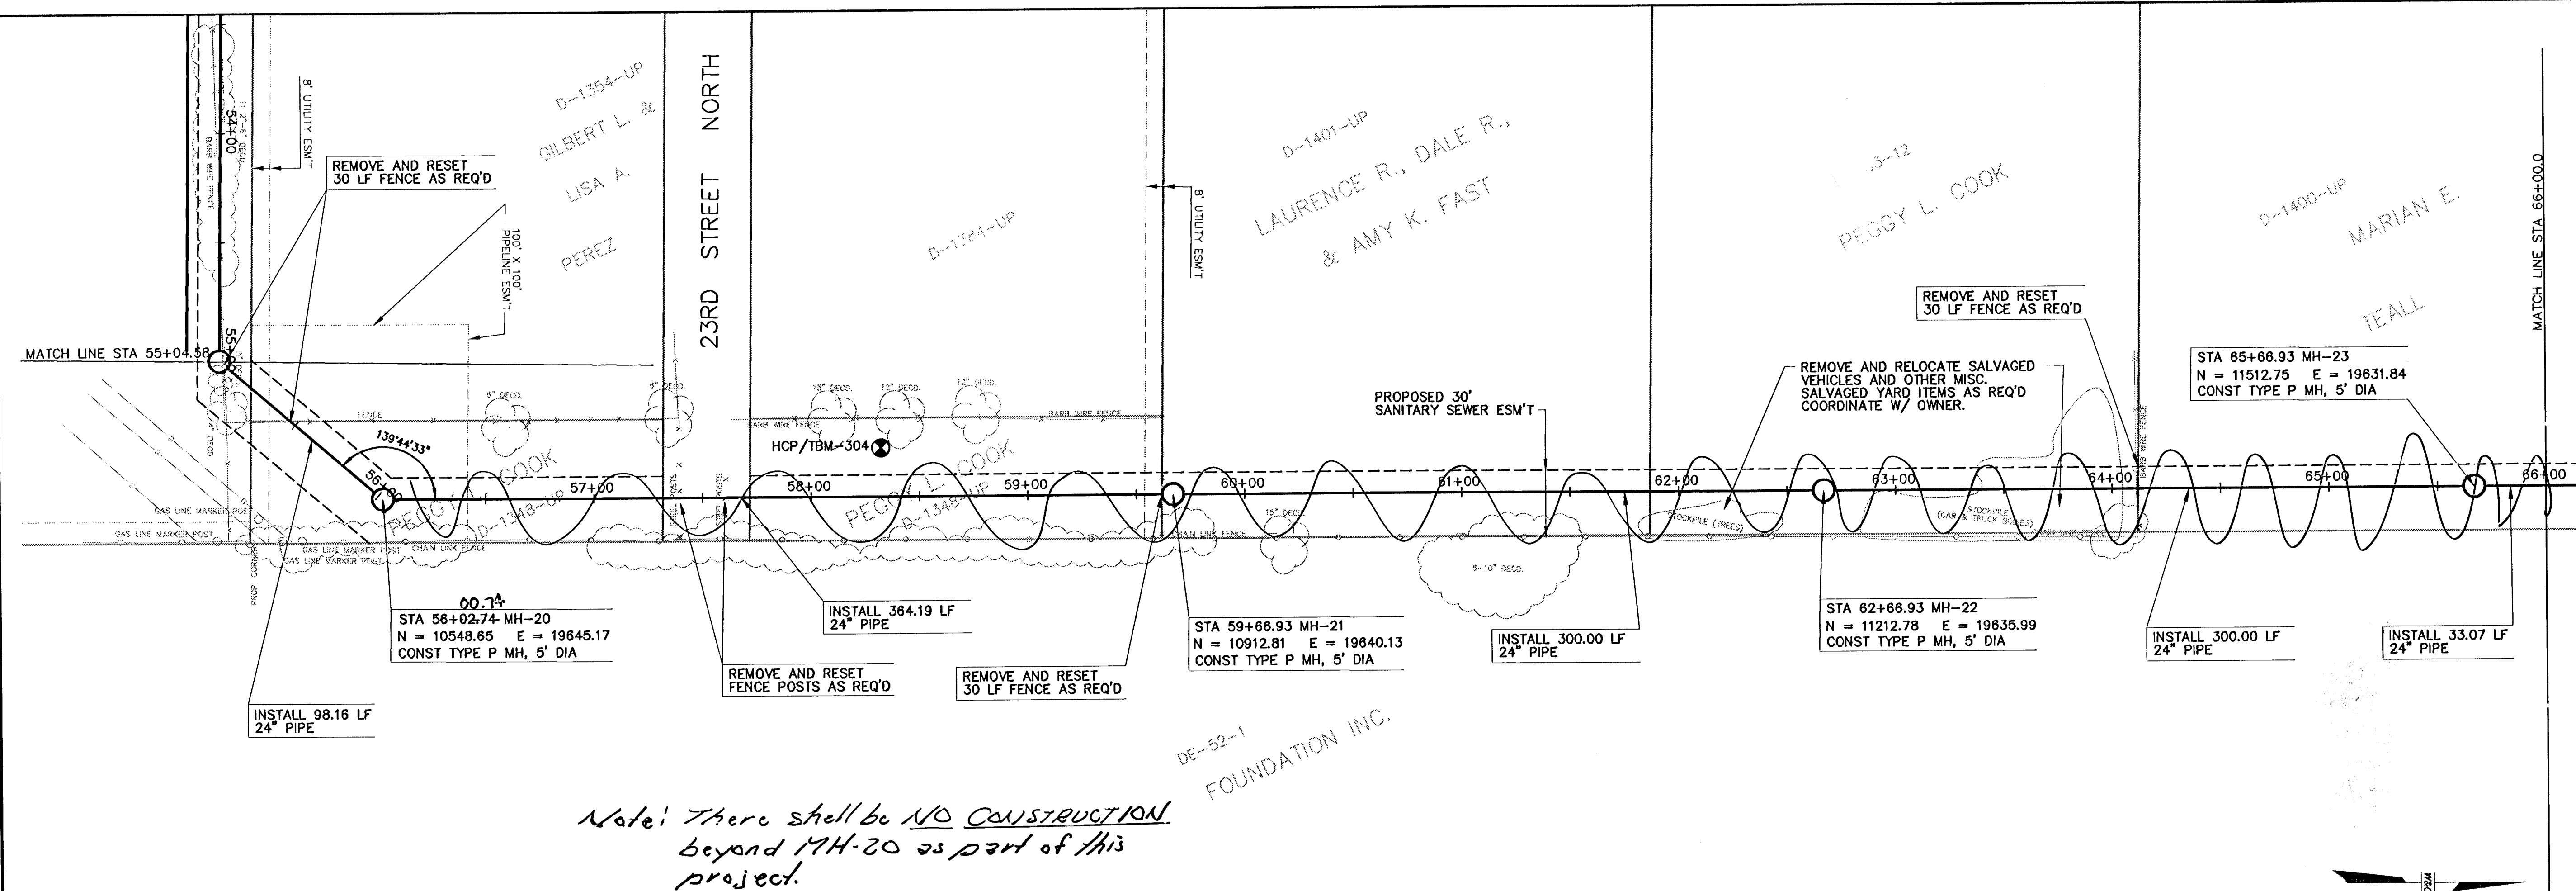

**WILSON
& COMPANY**

CITY OF WICHITA, KANSAS
MAIN 20 SOUTHWEST INTERCEPTOR SEWER
~~466-63186~~
PLAN 8 & PROFILE
STA. 55+04.58 TO STA. 66+00.0

DESIGN DWH	CHECKED JLM
DRAWN MEK/KMD	
DATE APRIL 2004	
FILE NO. X1460002	
SHEET NO. 8	

WILSON
& COMPANY
WICHITA, KANSAS