

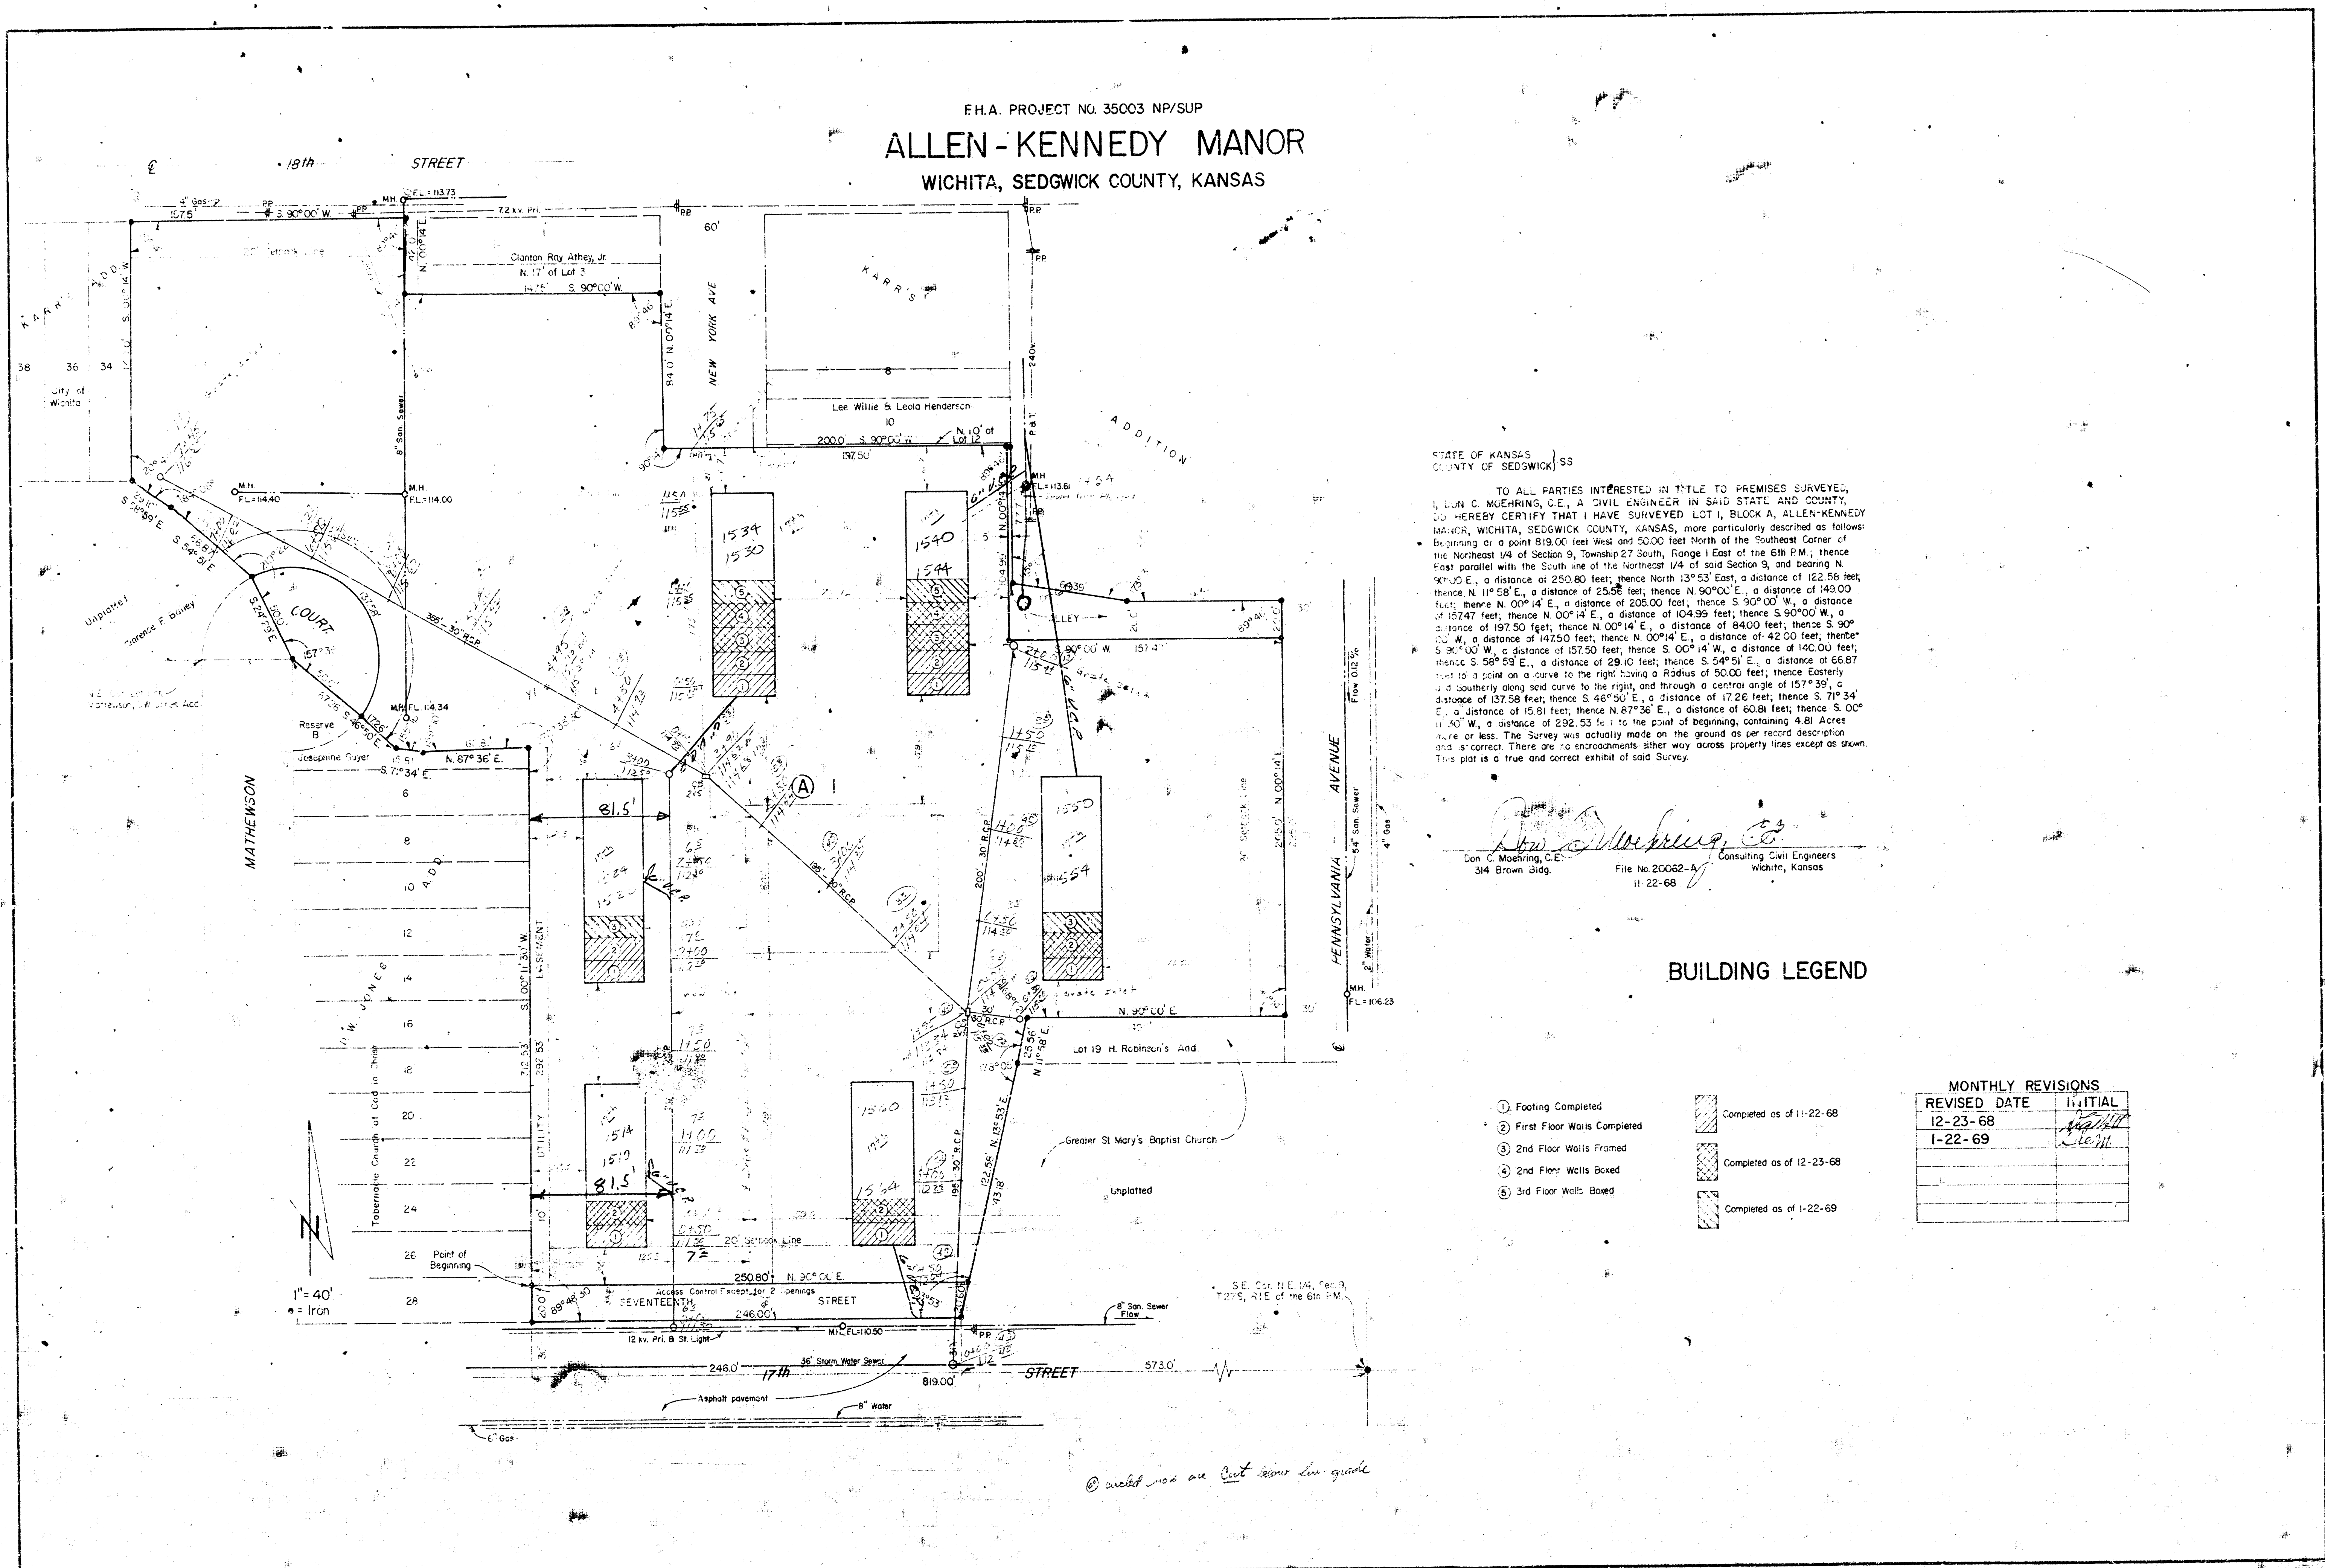
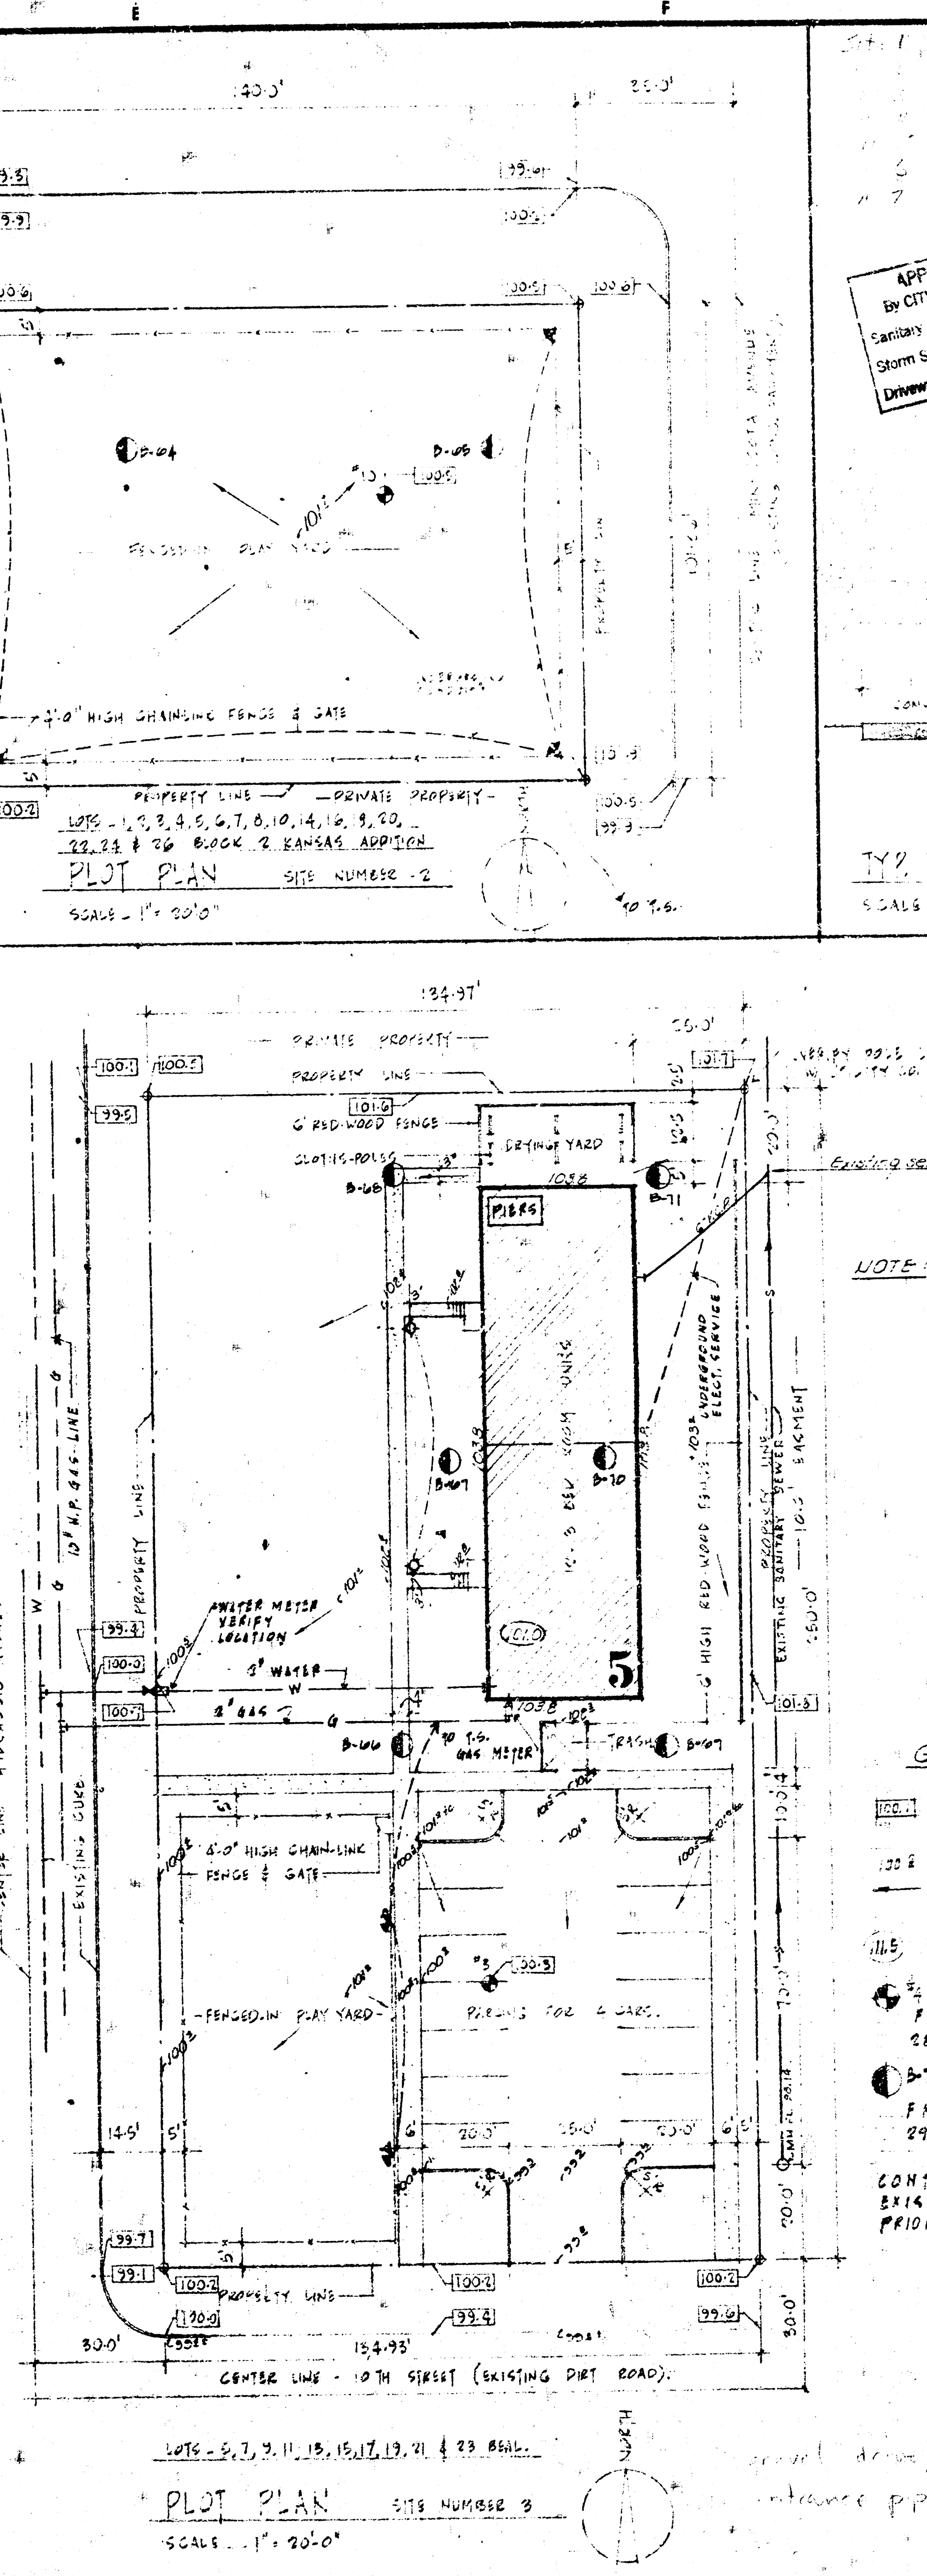


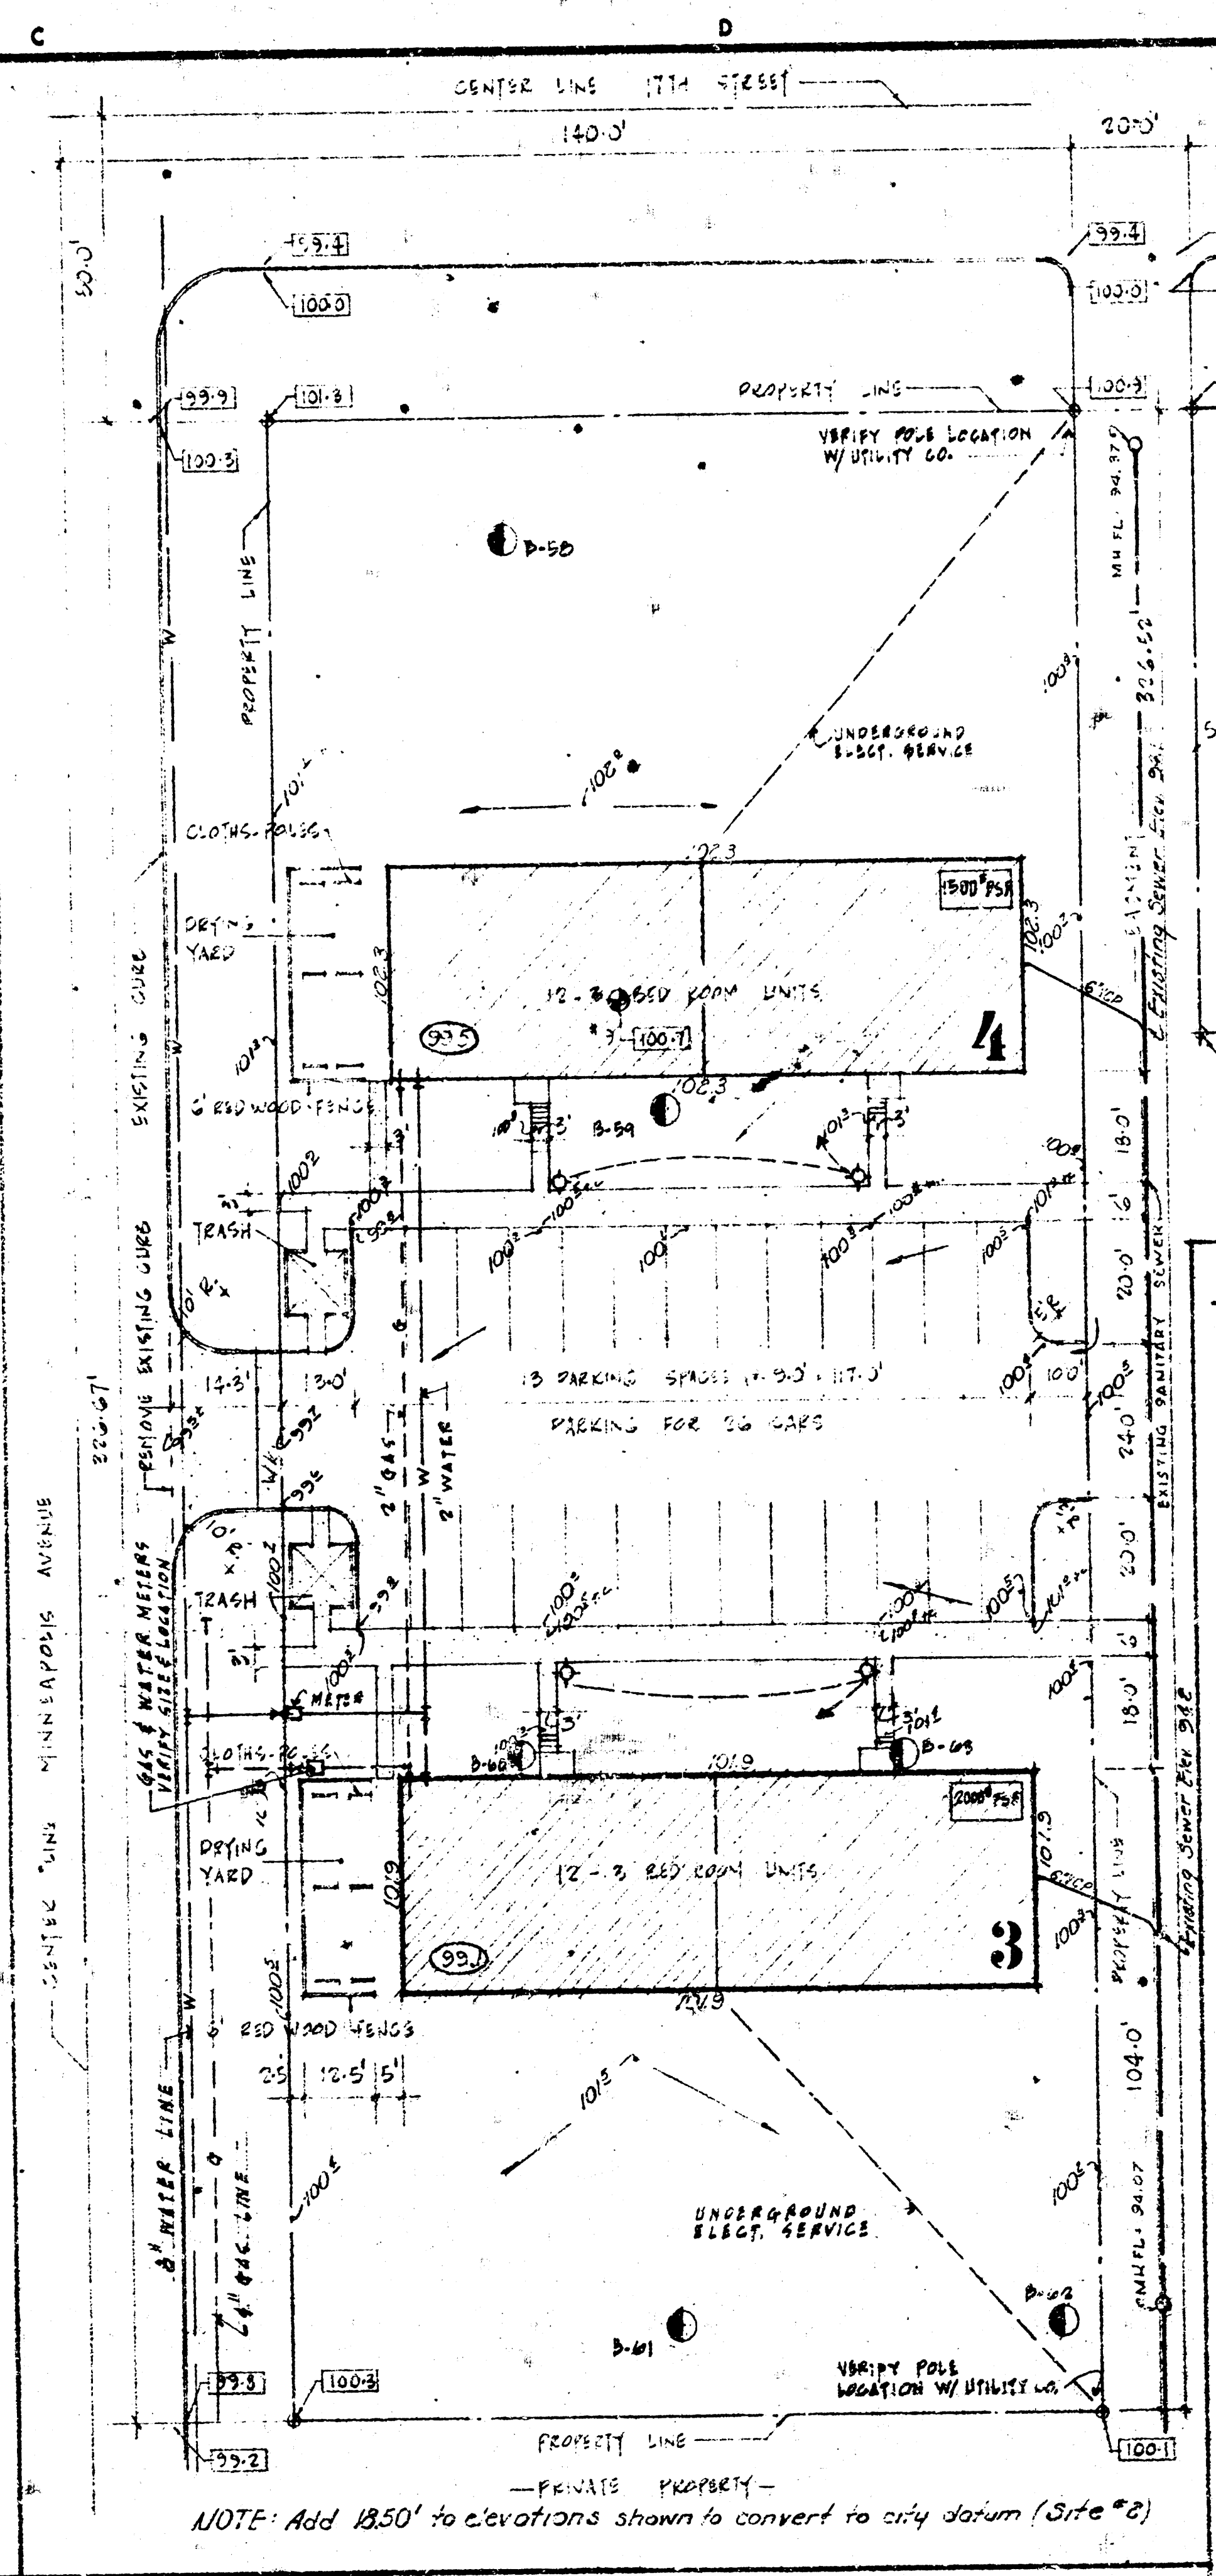

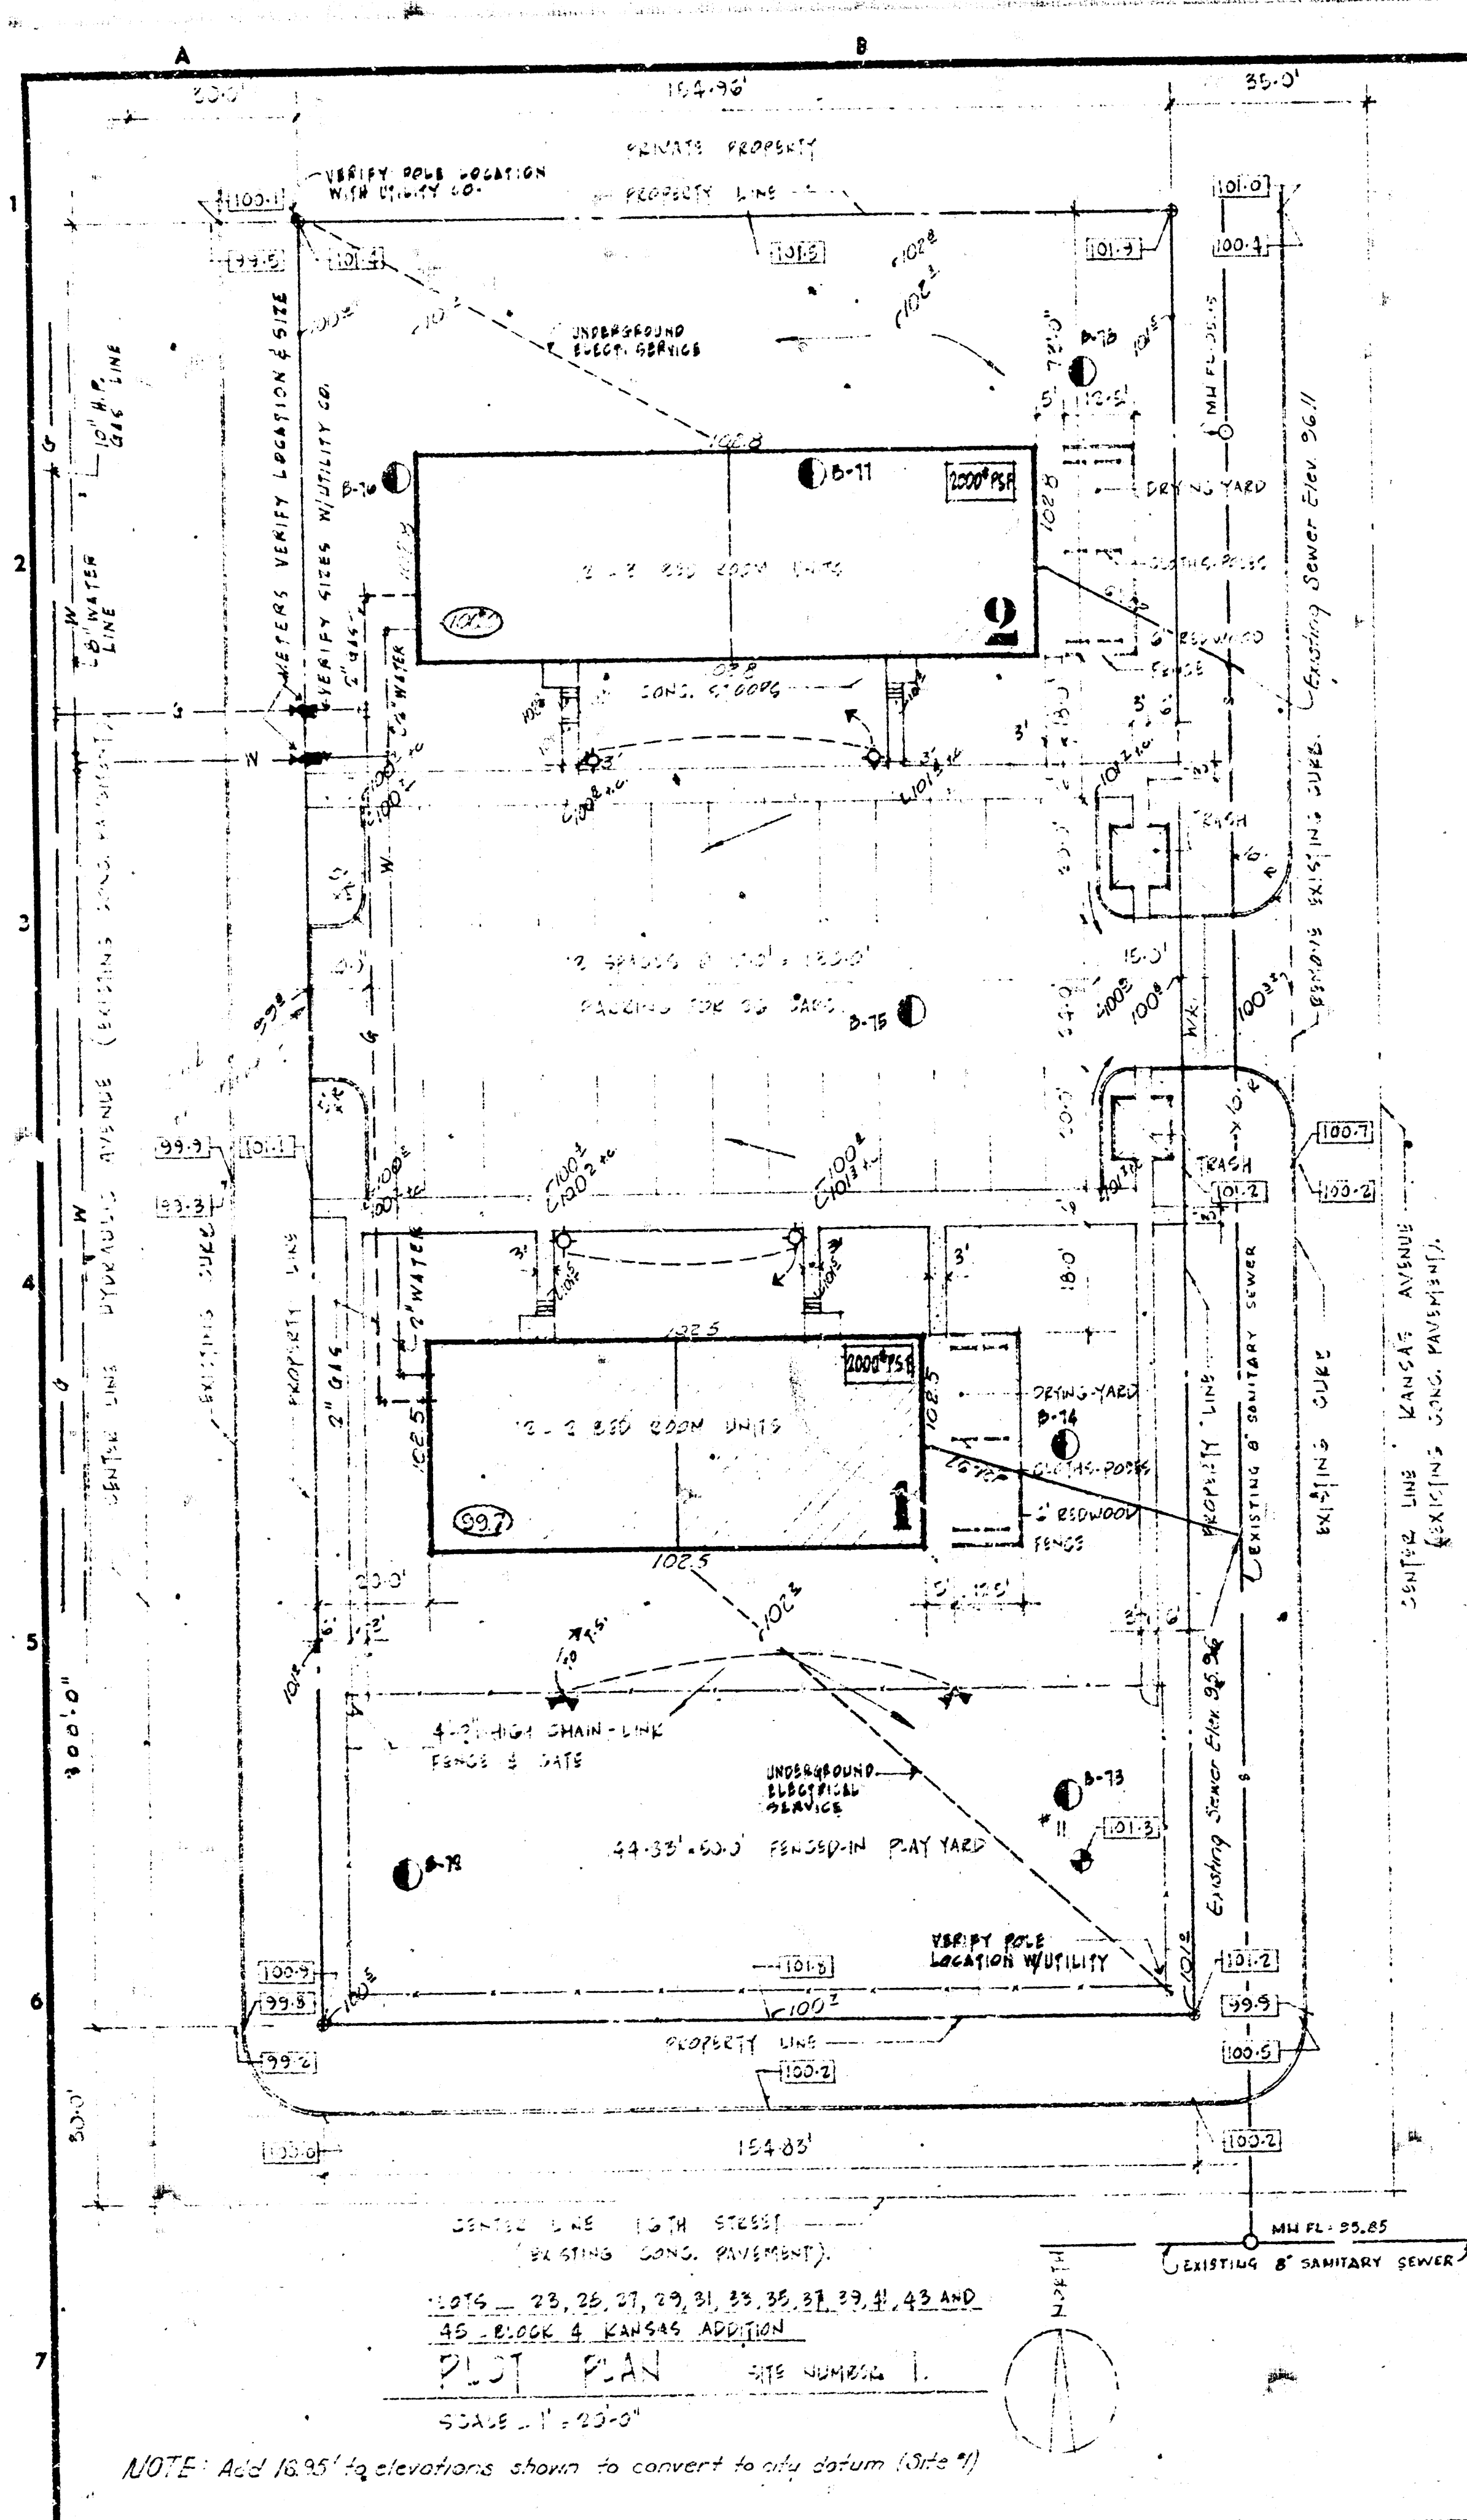

APPROVED AS NOTED
By CITY ENGINEER OF WICHITA
Sanitary Sewers
Storm Sewers
Driveway Approaches

TYPE WALK & PARKING DRIVE
SCALE 1" = 10'-0"

GENERAL NOTES:

1. EXISTING CONTOURS AND 4'00' ELEVATION

2. PROPOSED 4'00' ELEVATION

3. DIRECTION OF CURVE DRAINAGE

4. LOWER FLOOR ELEVATION

5. 4" 40' TEST BORING FROM REPORT DATED 28 MARCH 1966

6. 4" 40' TEST BORING FROM REPORT DATED 29 MAY 1965

CONTRACTOR TO VERIFY EXISTING ELEVATIONS PRIOR TO CONSTRUCTION.

W. H. JOHNSON-ARCHITECT
KANSAS CITY, MISSOURI

MANTREL & STEELE ASSOCIATE ARCHITECTS
KANSAS CITY, MISSOURI

LOGAN 1-0278 (816)



1706 NORTH PIKE, WICHITA, KANSAS

ARCHITECTS WILLIAM H. JOHNSON 1207 GRAND AVE. K.C.M.O. MANTREL & STEELE ASSOCIATE ARCHITECTS	
BY	DATE
OWNER ALLEN KENNEDY MANOR, INC. BERNARD MORAN - PRESIDENT	
BY	DATE
GENERAL CONTRACTOR NAME R. D. MONROE CONTRACTORS	
BY	DATE
PROJECTS NAME PROJECT INTEREST CO.	
BY	DATE
BONDING COMPANY NAME R. D. MONROE CONTRACTORS	
BY	DATE


DRAWING INDEX

- 1 SITE AND GRADING PLANS FOR SITES #1, 2 AND 3
- 2 SITE AND GRADING PLANS FOR SITES #4, 5 AND PART 1 OF SITE 6
- 3 SITE AND GRADING PLANS FOR SITES 6, PART 2
- 4 SITE AND GRADING PLAN FOR COMMUNITY CENTER
- 5 LANDSCAPING PLAN FOR SITES 1, 2 AND 3
- 6 LANDSCAPING PLAN FOR SITES 4, 5 AND PART 1
- 7 LANDSCAPING PLAN FOR SITES 6, PART 2
- 8 LANDSCAPING PLAN FOR COMMUNITY CENTER
- 9 FLOOR PLAN FOR 1 AND 2 BR. UNITS, KITCHEN AND BATH ELEV.
- 10 FLOOR PLANS FOR 3 BR. UNITS, ROOM FINISH SCHEDULE, DOOR SCHEDULE, PARTITION TYPES, WINDOW AND DOOR DETAILS
- 11 10' FLOOR PLANS 1, 2 AND 3 BR. UNITS AND FOOTING AND FIRM SCHEDULES
- 12 ELEVATIONS 1, 2 AND 3 BR. UNITS
- 13 TYPICAL WALL SECTION, PROJECT SIGN AND MOUNT. DETS.
- 14 COMM. BLDG. FLOOR PLANS, ROOM FIN. SCHEDULE, DOOR SCHEDULE, PARTITION TYPES, WINDOW AND DOOR DETAILS
- 15 ELEVATIONS, WALL SECTIONS AND DETS., COMMUNITY CENTER
- 16 MILLWORK, WALL SECTIONS AND KITCHEN ELEVATIONS
- 17 MECHANICAL PLANS & DETAILS FOR APARTMENTS
- 18 MECHANICAL PLANS FOR COMM. BLDG.
- 19 ELECTRICAL PLANS AND DETAILS FOR APARTMENTS
- 20 ELECTRICAL PLANS AND DETAILS FOR COMM. BLDG.
- 21 ELECTRICAL L.V. MCH. DETAILS FOR COMM. BUILDING
- 22 UTILITY DETAILS

GENERAL DATA						
SITE NO.	1 BR. RM.	2 BR. RM.	3 BR. RM.	LAND AREA	PARKING	RM. COUNT
1	12	12	12	4,200	25	36
2	24	24	24	6,000	20	48
3	12	12	12	5,800	10	36
4	24	24	24	9,600	58	48
5	12	12	12	3,500	24	36
6	24	24	24	22,500	82	48

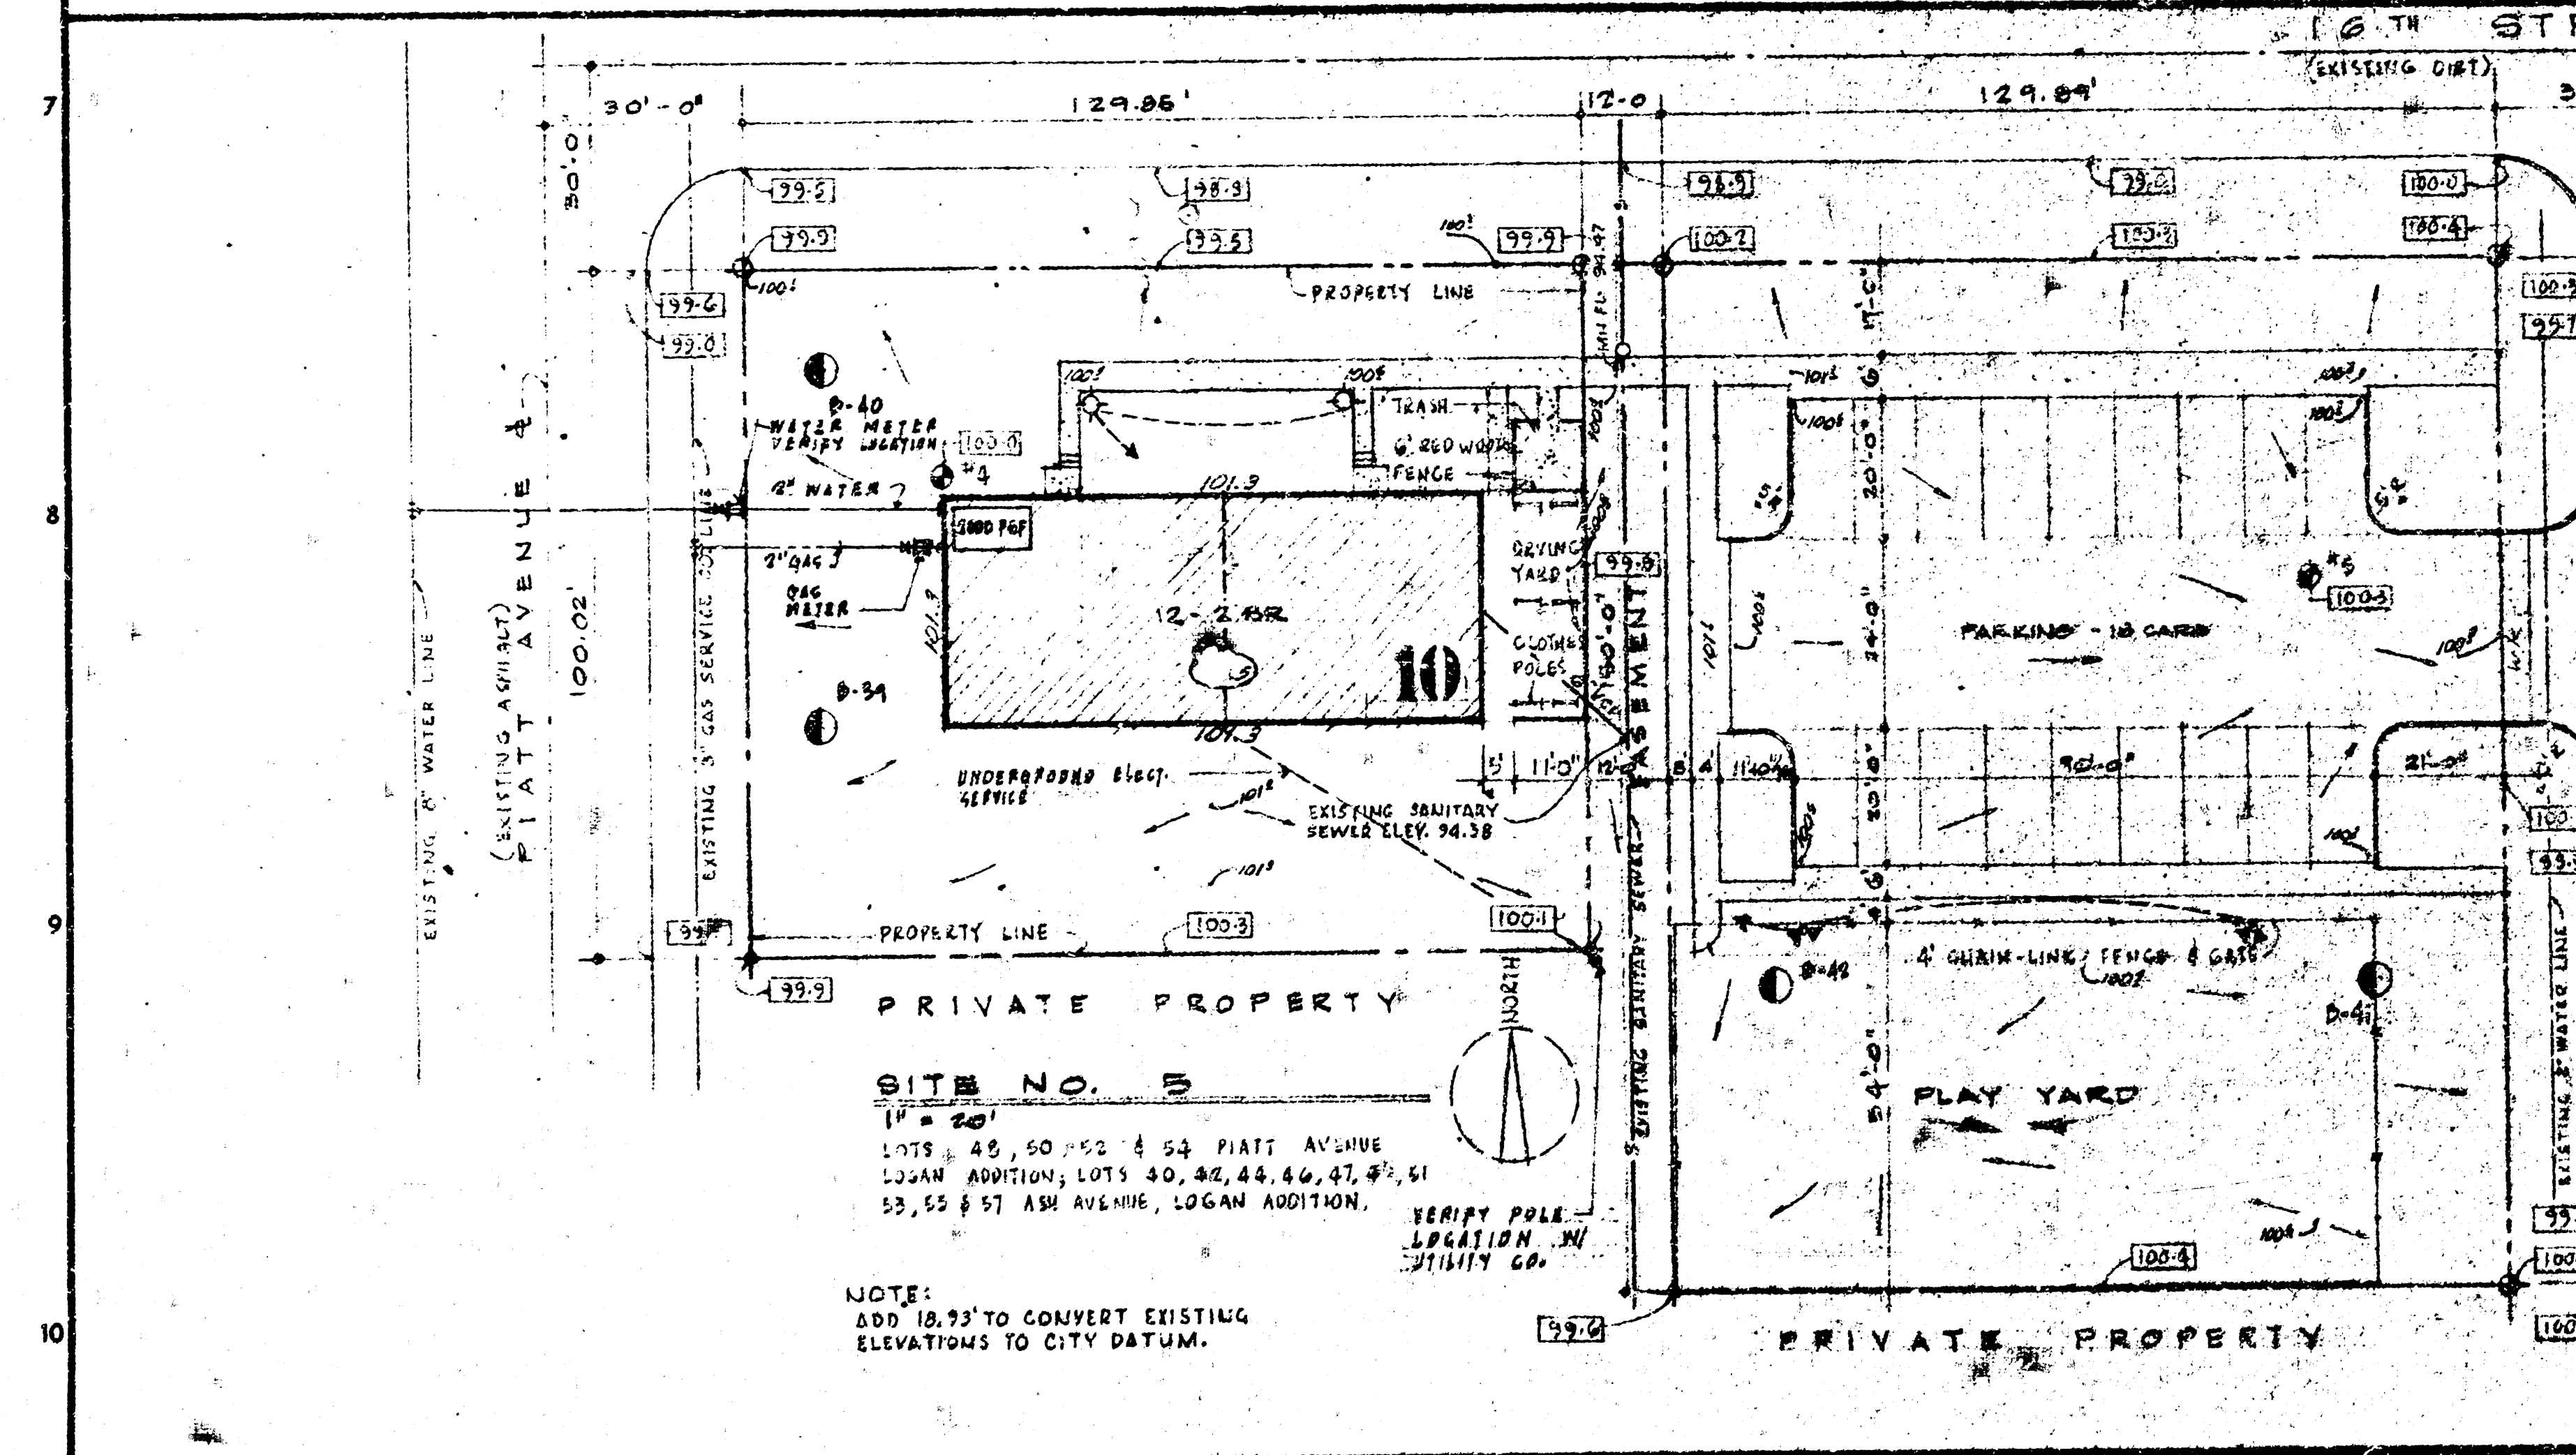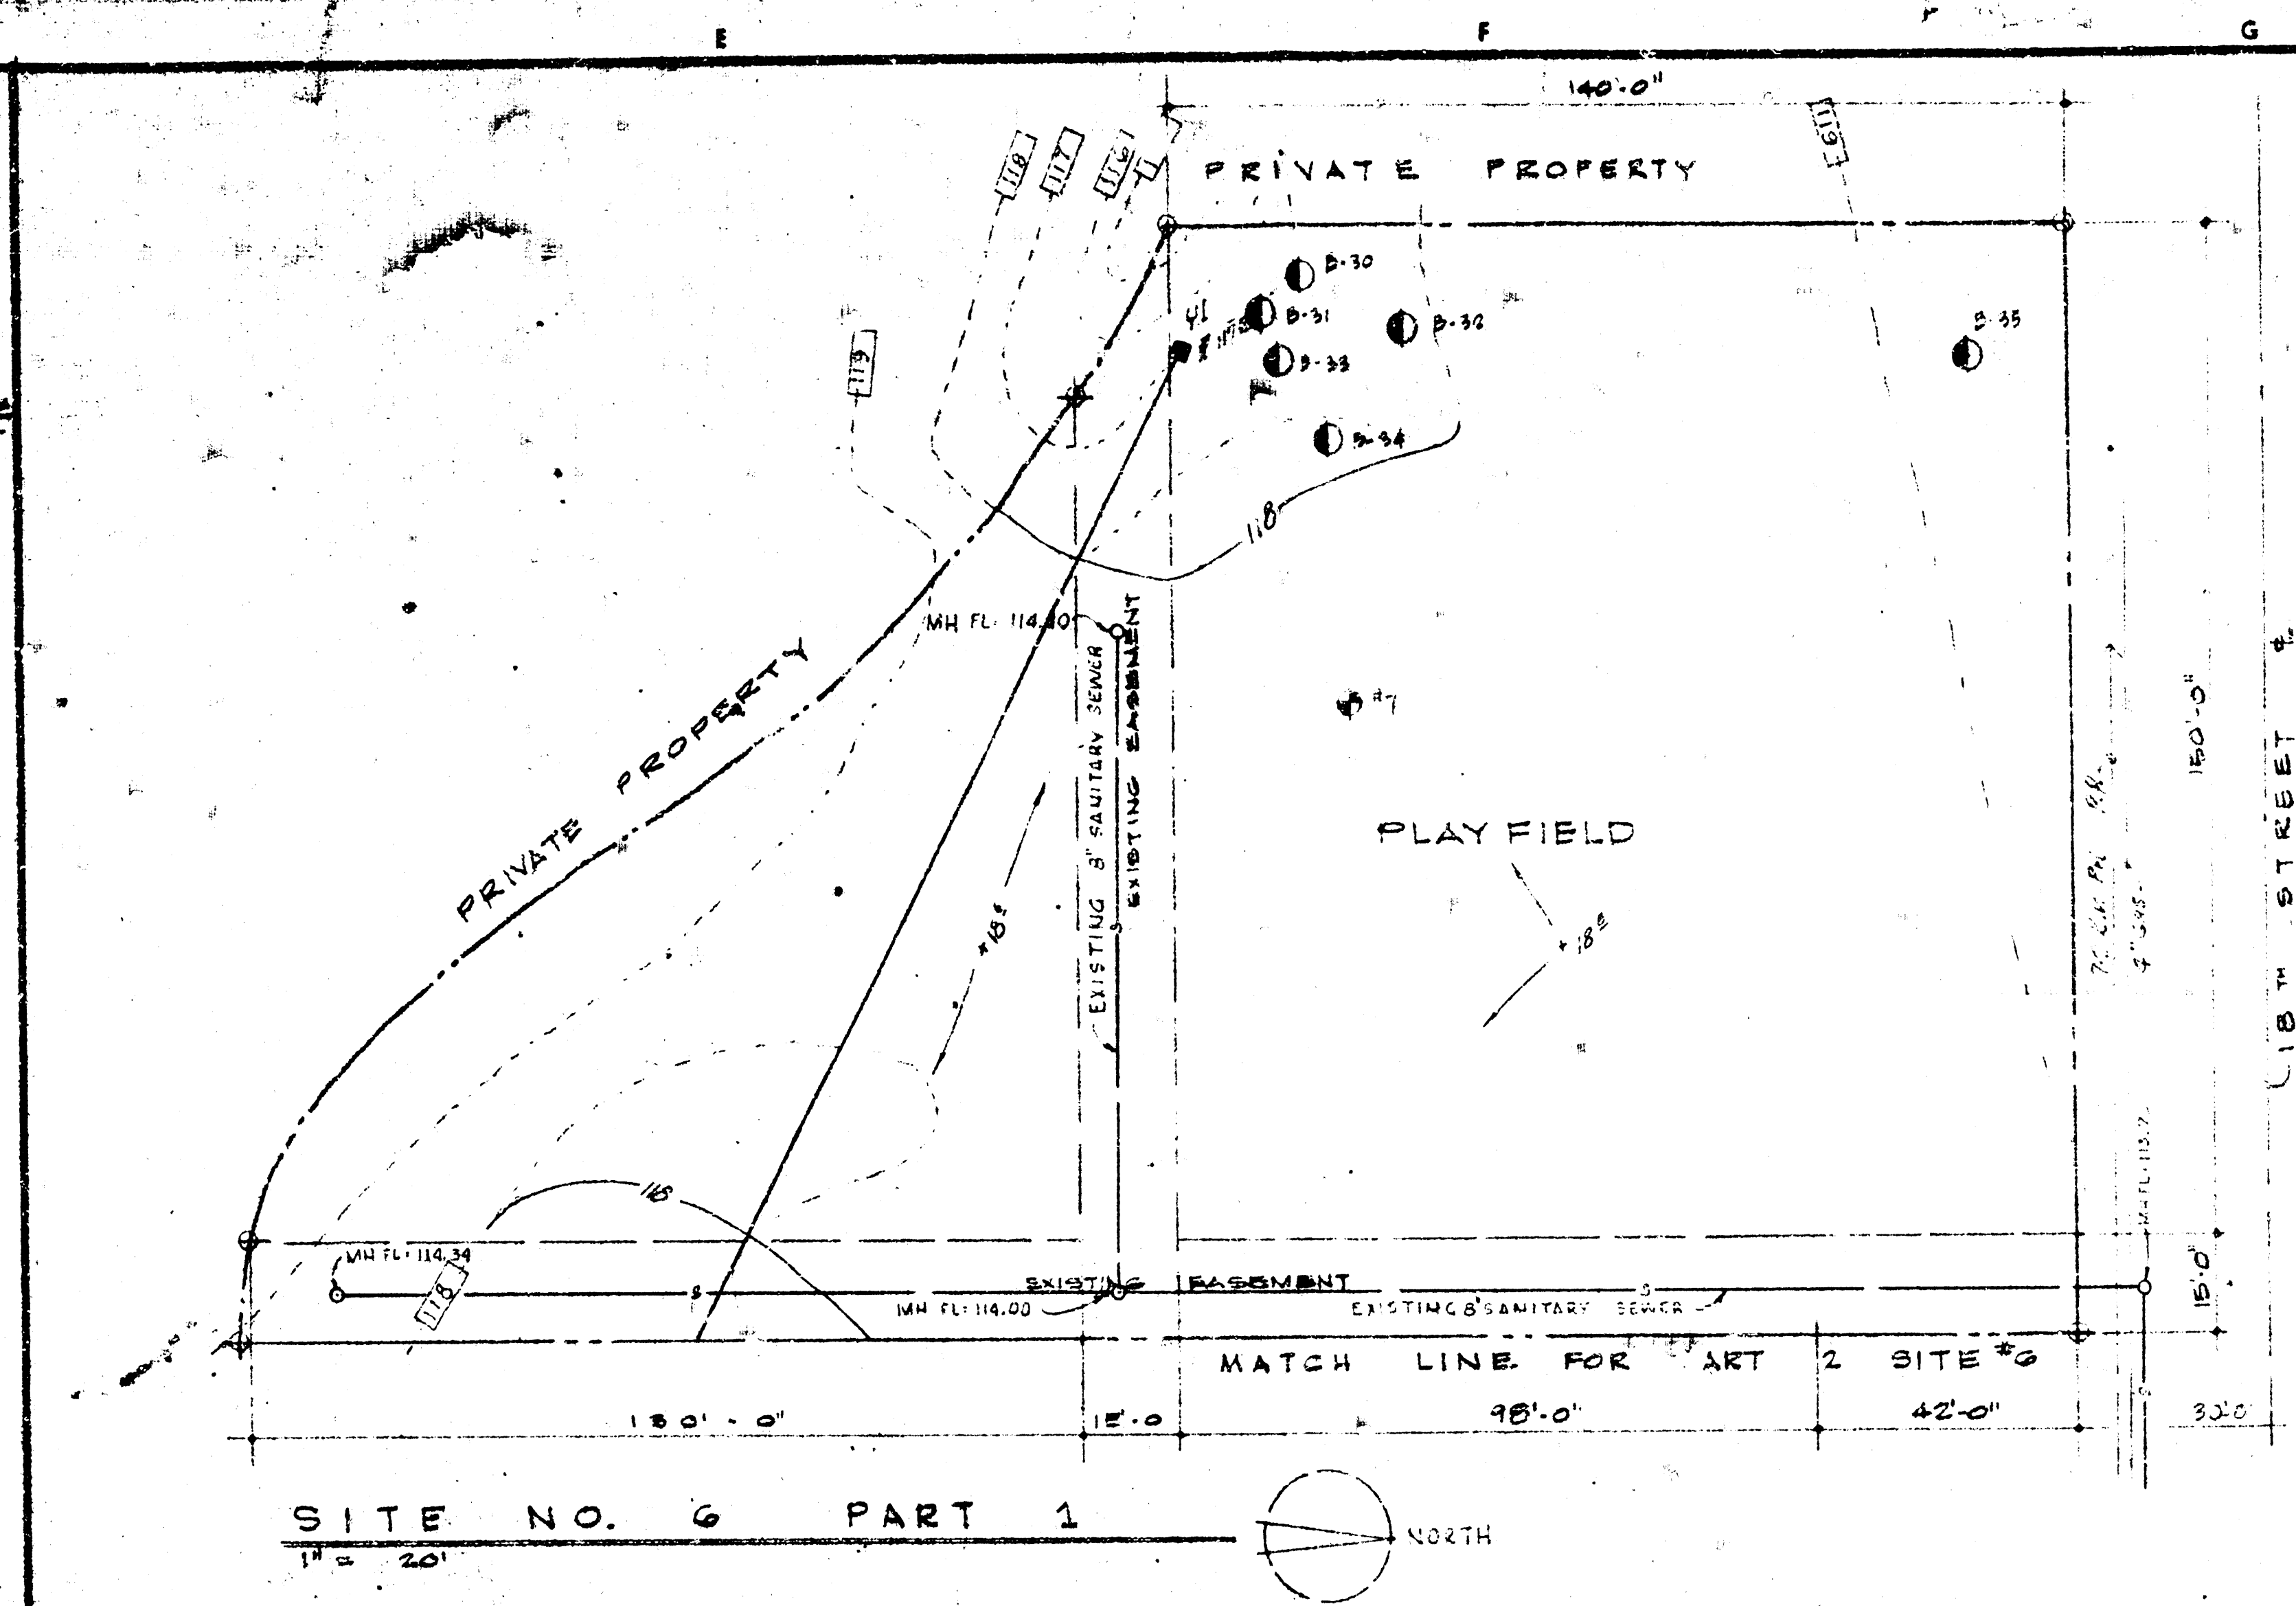

2
TOTAL SHEETS

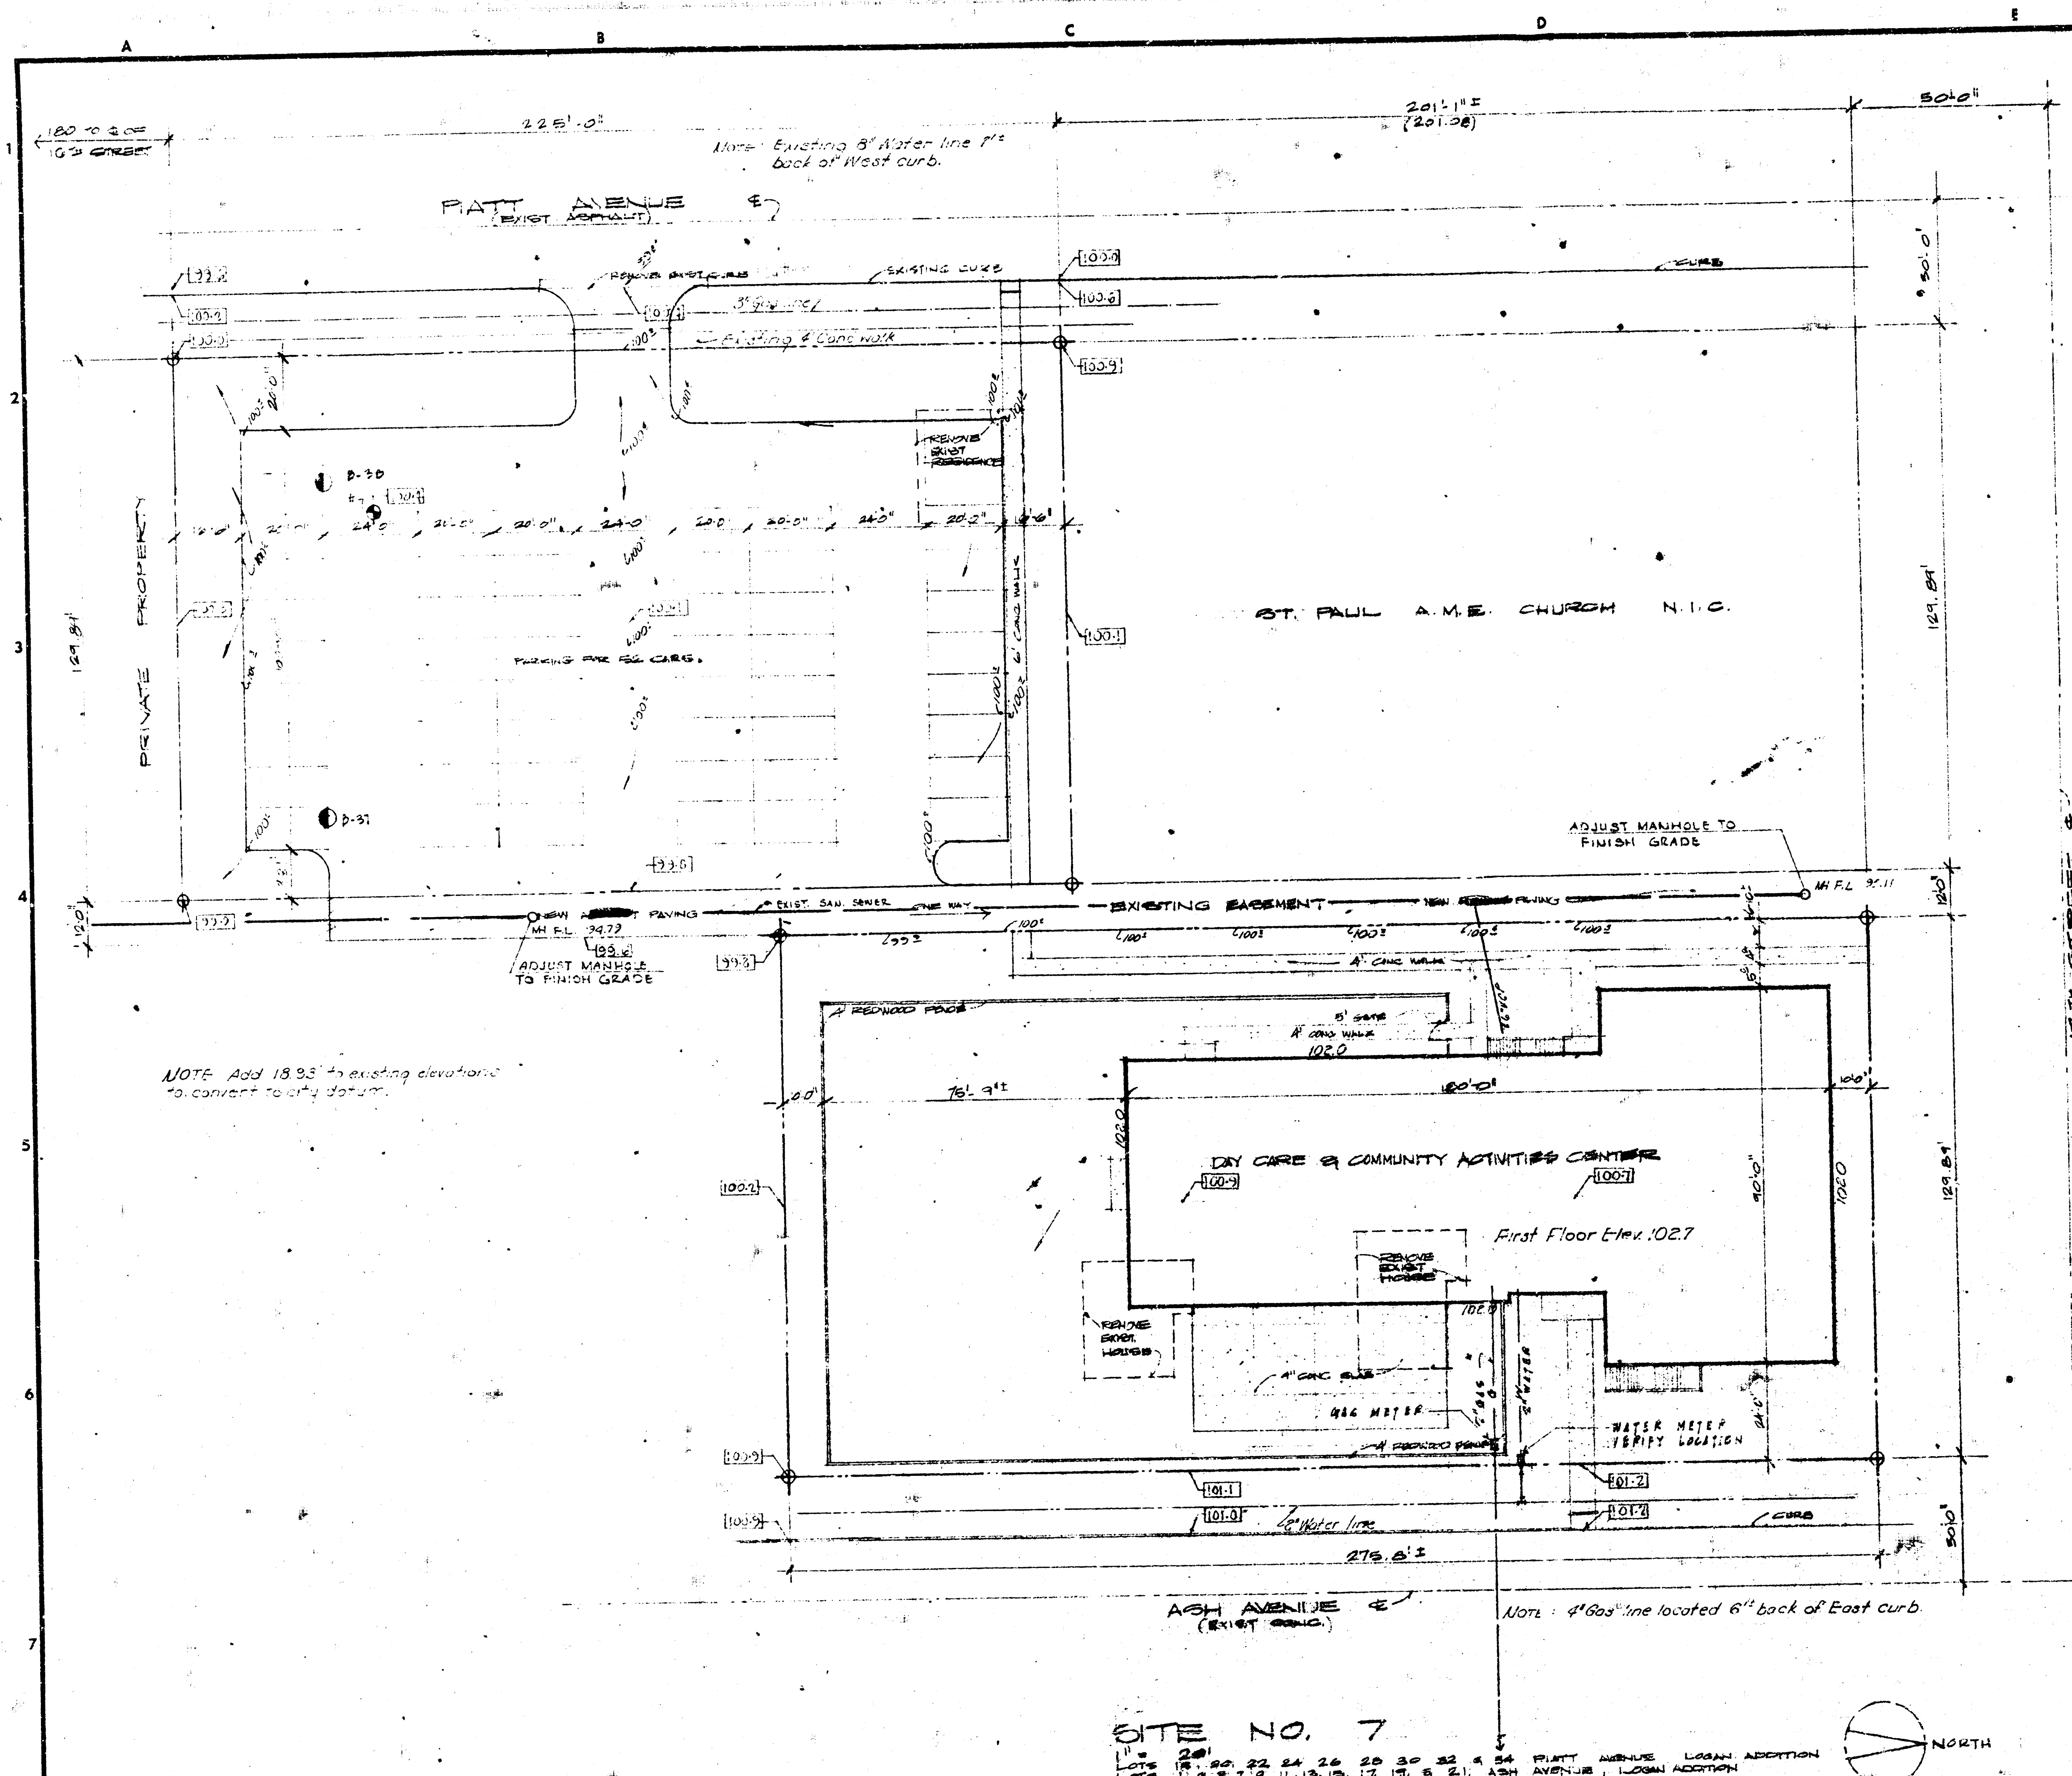

SITE NO. 7

1" = 20'

LOTS 18, 20, 22, 24, 26, 28, 30, 32, & 34 PLATT AVENUE, LOGAN ADDITION

LOTS 1, 3, 5, 7, 9, 11, 13, 15, 17, 19, & 21, ASH AVENUE, LOGAN ADDITION

W. H. JOHNSON - ARCHITECT
KANSAS CITY, MISSOURI

MANTEL & STEELE ASSOCIATE ARCHITECTS INC.
KANSAS CITY, MISSOURI


LOGAN 1-0273 (816)




SHEET NUMBER

4

TOTAL SHEETS

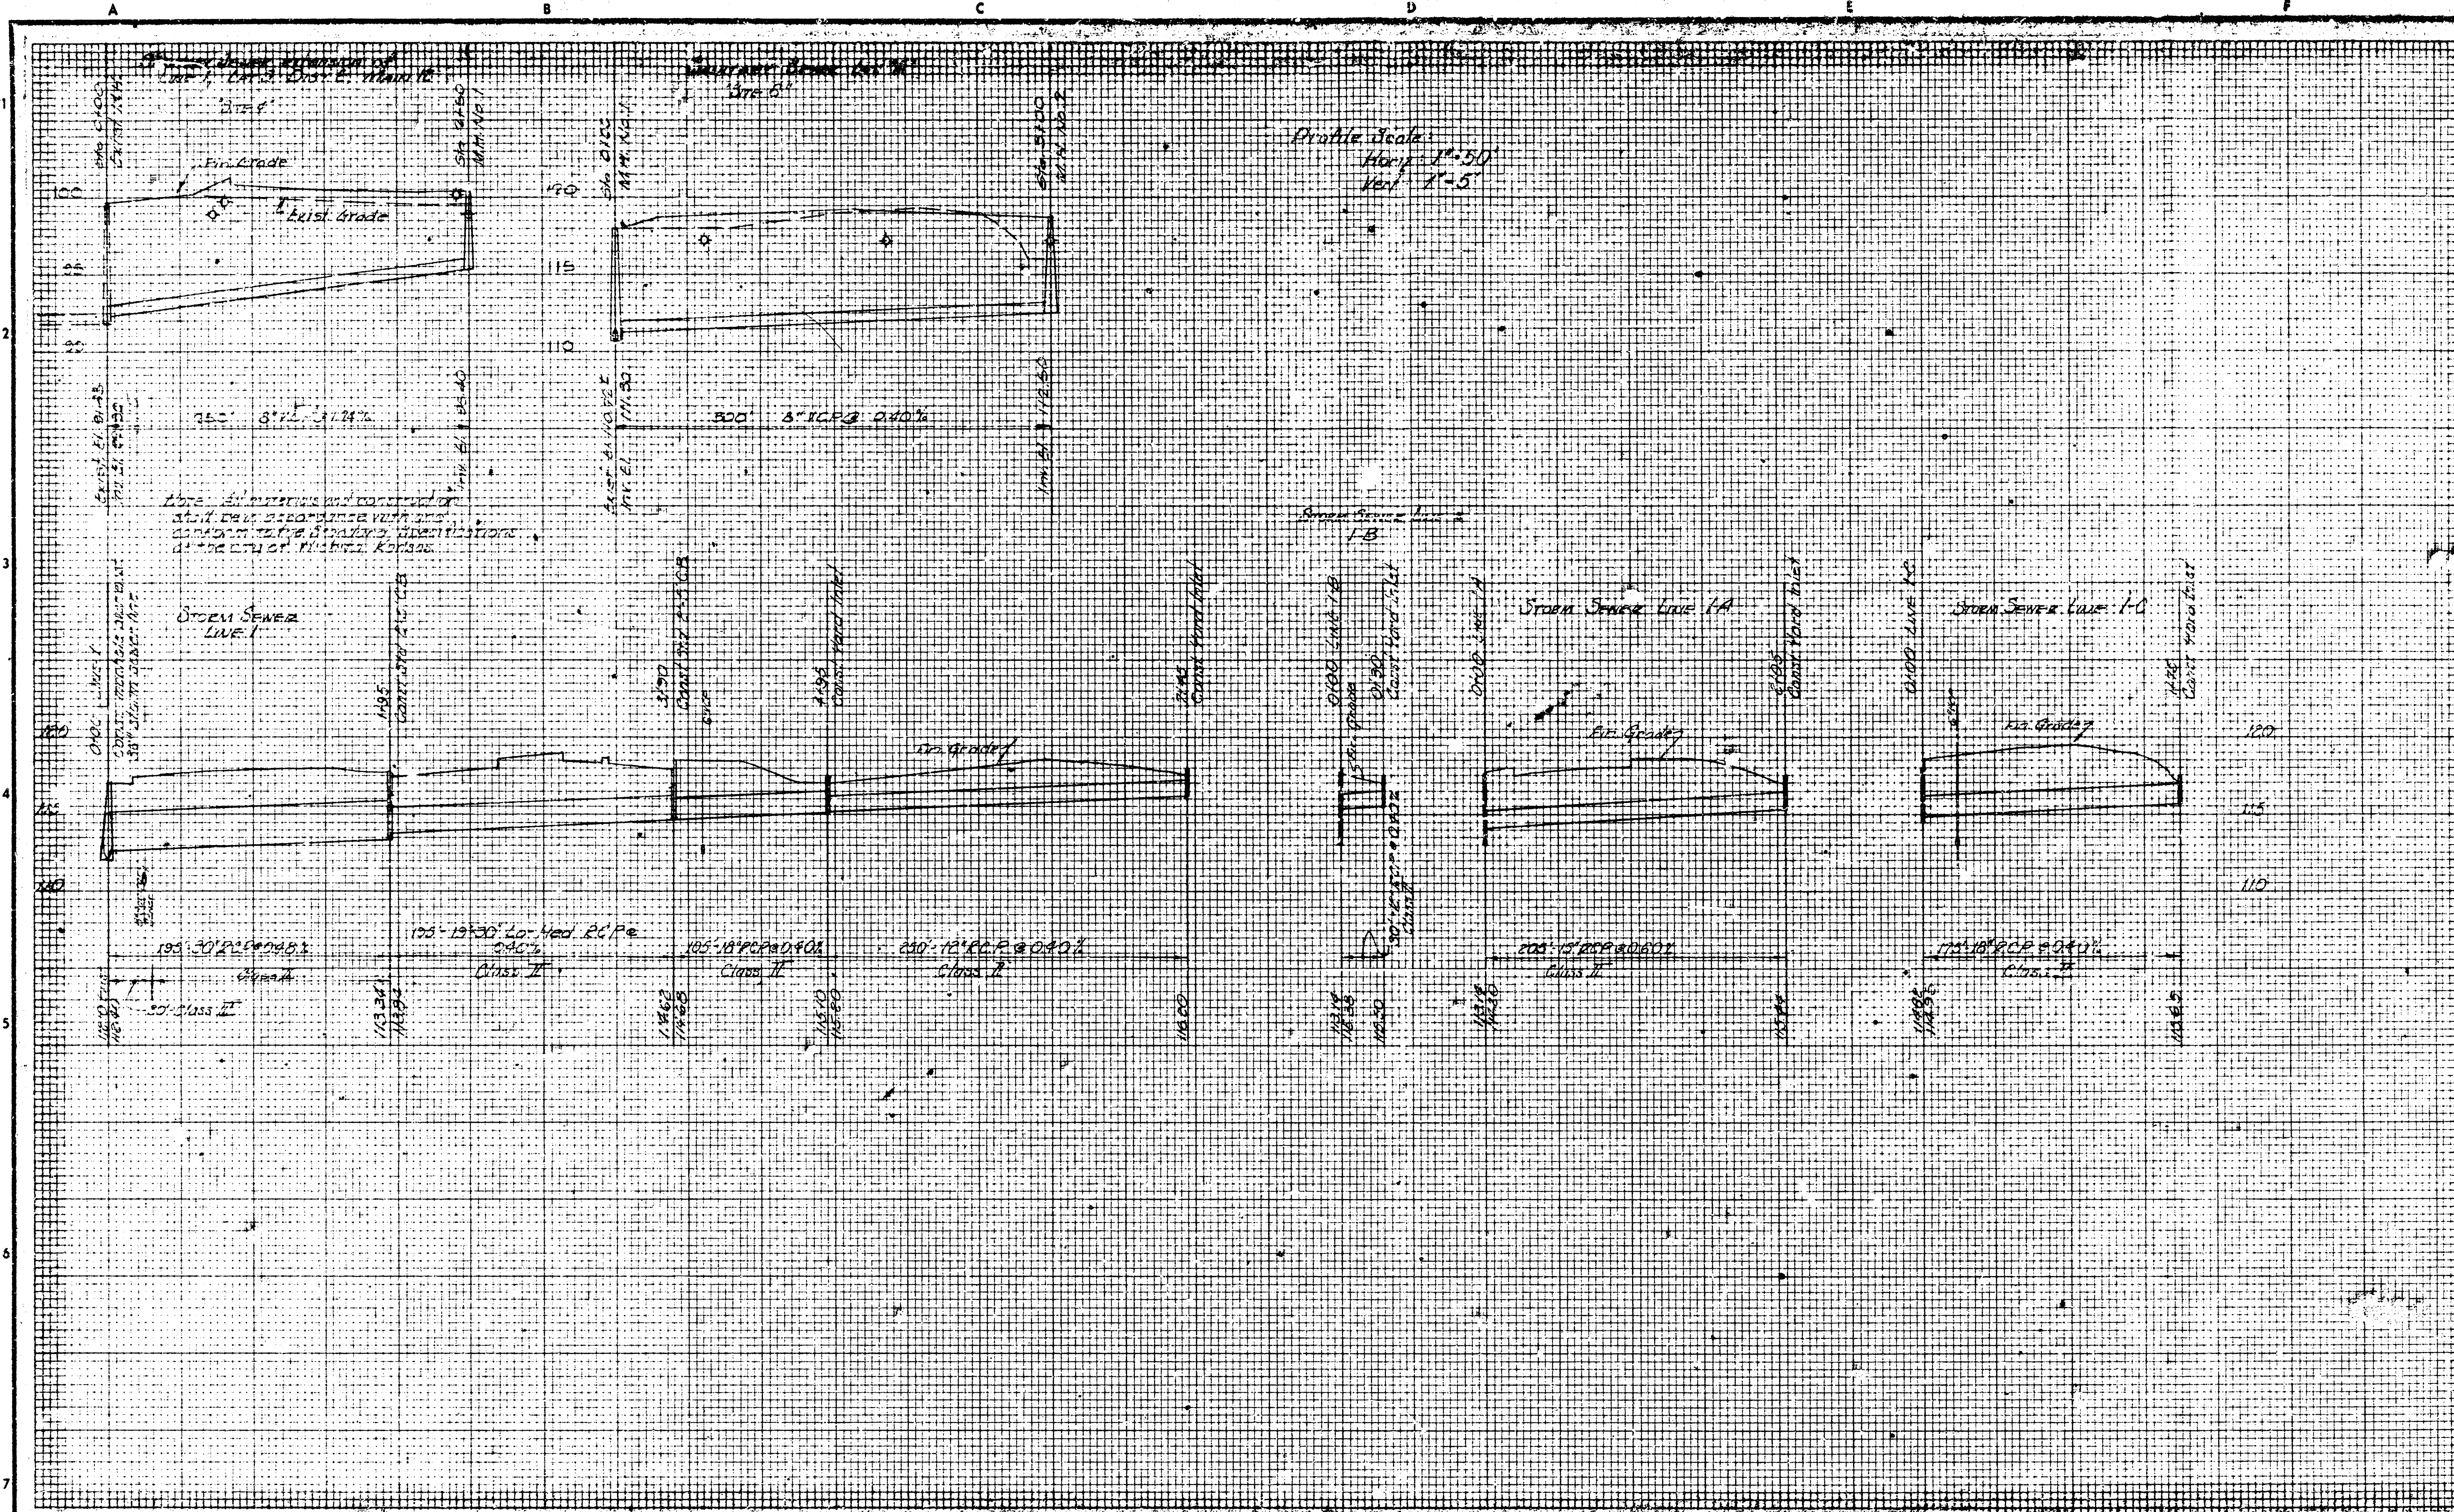

NOTE TO CONTRACTOR
 This project will be constructed under the supervision of the CITY ENGINEER and conforming to the SPECIFICATIONS of the CITY OF WICHITA. The CONTRACTOR will reimburse the City of Wichita for all cost of Engineering, Plans, and Inspection.
 The Elevations shown on this plan are tentative, they will be established or verified at time of construction by the City Engineering Dept.

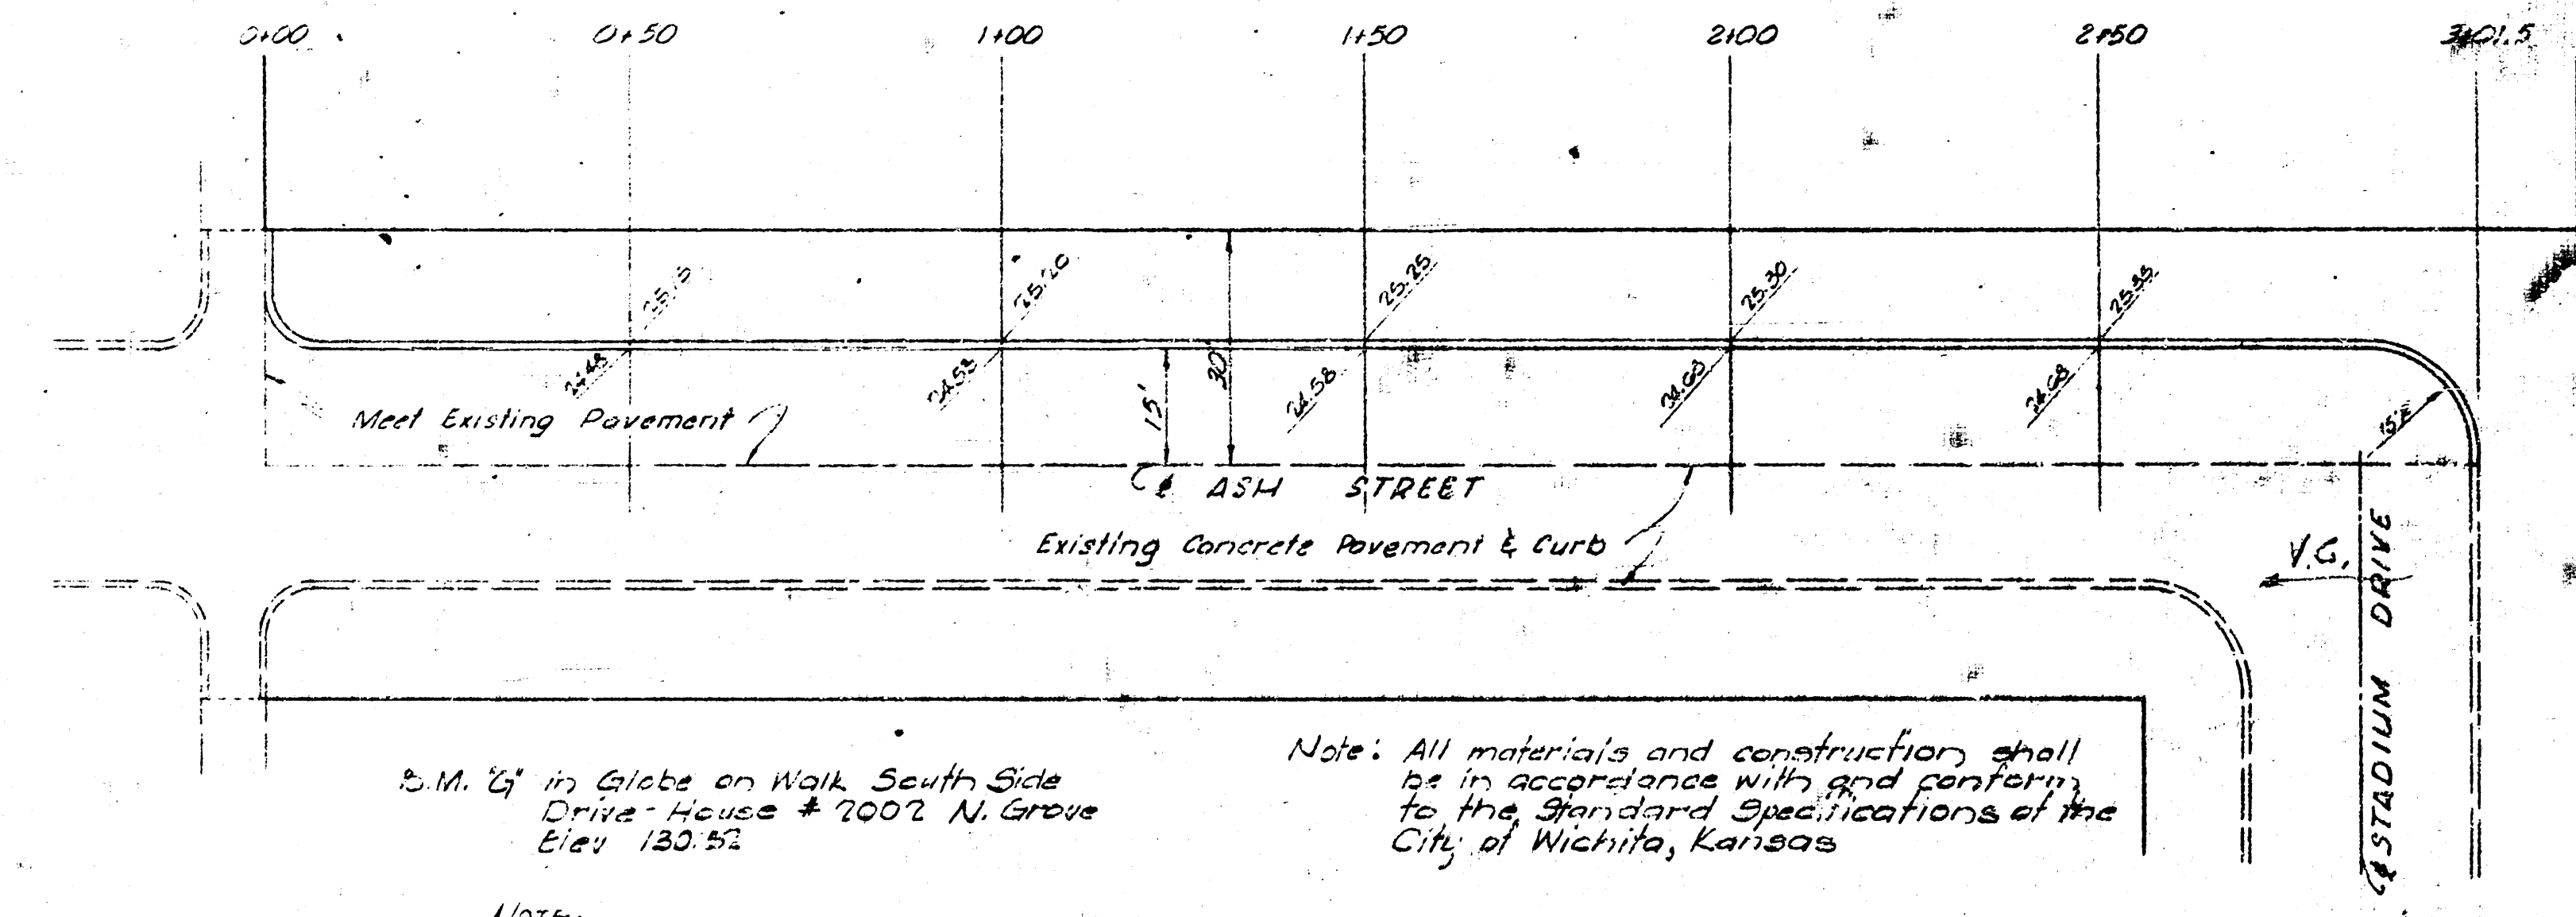

W. H. JOHNSON - ARCHITECT
 KANSAS CITY, MISSOURI
 1207 GRAND AVENUE



MANUEL & STEELE ASSOCIATE ARCHITECTS INC.
 KANSAS CITY, MISSOURI
 4550 MAIN STREET
 ALLEN KENNEDY, MANOR, INC.
 1755 North Platt, Wichita, Kansas

DATE NUMBER	LOGAN 1-0273 (516)
DATE	
DRAWN BY	
CHECKED BY	
DATE ISSUED	
REVISIONS	
ENGINEER	
ENGINEER	

SHEET NUMBER



U1

TOTAL SHEETS

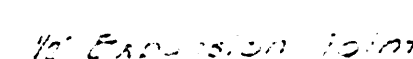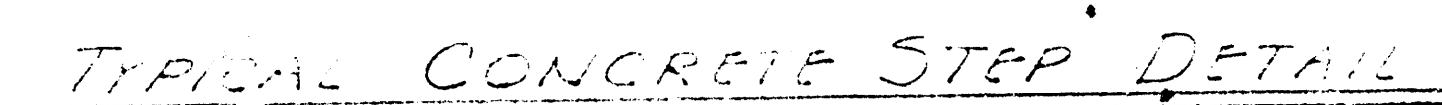


EXPANSION JOINT CONTRACTION JOINT

1. Buckle is centered with seat belt
2. Buckle is positioned so that it is not more than 50 (rear) centimeters from the middle of the seat
3. Buckle is positioned so that it is not more than 50 (rear) centimeters from the middle of the seat
4. Buckle is positioned so that it is not more than 50 (rear) centimeters from the middle of the seat

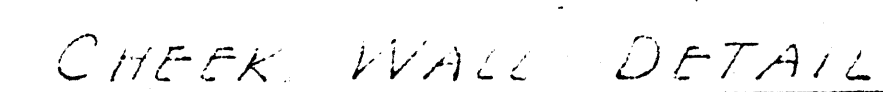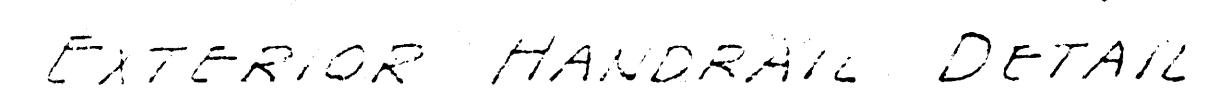

CONCRETE PAVEMENT DETAILS

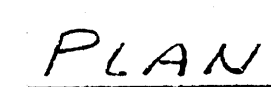

YARD INLET DETAILS

W. H. JOHNSON - ARCHITECT
1207 GRAND AVENUE
KANSAS CITY, MISSOURI

MANTEL & STEIFFE
KANSAS CITY, MISSOURI
4550 MAIN STREET

ALLEN KENNEDY MANOR INC.
1756 North Platt, Wichita, Kansas

ARCHITECTS
LOGAN 1-0273 (£16)

☐ JOB NUMBER
☐ MS. _____
☐ DRAWN BY
☐ _____
☐ DATE DRAWN
☐ _____
☐ DATE ISSUED
☐ _____
☐ CHECKED BY
☐ _____
☐ REVISIONS
☐ _____
☐ _____
☐ _____
☐ ENGINEERS
☐ _____
☐ ENGINEERS
☐ _____

SHEET NUMBER

D1

TOTAL SHEETS

