

BENCHMARKS:

BM #1: "□" on west end of median approx. 1020' west of intersection of Hillside and 45th St. N.
Elev. = 1348.19 MSL


BM #2: "□" on hub guard at the SE corner of bridge approx. 2130' west of intersection of Hillside and 45th St. N.
Elev. = 1346.24 MSL

Sta 0+34.7 to Sta 0+50.3
Install 15.6 L.F. Flowable Fill per City Specs.
Top Elev. = 1349.5

Sta 0+00, Begin Line 1A
= Sta 6+15.6, Line 1
= Sta 0+00, Line 1B

All trench and manhole excavation areas from Sta. 0+00 to Sta. 0+85.4, Line 1A shall be backfilled with sand. The sand backfill shall be within two feet of existing grade and shall be water-jetted and vibrated during backfilling. All costs shall be subsidiary to pipe cost.

Scale:
1" = 40' Horizontal
1" = 5' Vertical
• = Iron

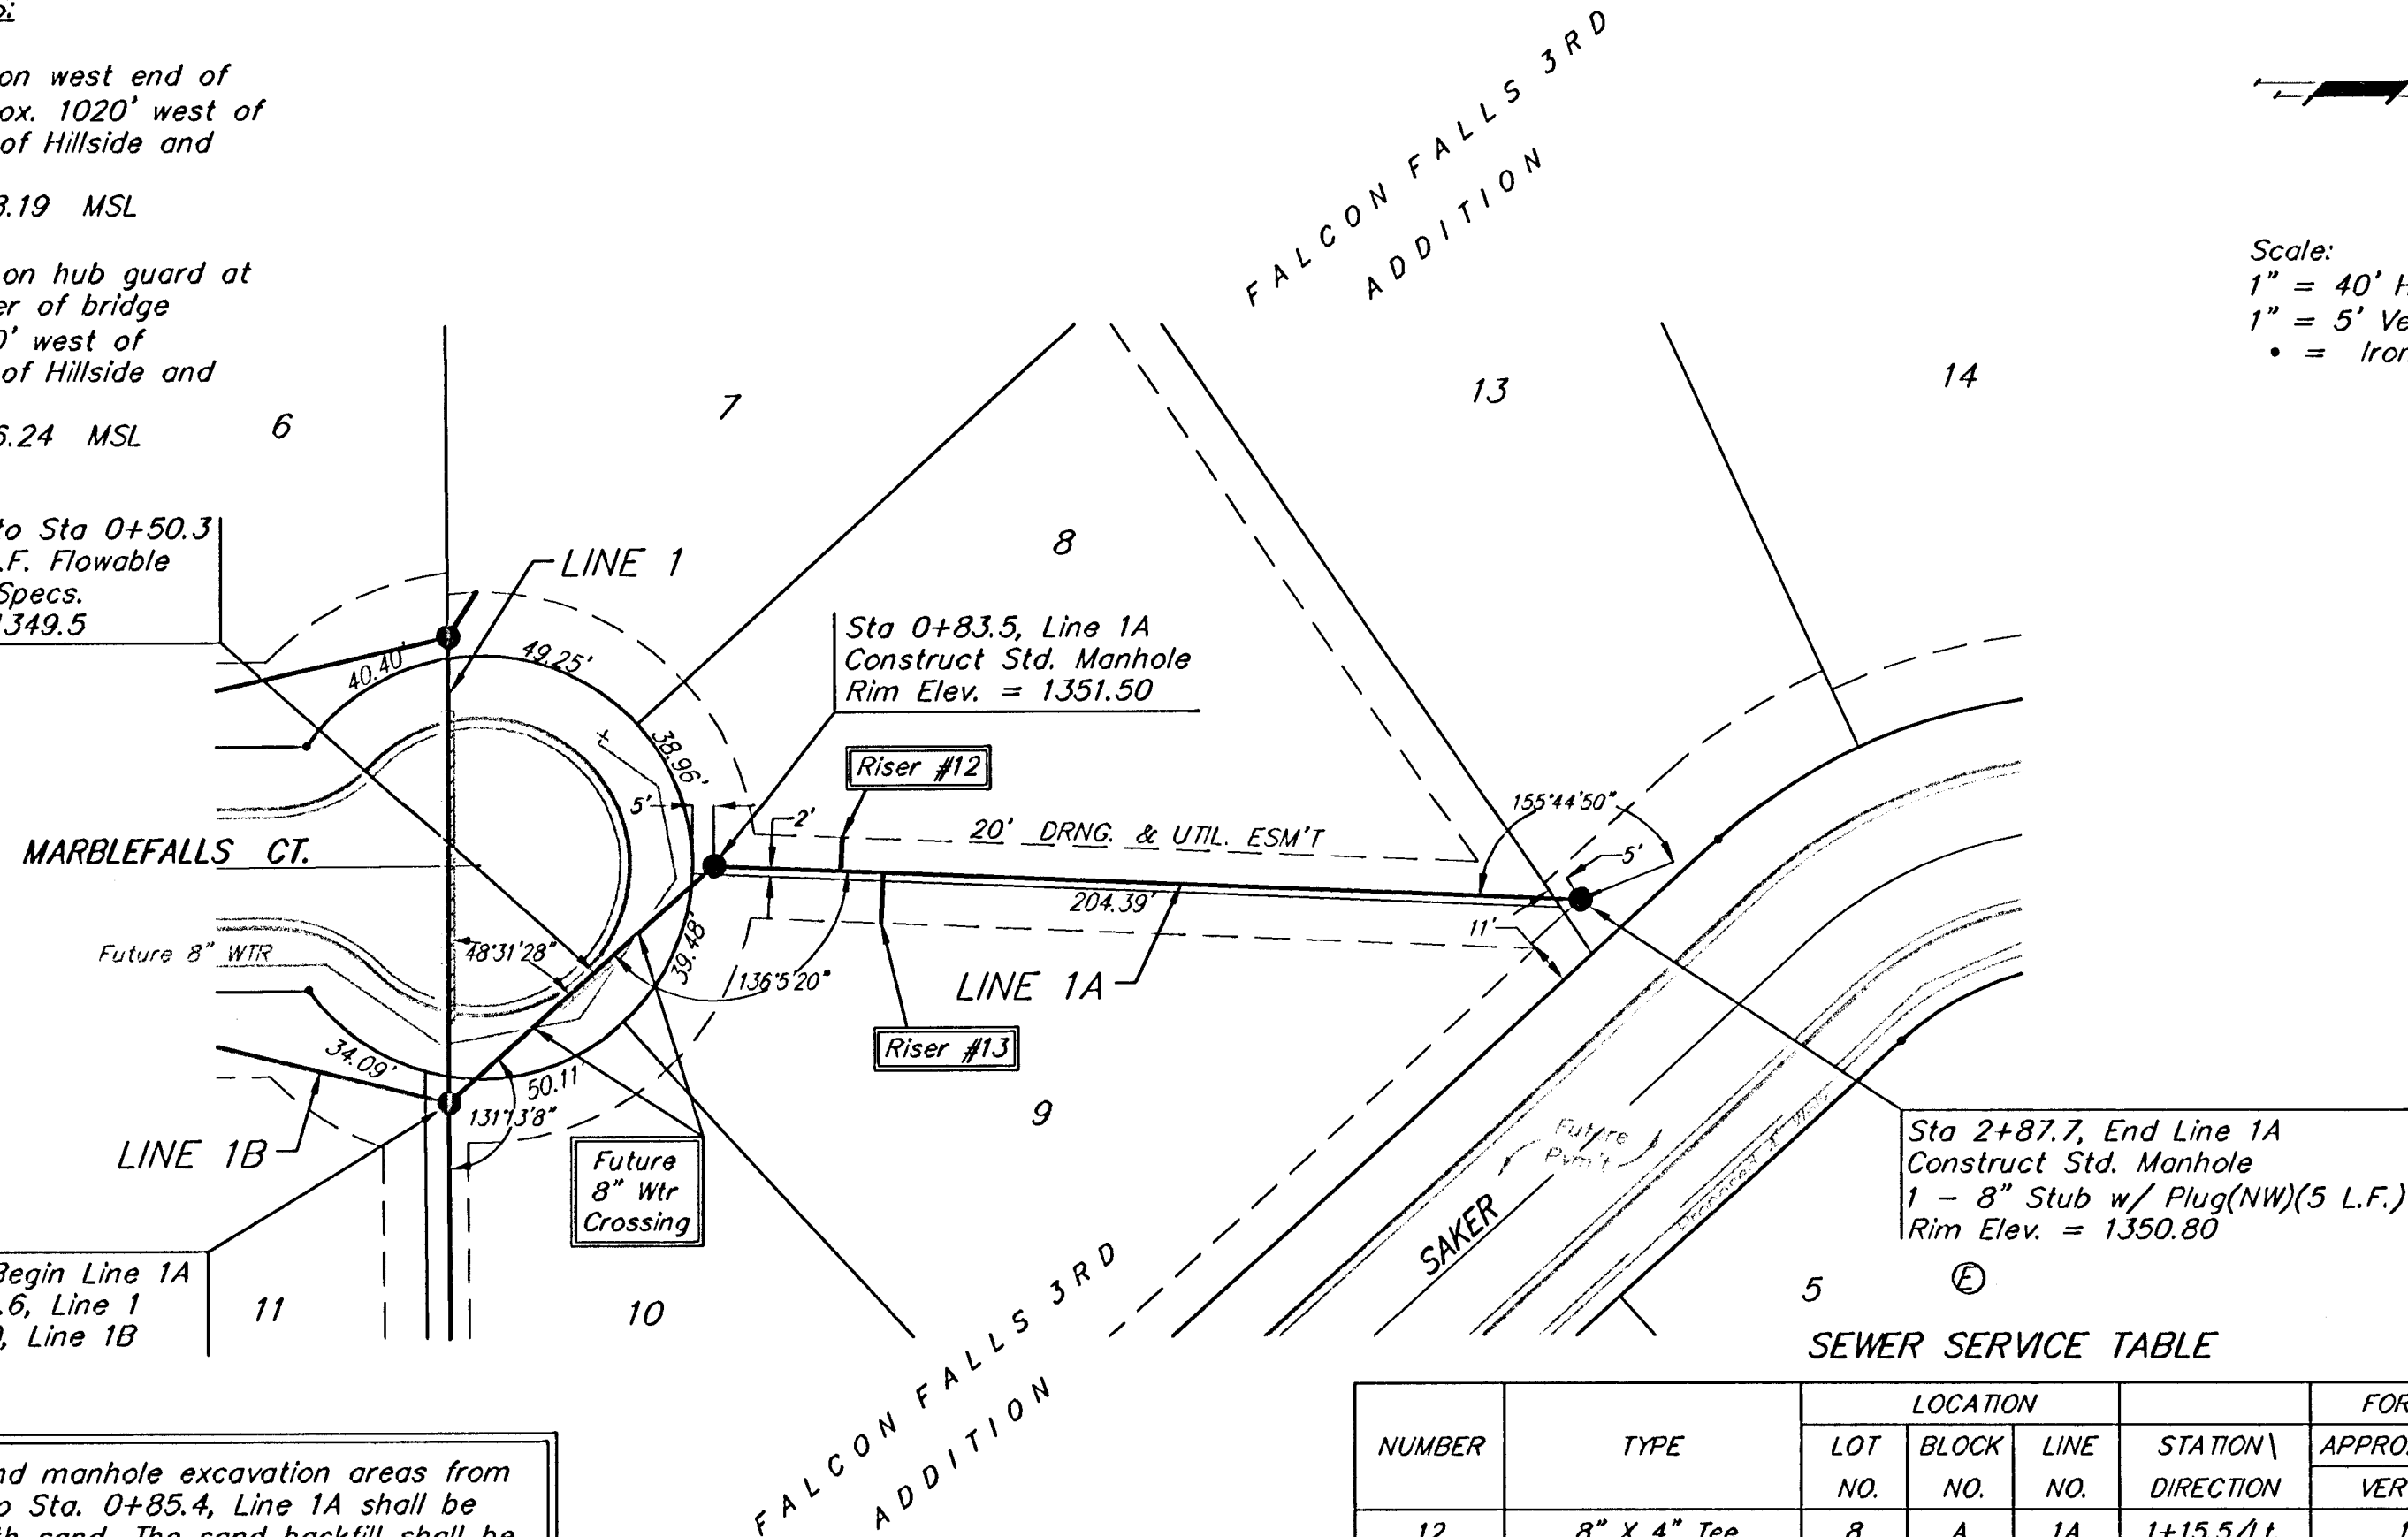


SEWER SERVICE TABLE

NUMBER	TYPE	LOCATION				FOR INFORMATION ONLY	
		LOT NO.	BLOCK NO.	LINE NO.	STATION \ DIRECTION	APPROXIMATE LENGTH 4" PIPE	
12	8" X 4" Tee	8	A	1A	1+15.5/Lt.	13'	18' 8"
13	8" X 4" Tee	9	A	1A	1+25.5/Rt.	13'	18' 12"

NOTE: Vertical Riser Pipe shall be extended to 2' minimum above ground water elevation and 4' maximum below proposed ground elevation.



Scale:
1" = 40' Horizontal
1" = 5' Vertical
• = Iron

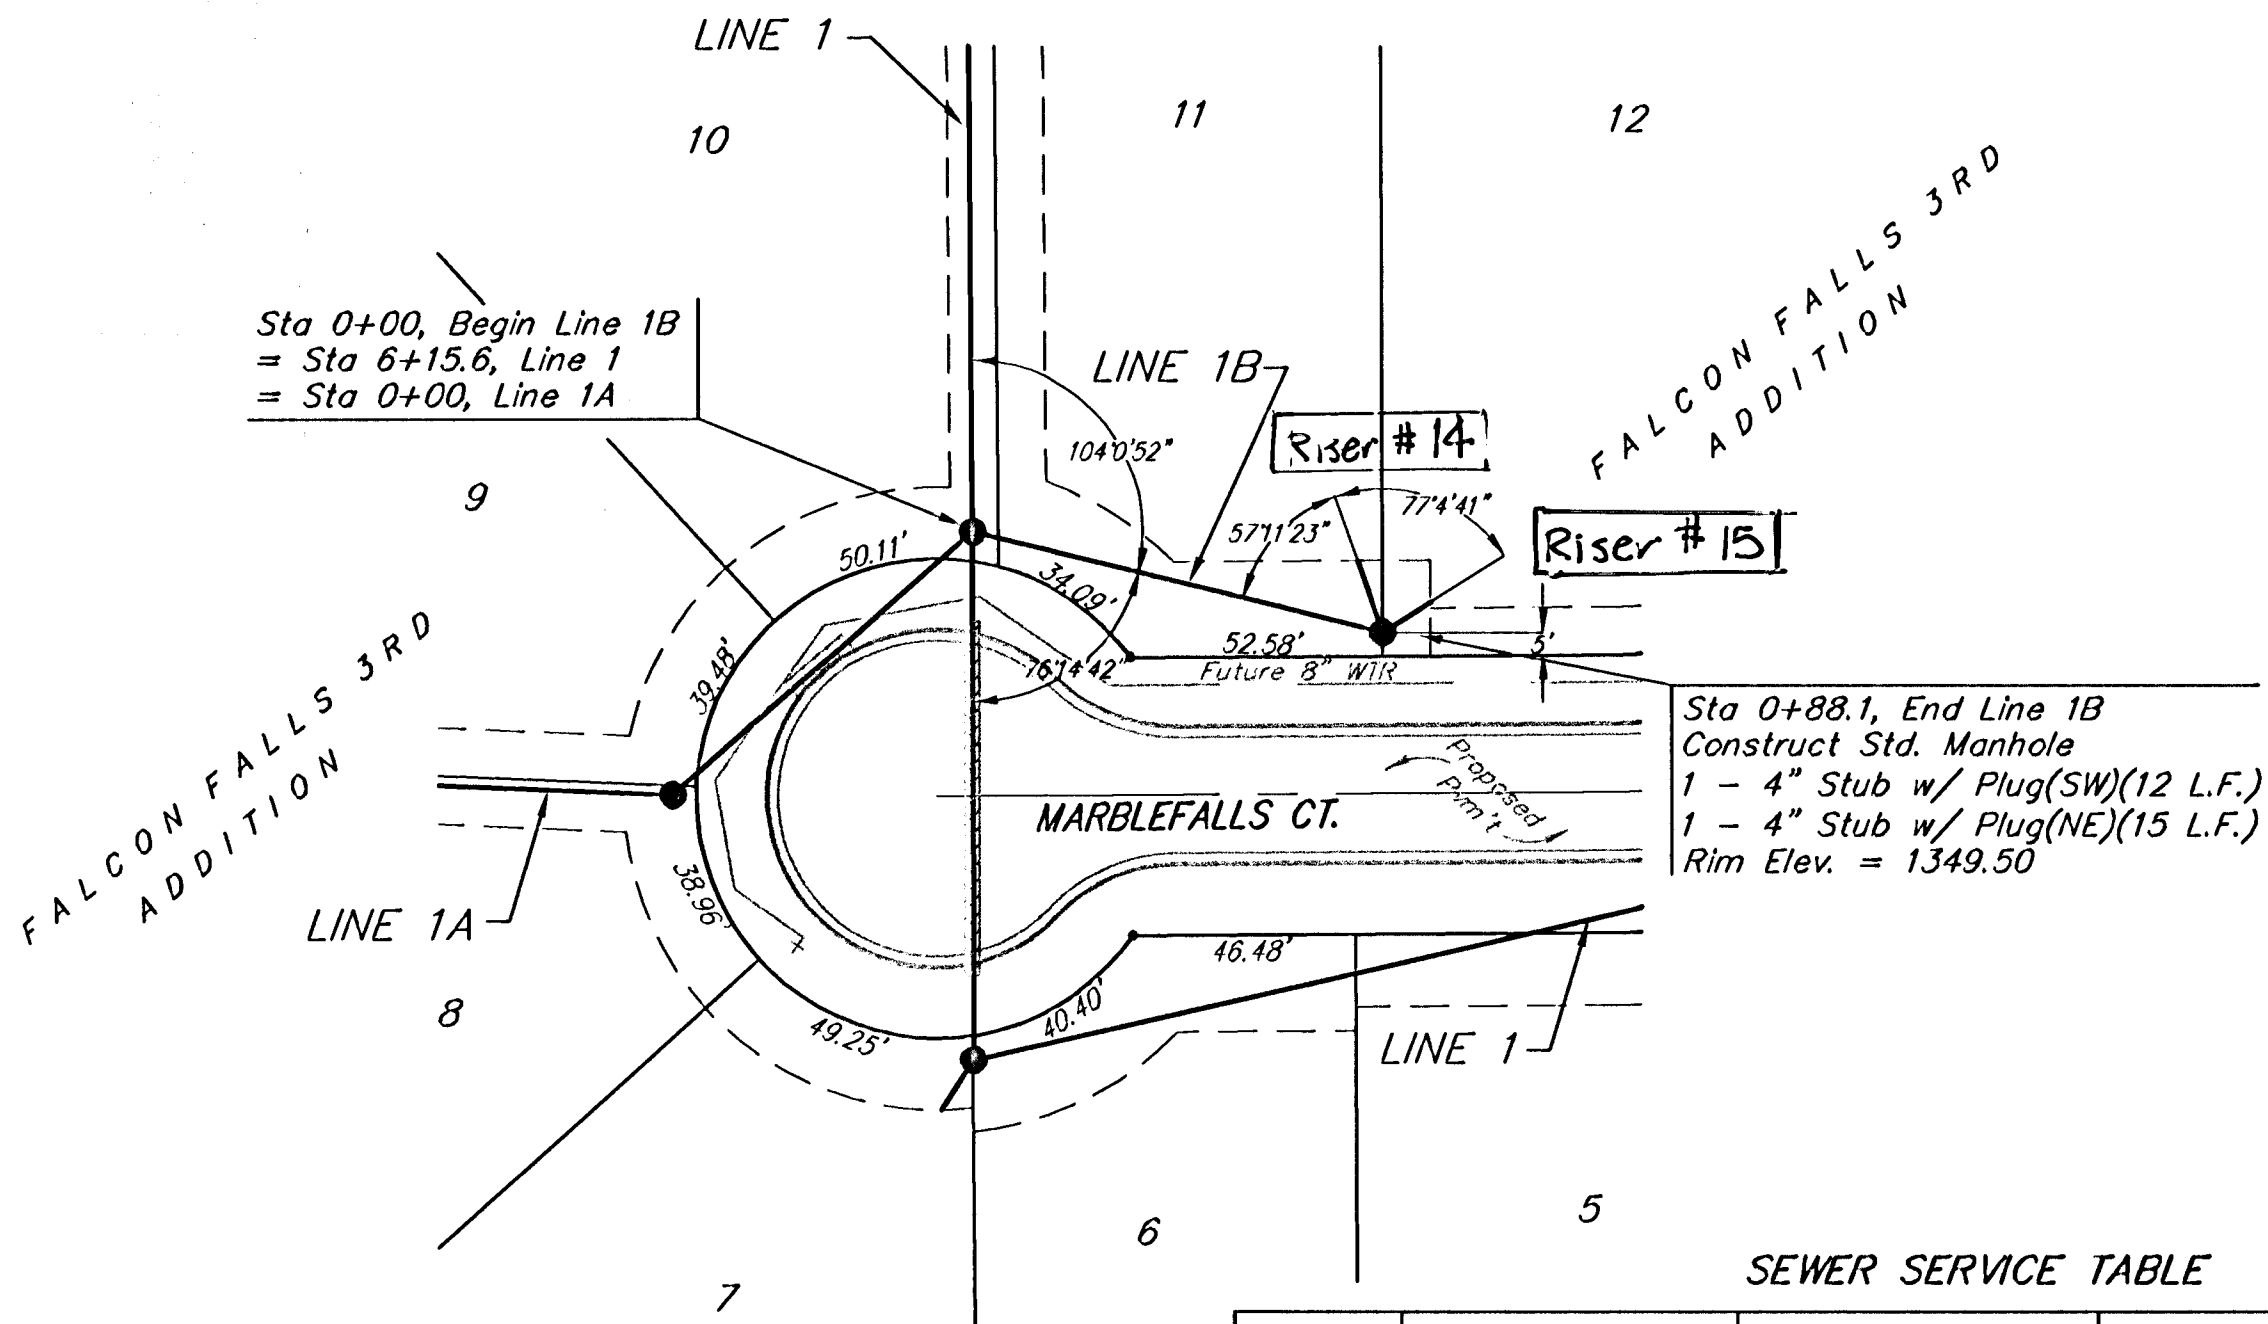

SEWER SERVICE TABLE

NUMBER	TYPE	LOCATION				FOR INFORMATION ONLY	
		LOT NO.	BLOCK NO.	LINE NO.	STATION \ DIRECTION	APPROXIMATE LENGTH 4" PIPE	
14	4" Stub w/ Riser	11	A	1B	0+88.1/Lt.	9'	15'
15	4" Stub w/ Riser	12	A	1B	0+88.1/Lt.	9'	12'

NOTE: Vertical Riser Pipe shall be extended to 2' minimum above ground water elevation and 4' maximum below proposed ground elevation.

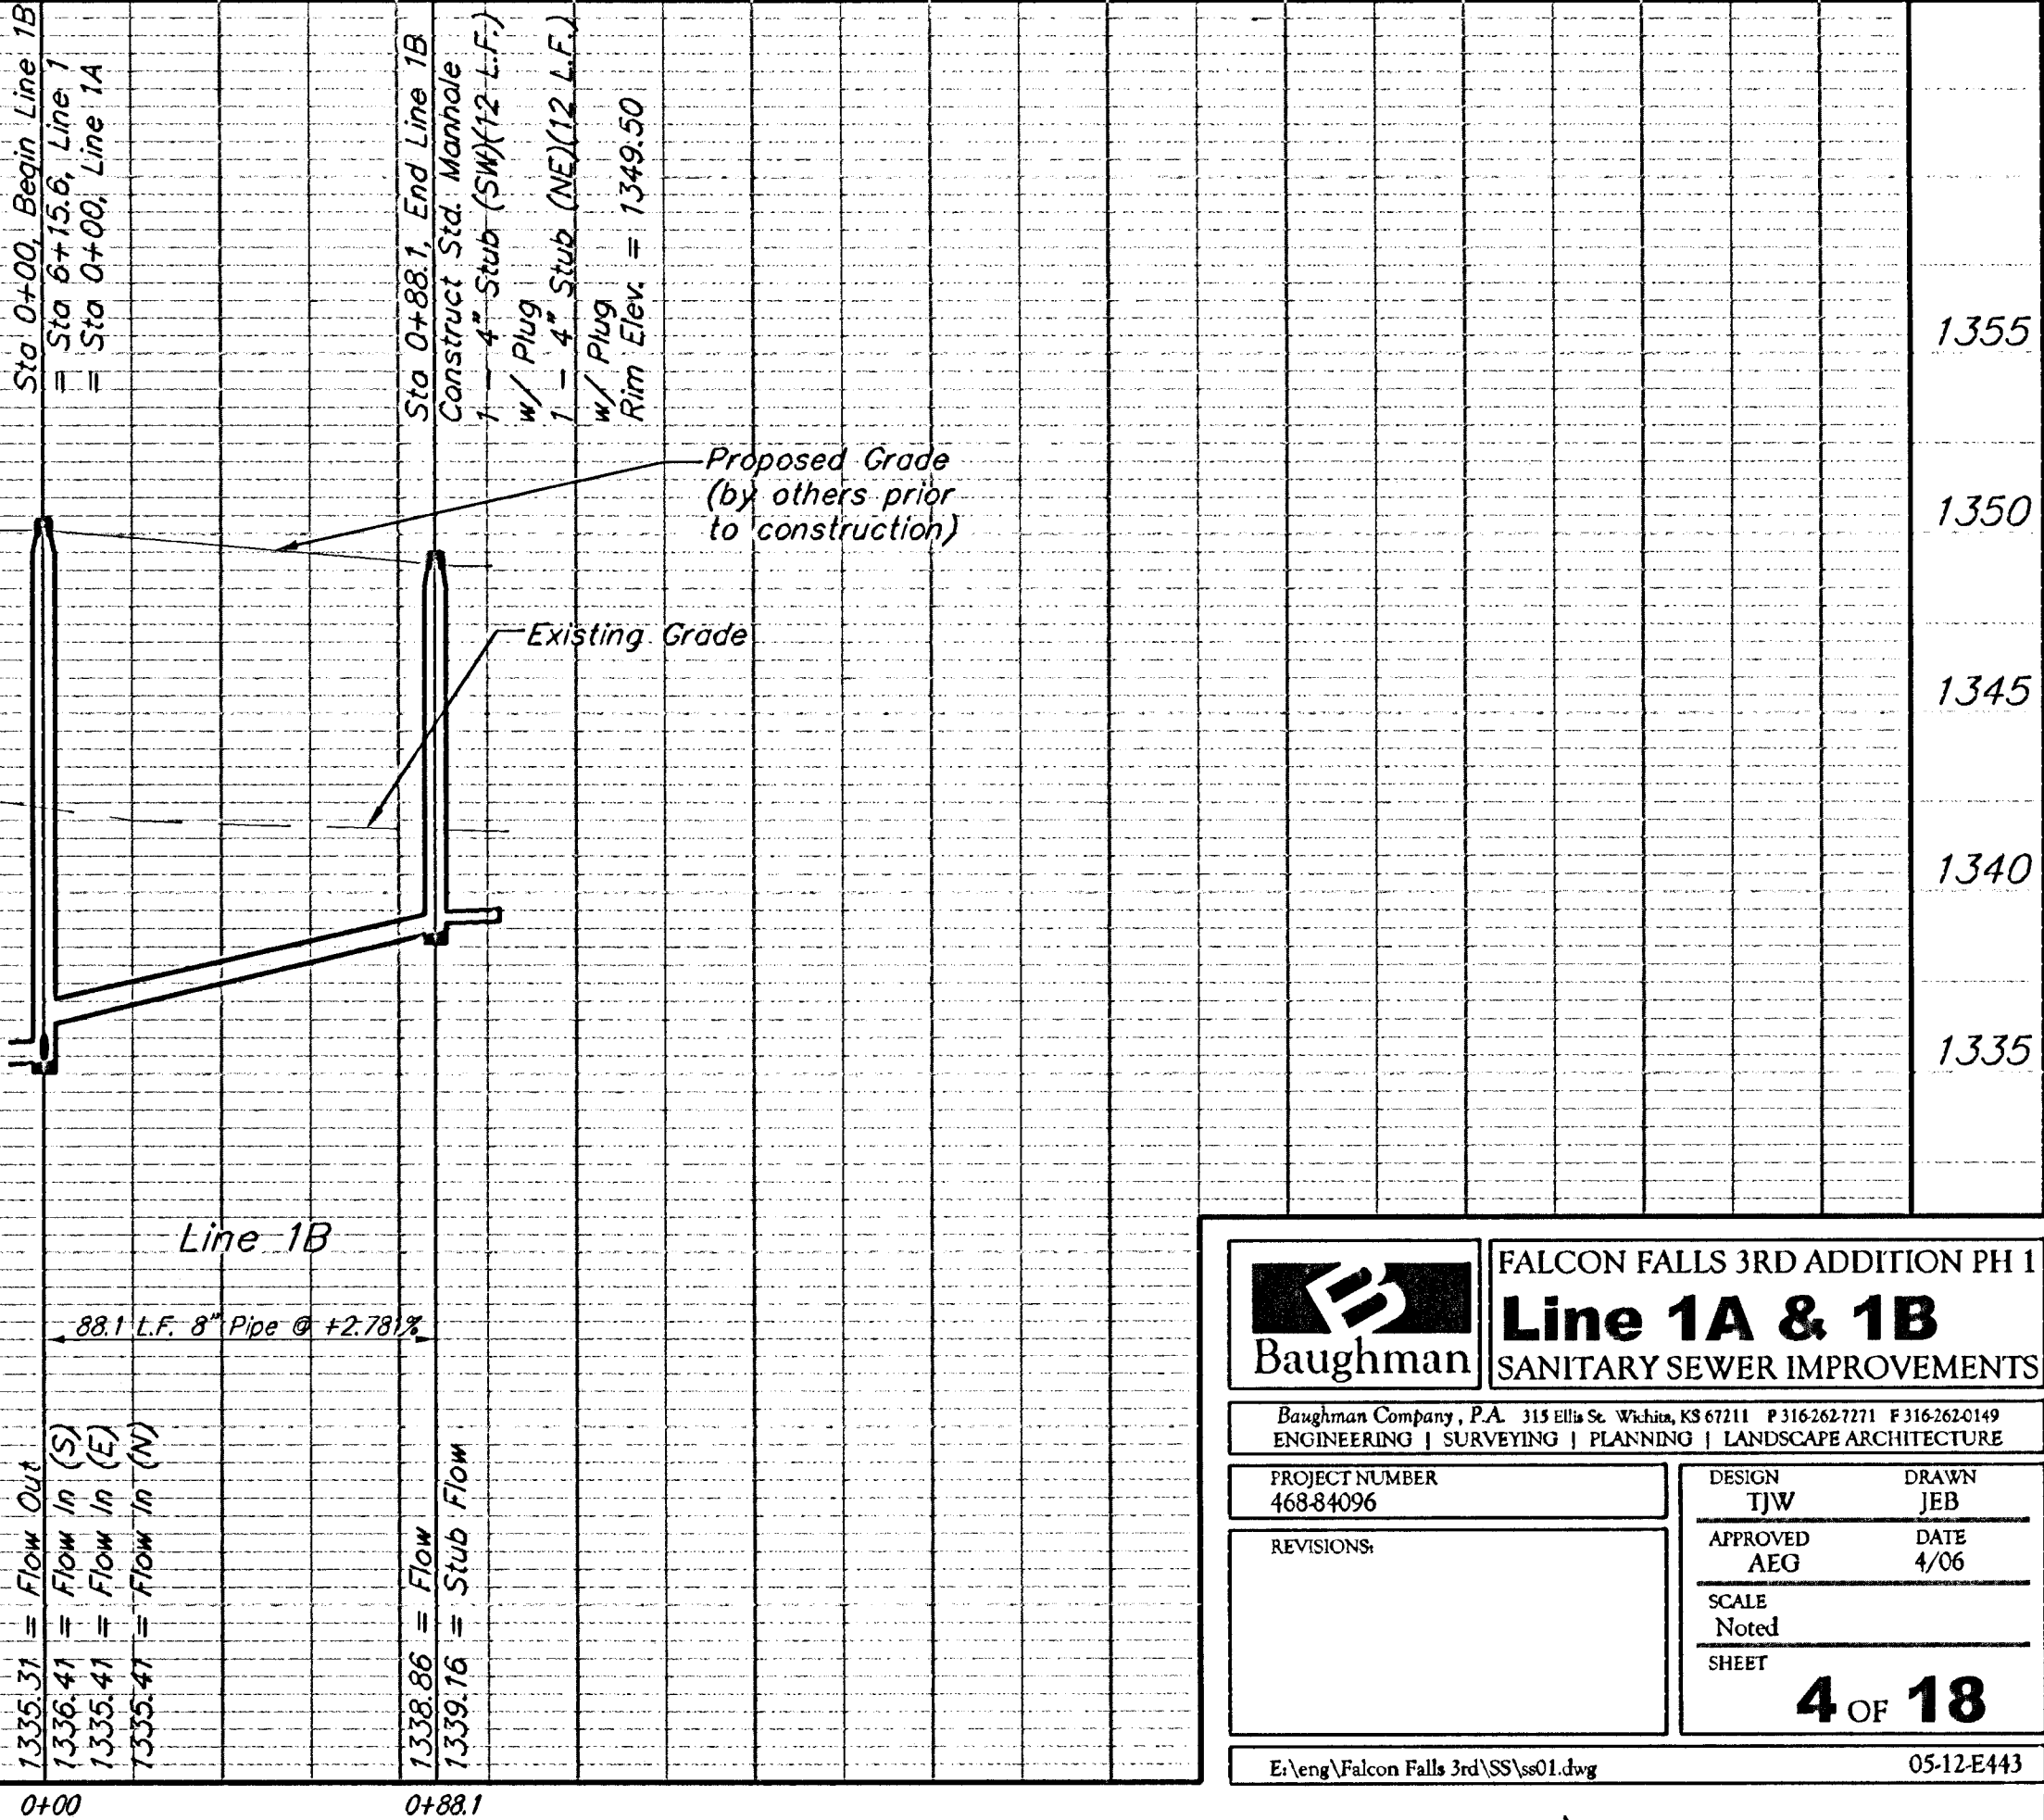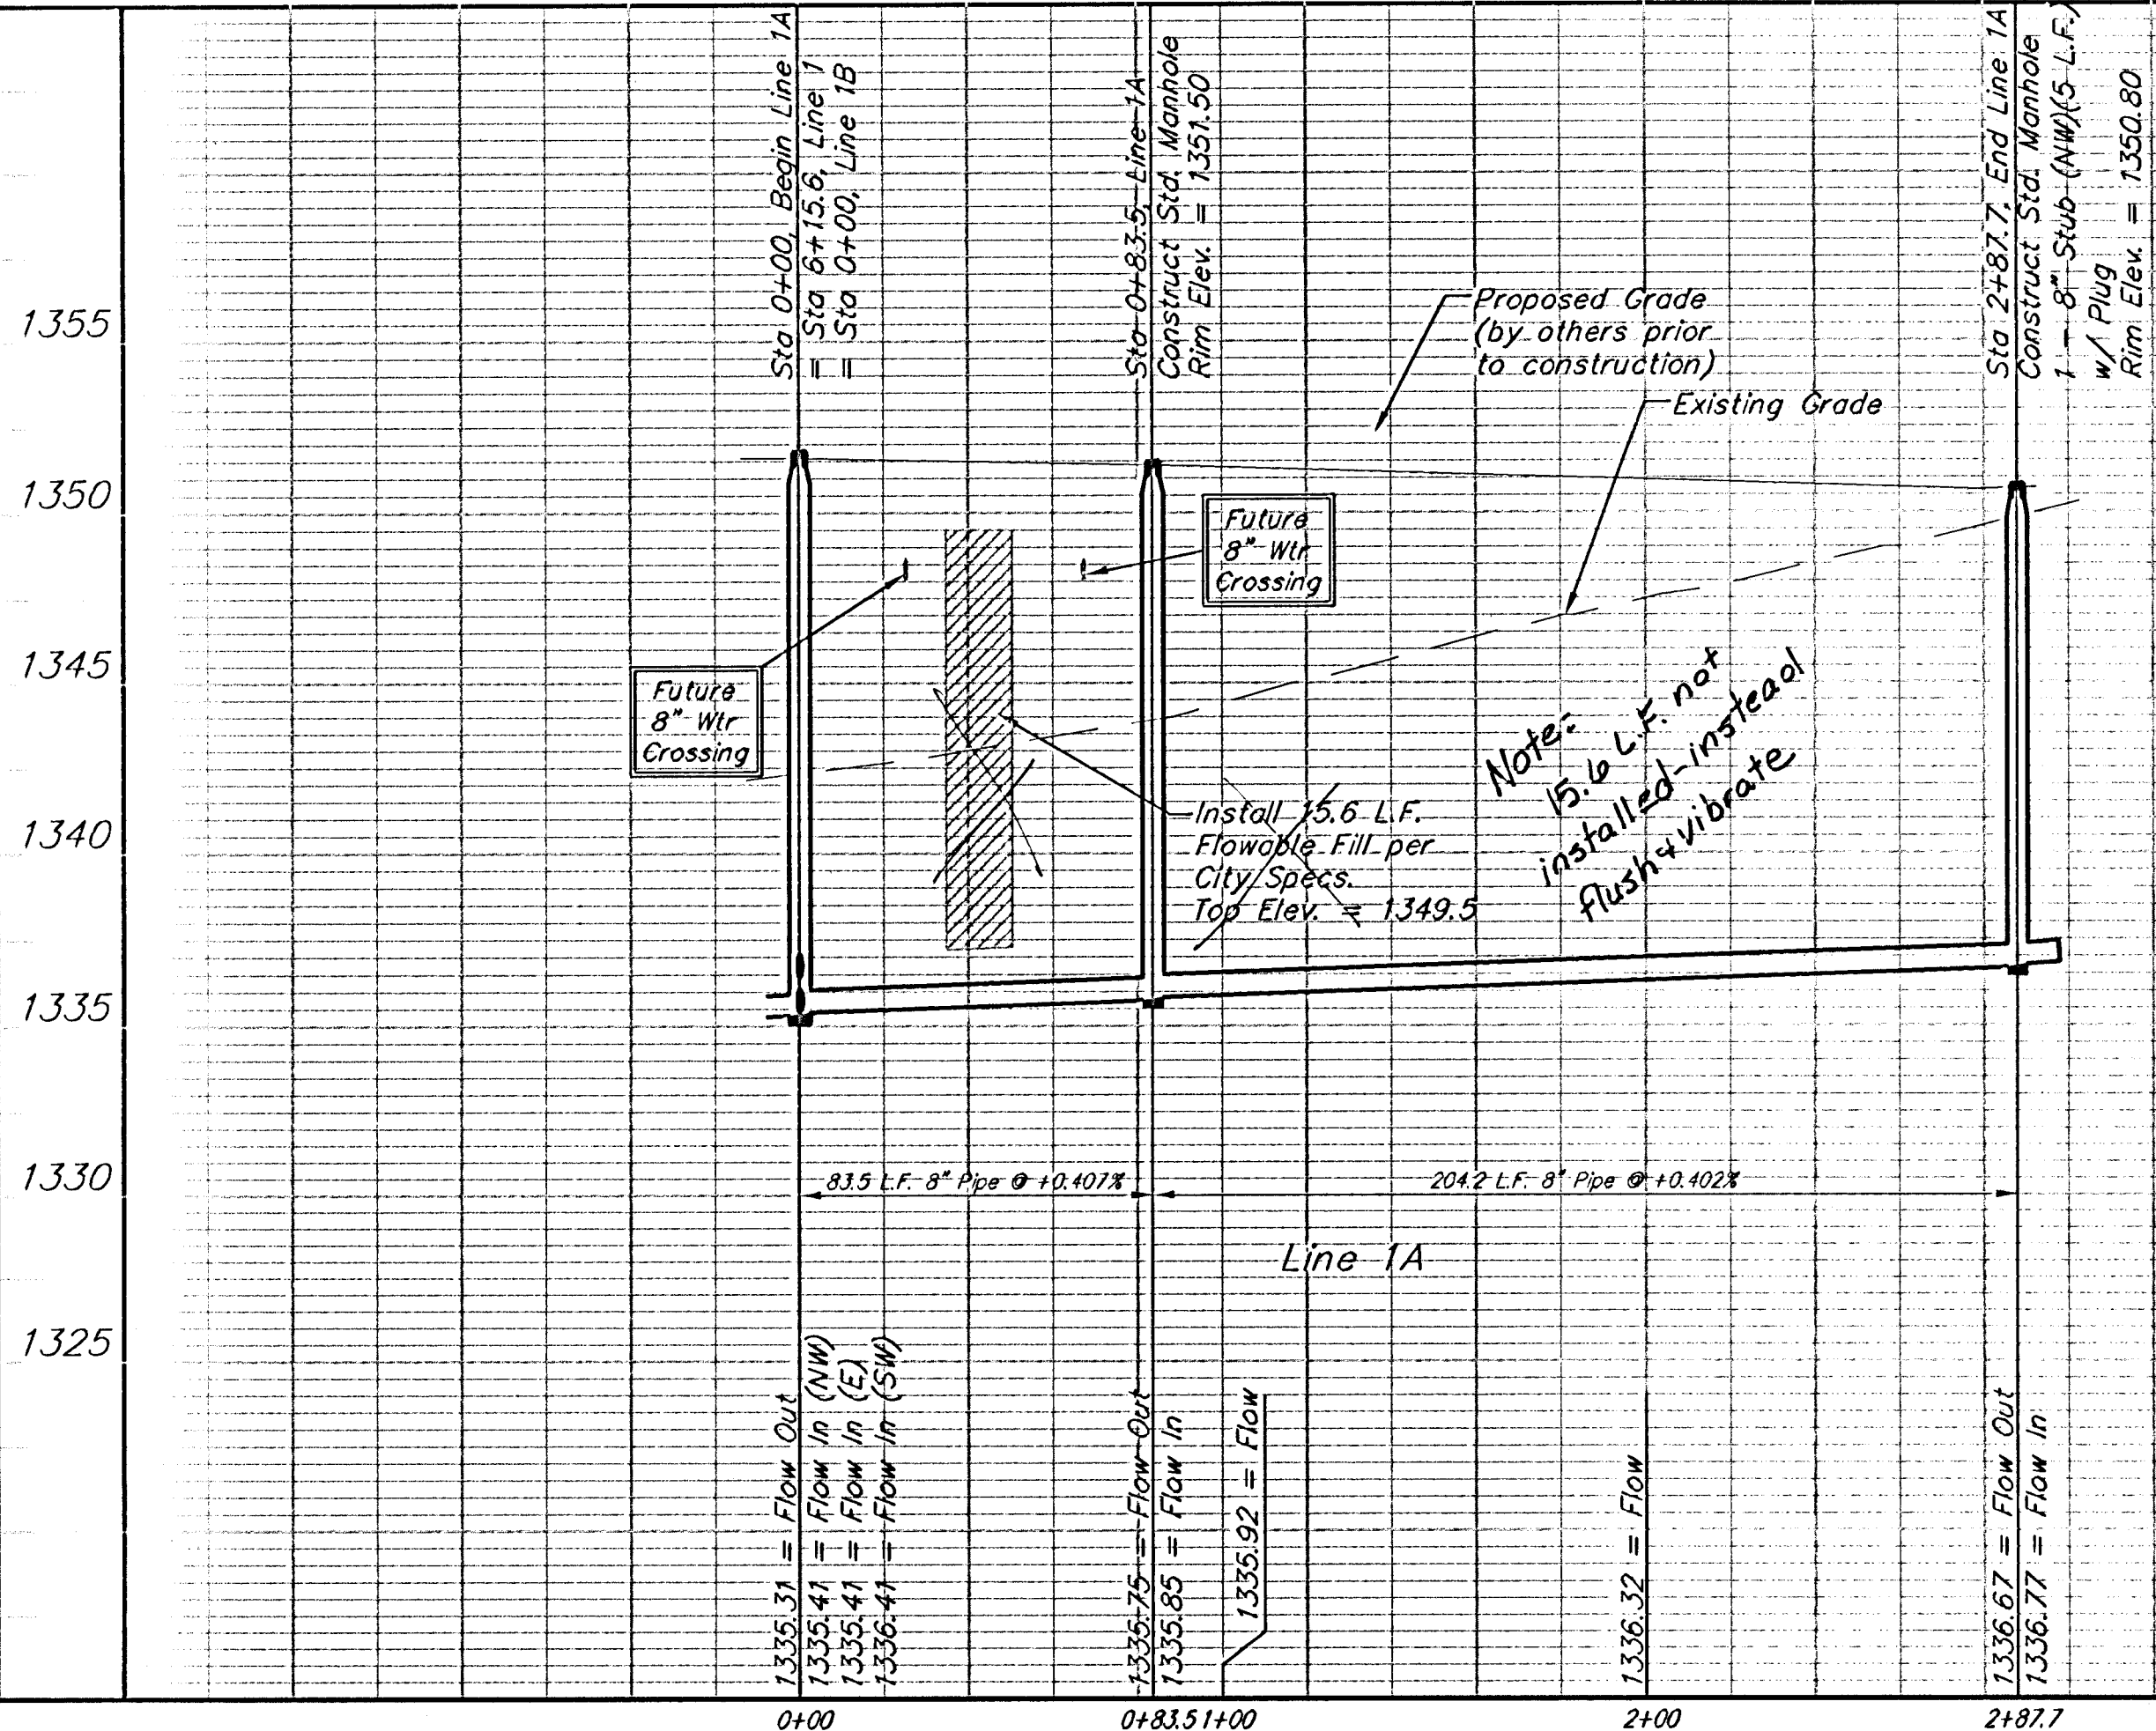



FALCON FALLS 3RD ADDITION PH I
Line 1A & 1B
SANITARY SEWER IMPROVEMENTS

PROJECT NUMBER
468-84026

DESIGN
TJW

APPROVED
AEG

SCALE
Noted

SHEET
4 OF 18

DESIGN
TJW

DATE
4/06

REVISIONS:

05-12-E443