
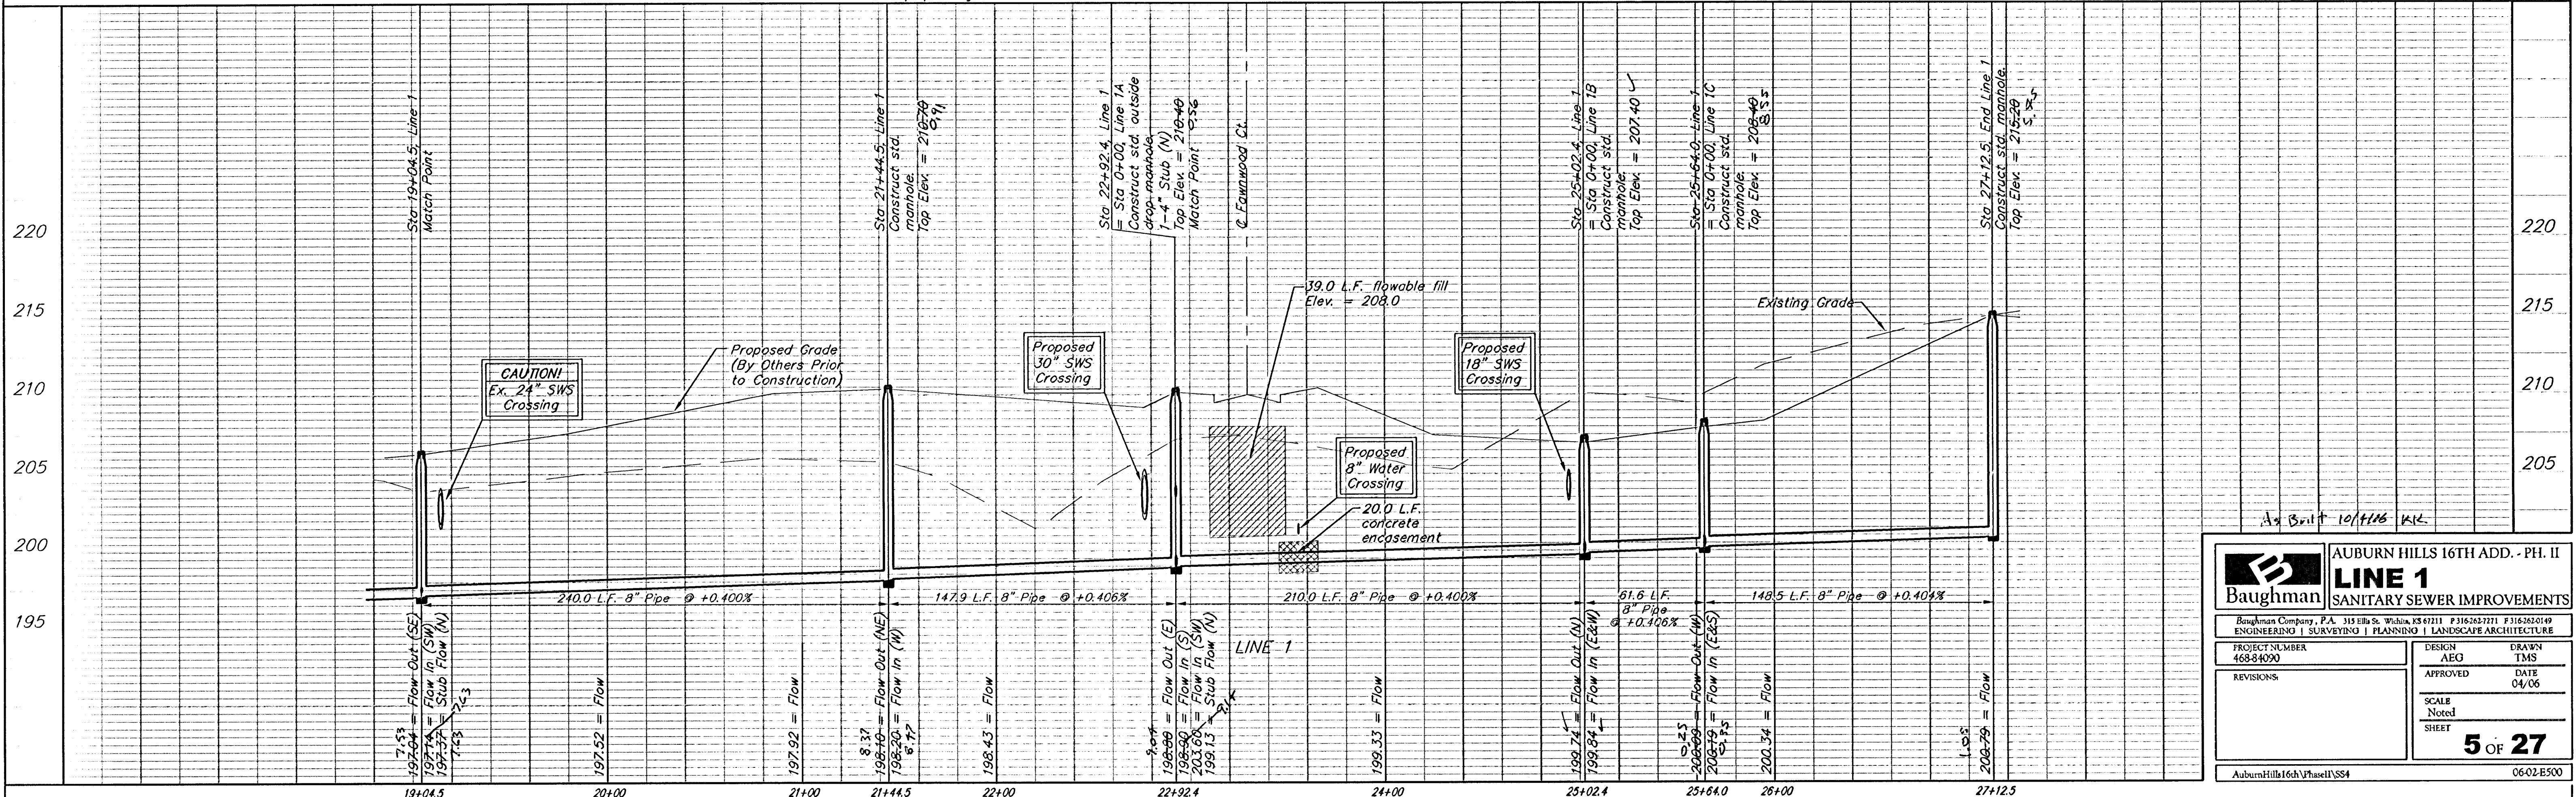


# **BENCHMARKS:**

BM #1: "C" Cut on Top of Curb at West Line of Lot 7, Block A, Auburn Hills 5th Addition. Elev. = 207.73 (City Datum)

BM #2: Disc in Back of Curb, North of Front Corner Common to Lots 23 and 24, Block D, Auburn Hills 12th Addition. Elev. = 191.84 (City Datum)

BM #3: "C" Cut in Middle of Curb Inlet Top Adjacent to the South Corner of Lot 15, Block B. Elev. = 193.65 (City Datum)

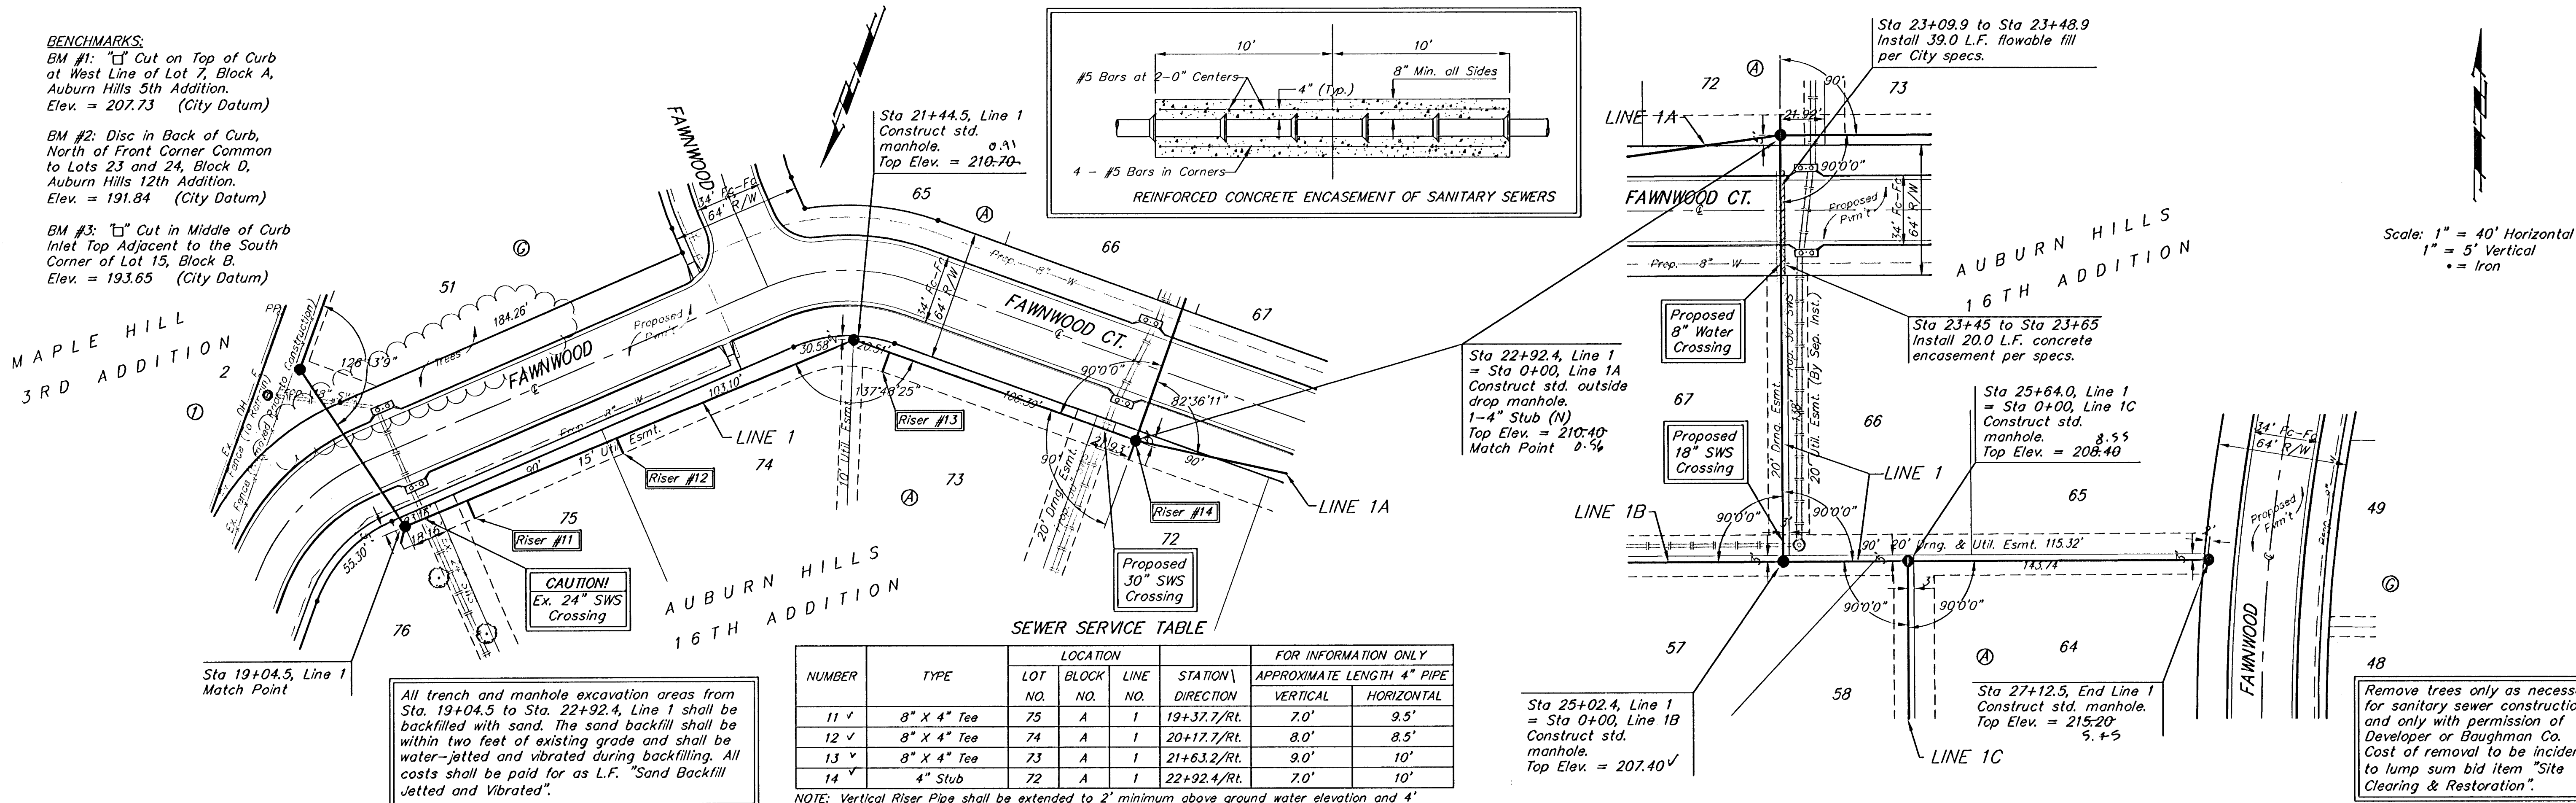

**Baughman**

ENGINEERING | SURVEYING | PLANNING | LANDSCAPE ARCHITECTURE

**AUBURN HILLS 16TH ADD. - PH. II**

**LINE 1**

**SANITARY SEWER IMPROVEMENTS**

PROJECT NUMBER: 468-84030

DESIGN: AEG

DRAWN: TMS

APPROVED: DATE: 04/06

SCALE: NOTED

SHEET: **5 OF 27**

AuburnHills16thPhaseII.SS4

06-02-E500