


BENCHMARKS:
BM #1: "I" Cut on Top of Curb
at West Line of Lot 7, Block A,
Auburn Hills 5th Addition.
Elev. = 207.73 (City Datum)


BM #2: Disc in Back of Curb,
North of Front Corner Common
to Lots 23 and 24, Block D,
Auburn Hills 12th Addition.
Elev. = 191.84 (City Datum)

BM #3: "I" Cut in Middle of Curb
Inlet Top Adjacent to the South
Corner of Lot 15, Block B.
Elev. = 193.65 (City Datum)

Scale: 1" = 40' Horizontal
1" = 5' Vertical
• = Iron

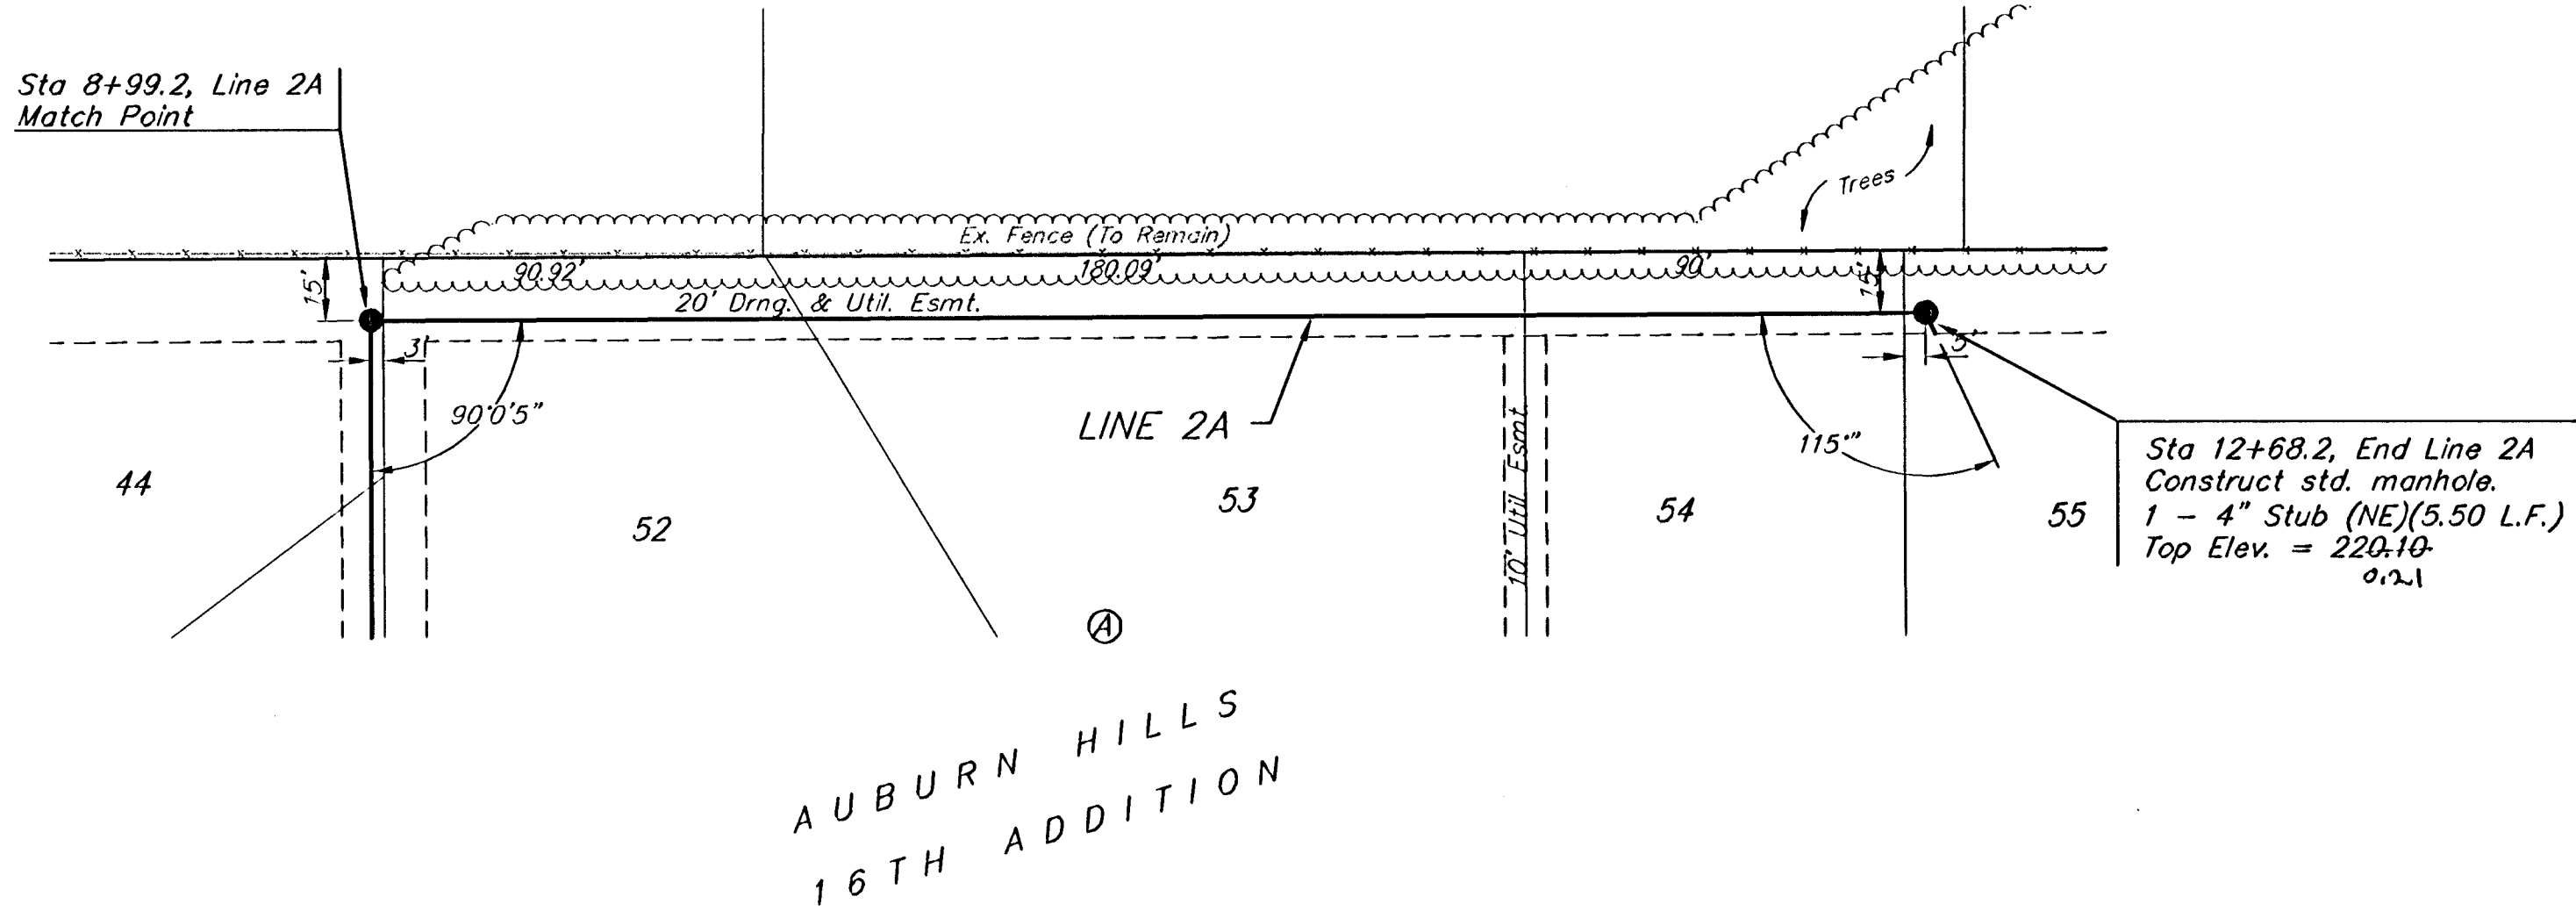

Remove trees only as necessary
for sanitary sewer construction
and only with permission of
Developer or Baughman Co.
Cost of removal to be incidental
to lump sum bid item "Site
Clearing & Restoration".

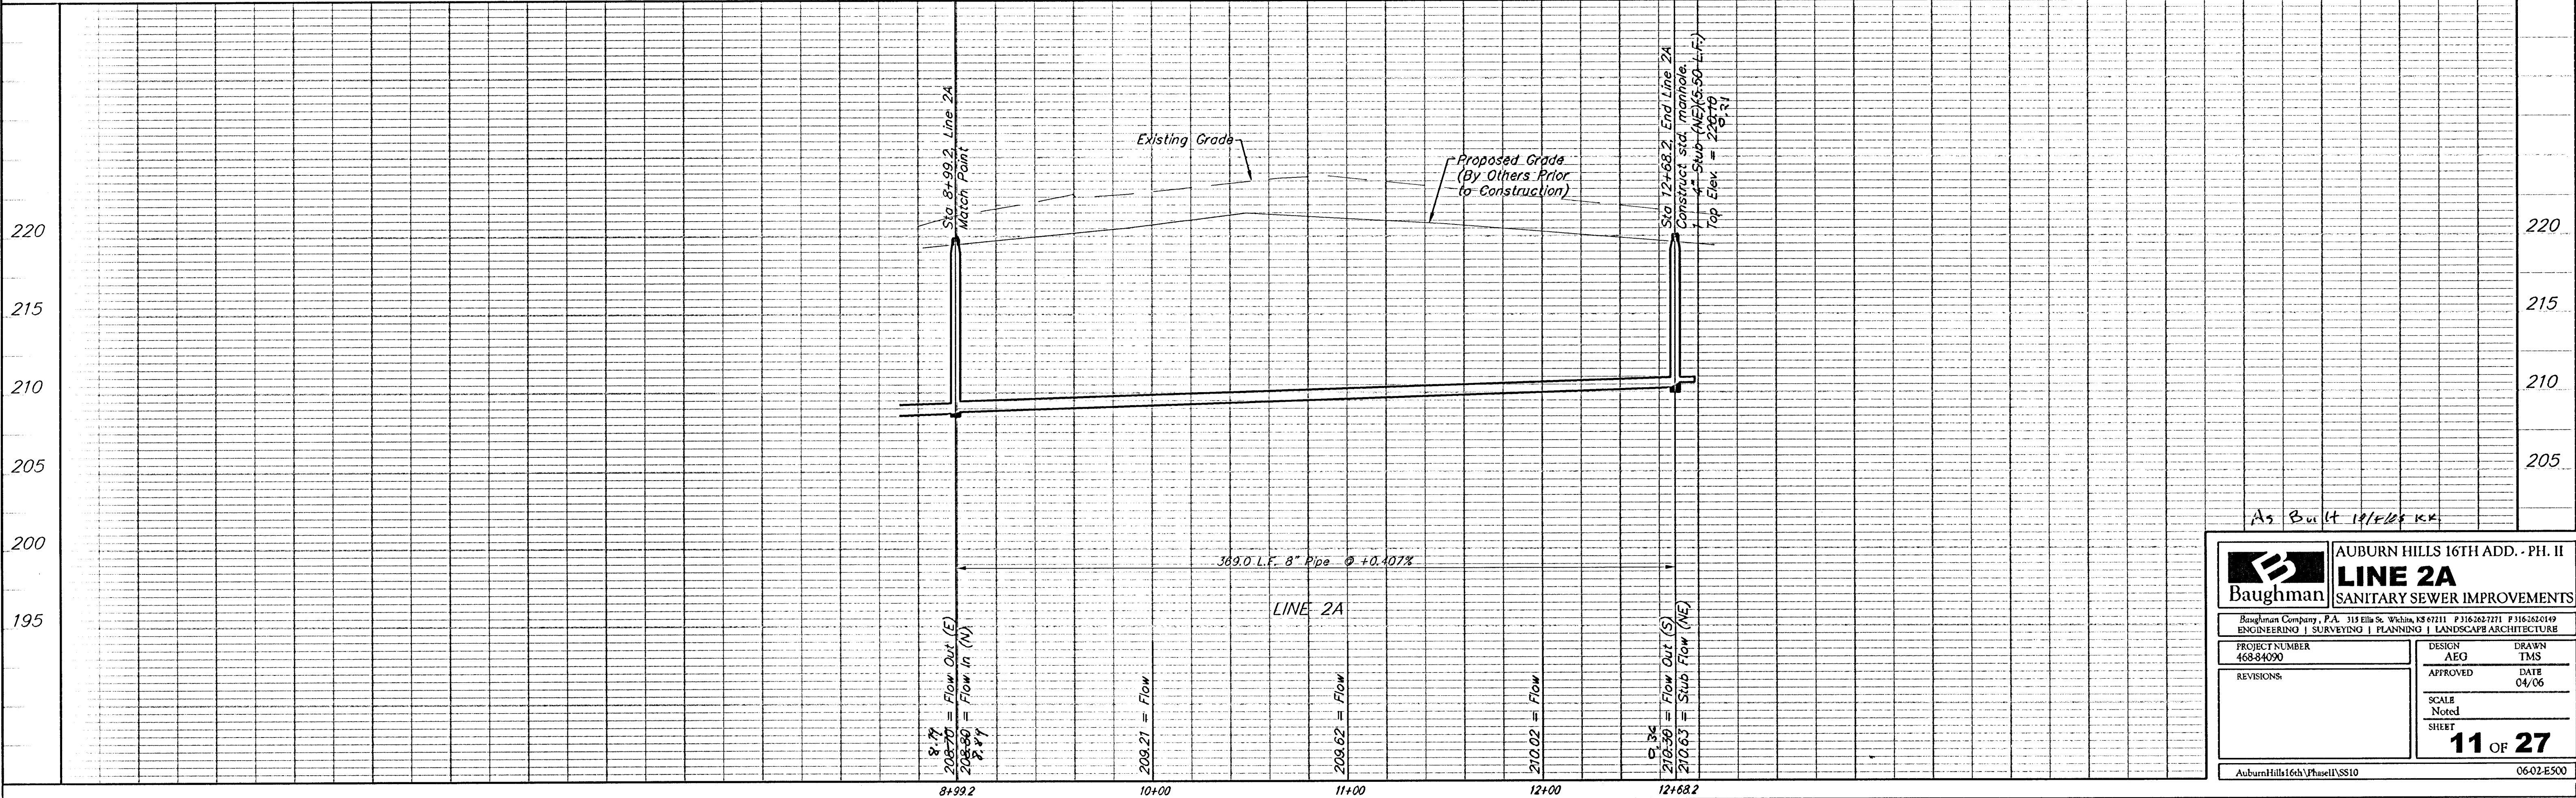

As Built 10/1/05 K.R.

Baughman		AUBURN HILLS 16TH ADD. - PH. II	
Baughman Company, P.A. 313 Ellis St. W. W. Minn. 55401 P 316-262-7271 F 316-262-0149		LINE 2A	
ENGINEERING SURVEYING PLANNING LANDSCAPE ARCHITECTURE		SANITARY SEWER IMPROVEMENTS	
PROJECT NUMBER 468-84030	DESIGN AEG	DRAWN TMS	
REVISIONS	APPROVED	DATE 04/06	
	SCALE Noted	SHEET 11 OF 27	
AuburnHills16th\PhaseII\SS10		06-02-E500	