


BENCHMARKS:

BM #1: "I" Cut on Top of Curb
at West Line of Lot 7, Block A,
Auburn Hills 5th Addition.
Elev. = 207.73 (City Datum)

BM #2: Disc in Back of Curb,
North of Front Corner Common
to Lots 23 and 24, Block D,
Auburn Hills 12th Addition.
Elev. = 191.84 (City Datum)

BM #3: "I" Cut in Middle of Curb
Inlet Top Adjacent to the South
Corner of Lot 15, Block B.
Elev. = 193.65 (City Datum)

Scale: 1" = 40' Horizontal
1" = 5' Vertical
• = Iron

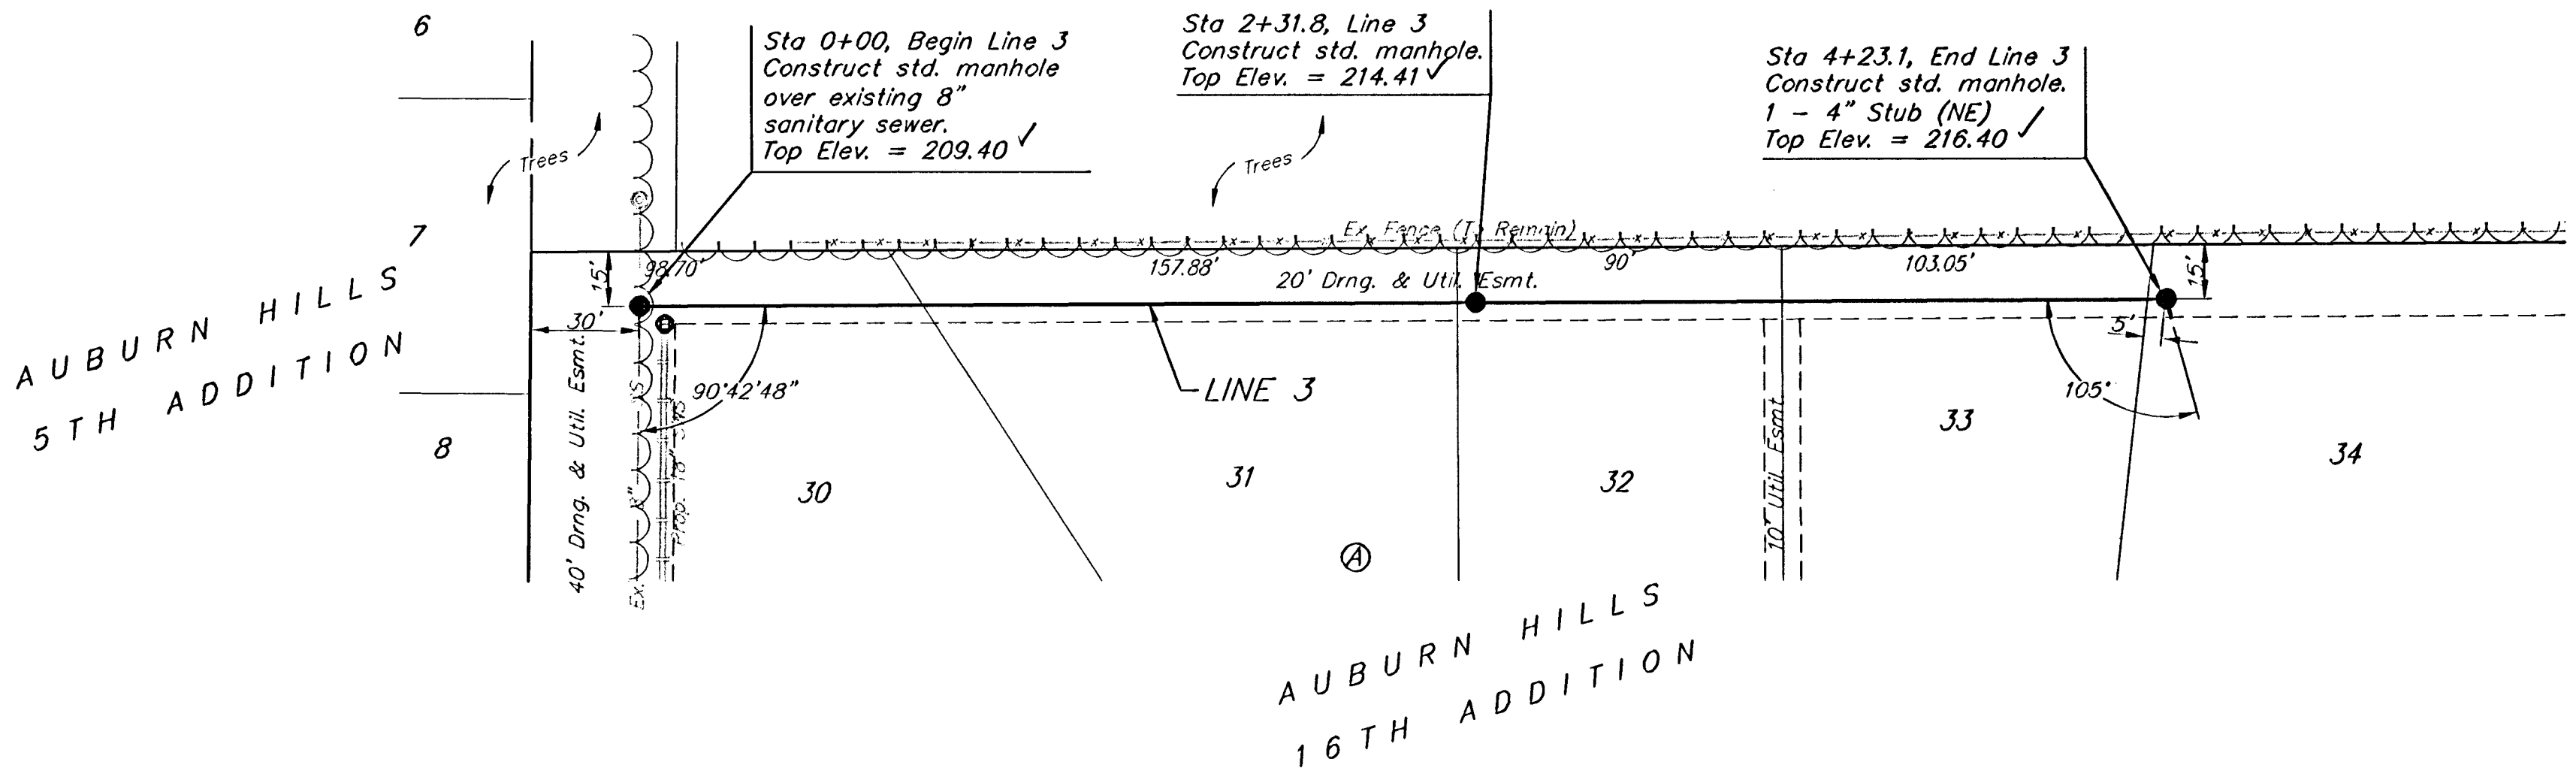

Contractor to Verify Depth &
Location of Existing 8" Sewer
Line Prior to Construction.

Remove trees only as necessary
for sanitary sewer construction
and only with permission of
Developer or Baughman Co.
Cost of removal to be incidental
to lump sum bid item "Site
Clearing & Restoration".

