

BENCHMARKS:

BM #1: "C" Cut on Top of Curb
at West Line of Lot 7, Block A,
Auburn Hills 5th Addition.
Elev. = 207.73 (City Datum)


BM #2: Disc in Back of Curb,
North of Front Corner Common
to Lots 23 and 24, Block D,
Auburn Hills 12th Addition.
Elev. = 191.84 (City Datum)

BM #3: "C" Cut in Middle of Curb
Inlet Top Adjacent to the South
Corner of Lot 15, Block B.
Elev. = 193.65 (City Datum)




Scale: 1" = 40' Horizontal
1" = 5' Vertical
• = Iron

AUBURN HILLS
5TH ADDITION

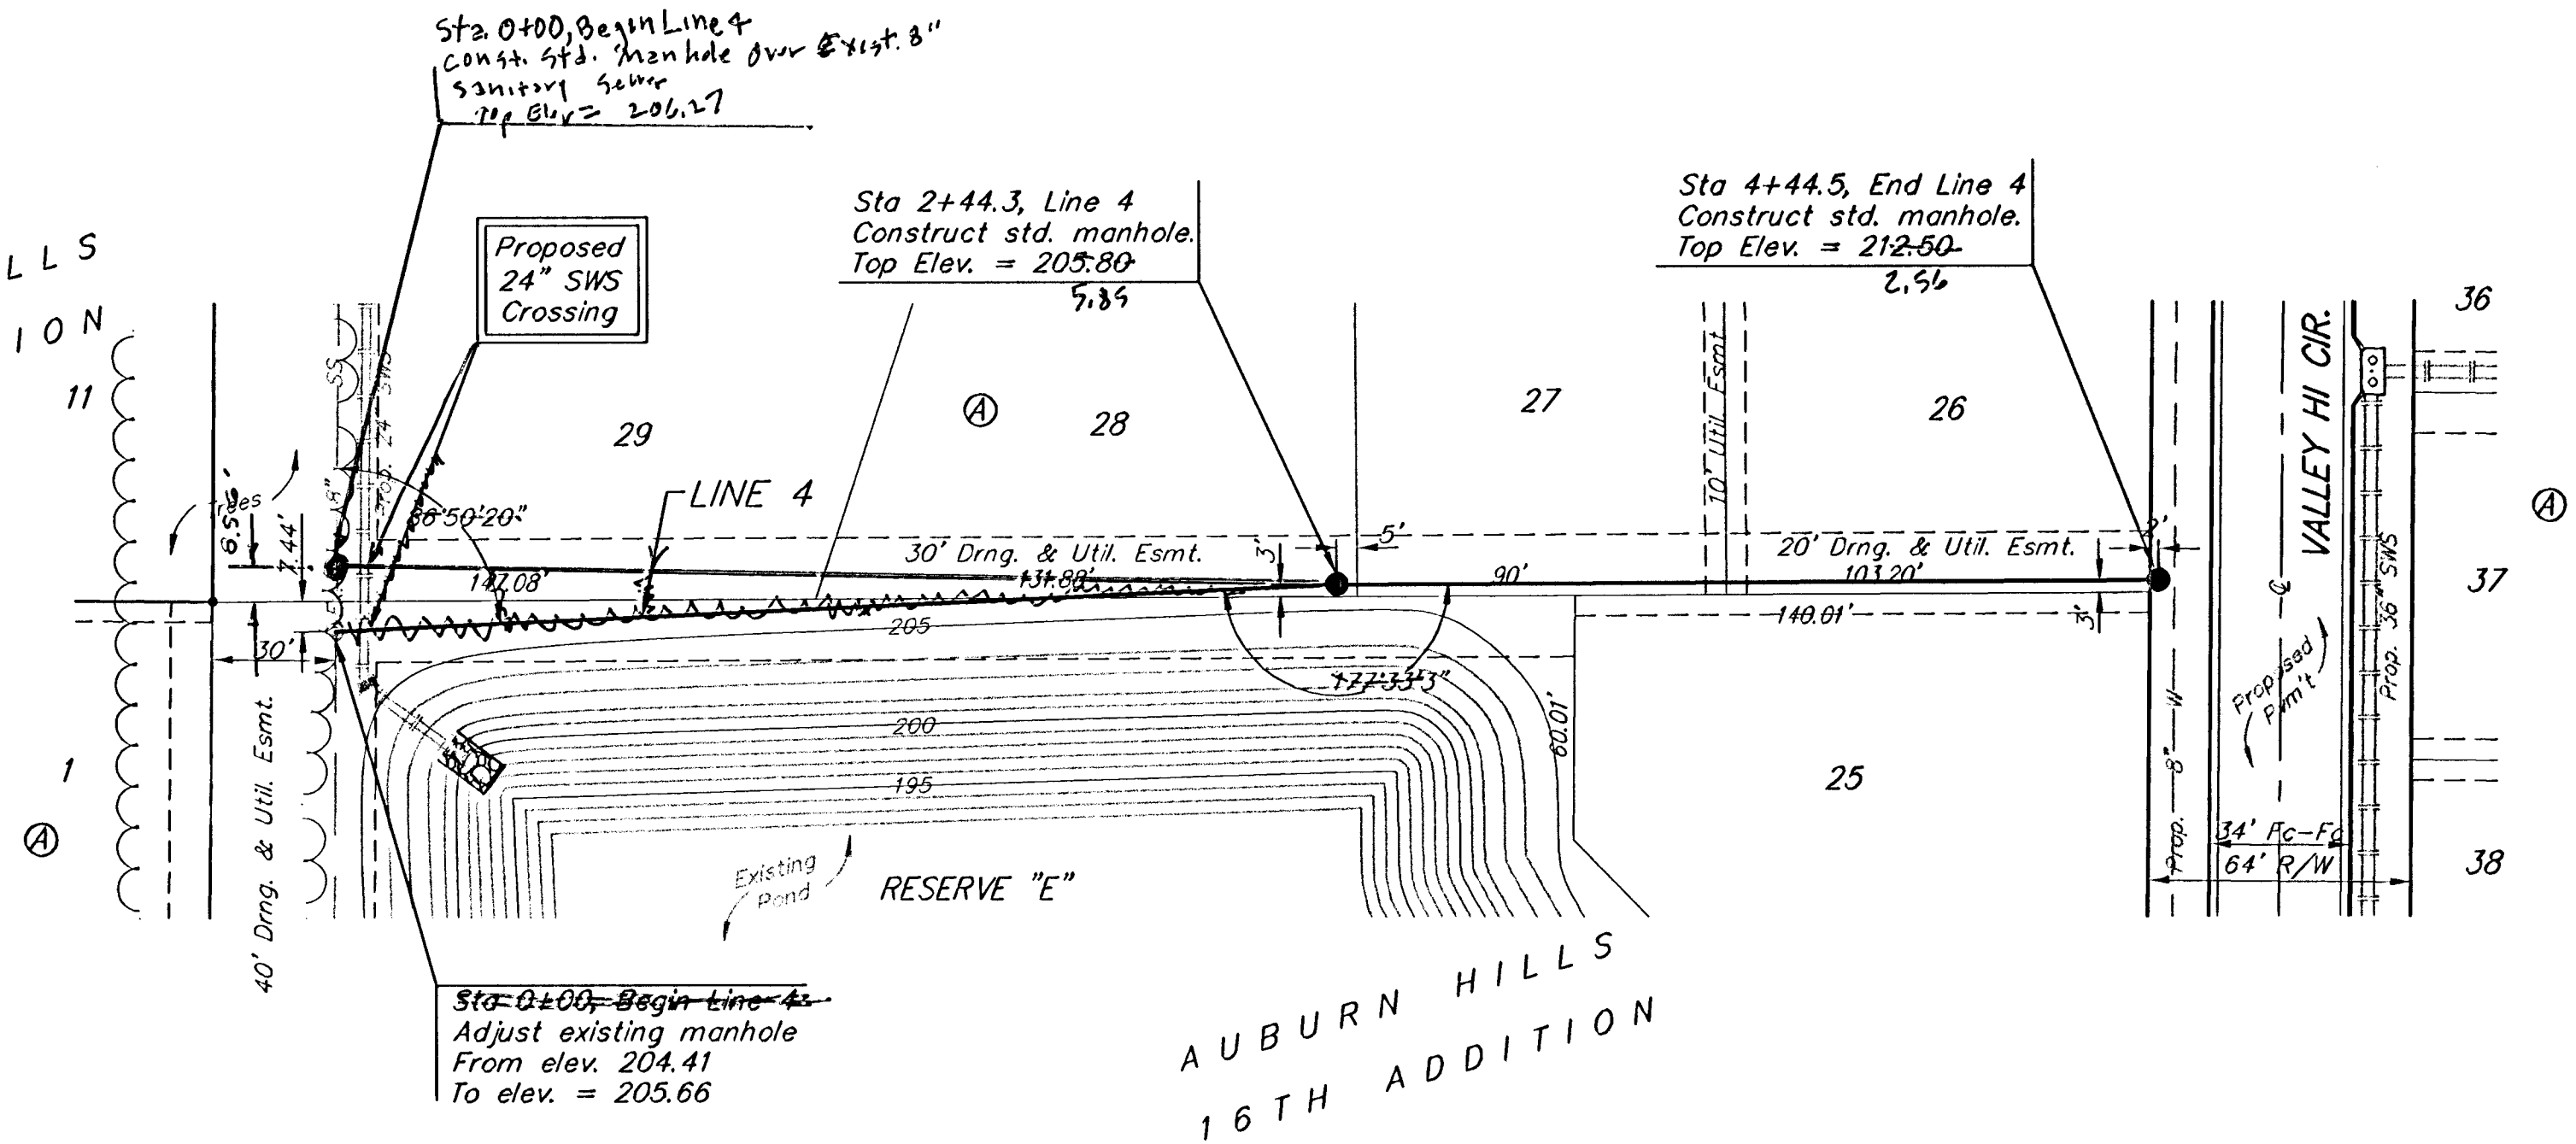

Contractor to Verify Depth &
Location of Existing 8" Sewer
Line Prior to Construction.

Remove trees only as necessary
for sanitary sewer construction
and only with permission of
Developer or Baughman Co.
Cost of removal to be incidental
to lump sum bid item "Site
Clearing & Restoration".

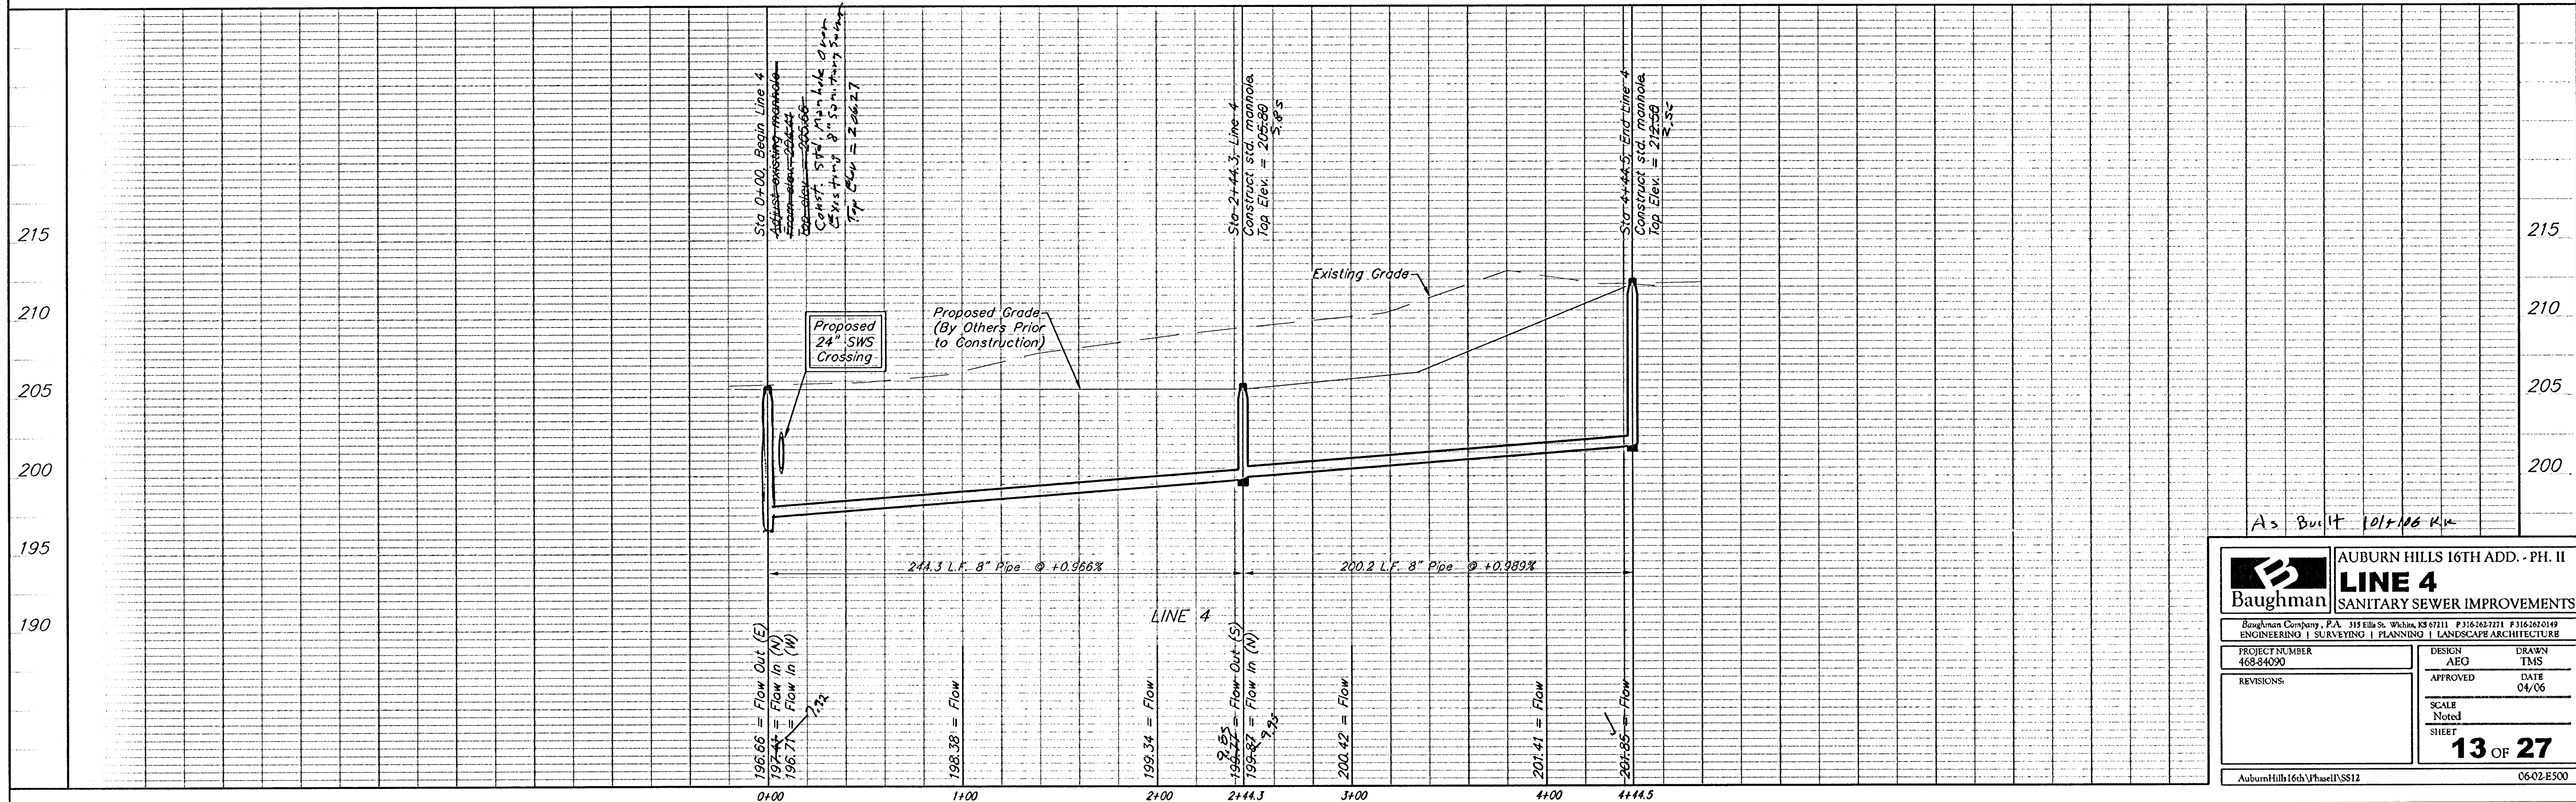

As Built 10/1/06 KLM

Baughman		AUBURN HILLS 16TH ADD. - PH. II	
LINE 4		SANITARY SEWER IMPROVEMENTS	
Baughman Company, P.A. 315 Ellis St., Woburn, MA 01801 P. 316.262.0119 F. 316.262.0119			
ENGINEERING SURVEYING PLANNING LANDSCAPE ARCHITECTURE			
PROJECT NUMBER 468-84090		DESIGN AEG	
REVISIONS		APPROVED DATE 04/06	
		SCALE Noted SHEET	
		13 OF 27	
Auburn Hills 16th Valley Hi SS12		06-02-E500	