

SANITARY SEWER PLANS
FOX RIDGE
PHASE 9


LINE 1
SHEET TITLE
468-84202
PROJECT NUMBER

DESIGN BY **DFL**
DRAWN BY **MKEC**
CHECKED BY **GJA**


ISSUED
JULY 2006
REVISED

SHEET NO.

4 of 14

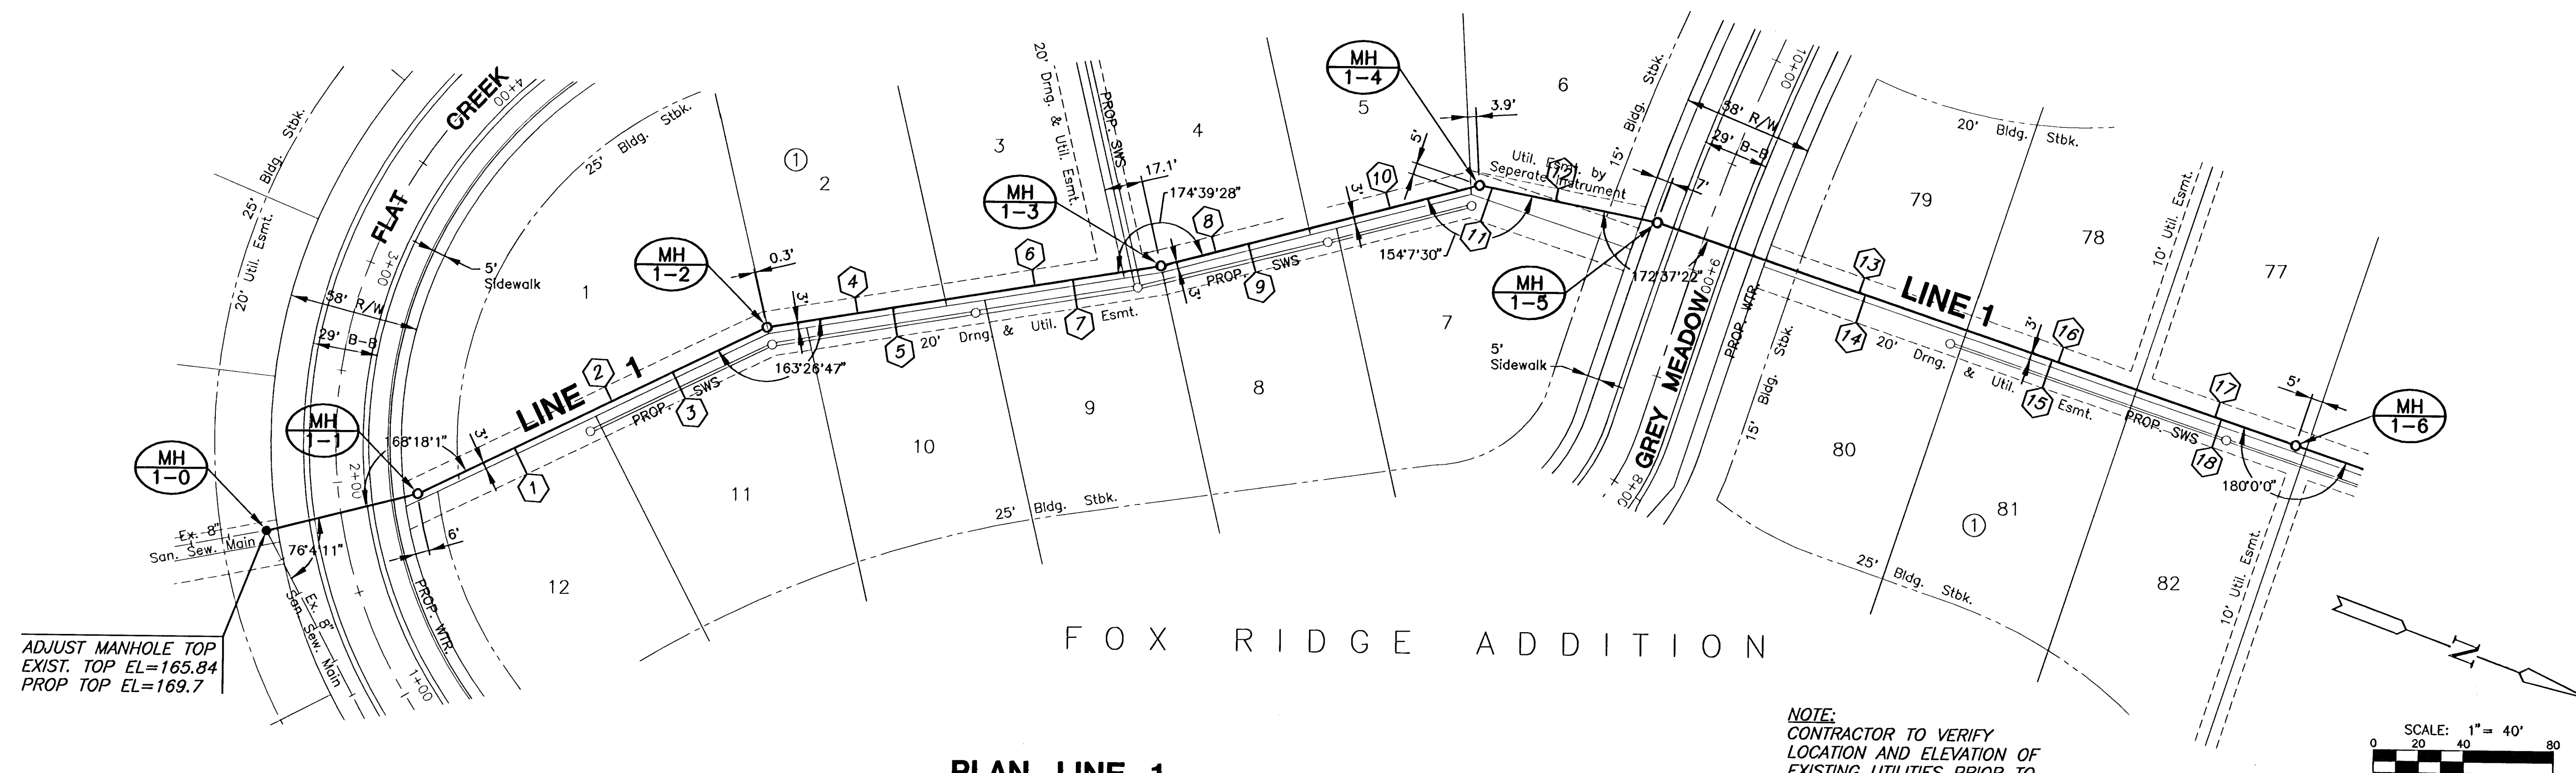

PLAN LINE 1

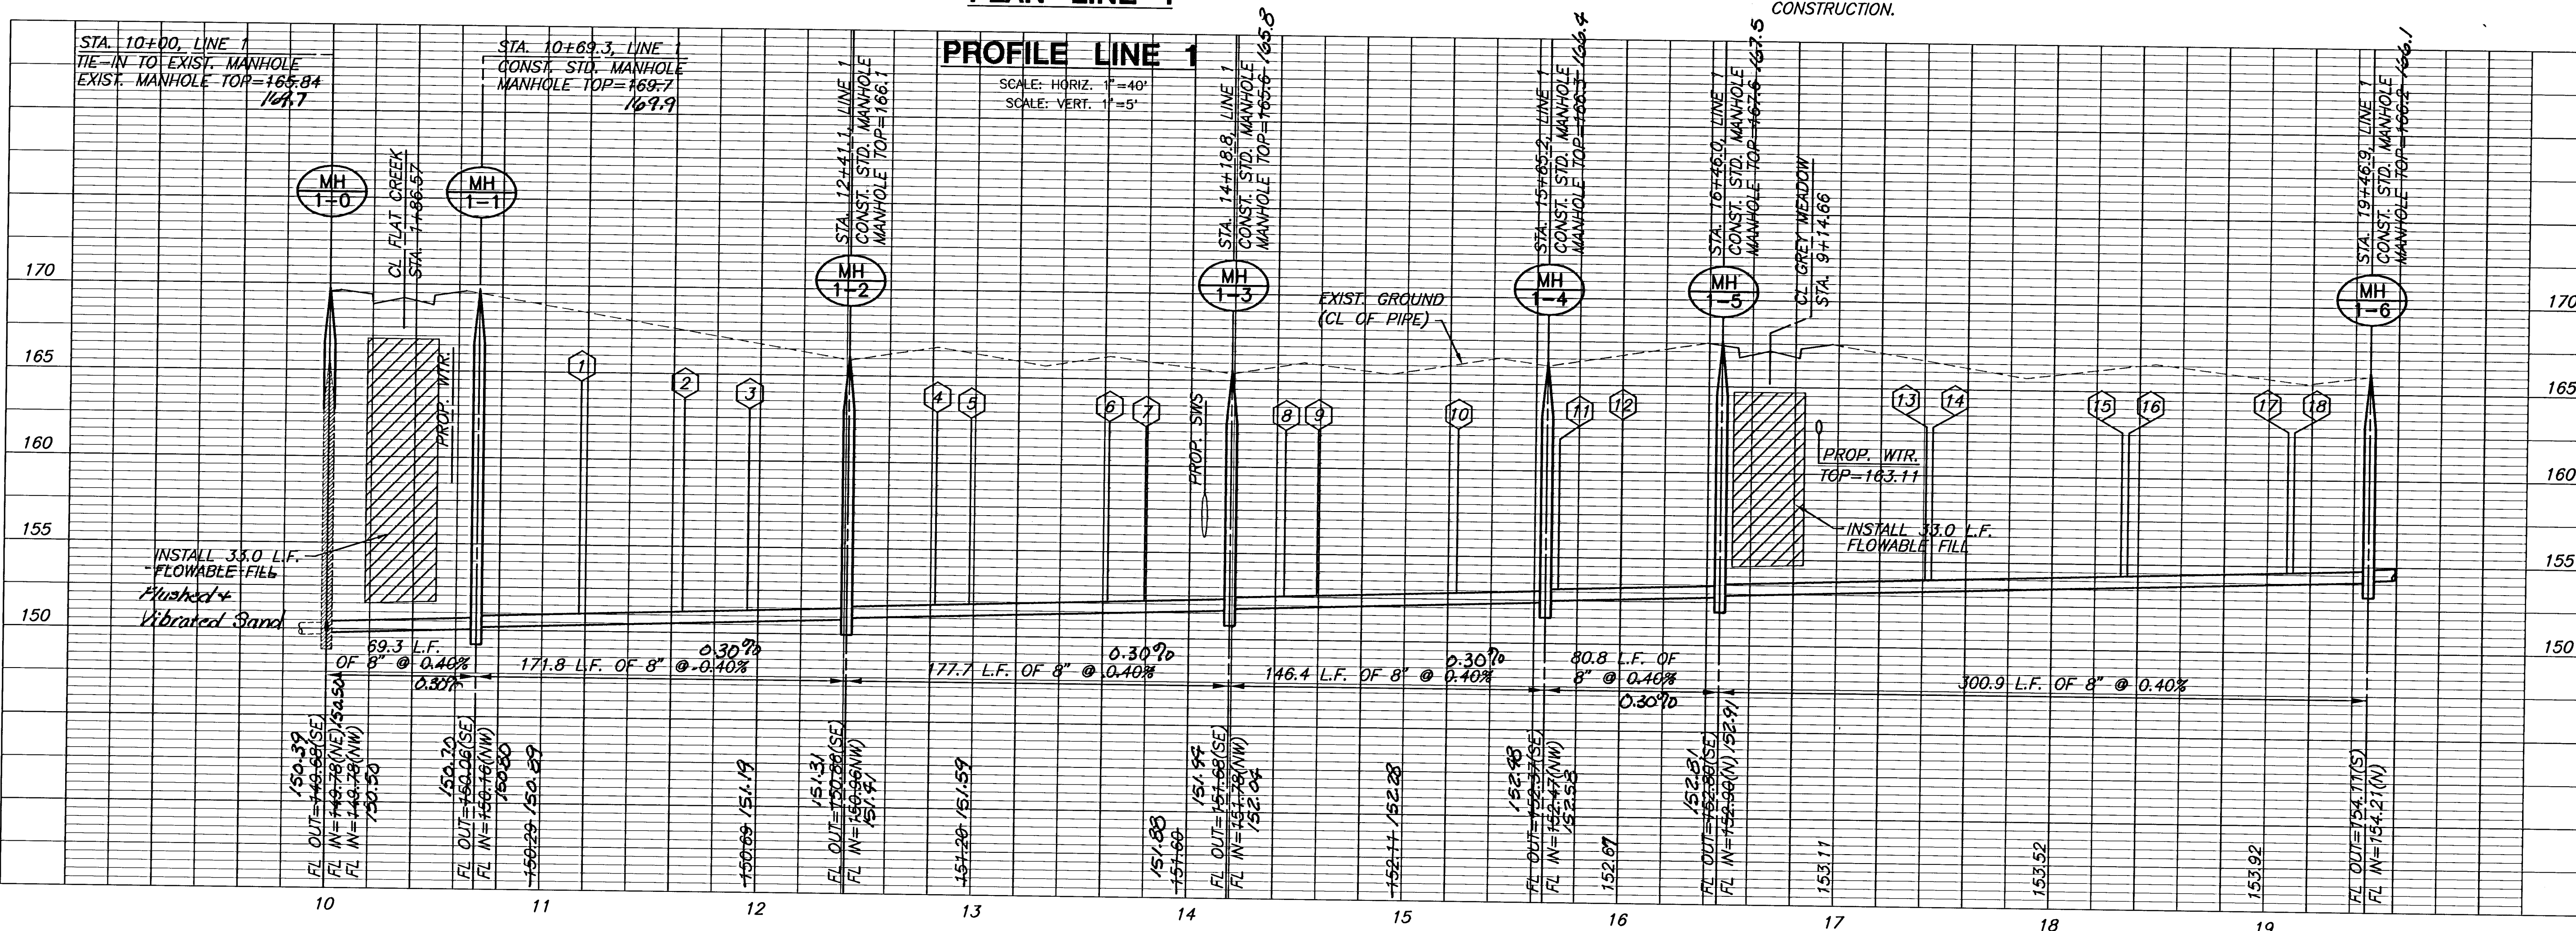

PROFILE LINE 1