






FOX RIDGE ADDITION

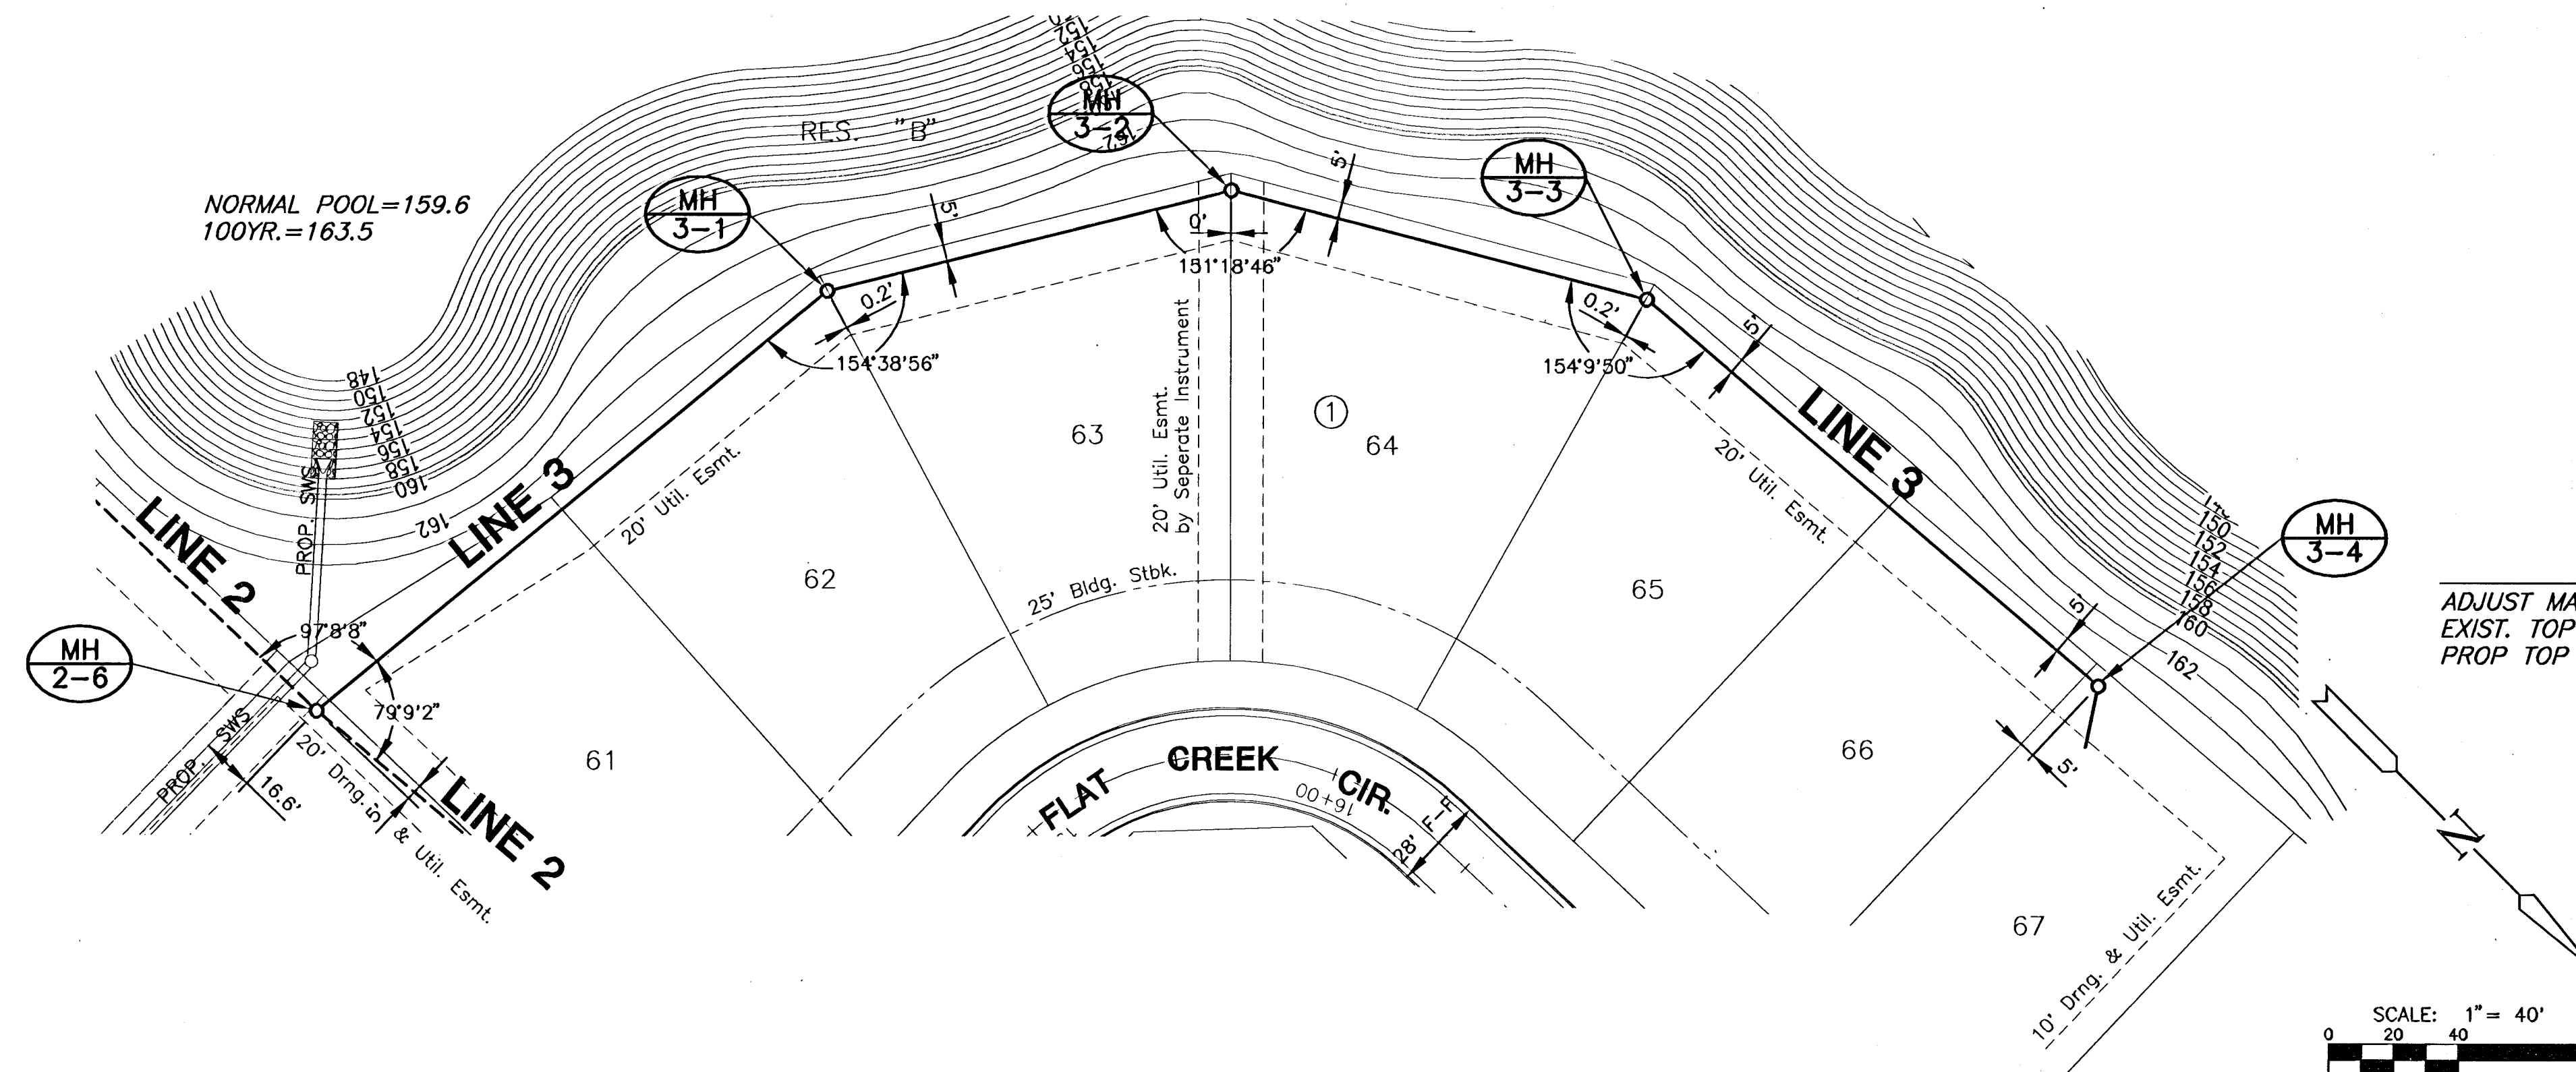

FOX RIDGE ADDITION

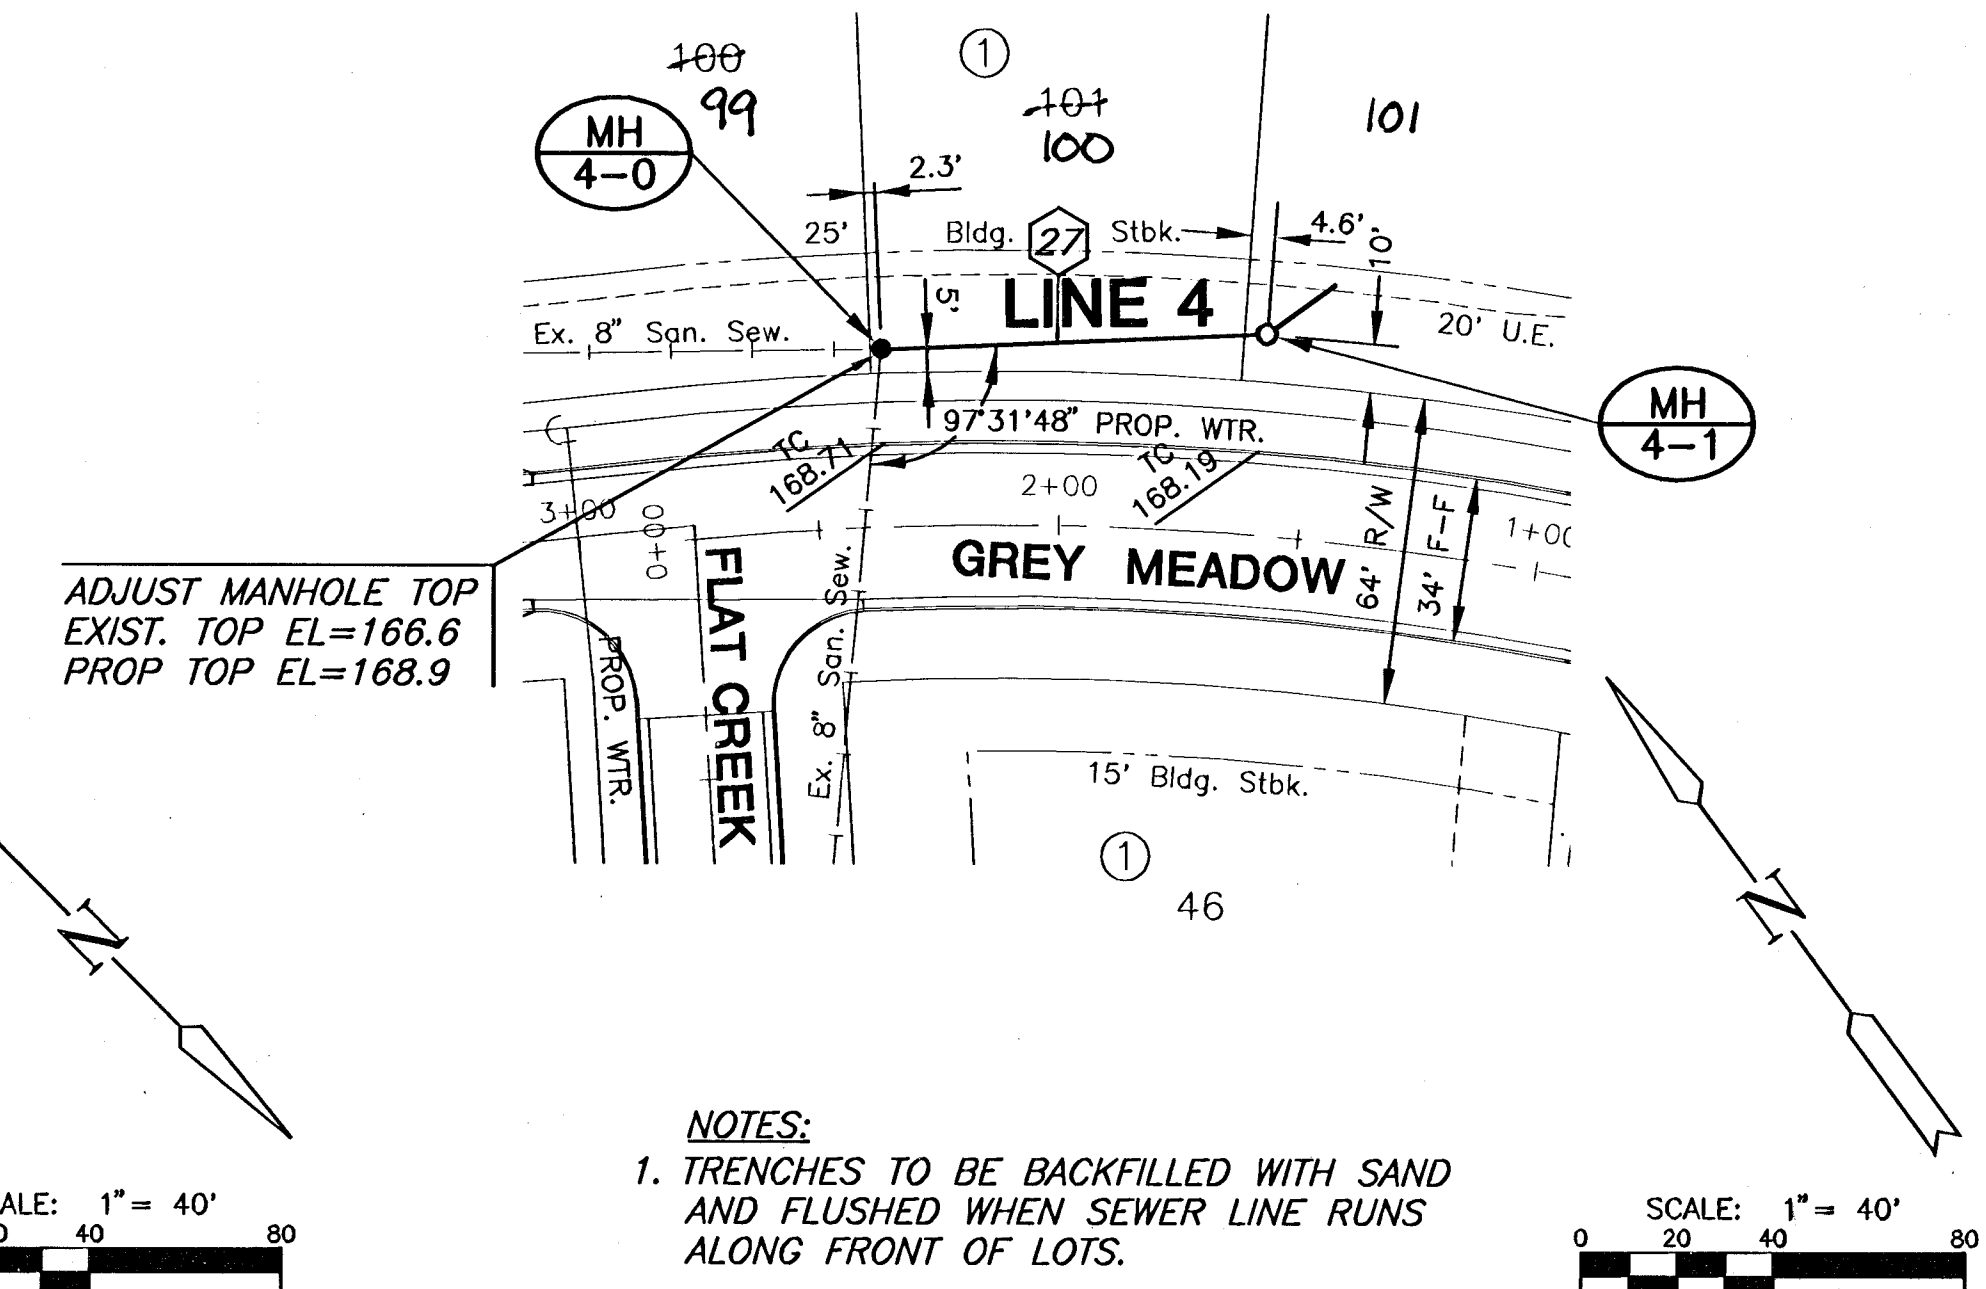

NOTES:
1. TRENCHES TO BE BACKFILLED WITH SAND AND FLUSHED WHEN SEWER LINE RUNS ALONG FRONT OF LOTS.

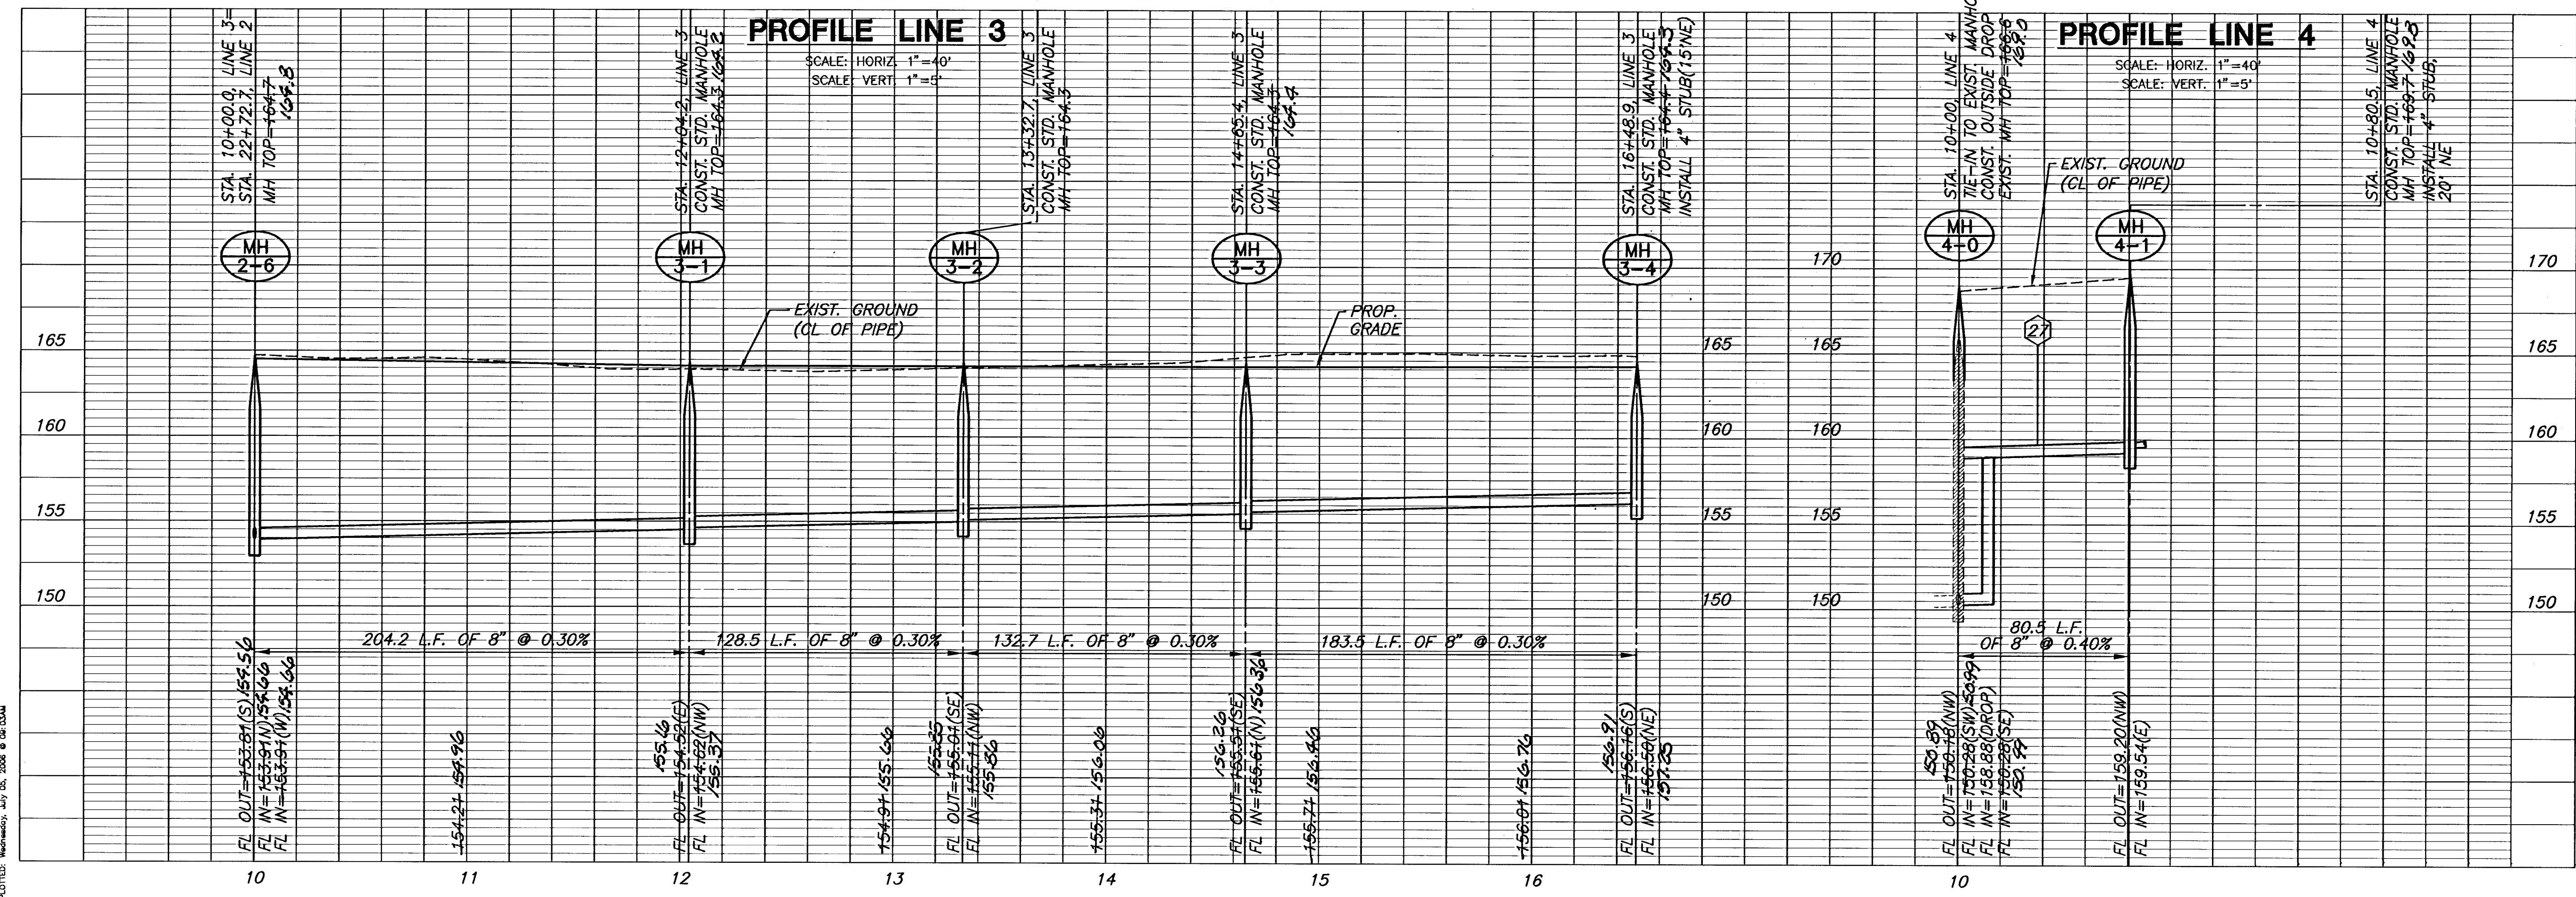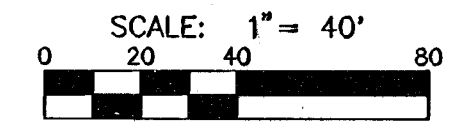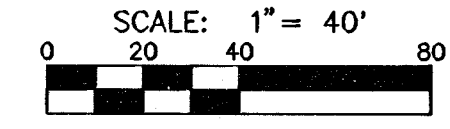

MKEC
ENGINEERING
CONSULTANTS, INC.
411 N. WEBB ROAD
WICHITA, KS. 67206
316-684-9600

SANITARY SEWER PLANS
FOX RIDGE
PHASE 9

LINE 3 & 4
SHEET TITLE
468-84202
PROJECT NUMBER

DESIGN BY: DFL
DRAWN BY: MKEC
CHECKED BY: GJA

ISSUED: JULY 2006
REVISED:

SHEET NO.
7 of 14

PLOTTED: Wednesday, July 05, 2006 @ 09:03AM