


SANITARY SEWER PLANS
FOX RIDGE
PHASE 9

LINE 5
SHEET TITLE
468-84202
PROJECT NUMBER

DESIGN BY
DFL
DRAWN BY
MKEC
CHECKED BY
GJA


ISSUED
JULY 2006
REVISED

SHEET NO.
8 of 14

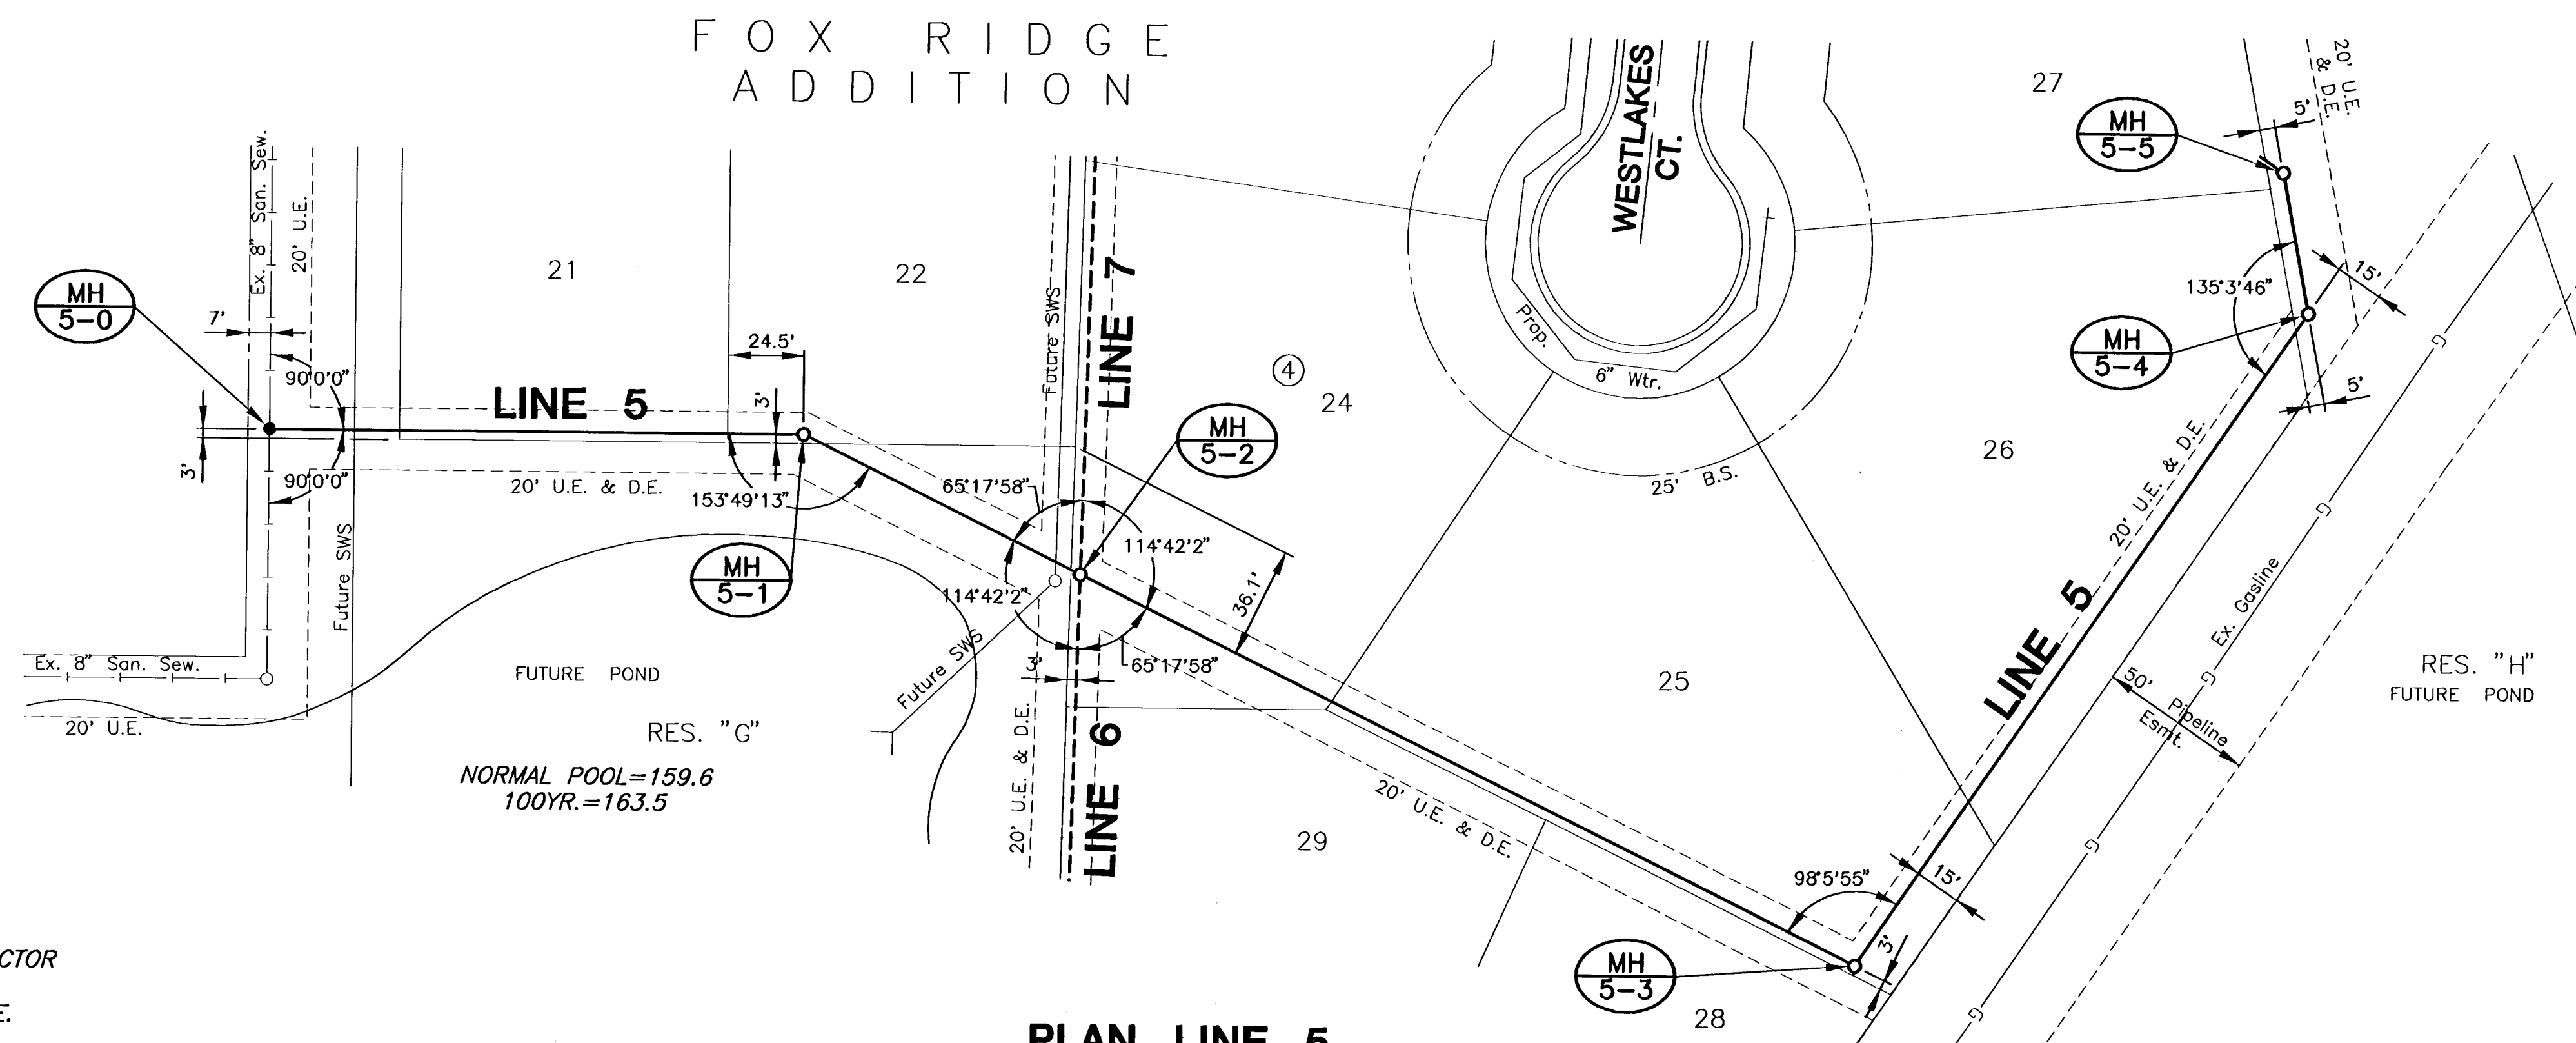

NOTE:
LINES 5 THRU 10 CONTRACTOR
TO PROVIDE 18" COLLAR
ADJUSTMENT FOR MANHOLE.

PLAN LINE 5

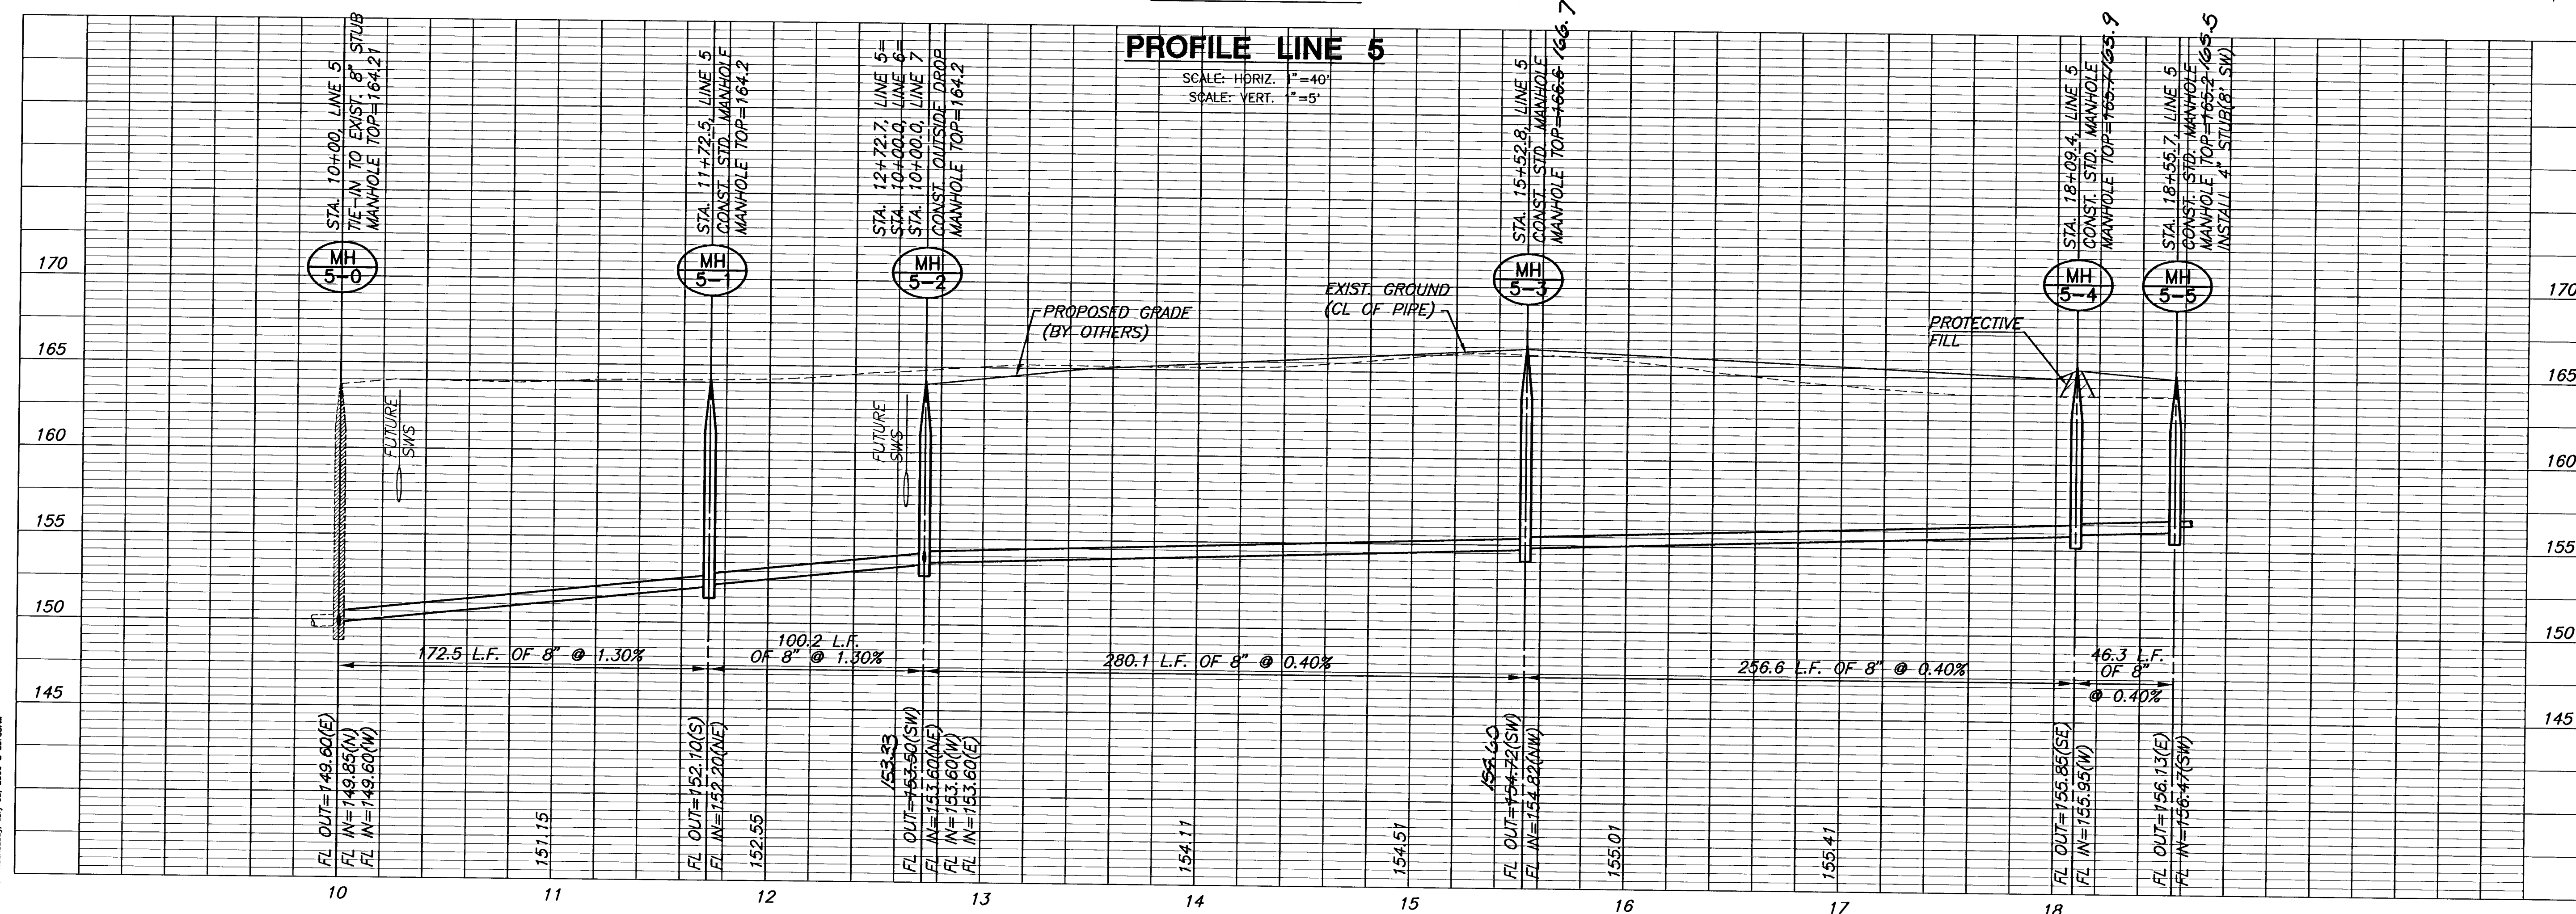

PROFILE LINE 5

SCALE: HORIZ. 1" = 40'
SCALE: VERT. 1" = 5'