


SANITARY SEWER PLANS
FOX RIDGE
PHASE 9

LINE 6
SHEET TITLE
PROJECT NUMBER
468-84202

DESIGN BY
MKEC
DRAWN BY
GJA
CHECKED BY

ISSUED
JULY 2006
REVISED


SHEET NO.
9 of 14

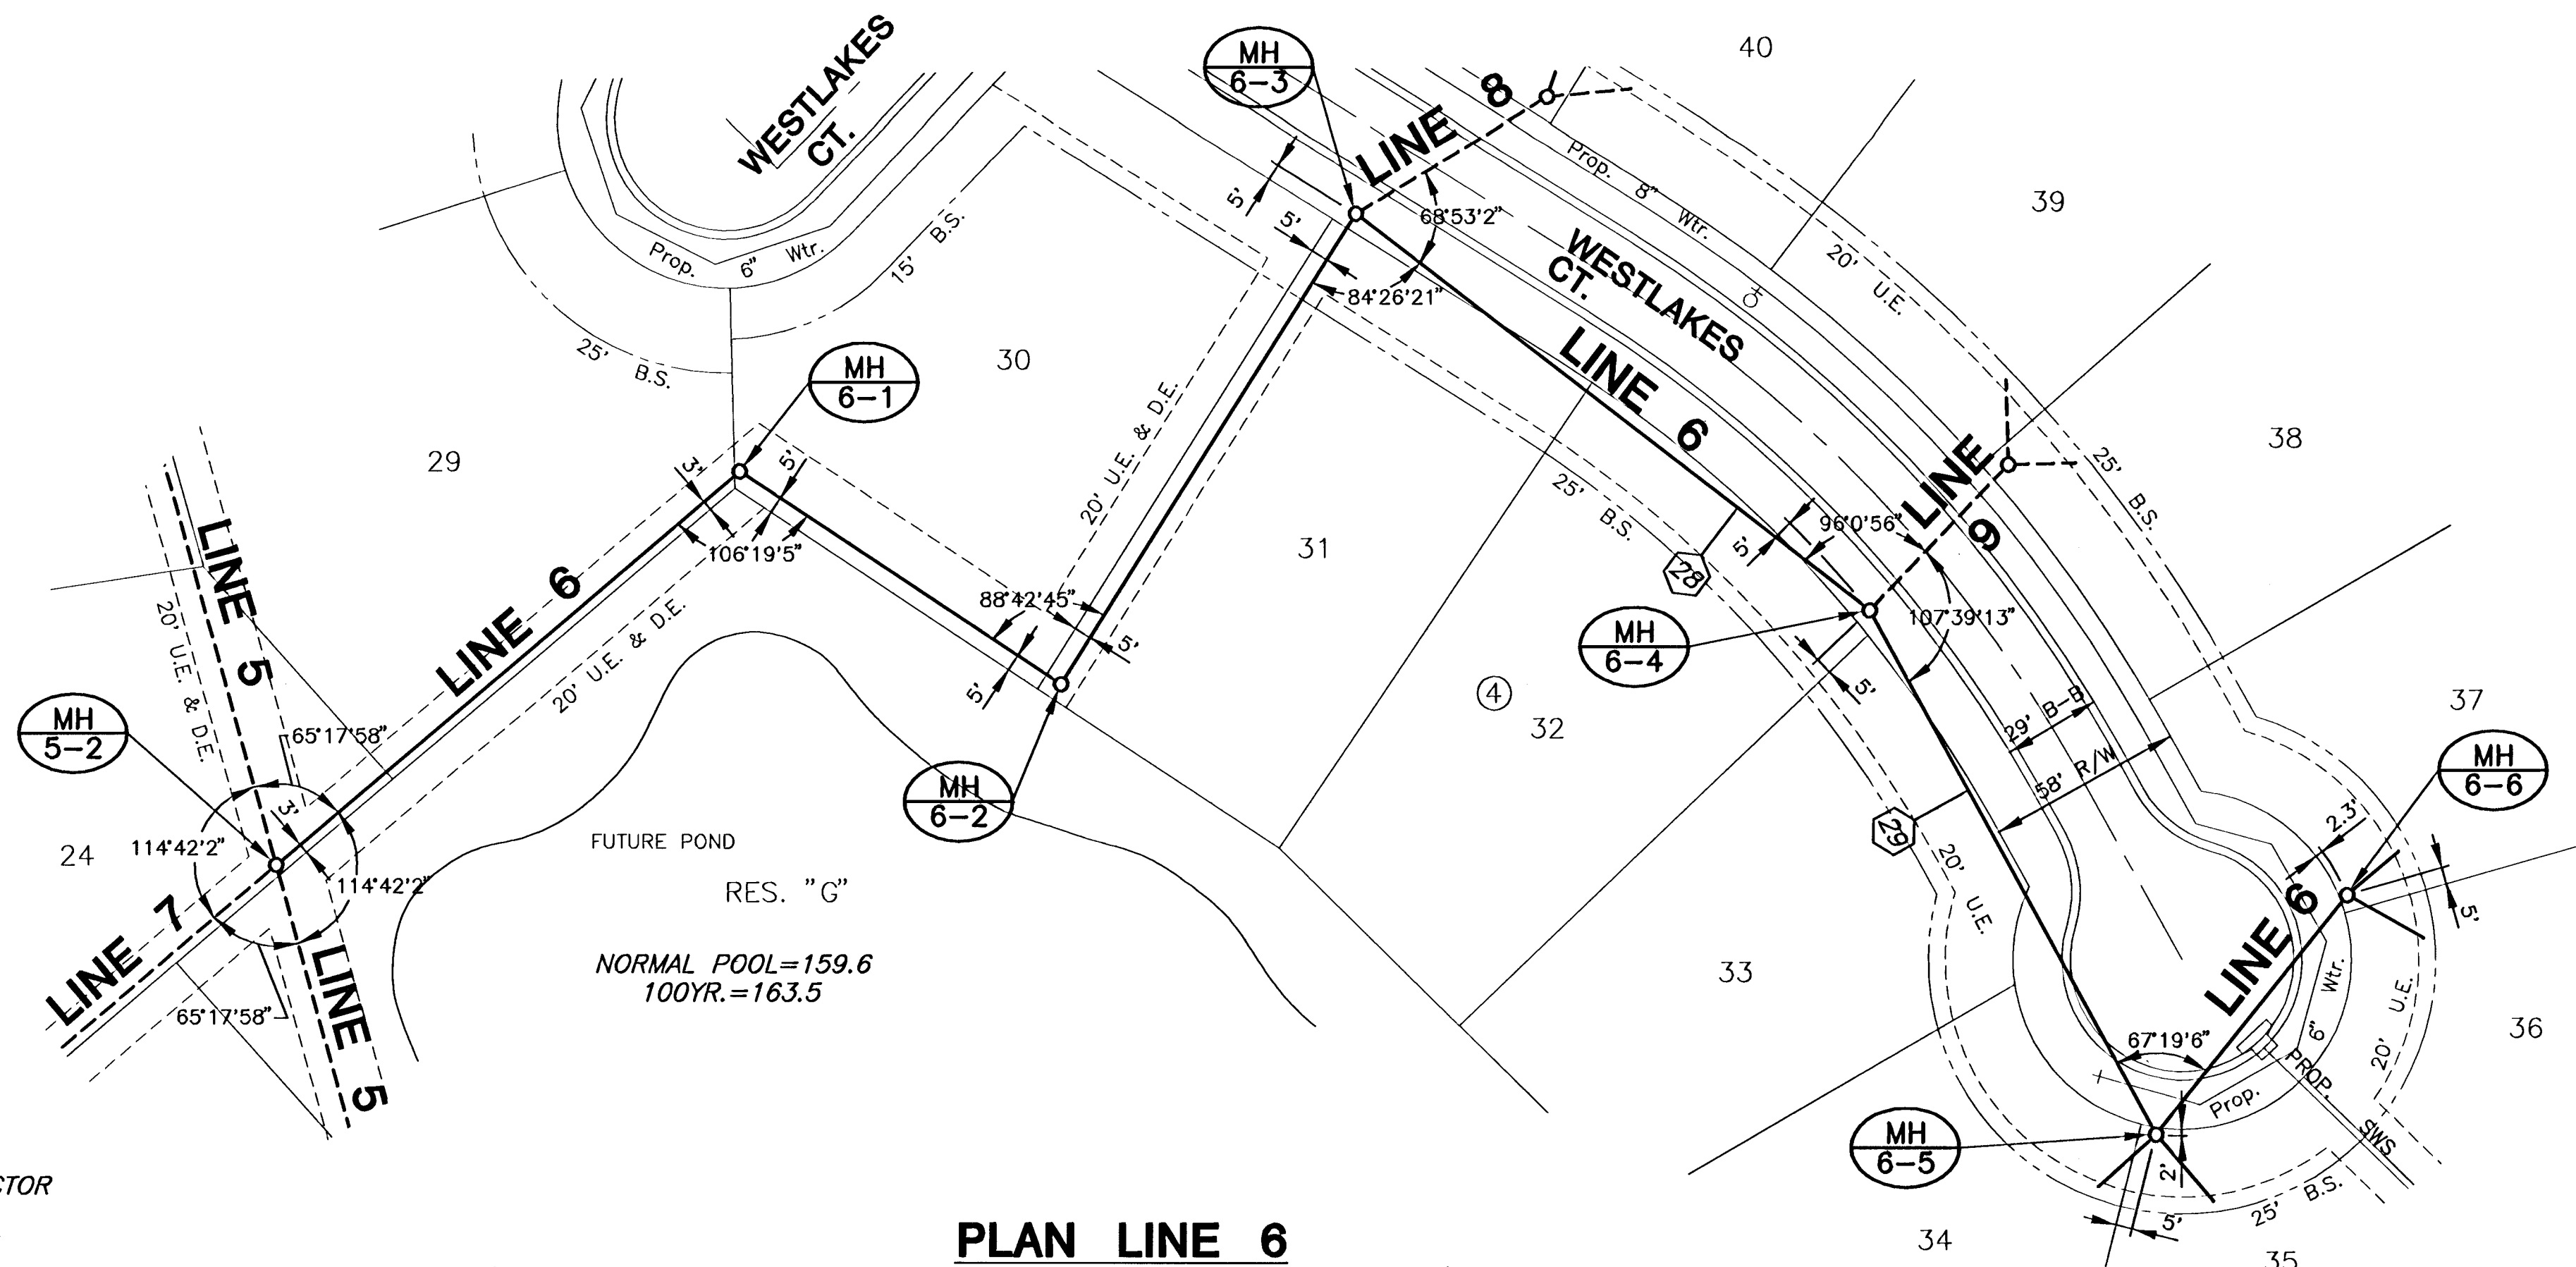

NOTES:
1. TRENCHES TO BE BACKFILLED WITH SAND AND FLUSHED WHEN SEWER LINE RUNS ALONG FRONT OF LOTS.

NOTE:
LINES 5 THRU 10 CONTRACTOR TO PROVIDE 18" COLLAR ADJUSTMENT FOR MANHOLE

PLAN LINE 6

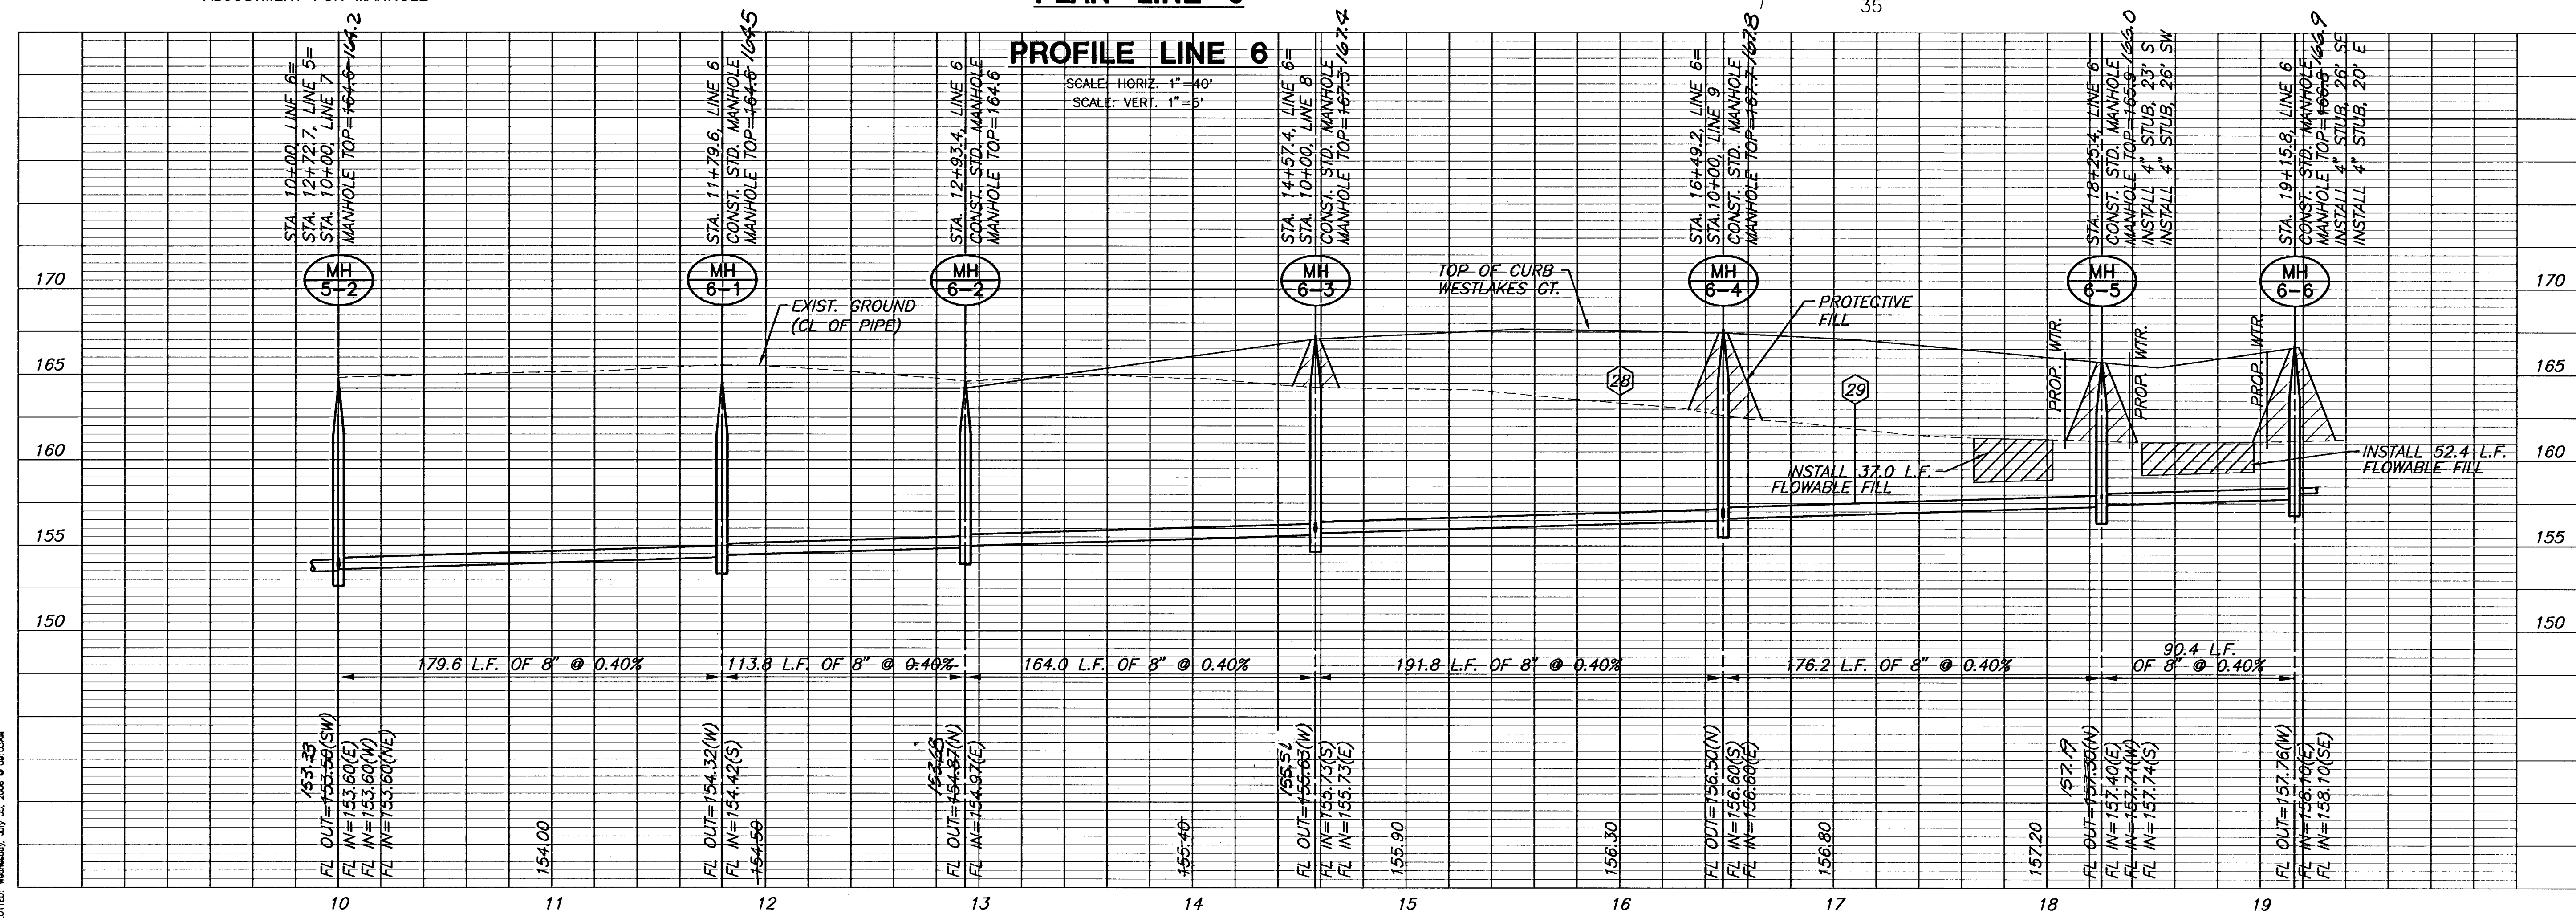

PROFILE LINE 6

SCALE: HORIZ. 1" = 40'
SCALE: VERT. 1" = 5'

PLOTTED: Wednesday, July 05, 2006 @ 04:03AM