


LATERAL 5, MAIN 7
OF THE
NORTHWEST INTERCEPTOR SEWER
IN
THE CITY OF WICHITA

83877

OCA NO. 744156
CITY OF WICHITA PROJECT NO. 468-83877
JAMES L. ARMOUR, P.E. - CITY ENGINEER

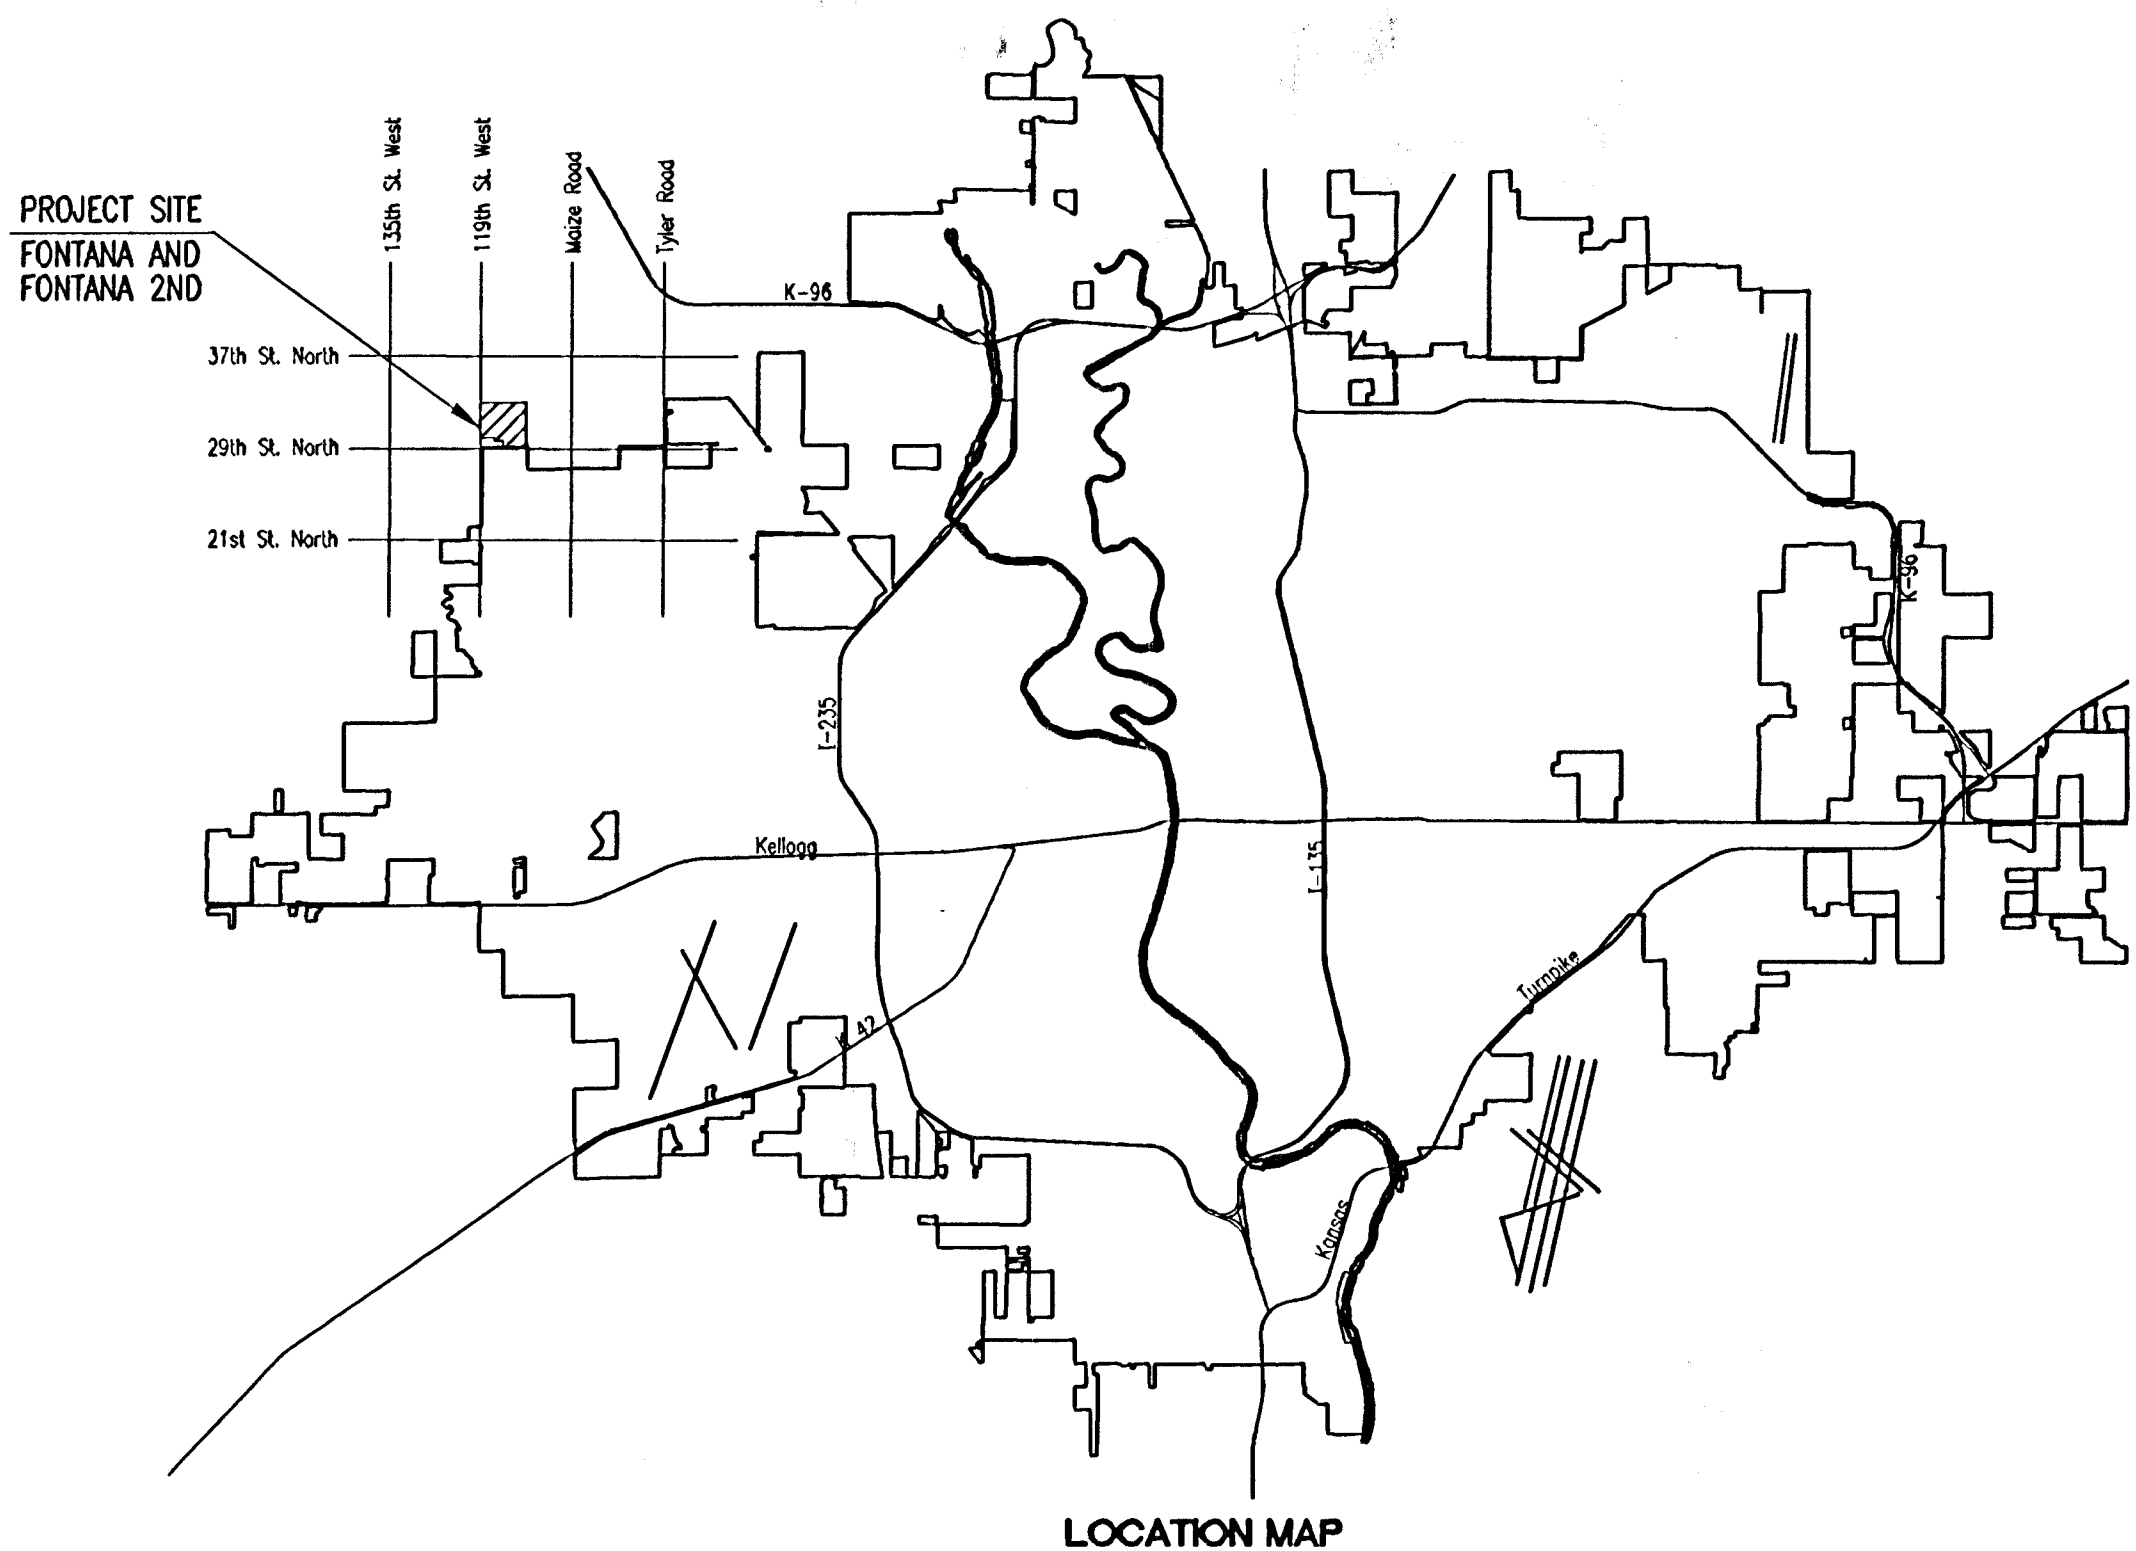

McCullough Excavation, Inc. - Contractor
Koleczek, City Inspector
Released 8/11/06
As-Built
Risers & Stubs
.pdf by JDL 12/18/06

INDEX OF SHEETS

SHEET NO. 1	TITLE SHEET
SHEET NO. 2	KEY MAP AND GENERAL NOTES
SHEET NO. 3-5	PLAT
SHEET NO. 6-25	PLAN/PROFILE
SHEET NO. 26	TYPE "P" MANHOLE DETAILS
SHEET NO. 27	CLEANOUT RISER ASSEMBLY DETAIL
SHEET NO. 28	FRAME & COVER DETAILS
SHEET NO. 29	RISER DETAILS
SHEET NO. 30-33	SOIL EROSION BMP DETAILS

CONSTRUCTION SCHEDULE/SEQUENCE

THE CONTRACTOR FOR EACH OF THE FOLLOWING FONTANA PROJECTS SHALL COORDINATE THEIR EFFORTS WITH OTHER CONTRACTORS PERFORMING WORK IN THIS AREA SUCH THAT ANY NECESSARY SIMULTANEOUS CONSTRUCTION CAN PROCEED CONCURRENTLY WITHOUT CAUSING UNDE DELAYS SO THAT CONSTRUCTION CAN BE COMPLETED WITHIN THE TIME FRAMES AS NOTED.

SANITARY SEWER (468-83877)
THE CONTRACTOR SHALL SEQUENCE HIS WORK TO COMPLETE, INCLUDING TESTING AND ACCEPTANCE, THE FOLLOWING WORK: LINE 1 FROM BEGINNING TO MH 6, LINE 2 IN ITS ENTIRETY, LINE 3 IN ITS ENTIRETY, LINE 4 IN ITS ENTIRETY, LINE 7 FROM BEGINNING TO MH 30, LINE 15 IN ITS ENTIRETY, LINE 9 IN ITS ENTIRETY, LINE 11 IN ITS ENTIRETY, LINE 13 IN ITS ENTIRETY, LINE 14 IN ITS ENTIRETY, LINE 10 IN ITS ENTIRETY, COMPLETE ALL REMAINING WORK. ALL WORK ON THE PROJECT SHALL BE COMPLETED BY MAY 5, 2006

WATER DISTRIBUTION SYSTEM (448-89999)
THE CONTRACTOR SHALL COMPLETE FONTANA - PHASE 1 AND FONTANA 2ND WATERLINE CONSTRUCTION BY JUNE 2, 2006. THE CONTRACTOR SHALL COORDINATE INSTALLATION OF WATERLINES WITH THE STORM WATER DRAIN AND PAVING CONTRACTOR SO THAT STORM SEWERS CROSSING BELOW PROPOSED WATERLINES WILL BE INSTALLED PRIOR TO WATERLINE CONSTRUCTION. THE CONTRACTOR SHALL COORDINATE HIS WORK EFFORTS WITH THE CONTRACTOR FOR THE WATER SUPPLY LINE (BY OTHERS) FOR CONNECTION TO THE SUPPLY LINE AND BLOWING OFF/TESTING OF THE PROPOSED WATERLINES.

STREETS/DRAINAGE (472-84086)
THE CONTRACTOR SHALL COMPLETE FONTANA - PHASE 1 AND FONTANA 2ND STREETS/DRAINAGE CONSTRUCTION BY JULY 14, 2006.

STORM WATER DRAIN (468-83883)
THE CONTRACTOR SHALL COMPLETE FONTANA - PHASE 1 AND FONTANA 2ND STORM WATER DRAIN CONSTRUCTION BY FEBRUARY 25, 2006.

NOVEMBER 2005
PLANS PREPARED BY
PROFESSIONAL ENGINEERING CONSULTANTS, P.A.
ENGINEERS
WICHITA, KANSAS

