

SANITARY SEWER PLANS FOR
HAWTHORNE THIRD ADD.
PHASE 4

LINES 1 & 2
SHEET TITLE
468-83874
PROJECT NUMBER




DESIGN BY: DFL
DRAWN BY: DMU
CHECKED BY: GJA

ISSUED: JUNE 2006
REVISED:

SHEET NO.
4 of 10

HAWTHORNE THIRD ADDITION

HAWTHORNE THIRD ADDITION

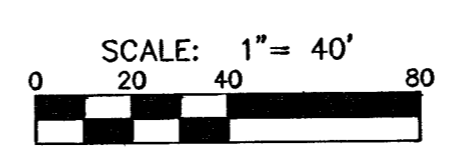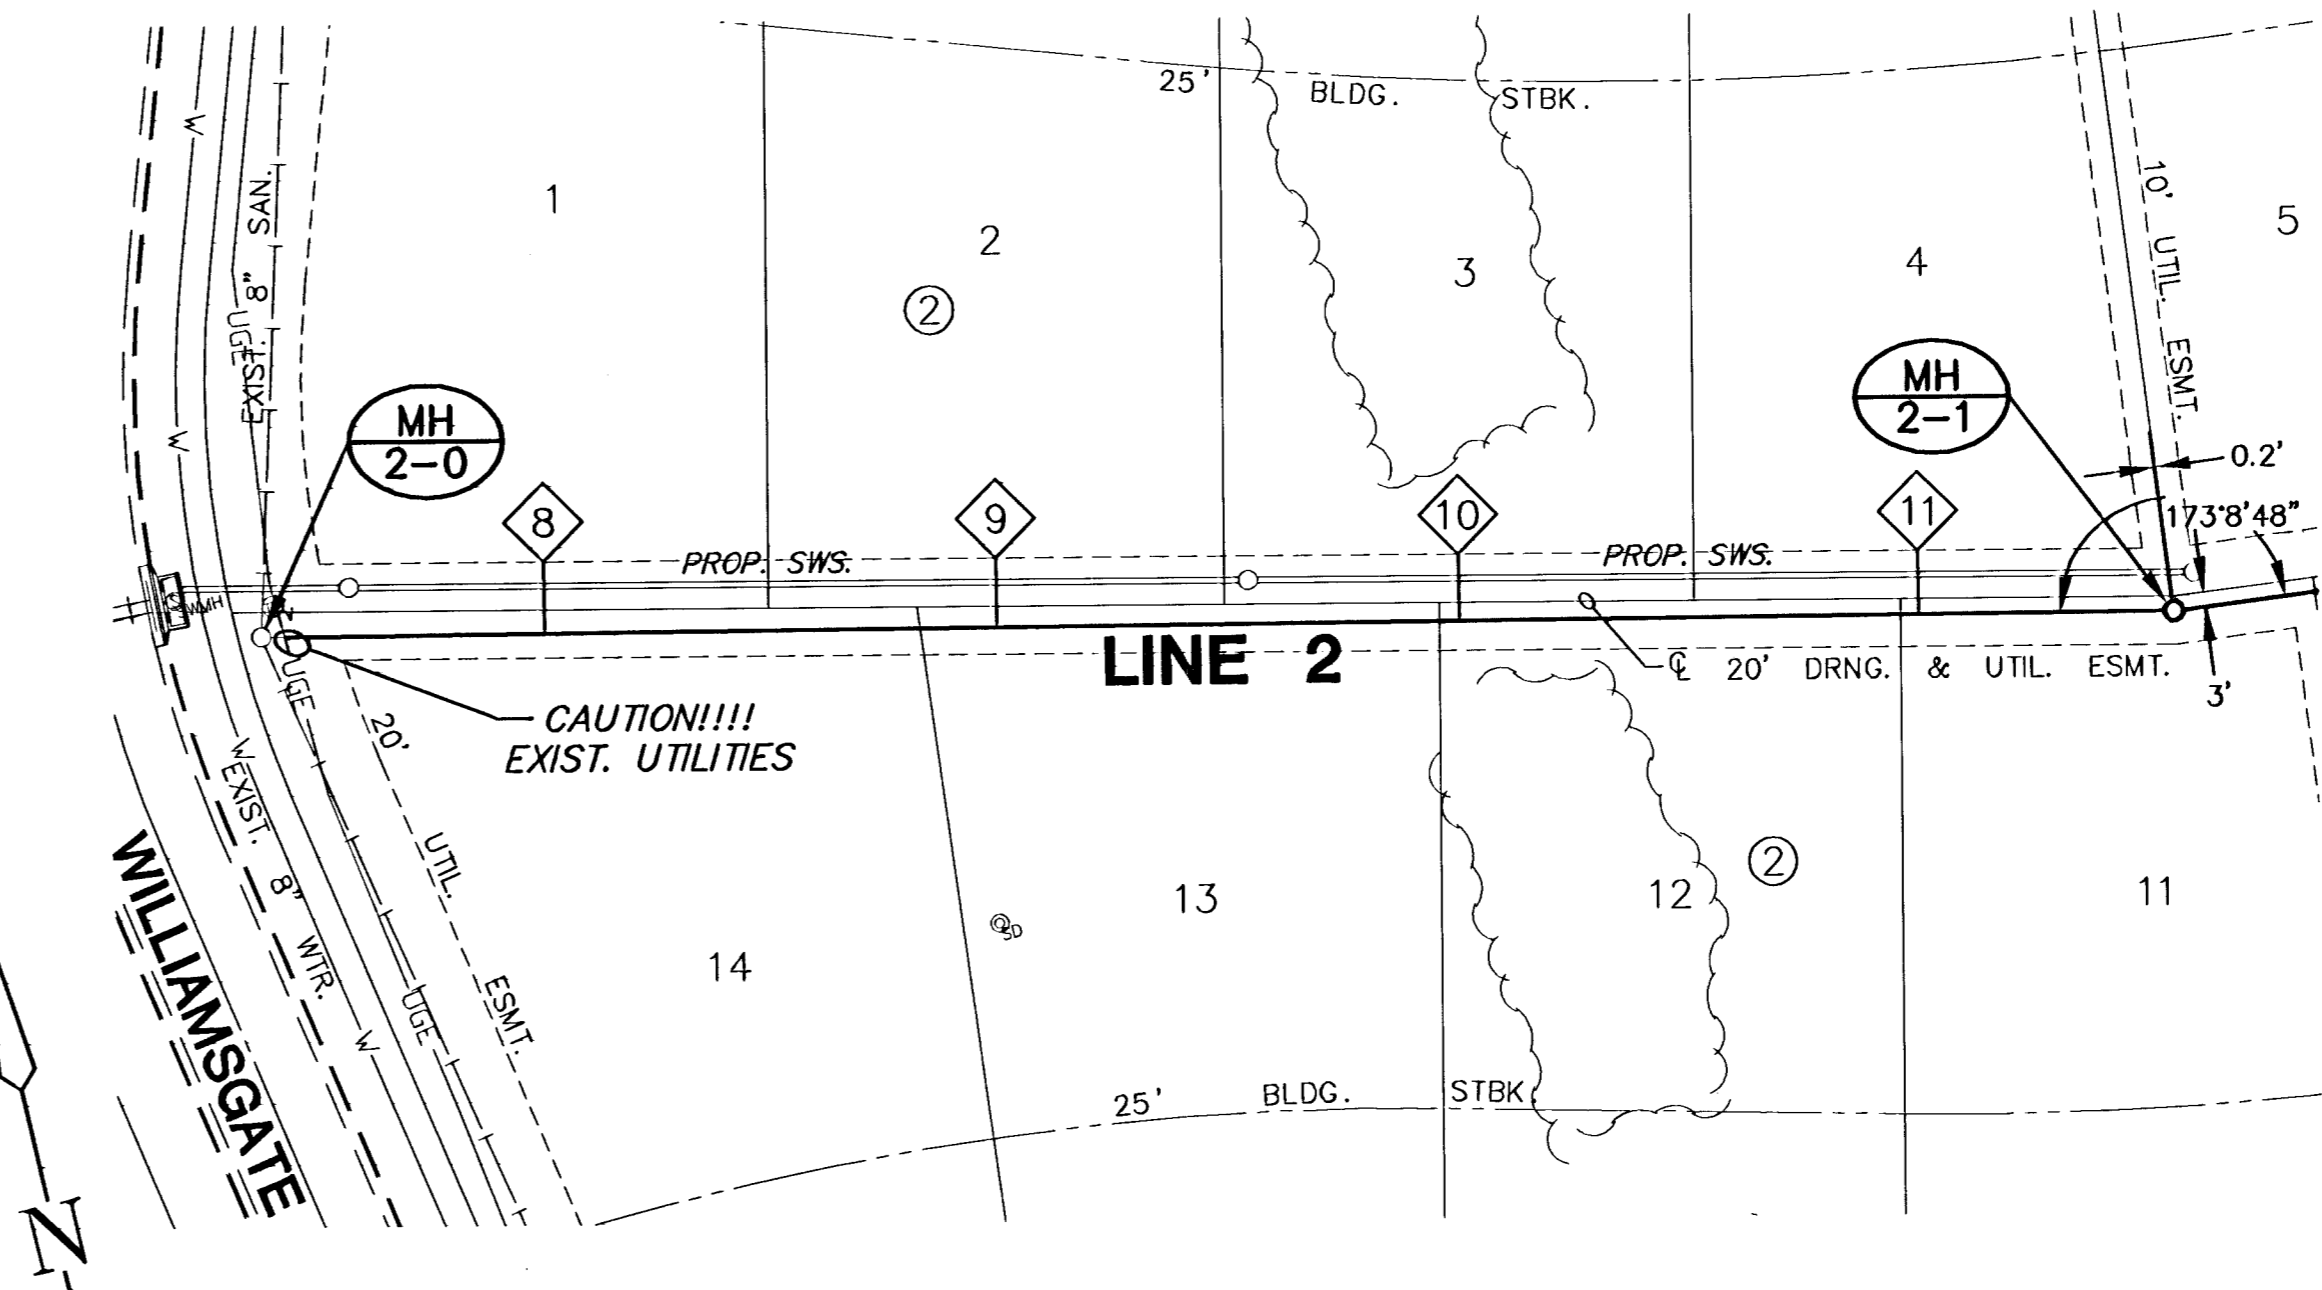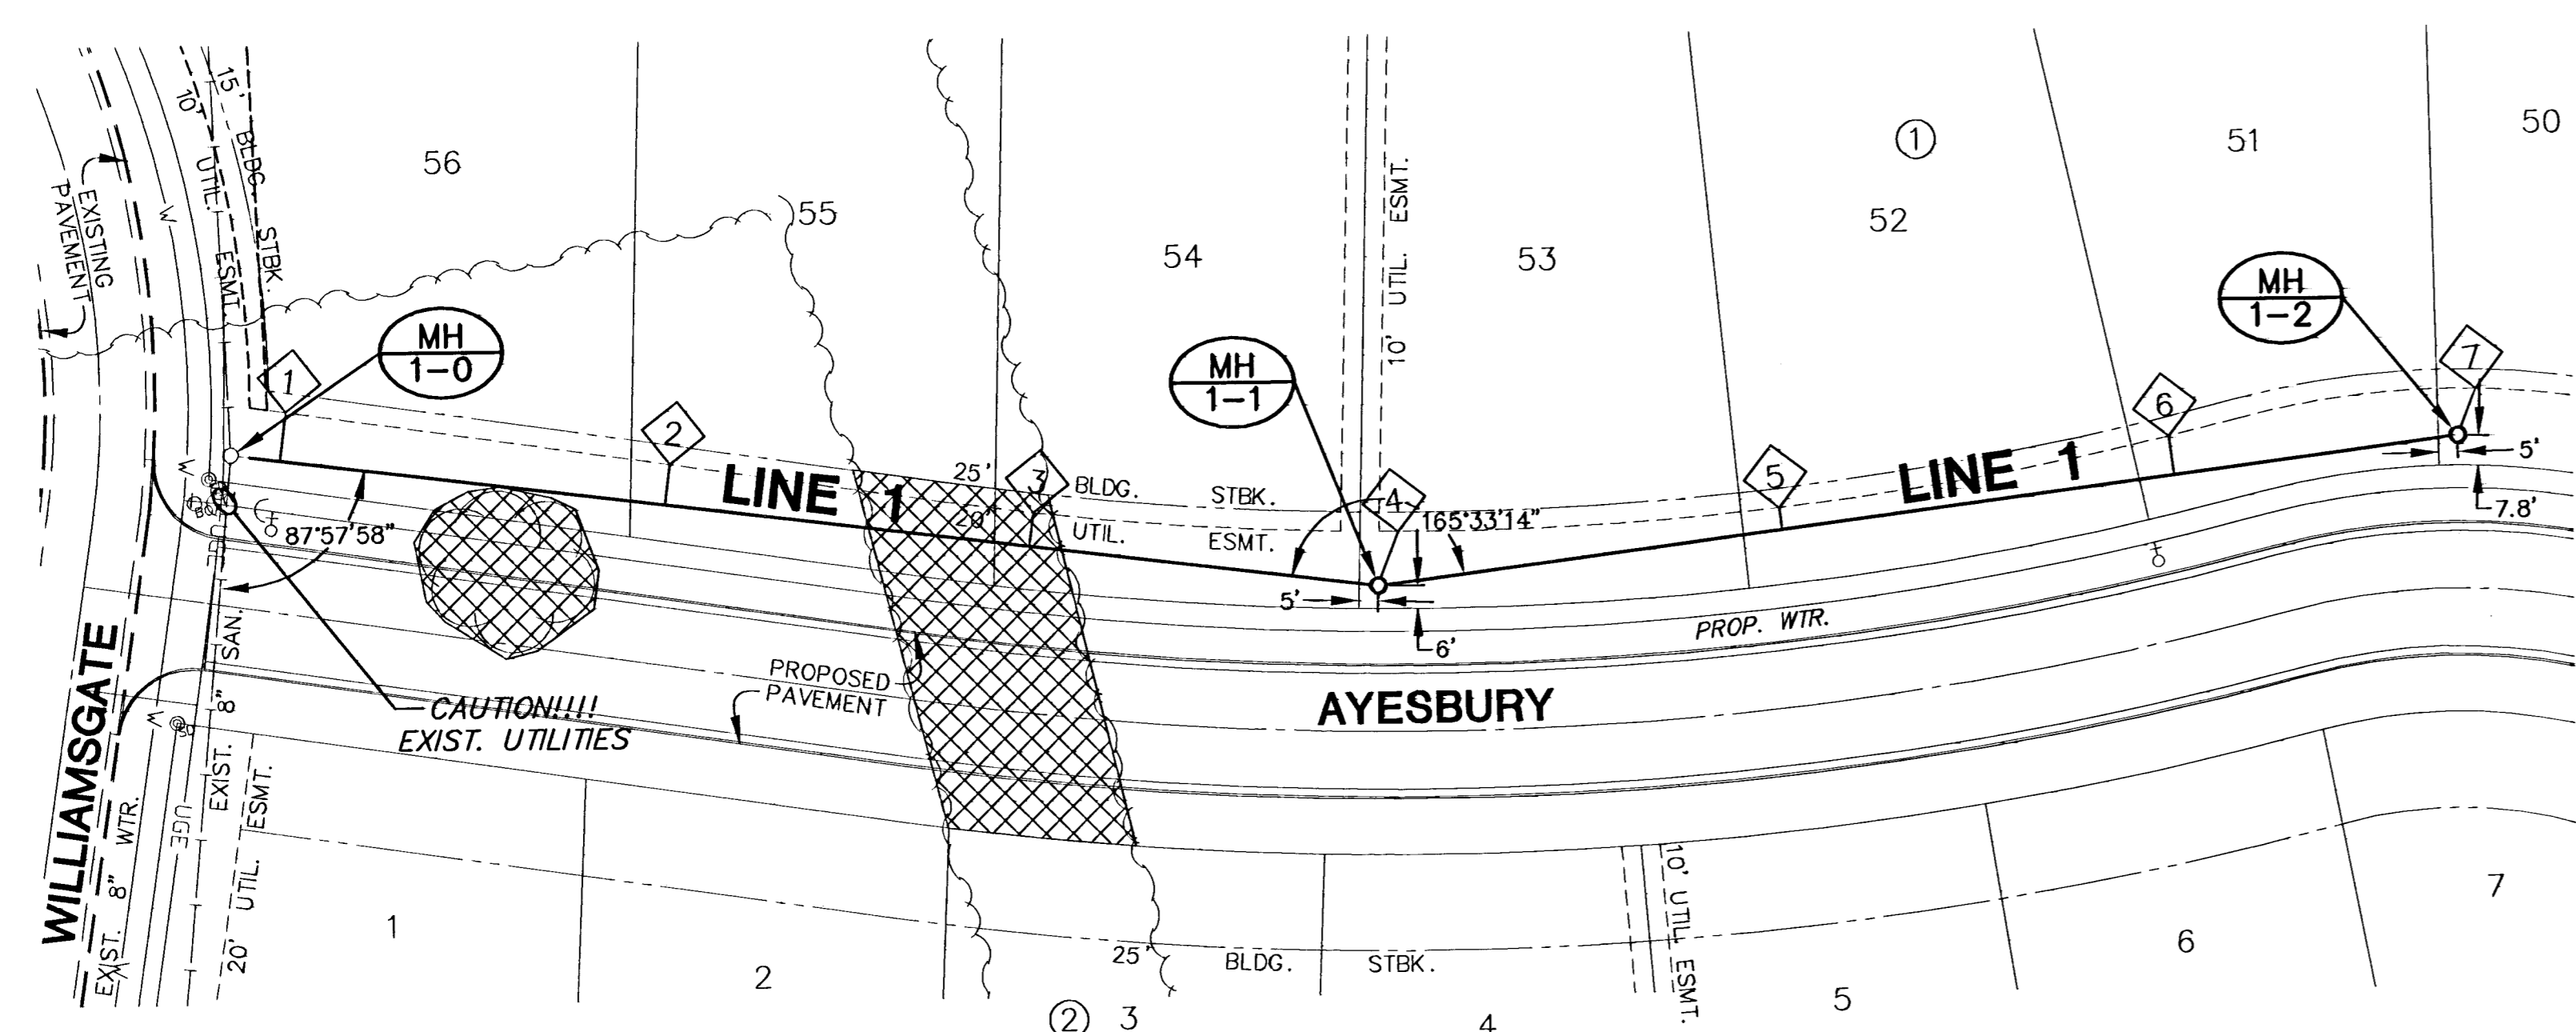

HAWTHORNE THIRD ADDITION

HAWTHORNE THIRD ADDITION


PLAN LINE 1

PLAN LINE 2

(AB) = AS-BUILT

NOTES:
CONTRACTOR TO VERIFY THE DEPTH AND LOCATION OF EXISTING UTILITIES PRIOR TO CONSTRUCTION.
TRENCHES TO BE BACKFILLED WITH SAND AND FLUSHED WHEN SEWER LINE RUNS ALONG FRONT OF LOTS.

[Hatched Box] = TREE REMOVAL

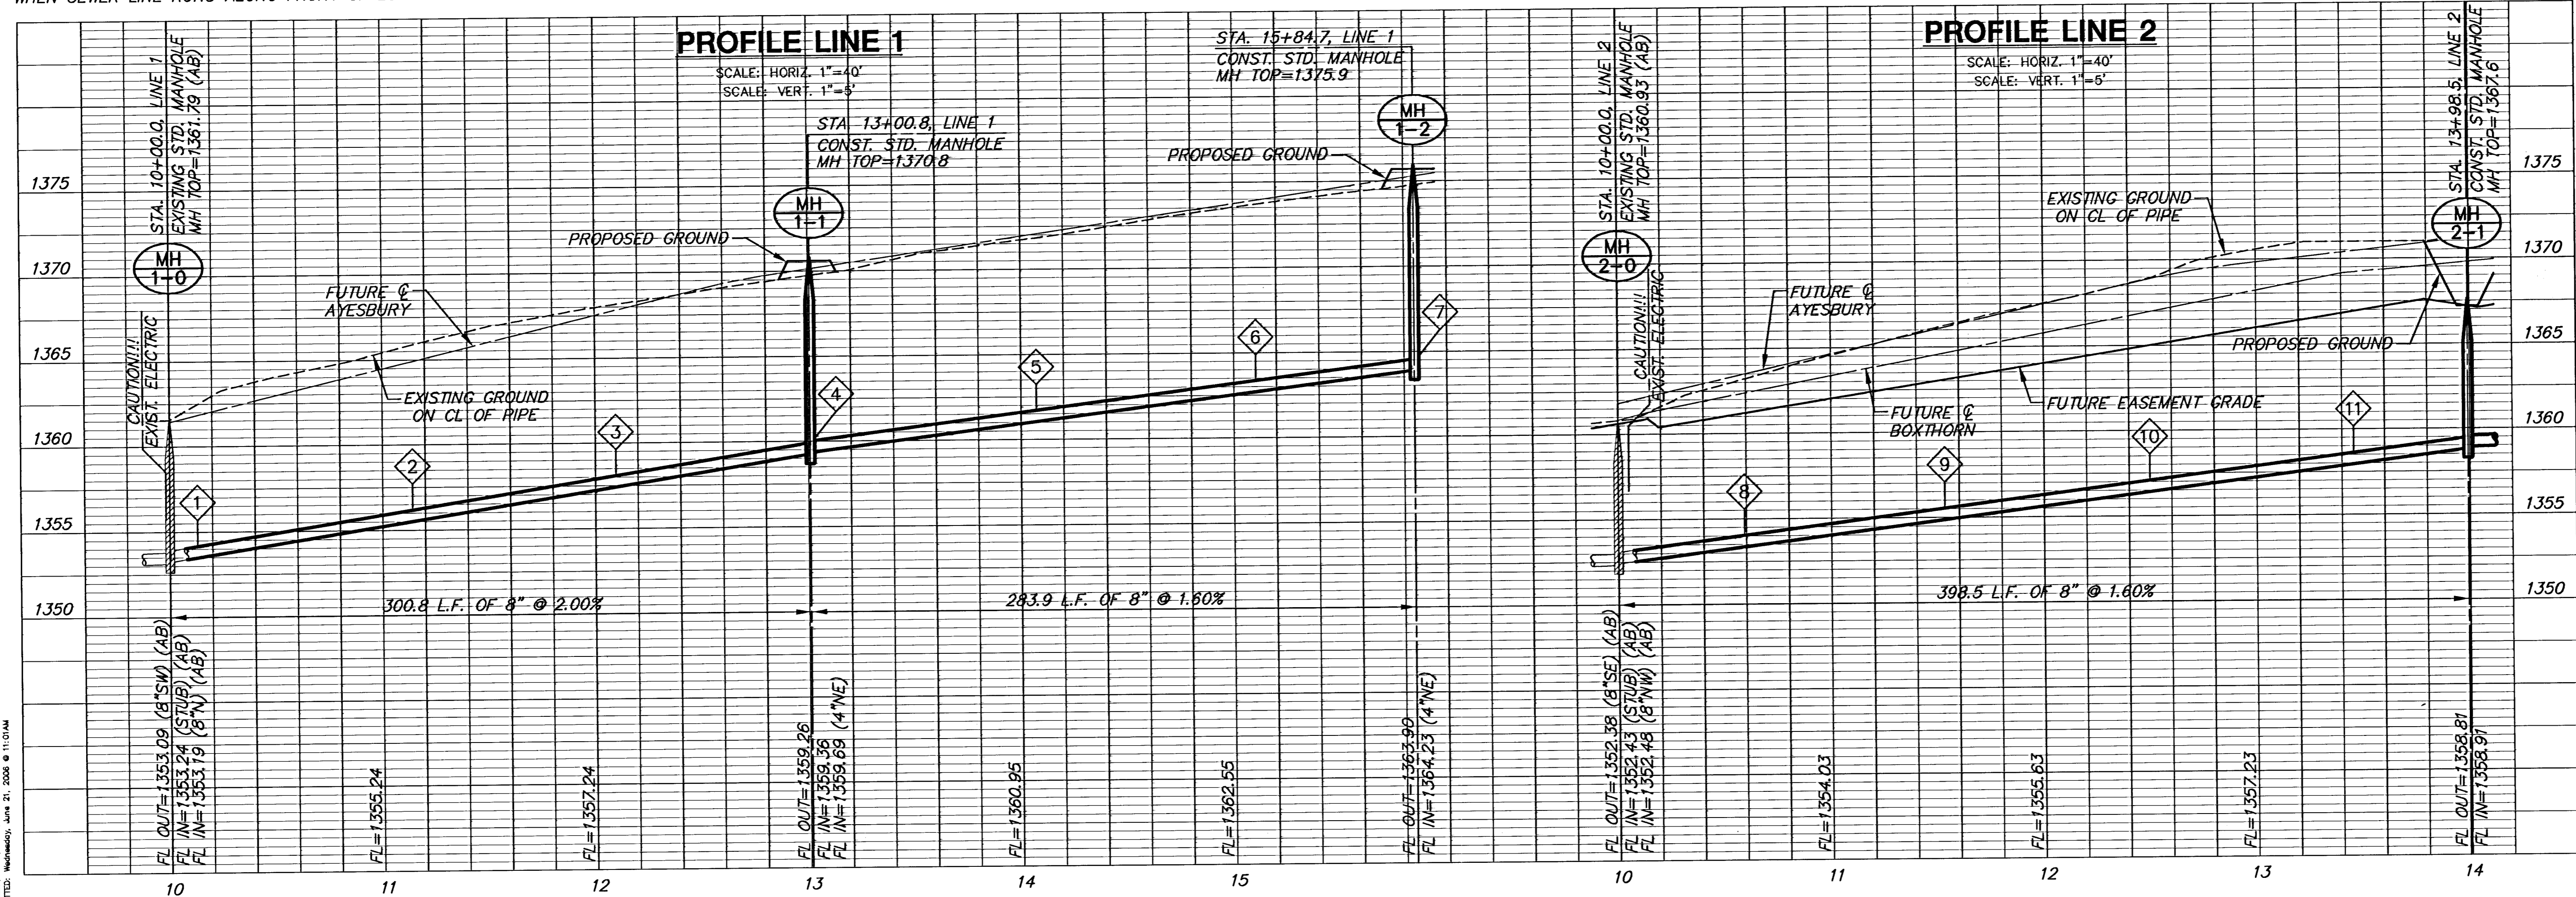

PLOT DATE: November, June 21, 2006 @ 11:01 AM

H:\Civil\20167\DWG\San_Sew_Ads\Ph4\02167.dwg