

**SANITARY SEWER PLANS FOR  
 HAWTHORNE THIRD ADD.  
 PHASE 4**


**LINES 2 & 3**  
 SHEET TITLE  
 PROJECT NUMBER  
 468-83874

DESIGN BY  
 DFL  
 DRAWN BY  
 DMU  
 CHECKED BY  
 GJA

ISSUED  
 JUNE 2006  
 REVISED

SHEET NO.  
 5 of 10


HAWTHORNE THIRD ADDITION

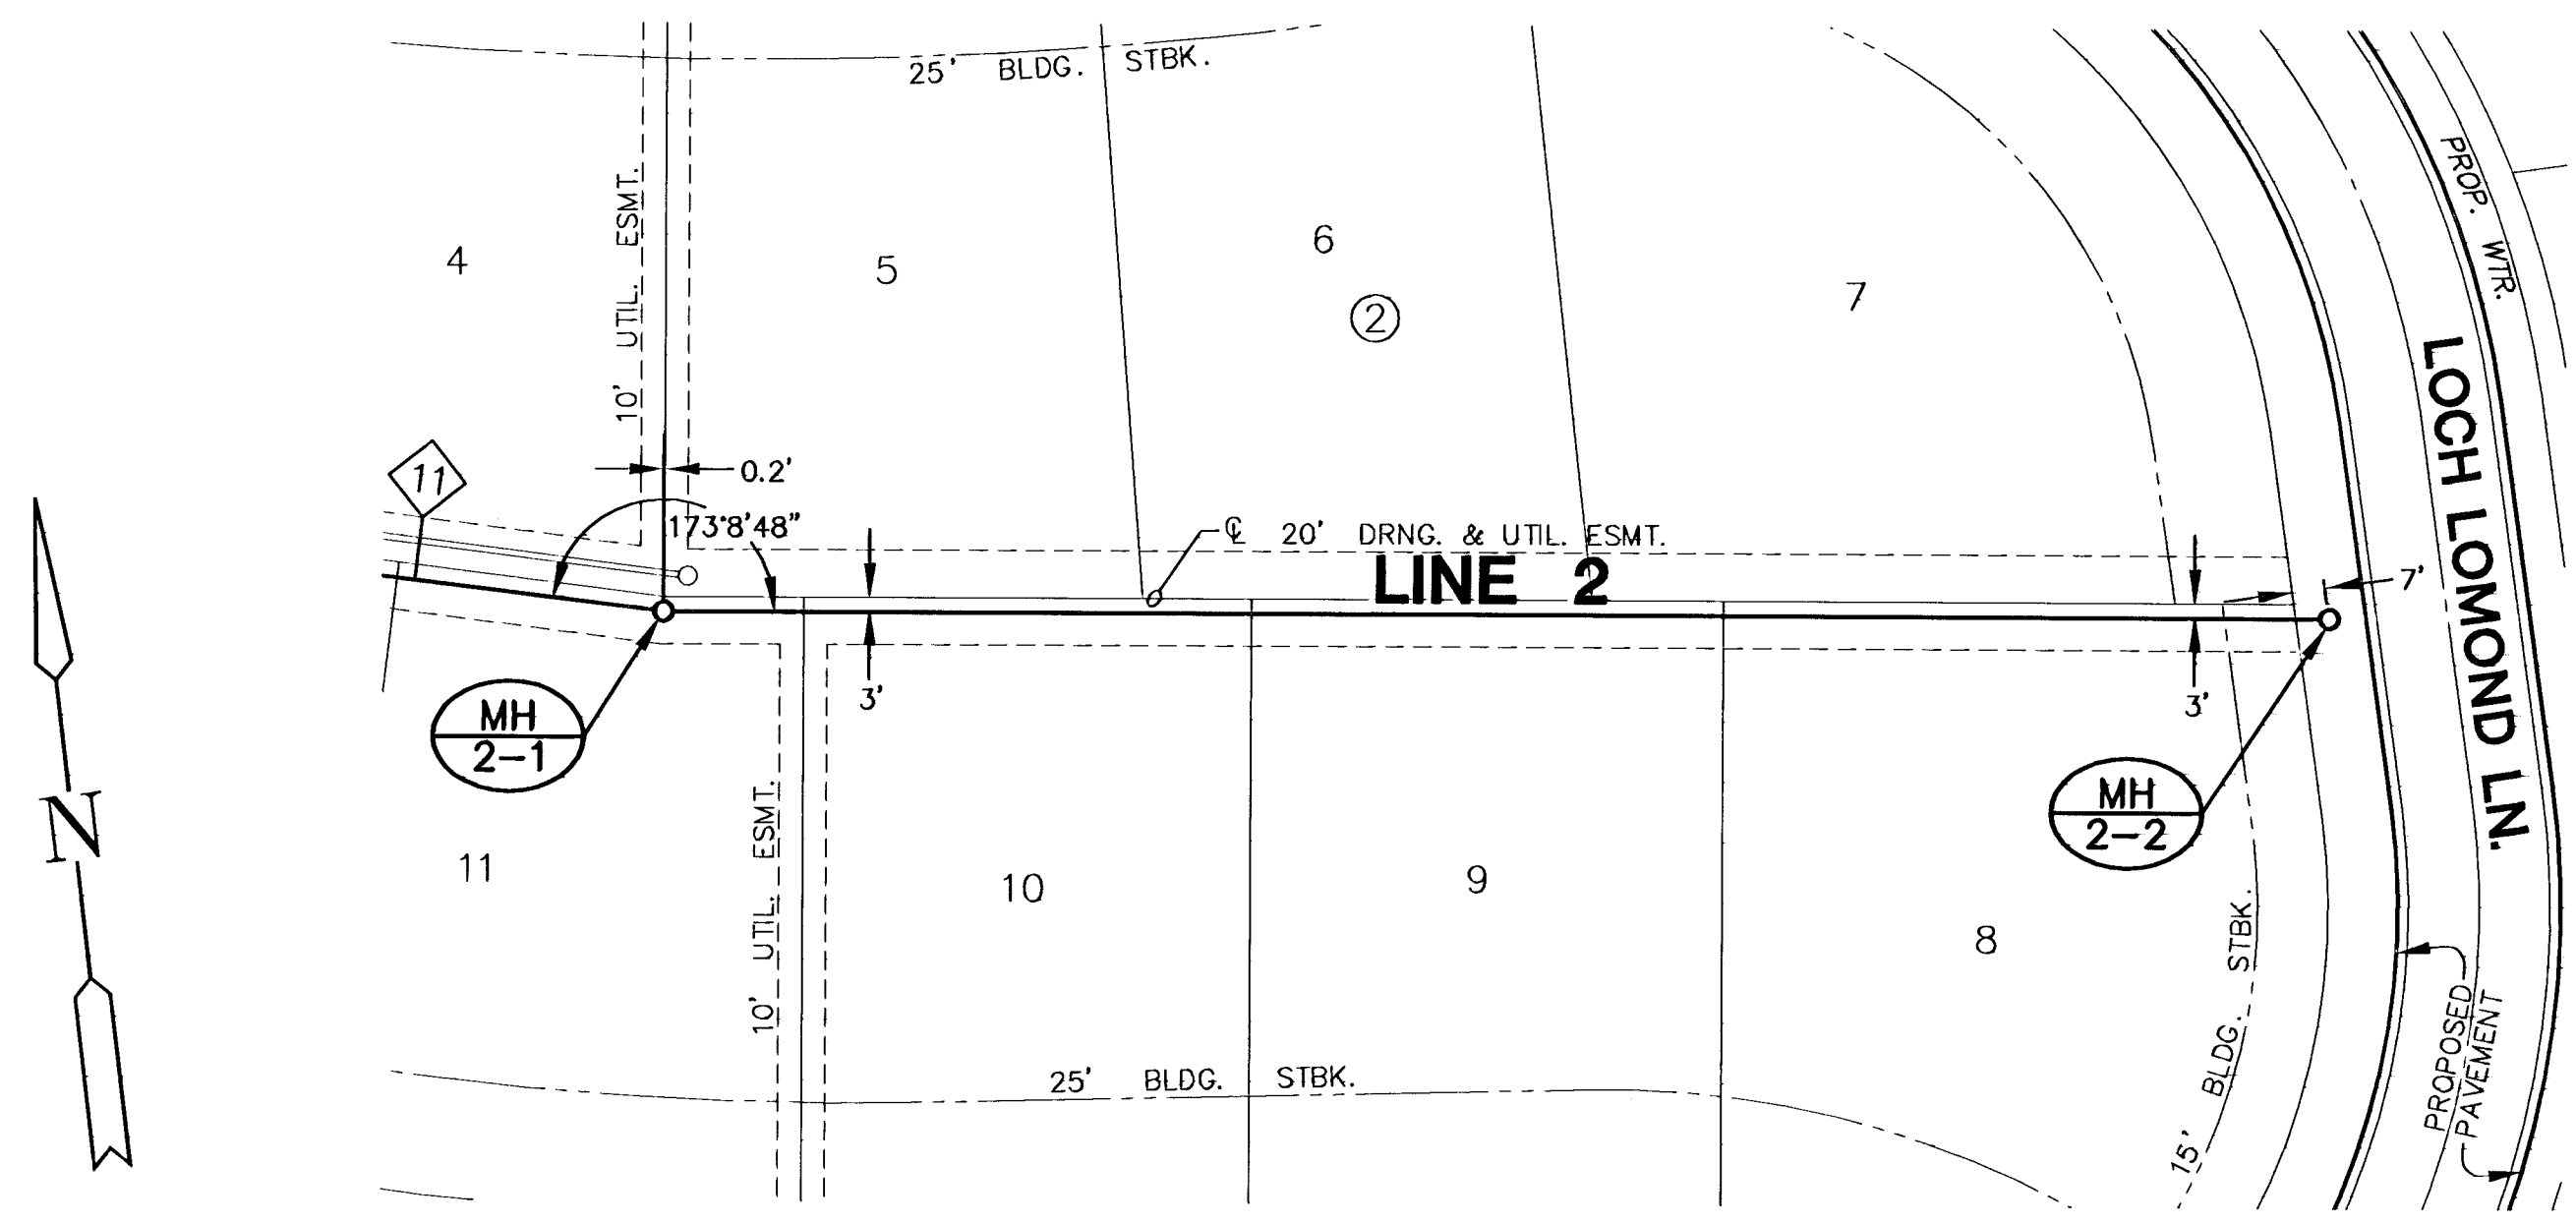

HAWTHORNE THIRD ADDITION


PLAN LINE 2

HAWTHORNE THIRD ADDITION

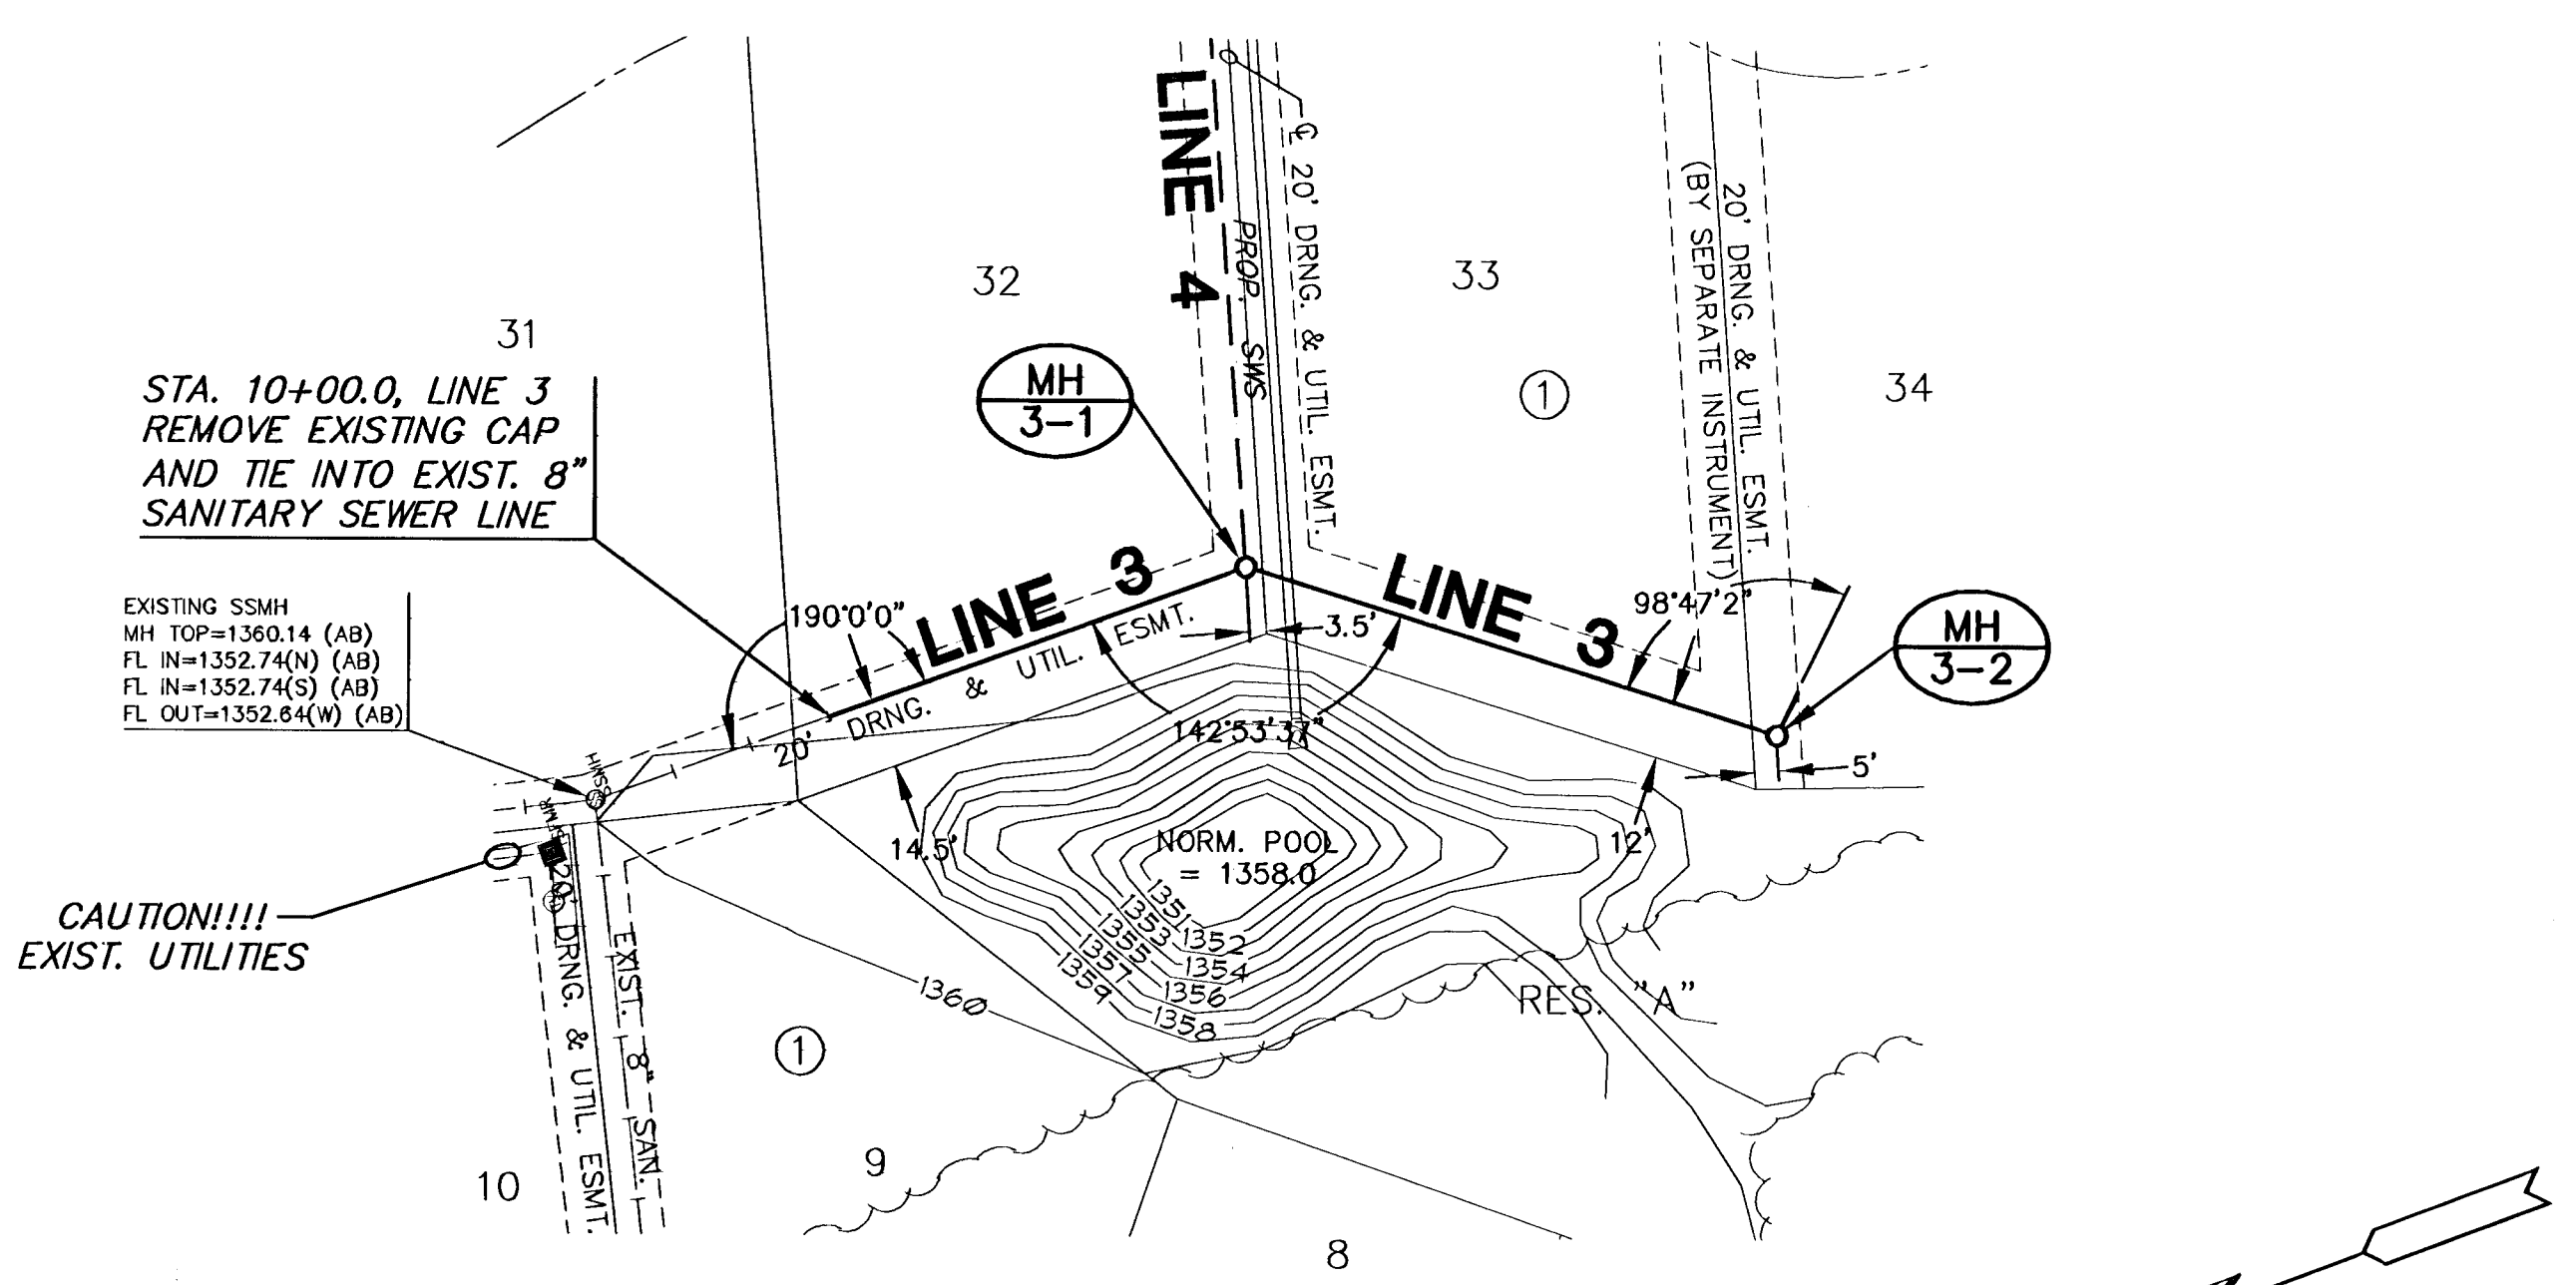


HAWTHORNE THIRD ADDITION

PLAN LINE 3

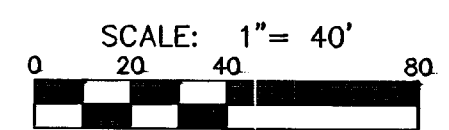


(AB) = AS-BUILT

NOTES:  
 CONTRACTOR TO VERIFY THE DEPTH AND LOCATION OF EXISTING UTILITIES PRIOR TO CONSTRUCTION.  
 TRENCHES TO BE BACKFILLED WITH SAND AND FLUSHED WHEN SEWER LINE RUNS ALONG FRONT OF LOTS.

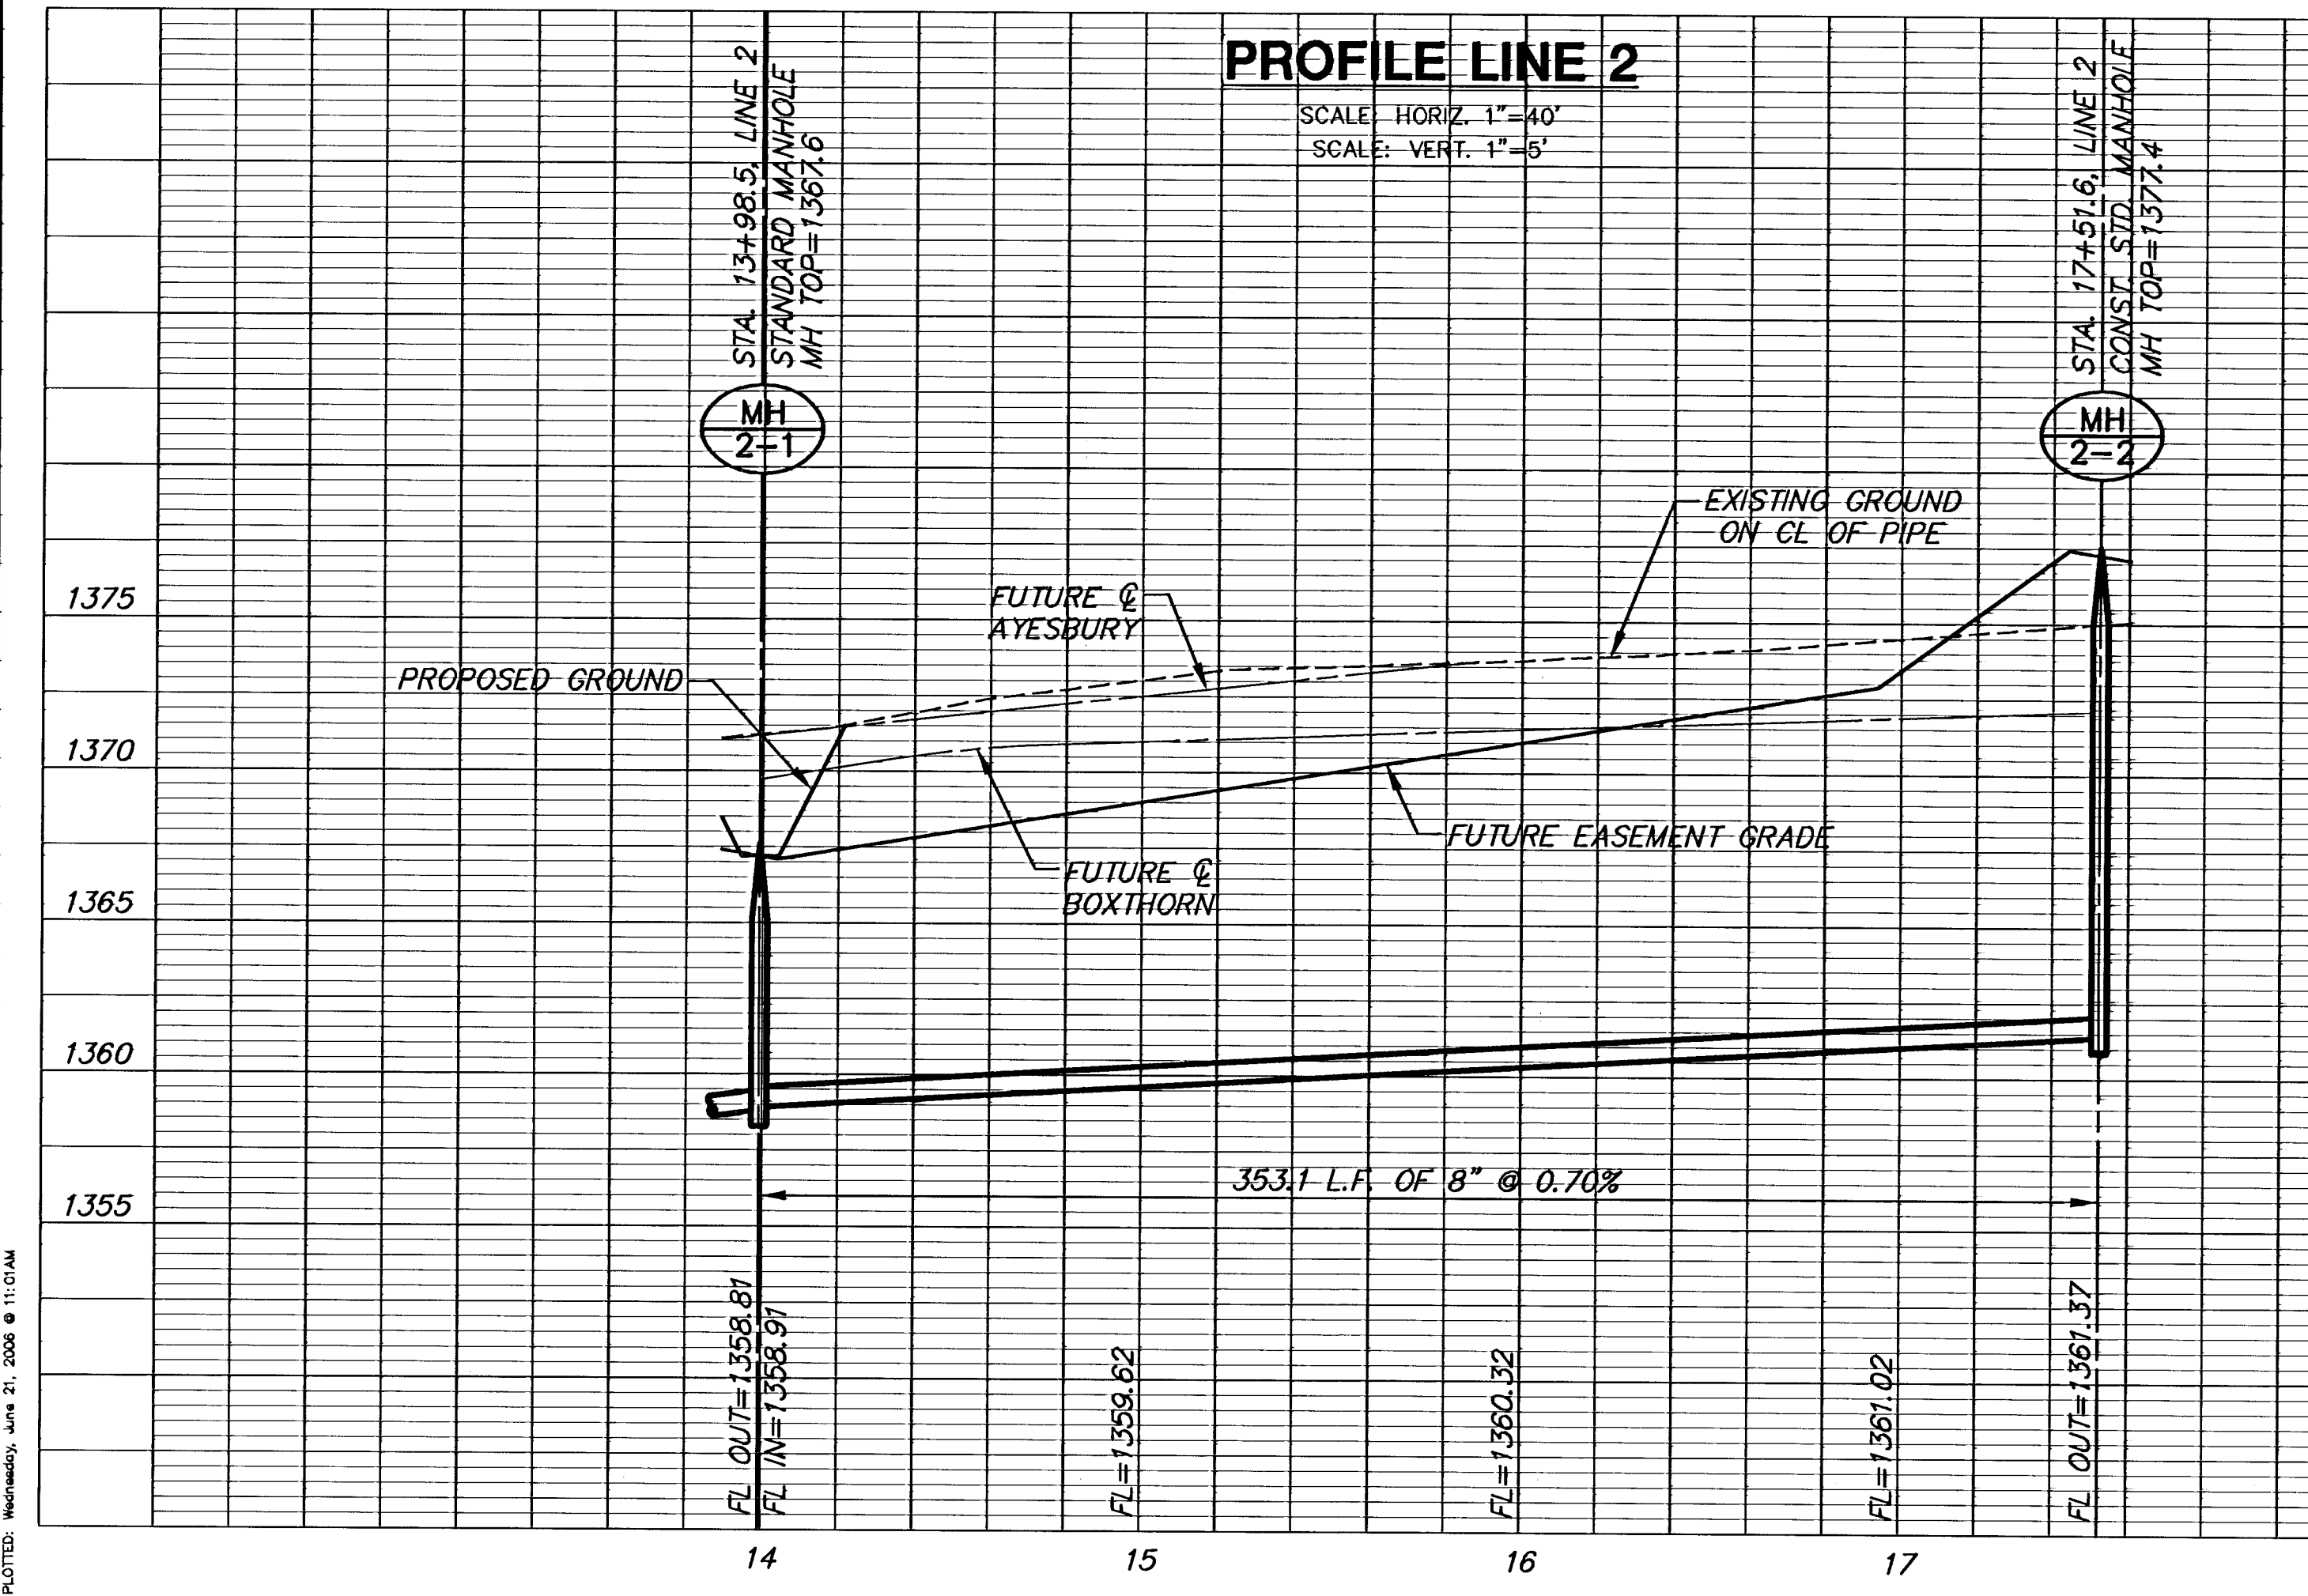

PLOTTED: Wednesday, June 21, 2006 @ 11:01 AM

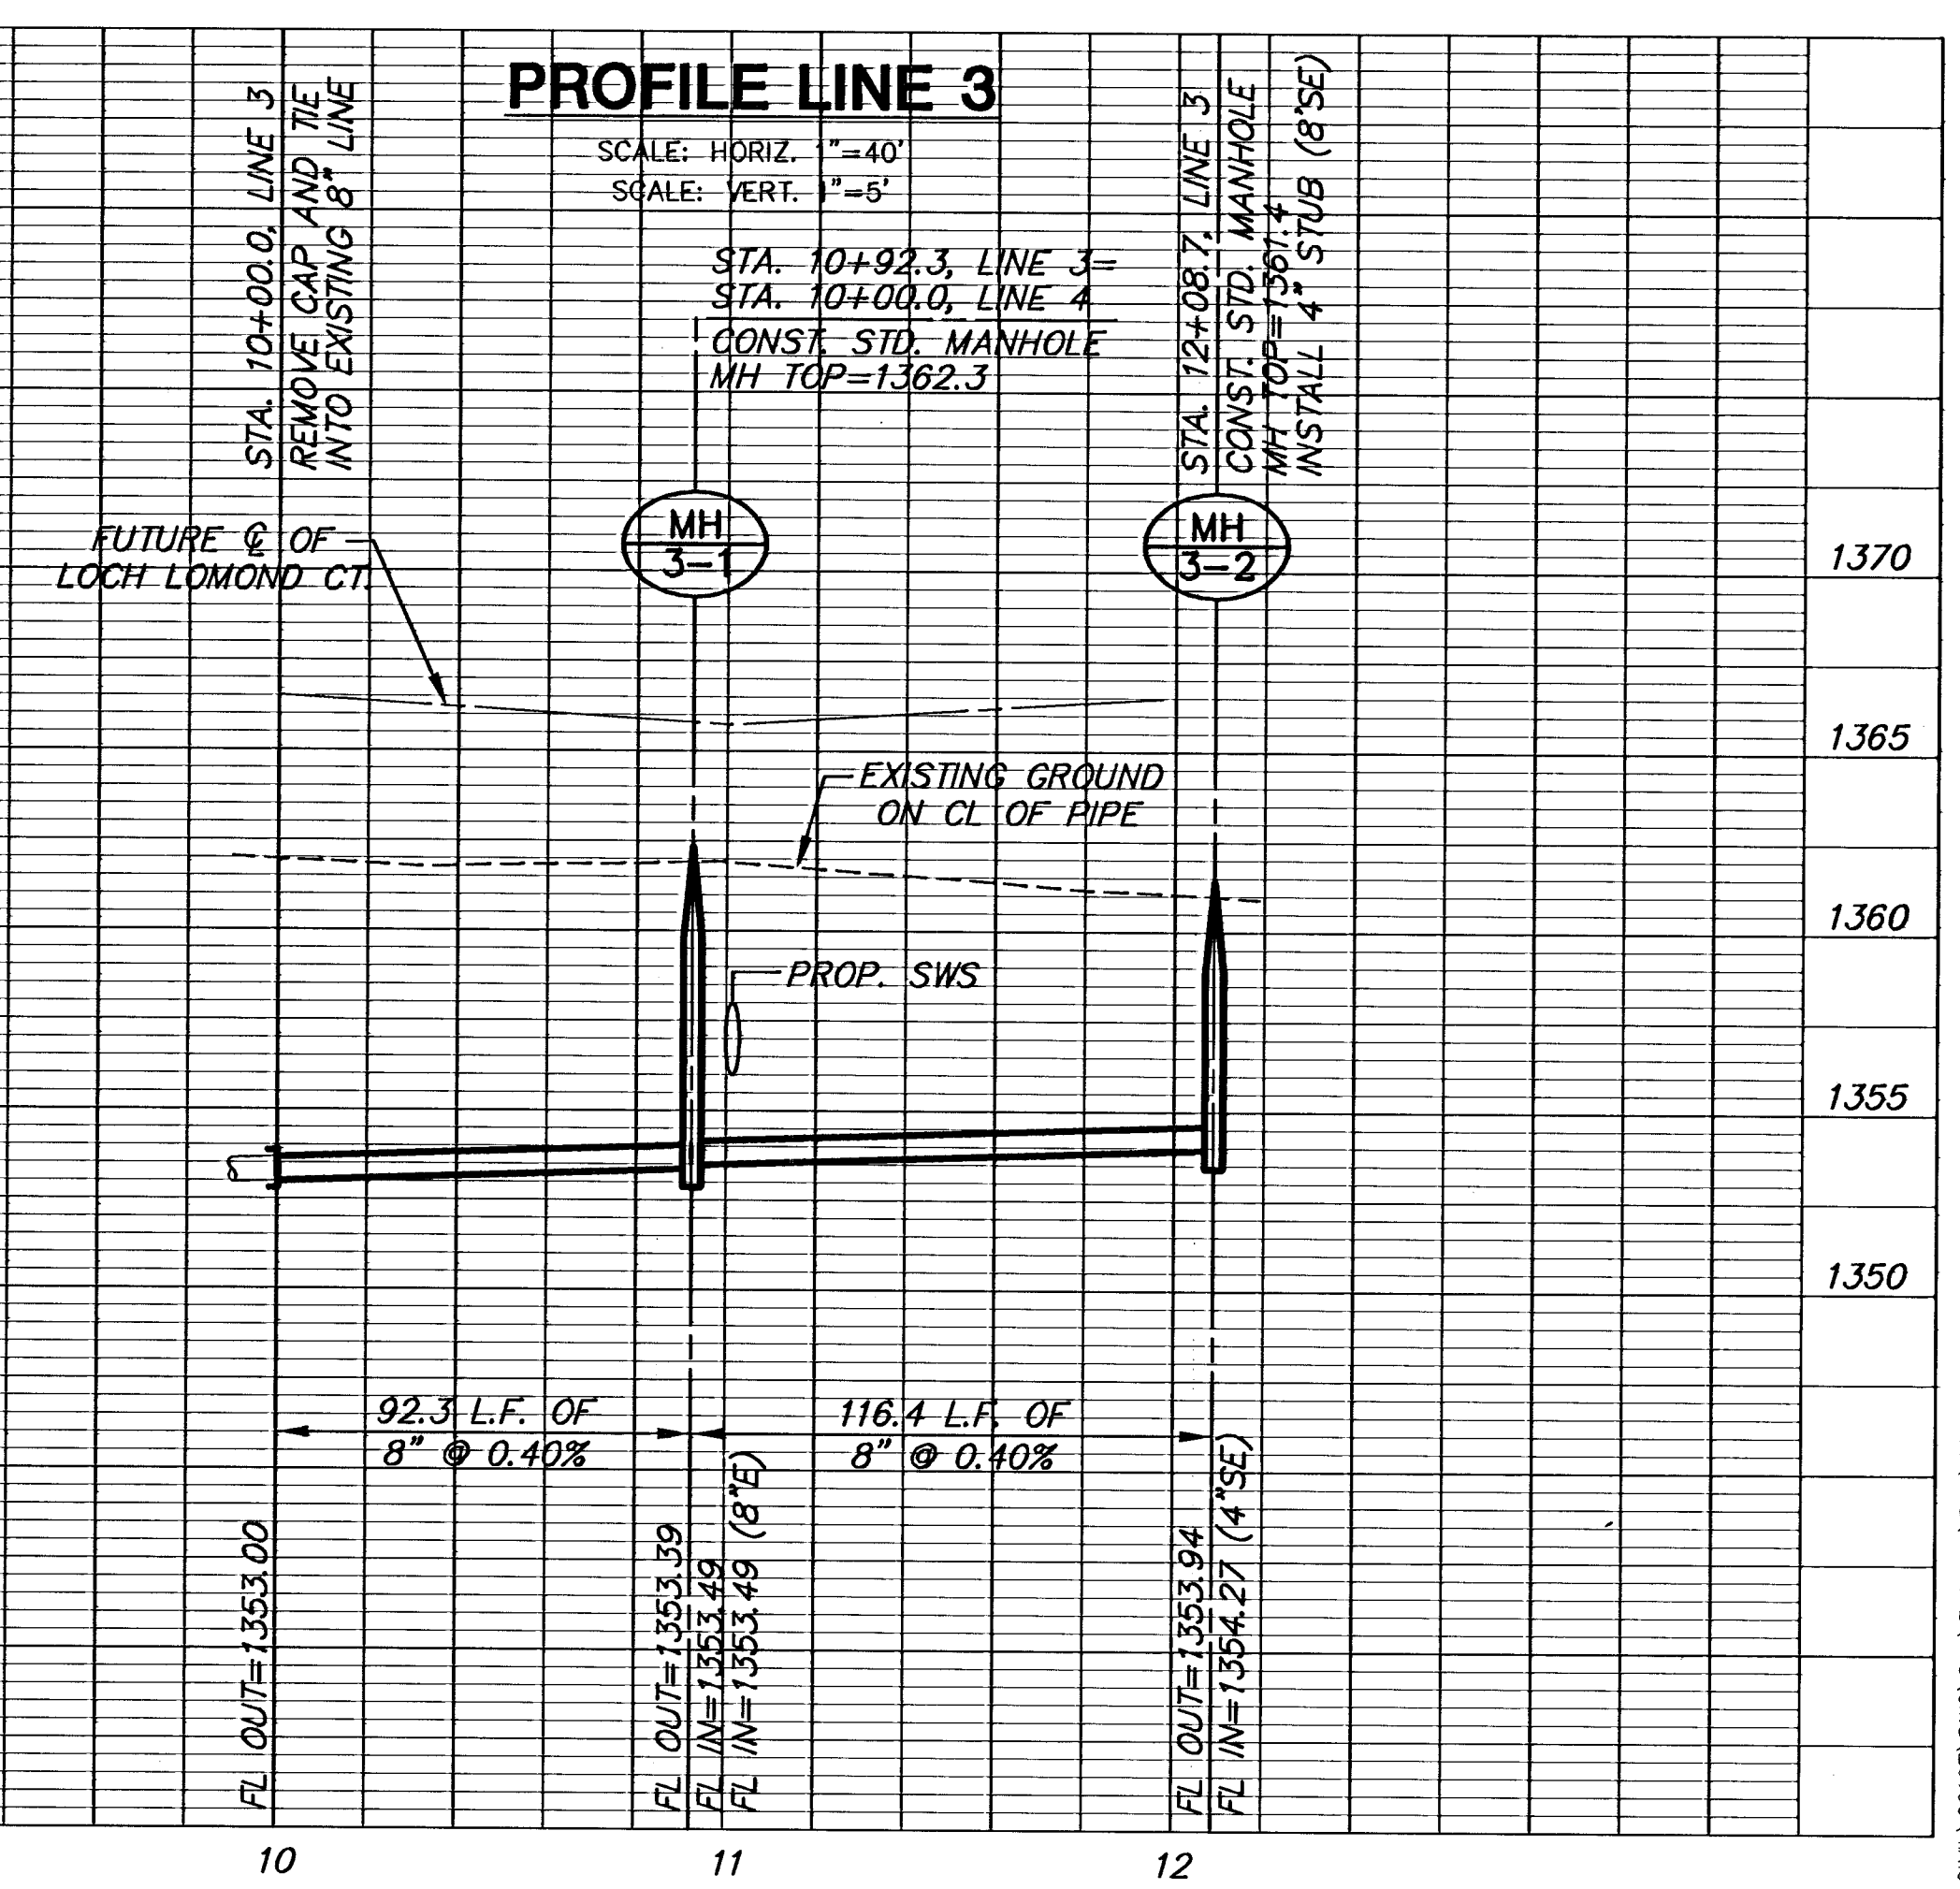

H:\DWG\02187\000\50m\30a Add\104\02187\_B2