


**SANITARY SEWER PLANS FOR
HAWTHORNE THIRD ADD.**
PHASE 4

LINES 4 & 6
SHEET TITLE
468-83874
PROJECT NUMBER


DESIGN BY DFL
DRAWN BY DMU
CHECKED BY GJA

ISSUED JUNE 2006
REVISED


SHEET NO.
6 of 10

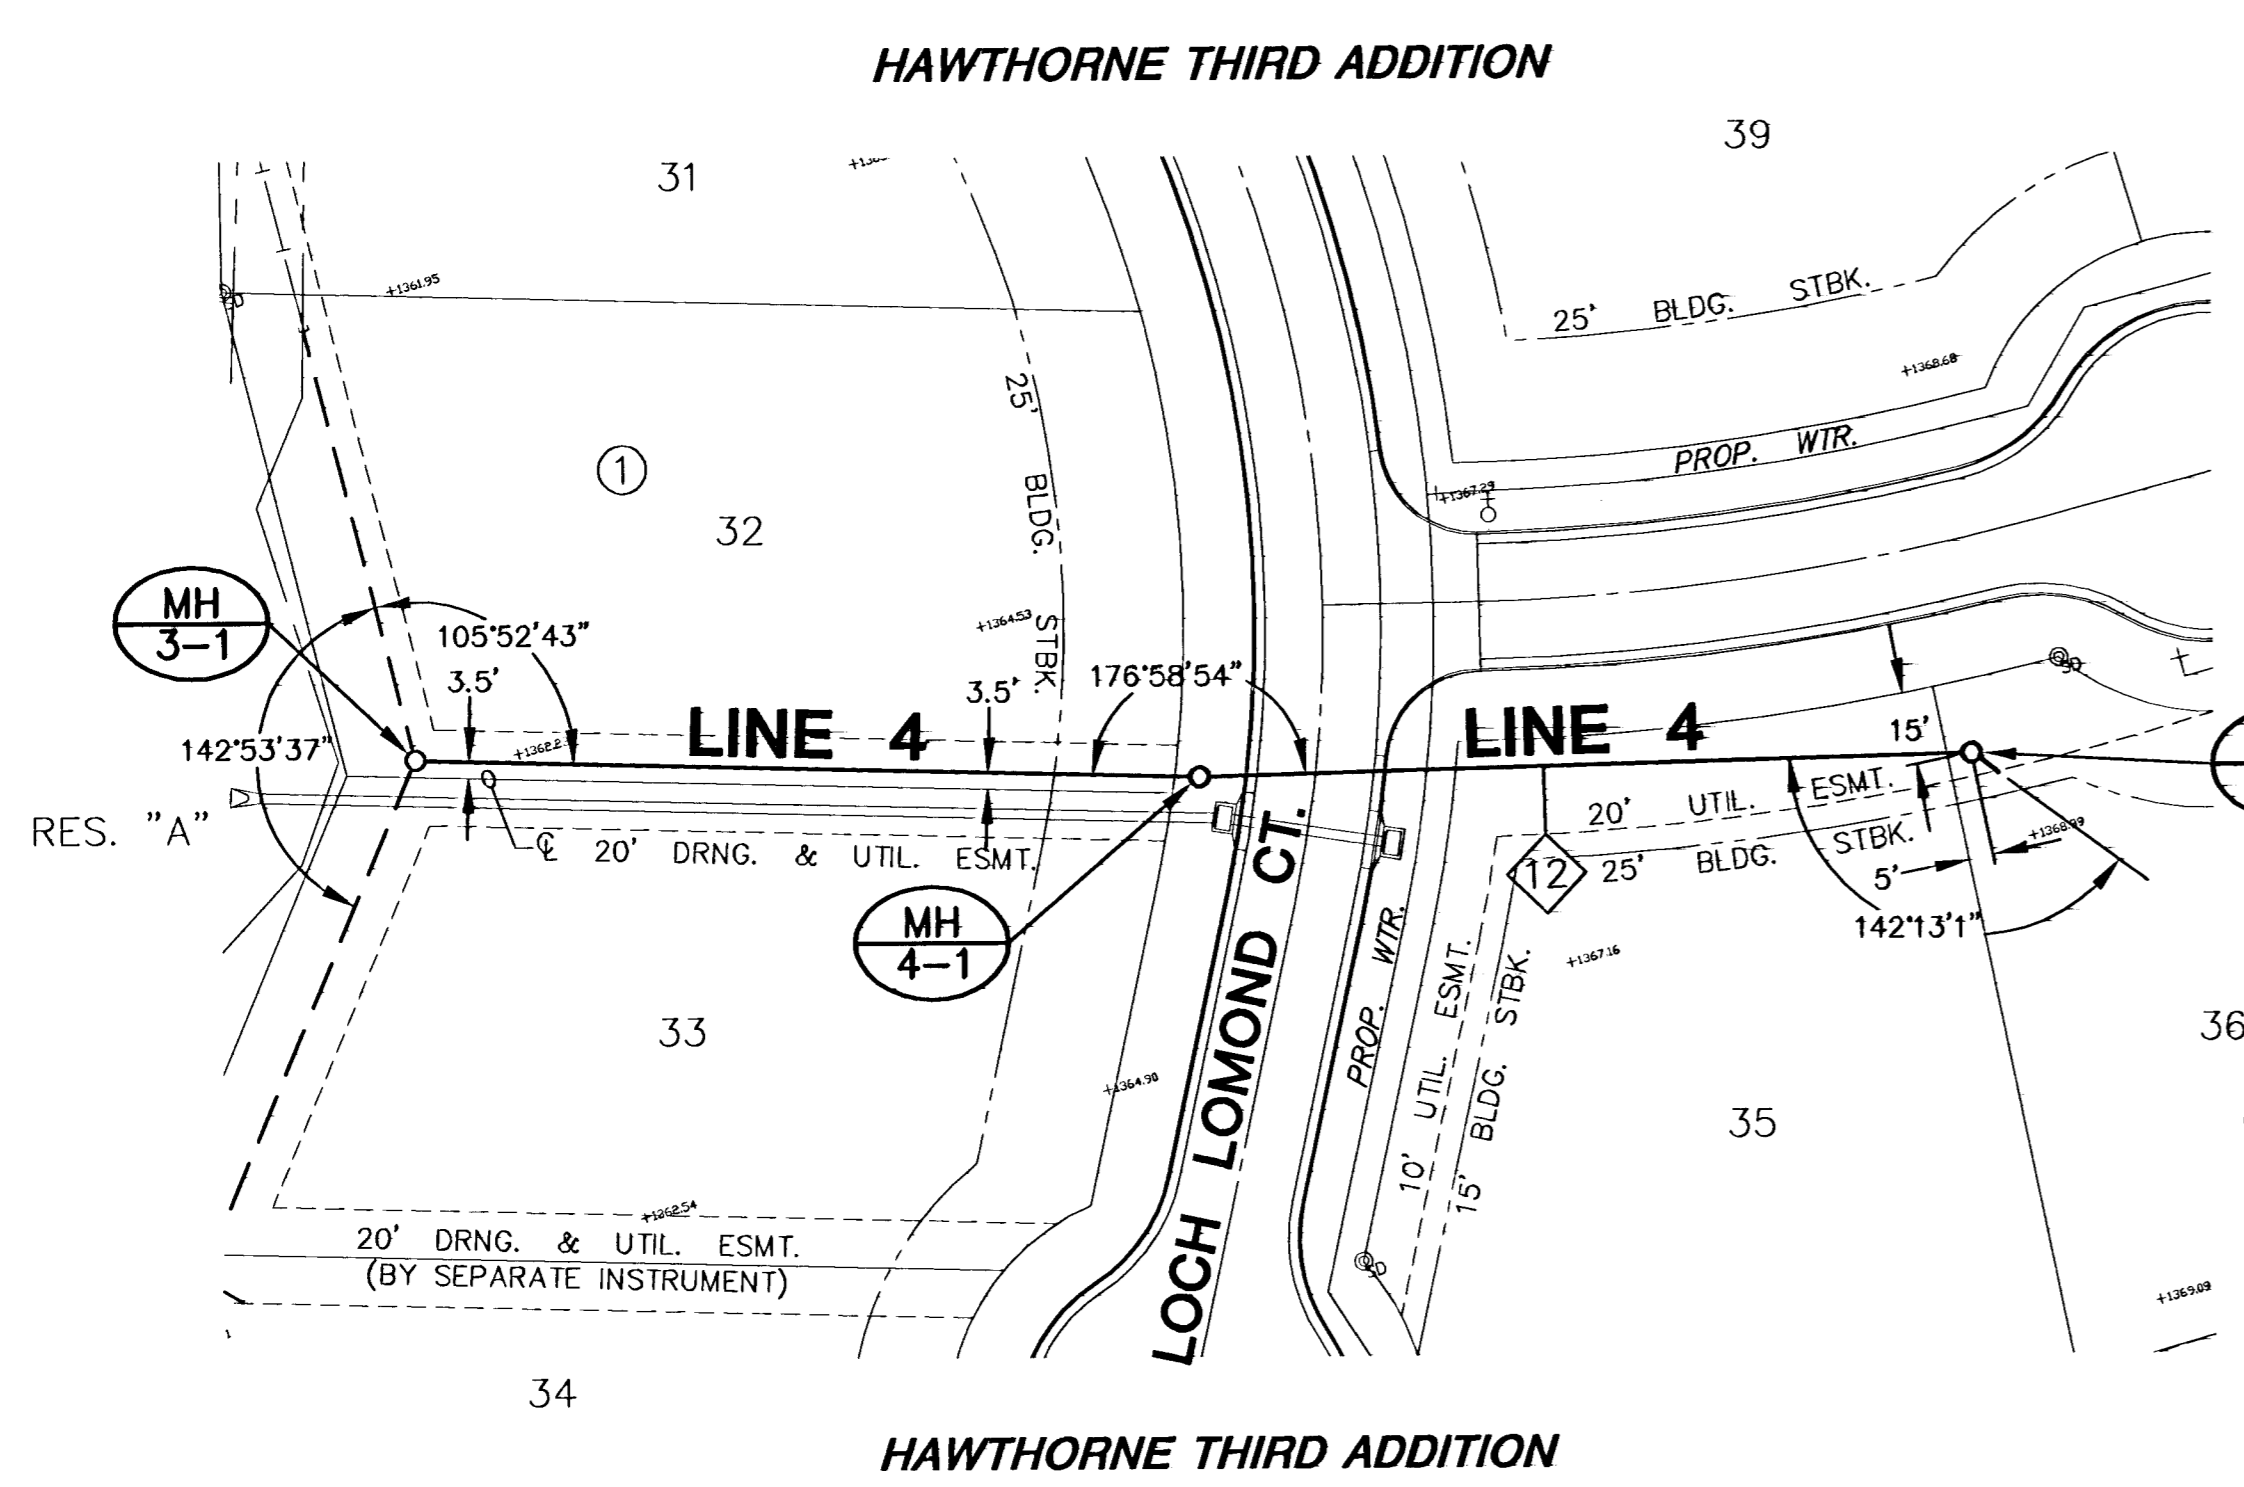


PLAN LINE 4

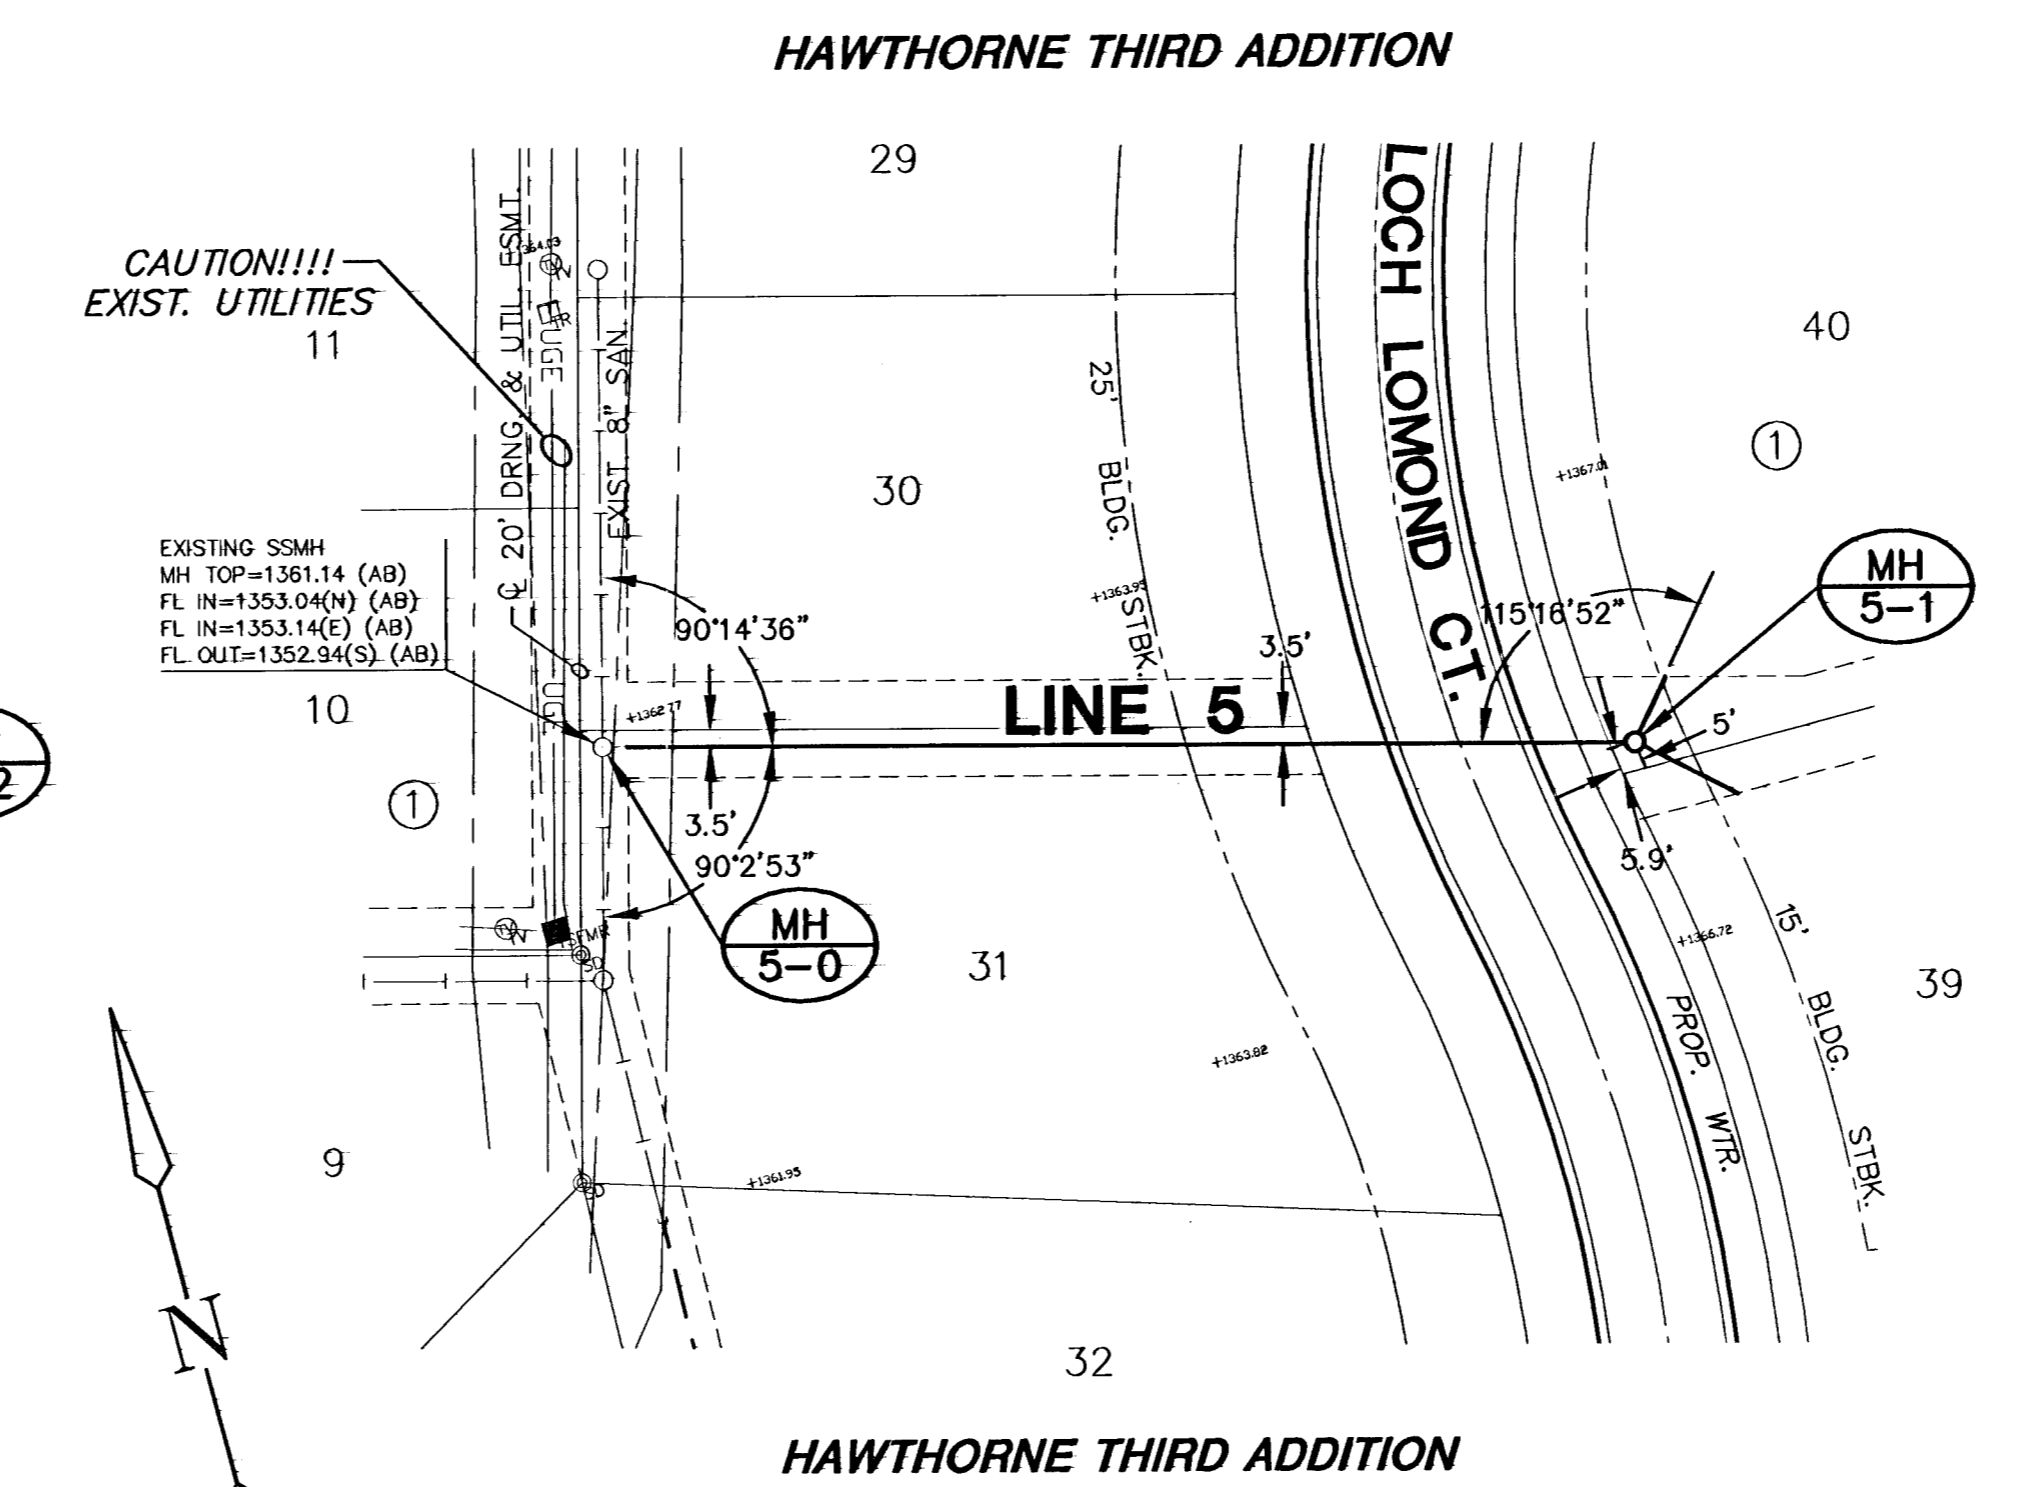

PLAN LINE 5

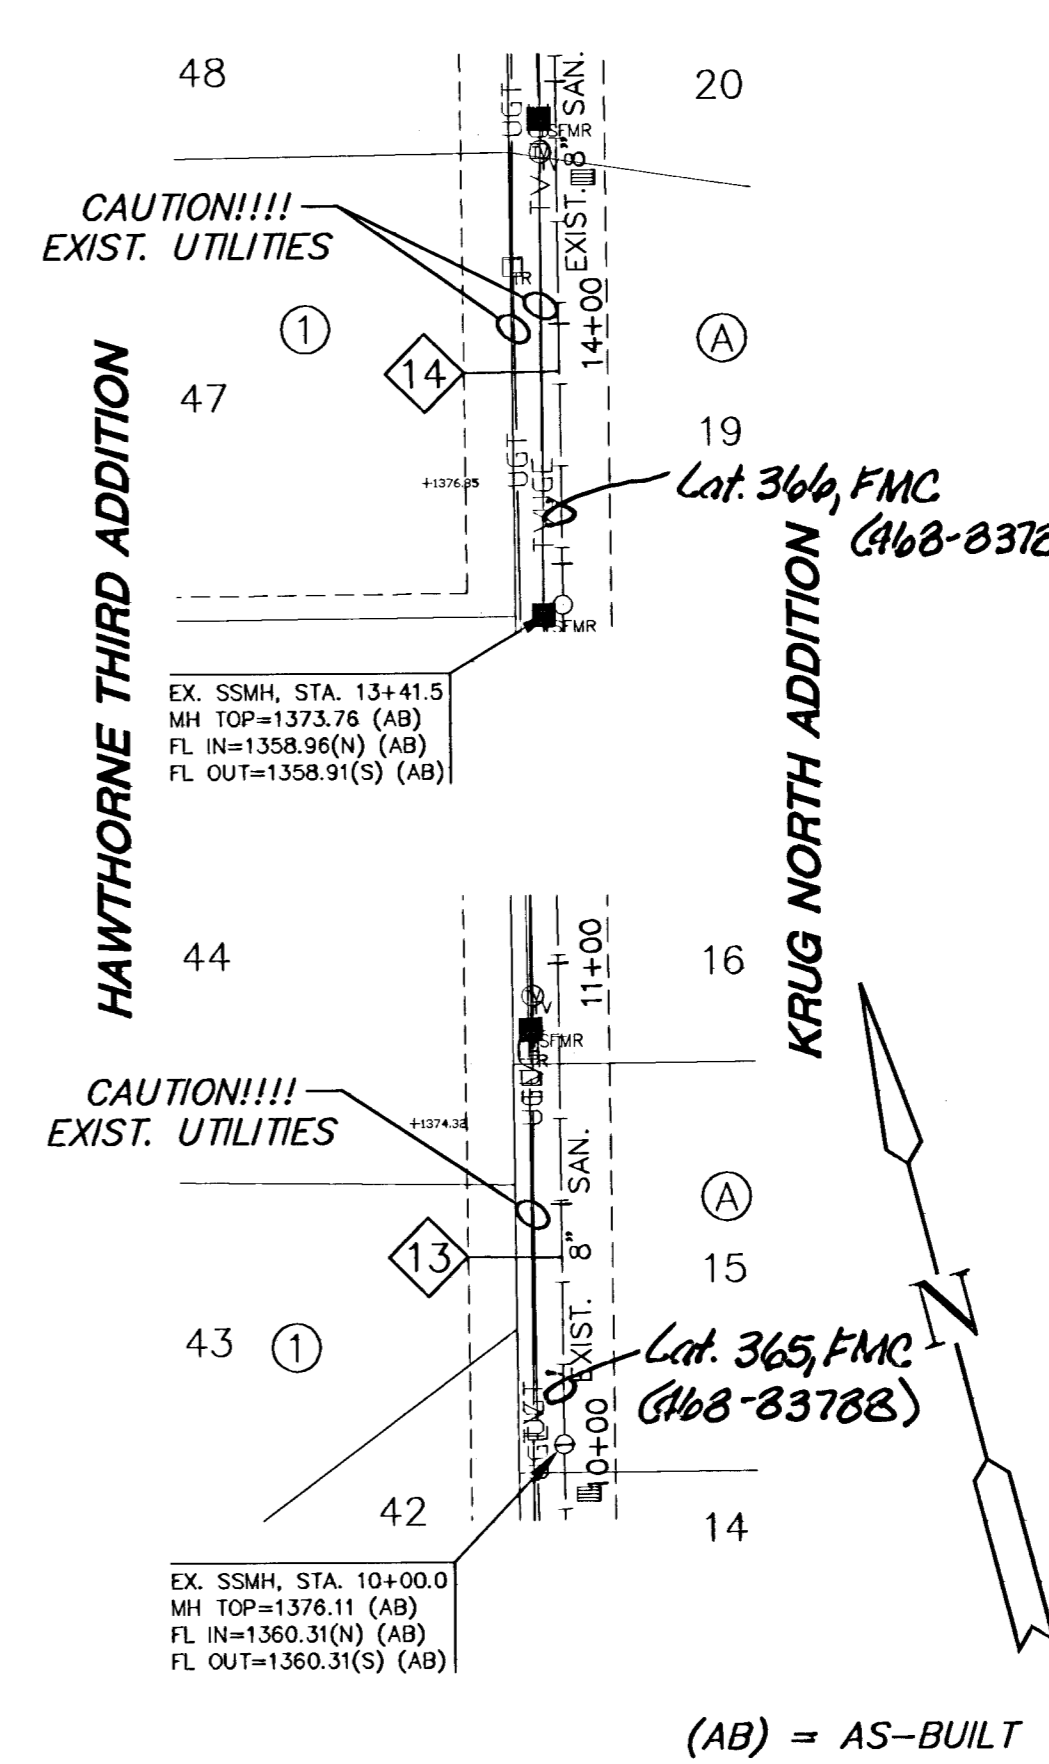

NOTES:
CONTRACTOR TO VERIFY THE DEPTH AND LOCATION OF EXISTING UTILITIES PRIOR TO CONSTRUCTION.
TRENCHES TO BE BACKFILLED WITH SAND AND FLUSHED WHEN SEWER LINE RUNS ALONG FRONT OF LOTS.

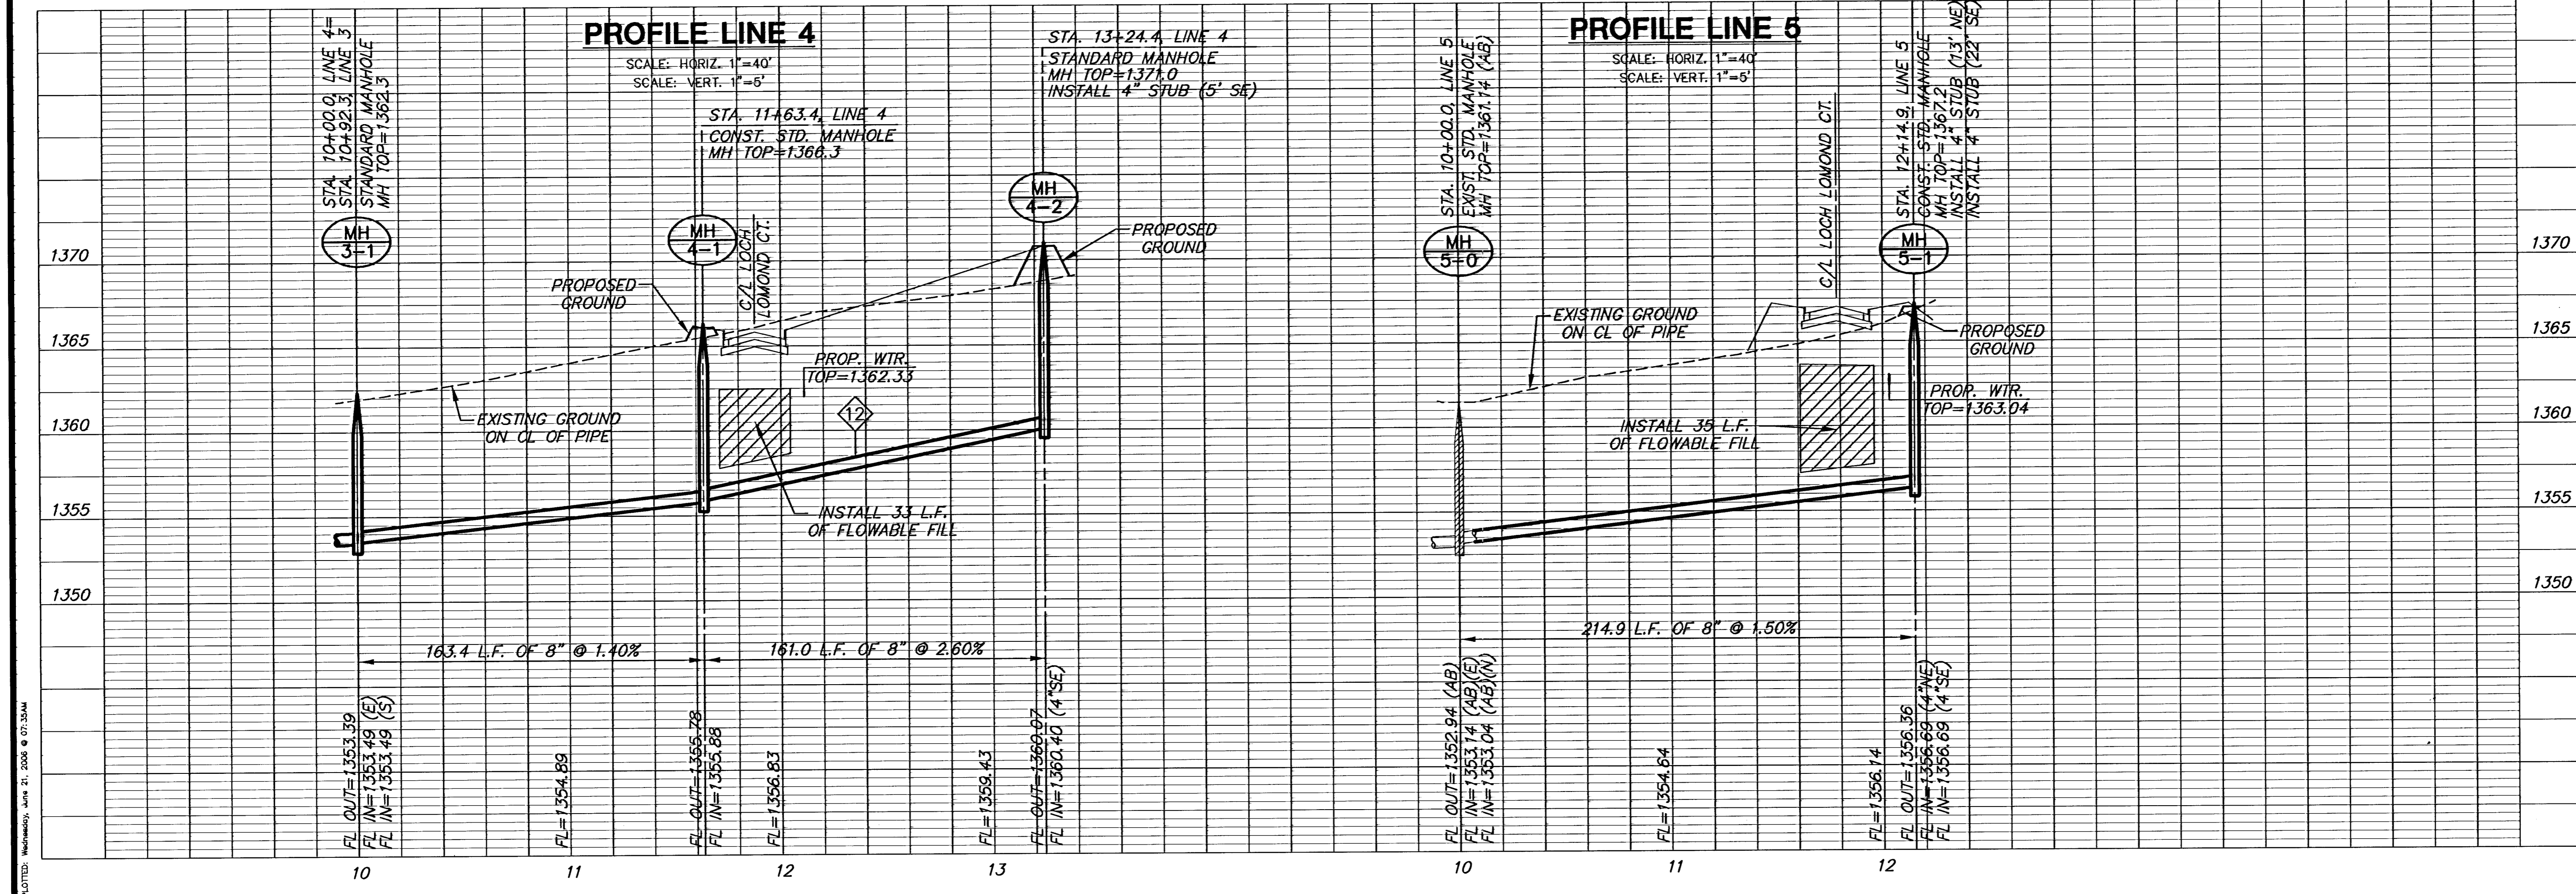

PLOTTED: Wednesday, June 21, 2006 @ 07:35AM

H:\DWG\02167.DWG User: Jrg Add:\p4\02167_03