

SANITARY SEWER IMPROVEMENTS TO SERVE LATERAL 149, MAIN 4, SANITARY SEWER # 23 CITY OF WICHITA PROJECT NUMBER 468-84061 CITY OF WICHITA, KANSAS OCA 744157 Jim Armour, P.E., City Engineer

INDEX OF SHEETS

- 1 Cover Sheet
- 2 Plan and Profile SS
- 3 Clean Out Detail
- 4 Type P Manhole Detail

GENERAL NOTES

1. Contractor will be required to provide notice to utility companies a minimum of twenty-four (24) hours prior to any excavation, as follows:



Kansas One-Call	687-2470
-----------------	----------

The Contractor must notify the following in case of an emergency:

Cablevision	262-4270
or	263-2061
Westar Energy	383-8650
	383-8600


Southwestern Bell Telephone Company	1-571-2611
City of Wichita Water Department	268-4908
City of Wichita Sewer Department	268-4071
Kansas Gas Service	832-3168
or	832-3167
2. Exist. utilities and their locations, as shown on the plans, represent the best information obtainable for design. Location information has been obtained from the various utility companies and is either from company record drawings or company-provided field locations. The Contractor will be required to work around existing utilities which do not conflict with proposed construction.
3. The Contractor to verify utility locations prior to construction of this project.
4. Utility service and installation shall be coordinated with the respective utility owners. Contacts are:

Kansas Gas Service	Jim Coe	832-3126
Westar Energy	Miles Copps	261-6824
Wichita Water	Paul Bryant	268-4555
	Steve Palmer	268-4908
Southwestern Bell	Jim Toben	268-2759
Multimedia Cablevision	Mark Anaya	262-4270
5. All lawn/turf areas disturbed by construction of proposed improvements shall be restored with seed. All seeding work shall be in accordance with the City of Wichita standard specifications and the City of Wichita administrative regulation No. AR78 which governs cleanup and replacement following construction. All costs for this work shall be subsidiary to the lump sum price bid for "Site Restoration."
6. Traffic affected by the construction of this project shall be handled in accordance with the latest edition of the Manual on Uniform Traffic Control Devices.
7. Properties within the project may have underground irrigation systems (lawn sprinklers) which conflict with the new construction. Contractor shall remove such components as needed during construction of the project. The irrigation system shall be reinstalled in like kind before project completion. Any irrigation system modifications required because of project improvements shall be coordinated with the property owner. Portions of underground irrigation systems not in conflict with construction shall be protected from damage and shall remain in place. All work related to underground irrigation/sprinklers shall be subsidiary to Site Restoration.

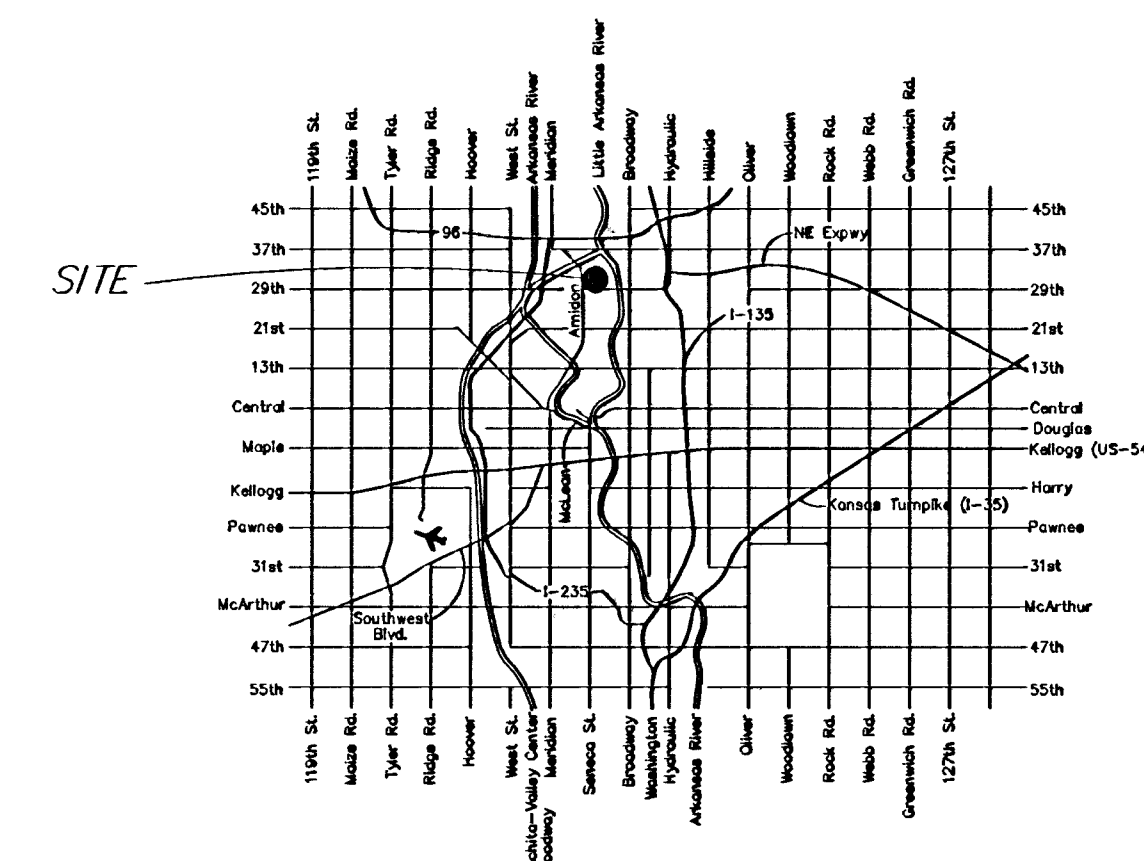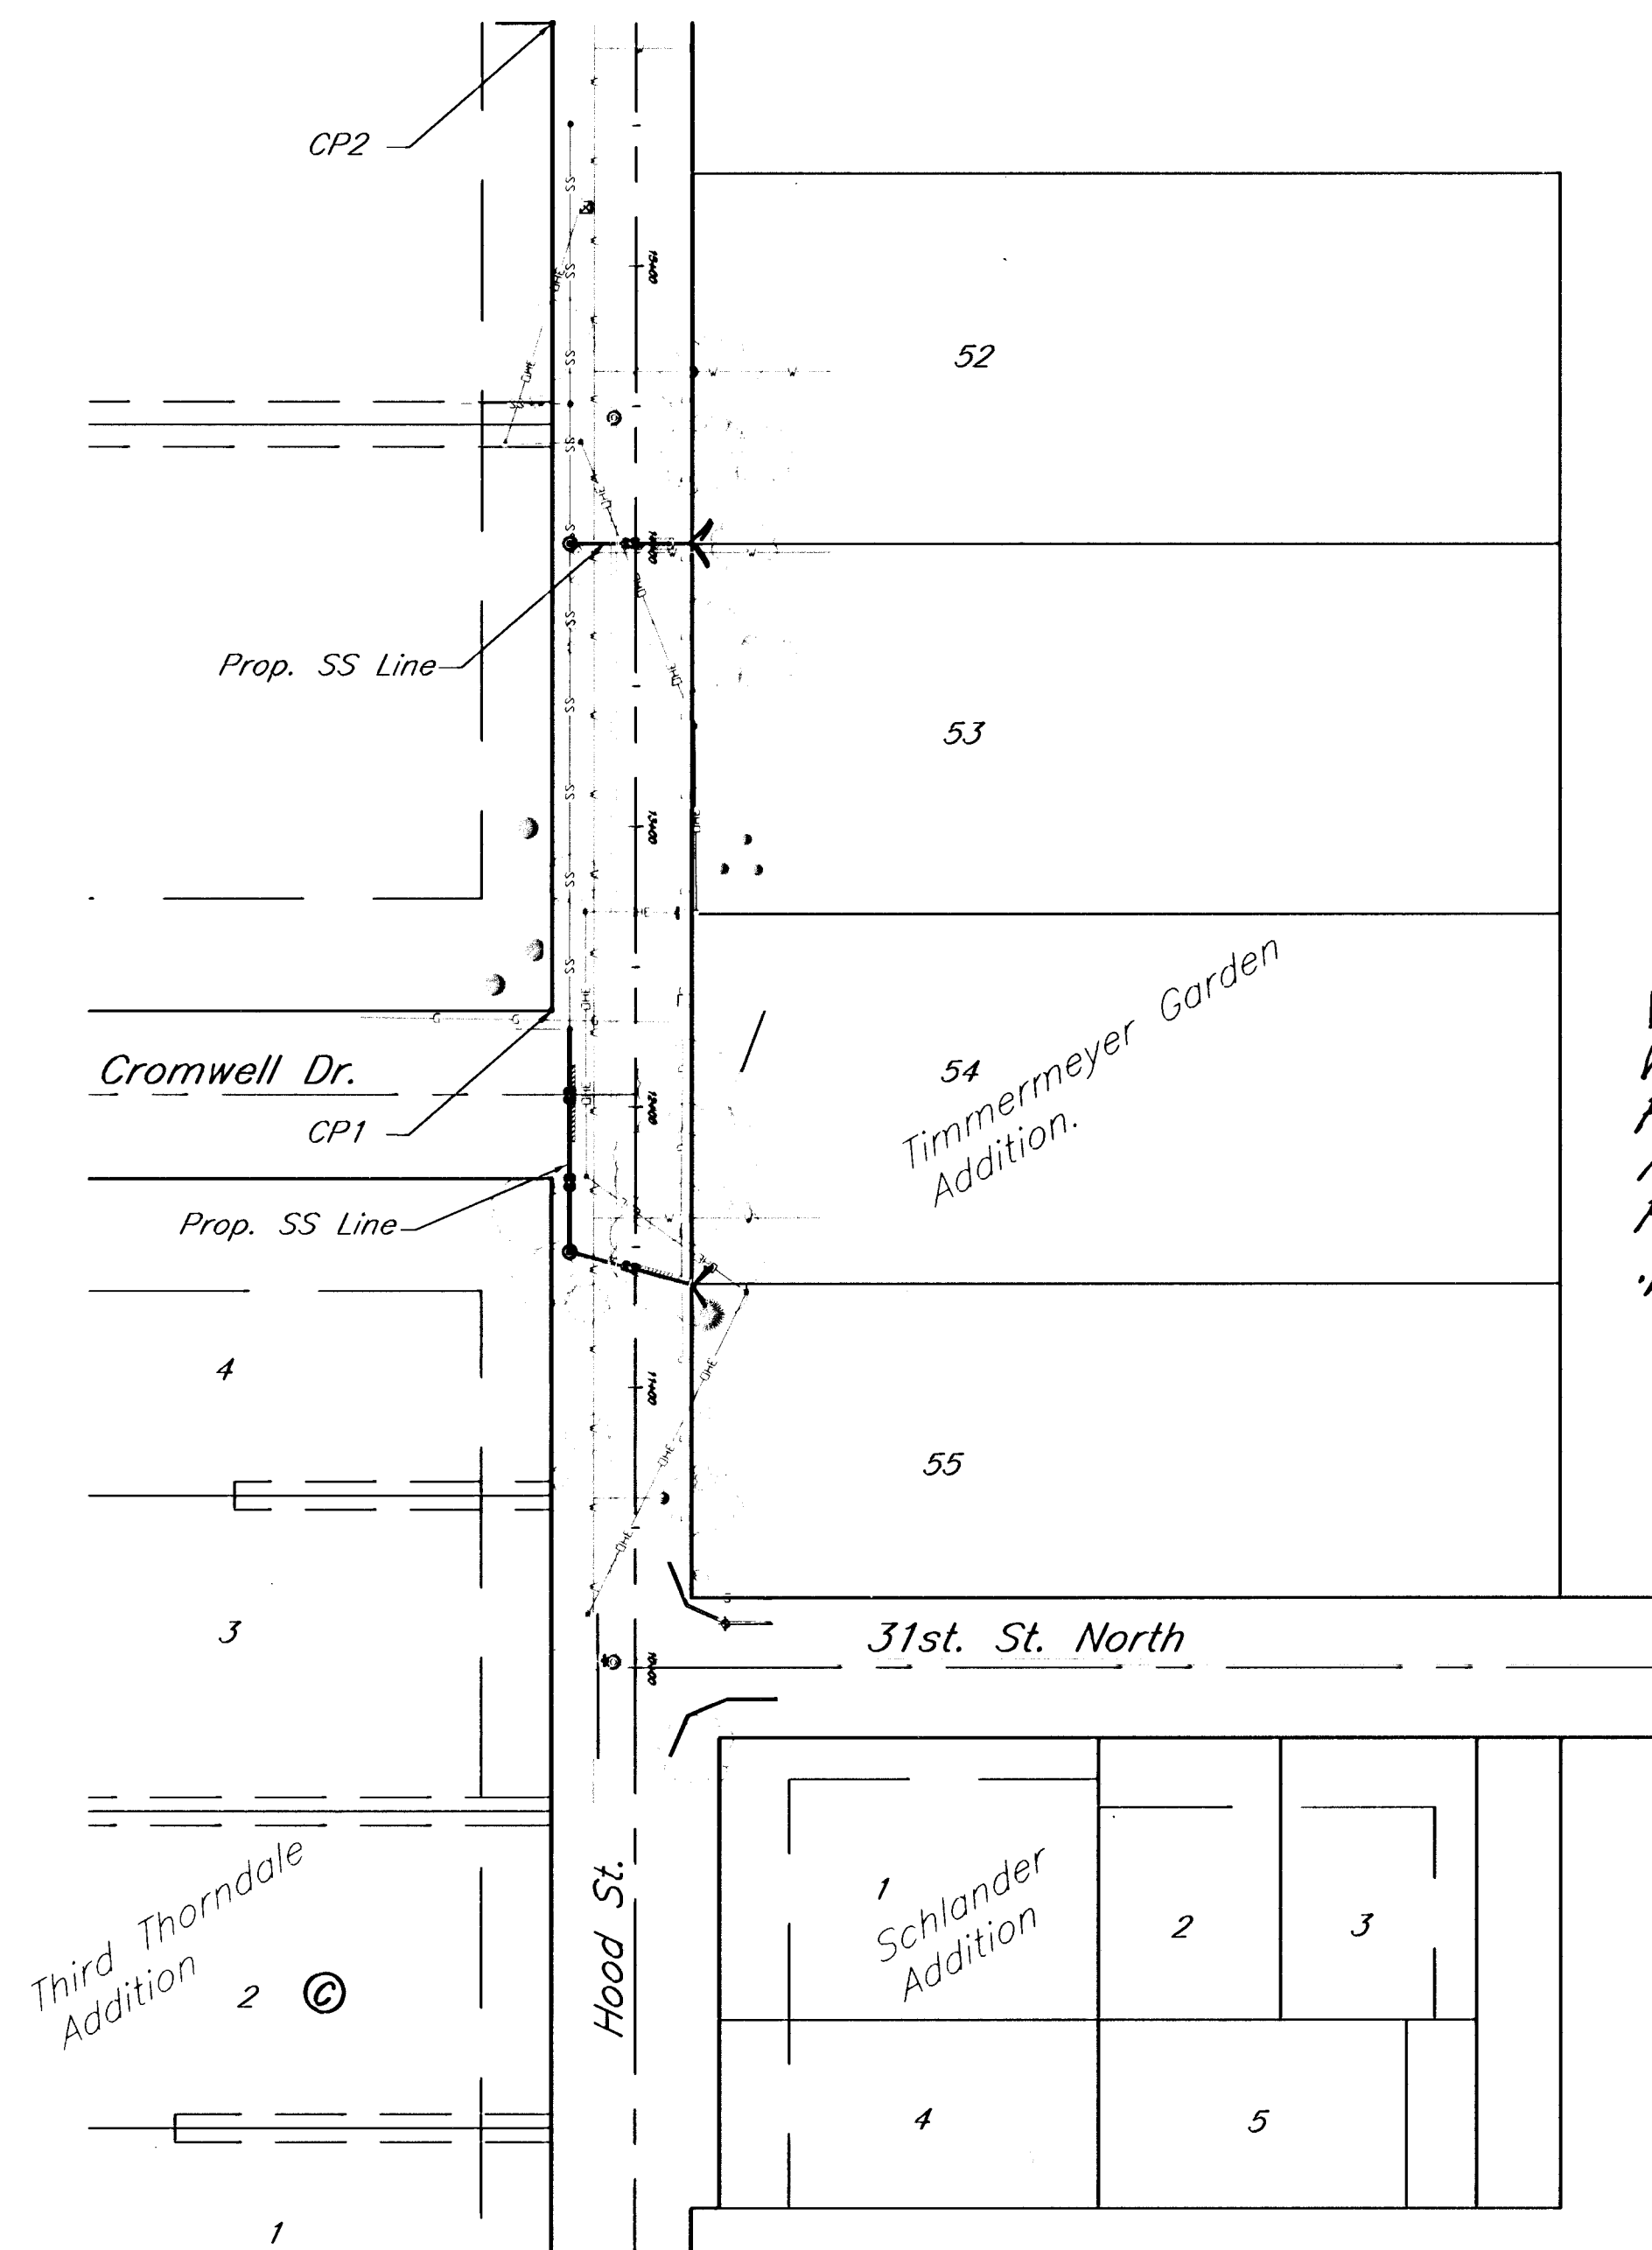

WB Carter Construction Co., Inc. - Contractor
 Weigant, City - Inspector
 Released 2/18/07
 As-Built
 Risers
 .pdf by JDL 4/14/07

Baseline 10+00
 Intersection of
 31st St. North
 and Hood St.
 Benchmark:
 "□" cut on North
 Return at 31st St.
 Hood St.
 Elev. = 129.39
 Control Points
 CP1:
 Bl. Sta 13+34.52 30.22'lt.
 NW Corn. IP, Cromwell Dr.
 & Hood.
 N=5,259.37 E=4,974.82
 CP2:
 Bl. Sta 15+86.62 30.00'lt.
 SW Corn. IP, Hood Ct.
 & Hood.
 N=5,611.47 E=4,975.17

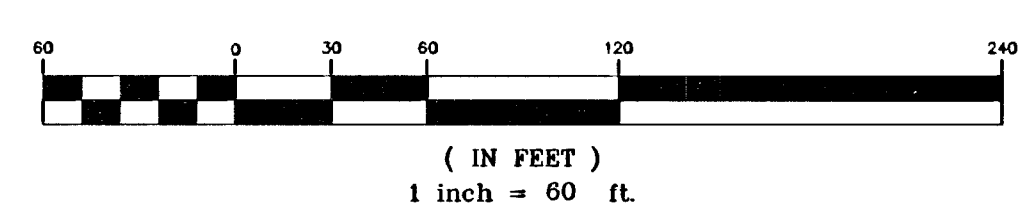

September 2006

kemiller

engineering

516 S. Market,
Wichita, KS 67202

316/264-0242