


SANITARY SEWER PLANS  
**REED'S COVE**  
**FOURTH ADDITION**

**LINES 2 & 5**  
SHEET TITLE  
448-00000  
PROJECT NUMBER

DESIGN BY SRS  
DRAWN BY DM  
CHECKED BY GJA


ISSUED FEBRUARY 2006  
REVISED

SHEET NO.  
4 of 11

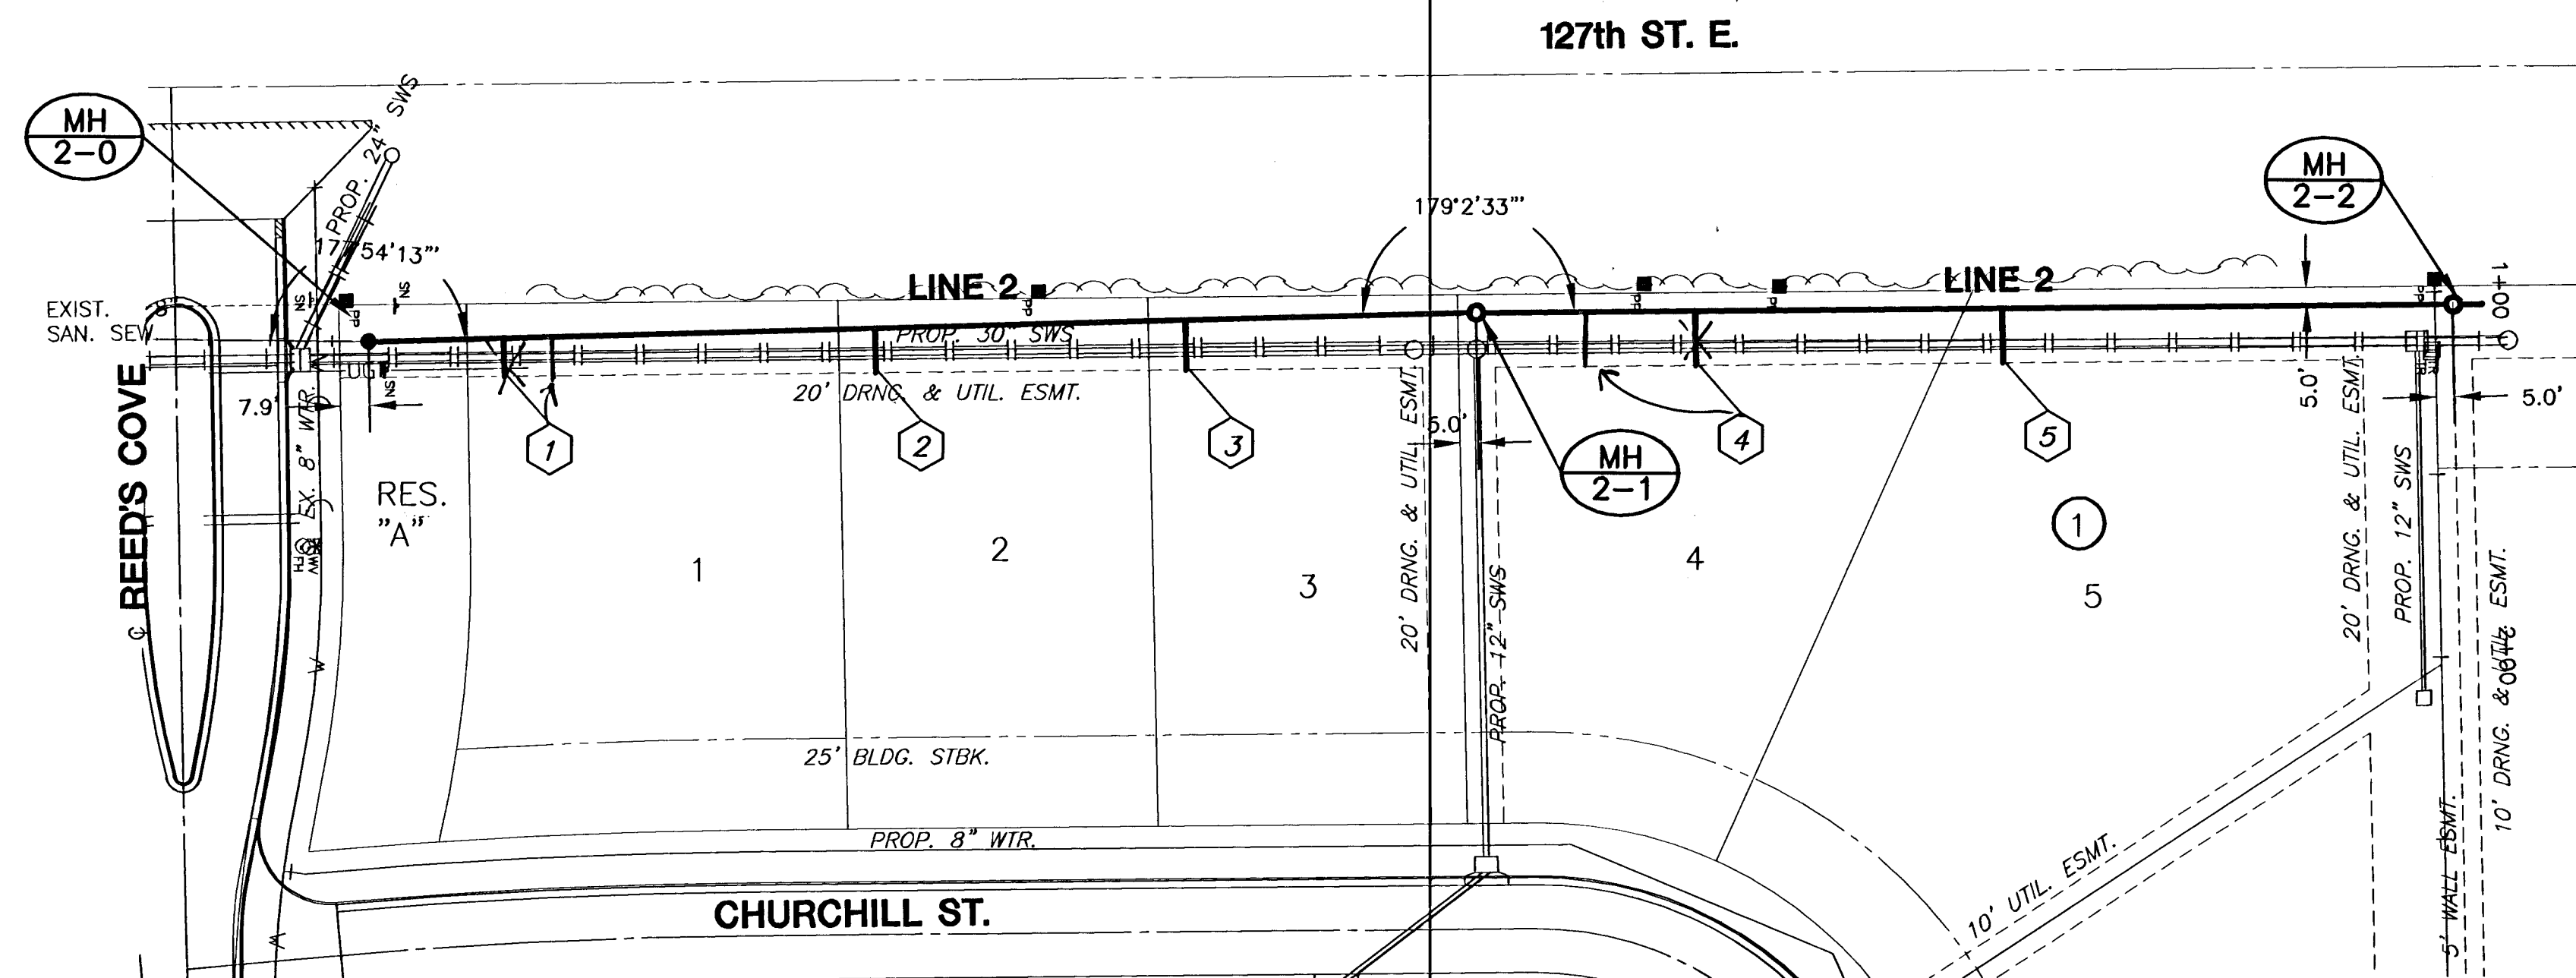

REEDS COVE 4TH ADDITION


PLAN LINE 2

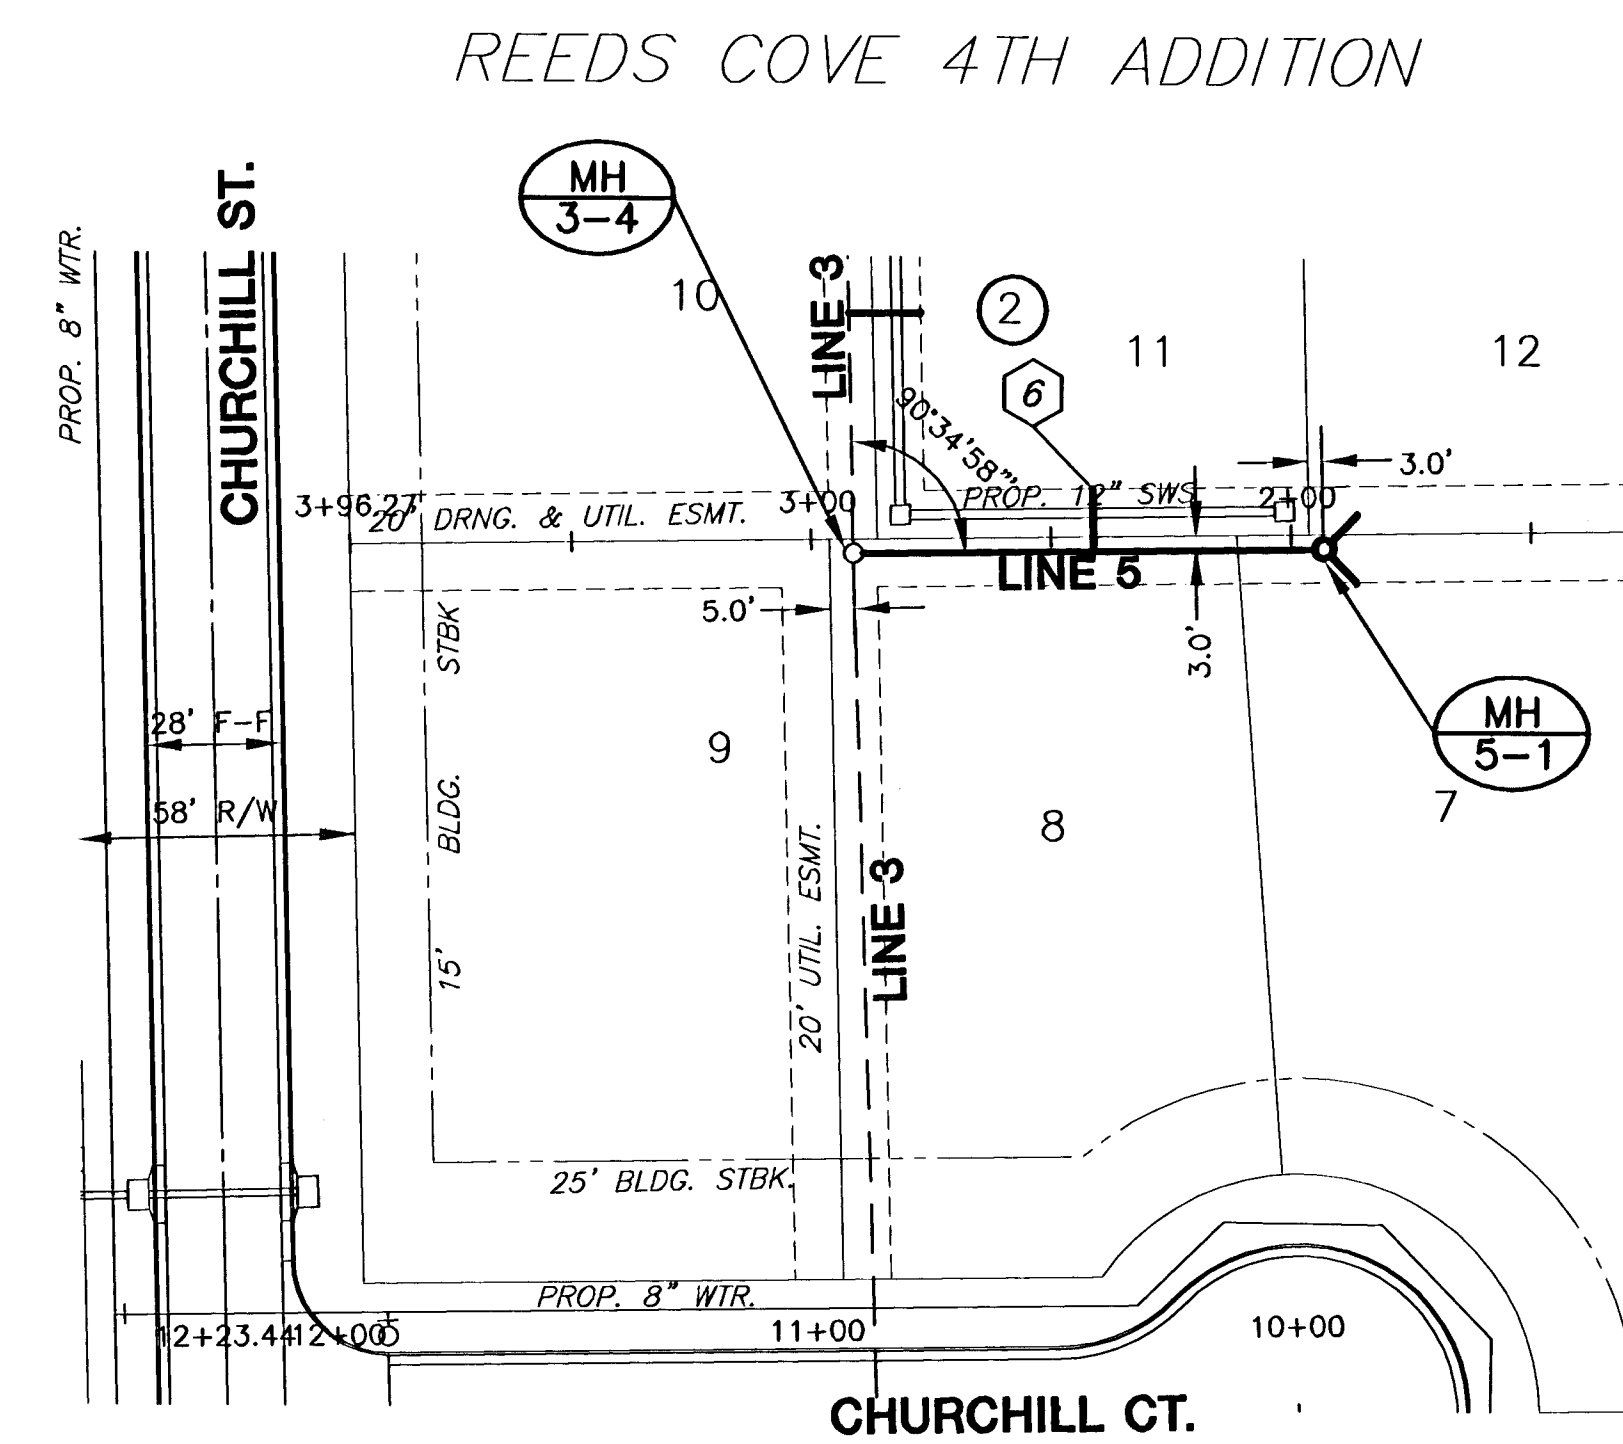

REEDS COVE 4TH ADDITION

PLAN LINE 5

NOTE:  
SEE SHEET 7 FOR  
RISER TABLE.

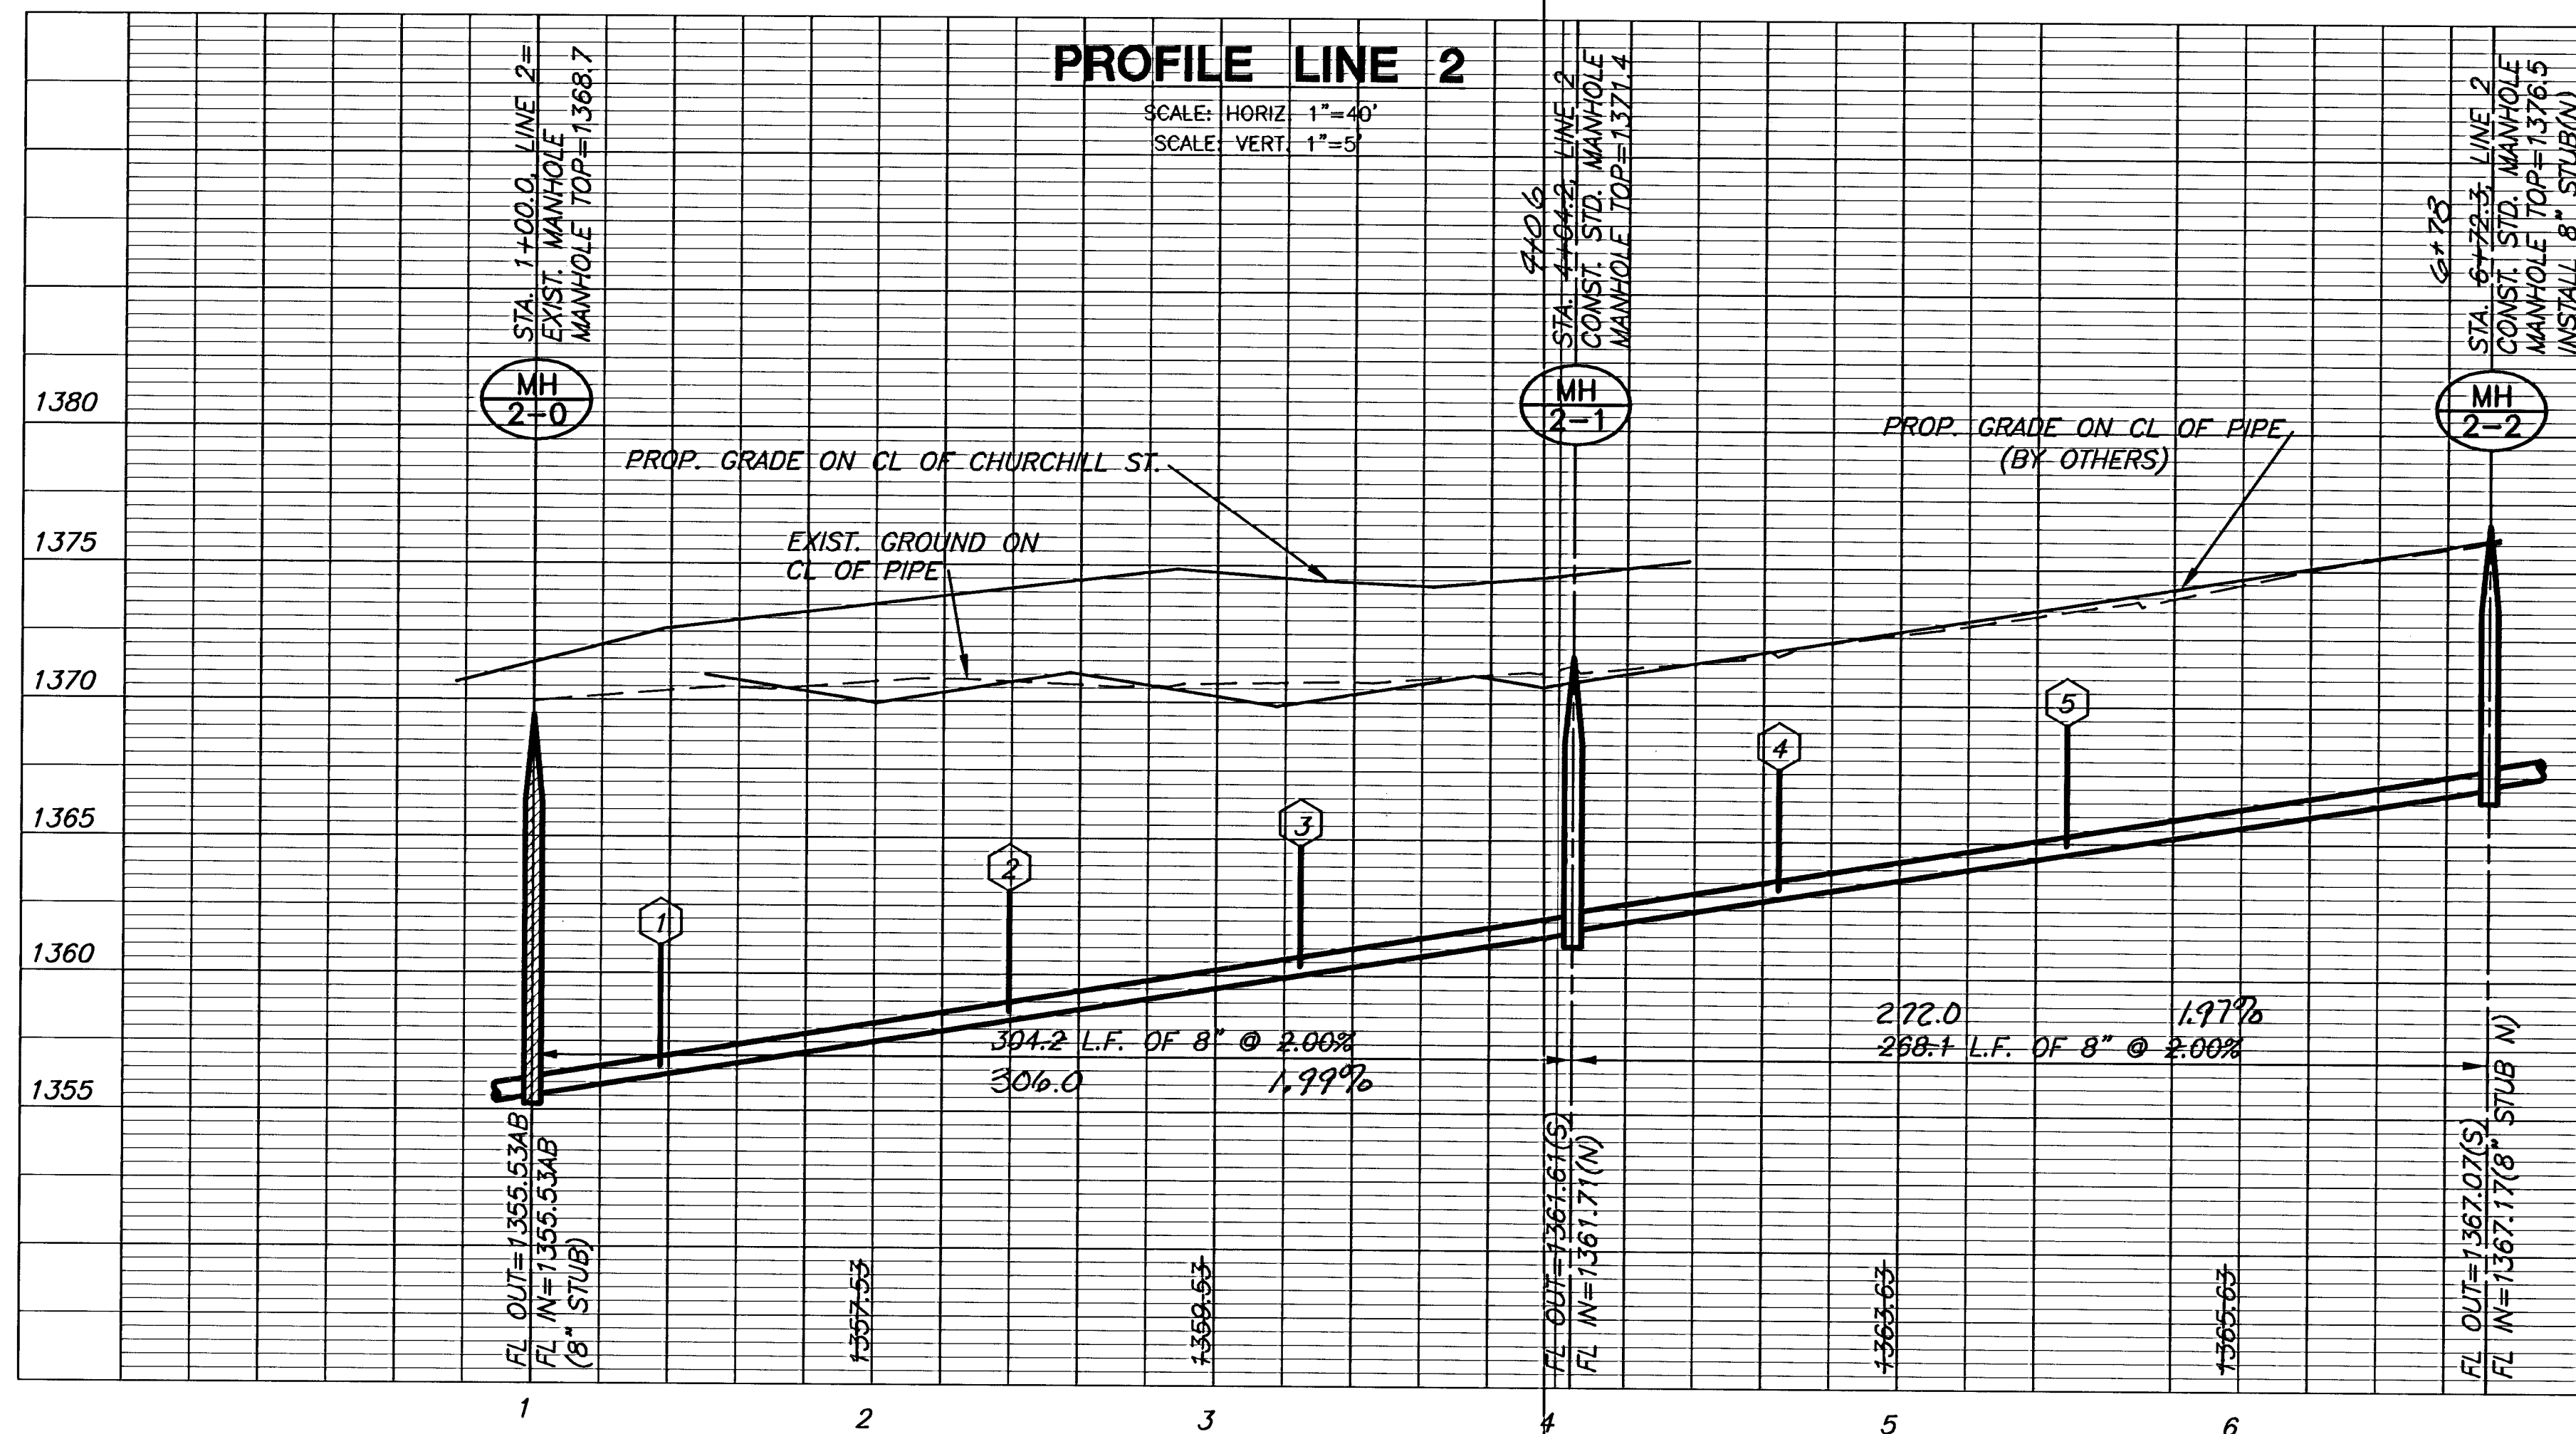

PROFILE LINE 5

