

SANITARY SEWER EXTENSION LATERAL 2, MAIN 18, FOUR MILE CREEK CASA BELLA ADDITION PROJECT NO. 468-84072 OCA # 744165

GENERAL NOTES

Contractor will be required to provide a minimum advance notice of forty-eight (48) hours to utility companies prior to starting any excavation as follows:

Kansas One-Call	687-2470
Cox Communications	262-0661
Kansas Gas Service	383-8600
Westar	383-8600
Aquila	1-800-303-0357
SBC	1-800-286-8313
City of Wichita Water Department	262-6000
City of Wichita Sewer Maintenance	262-6000


Underground utility service lines and overhead utility pole lines are to be adjusted as necessary by others prior to construction unless the plans specifically call for their adjustment by the Contractor or unless the plans specifically identify a utility to be adjusted by its owner during construction. Existing utilities and their location, as shown on the plans, represent the best information obtainable for design. Location information has been obtained from the various utility companies and is either from company record drawings or company-provided field locations. The Contractor will be required to work around existing utilities within the right-of-way which do not conflict with proposed construction.

Rubble from the removal of miscellaneous structures and excess excavation which is to be wasted shall be disposed of on sites to be provided by the Contractor. These sites shall be approved by the Engineer as to suitability, appearance and site location. Locations that, in the opinion of the Engineer, will leave an unsightly appearance will not be approved.

All disposal sites must be approved by the Kansas Department of Health and Environment. Material either stockpiled or disposed of in a flood plain would require a Kansas State Board of Agriculture permit. Any material dumped in waters of the United States or wetlands is subject to U.S. Corps permitting regulations. Any material buried or stockpiled beyond approved of Engineers construction limits would require additional archeological investigations unless buried in a previously approved borrow location.

The Contractor shall give all property owners and/or tenants of developed property directly abutting the construction of this project a minimum of ten (10) days advance notice prior to start of construction.

McCullough Excavation, Inc. - Contractor
Wood, City - Inspector
Released 7/12/06
As-Built
Risers & Stub
.pdf by JDL 11/6/06

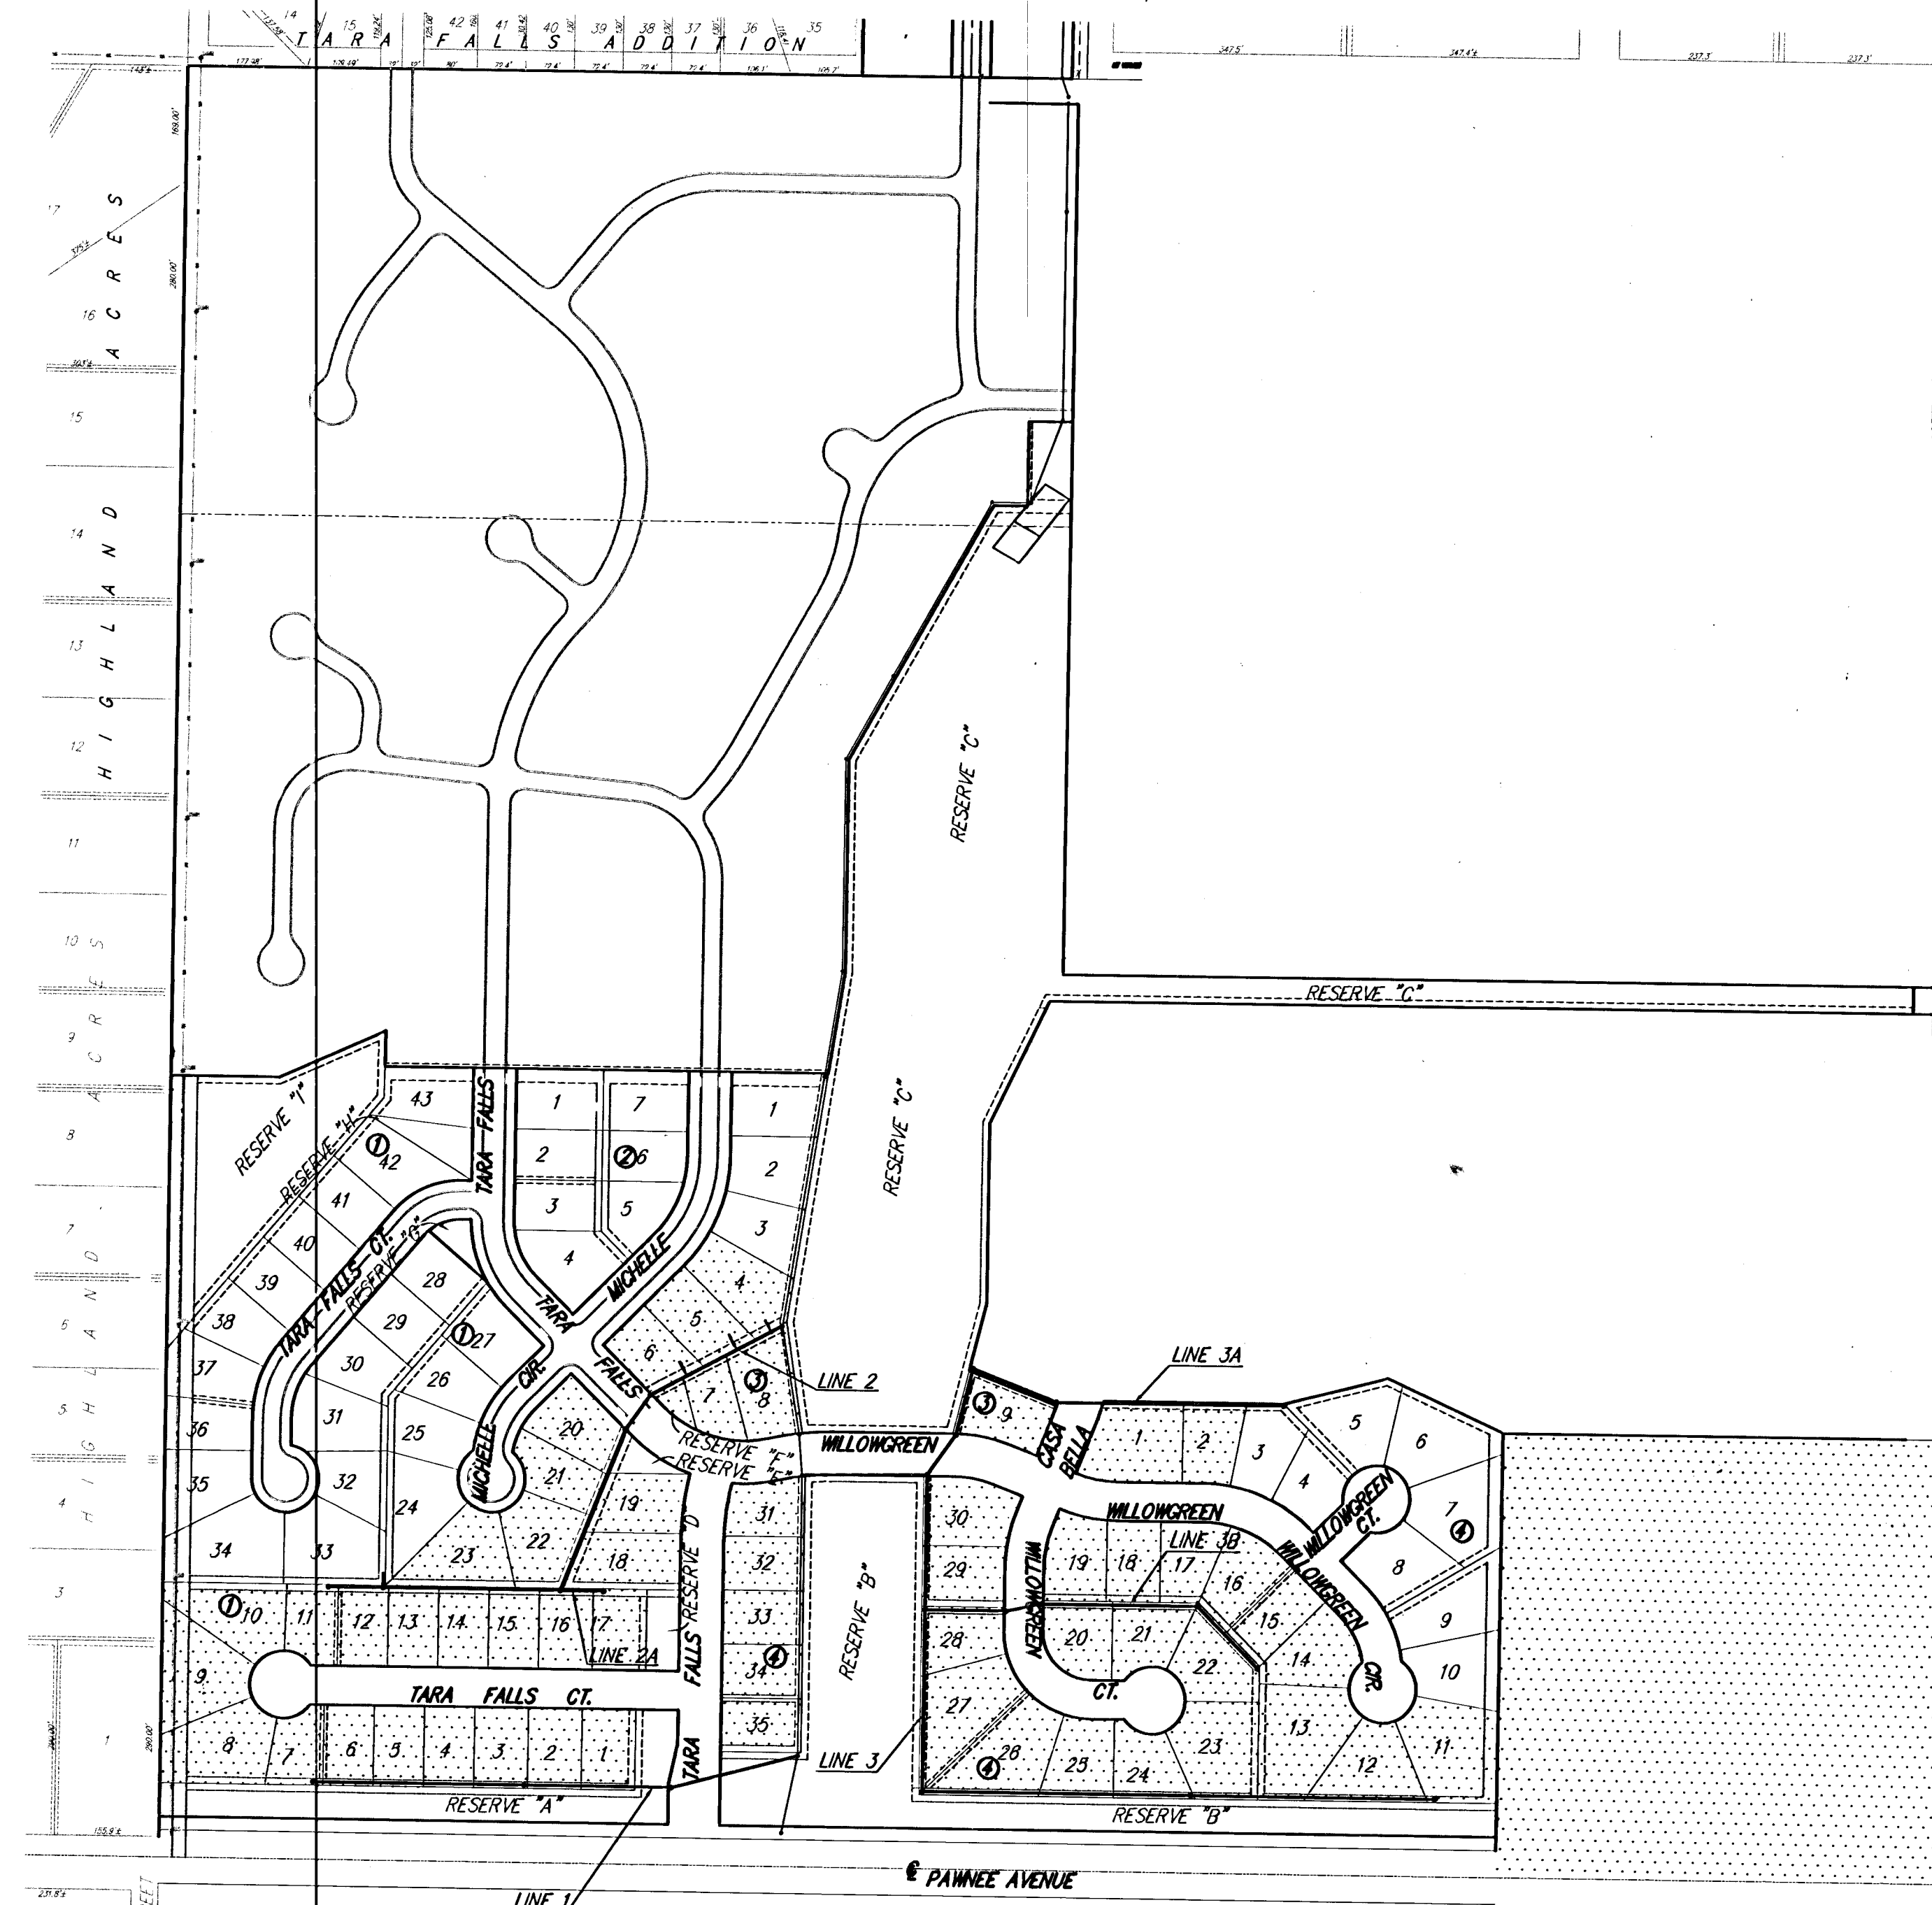

BENCH MARKS


BENCHMARK #1 SRB BRASS DISC 55.45' E. & 5.13' S. OF THE N.W. COR. SW1/4, SEC. 35, 127S, R2E. ELEV.=1348.35 (NGVD) = 160.95 (CITY DATUM)

INDEX OF SHEETS

1. TITLE SHEET
- 2-6. SANITARY SEWER PLAN/PROFILE
7. TYPE 'P' MANHOLE DETAIL
8. MANHOLE RING & COVER DETAIL
9. RISER DETAILS
10. EROSION CONTROL PLAN
11. EROSION BMP'S
- 12-13. EASEMENT GRADING
14. KEY MAP
15. FINAL PLAT



Scale: 1" = 200'

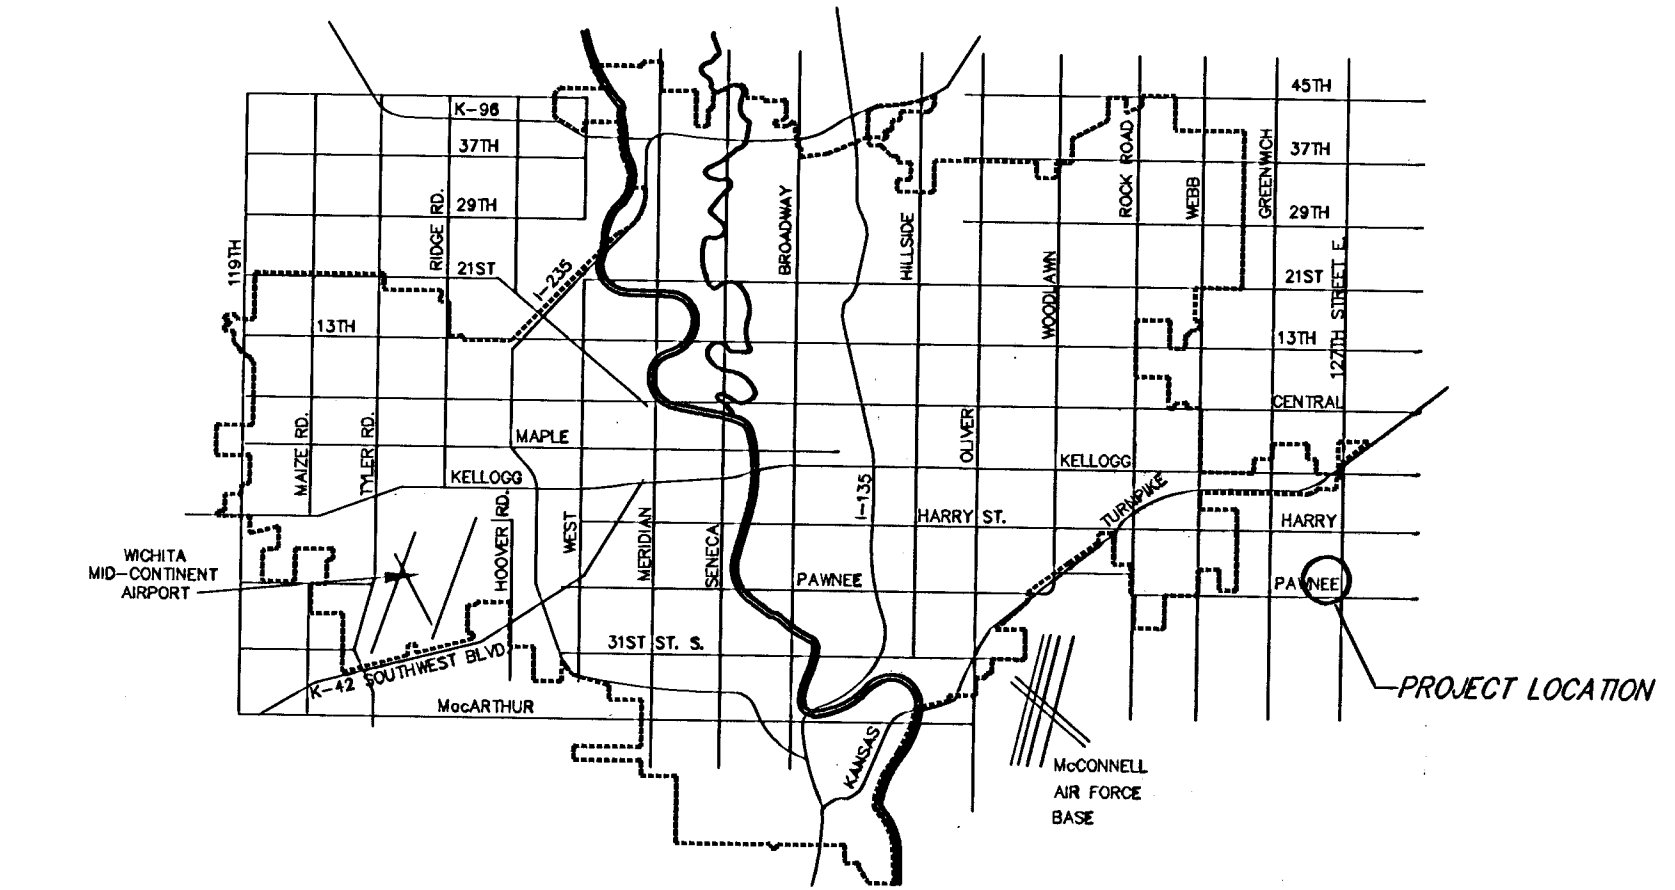


VICINITY MAP

BENEFIT DISTRICT



CITY OF WICHITA, KANSAS
JAMES L. ARMOUR, P.E. - CITY ENGINEER

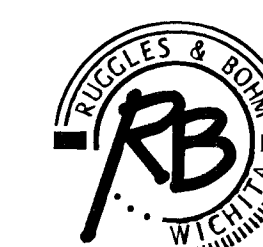

Ruggles & Bohm, P.A.
Engineering, Surveying, Land Planning
924 North Main
Wichita, Kansas 67203
www.rbkansas.com
(316) 264-8008
(316) 264-4621 fax
E-mail: info@rbkansas.com

2779E