


BENCHMARKS


BM #1: Brass Plate on North
Hub Guard of R.C.B.C. 50' East of
NW Corner NE 1/2, Sec. 22, Twp.
26-S, R-1-E.
Elev. = 1371.83 (NGVD29)

BM #2: "□" cut on East Hub
Guard of R.C.B.C., 110' S. of the
SE Cor., SE 1/4, Sec. 22, Twp.
26-S, R-1-E.
Elev. = 1359.54 (NGVD29)

Scale: 1" = 40' Horizontal
1" = 5' Vertical
• = Iron

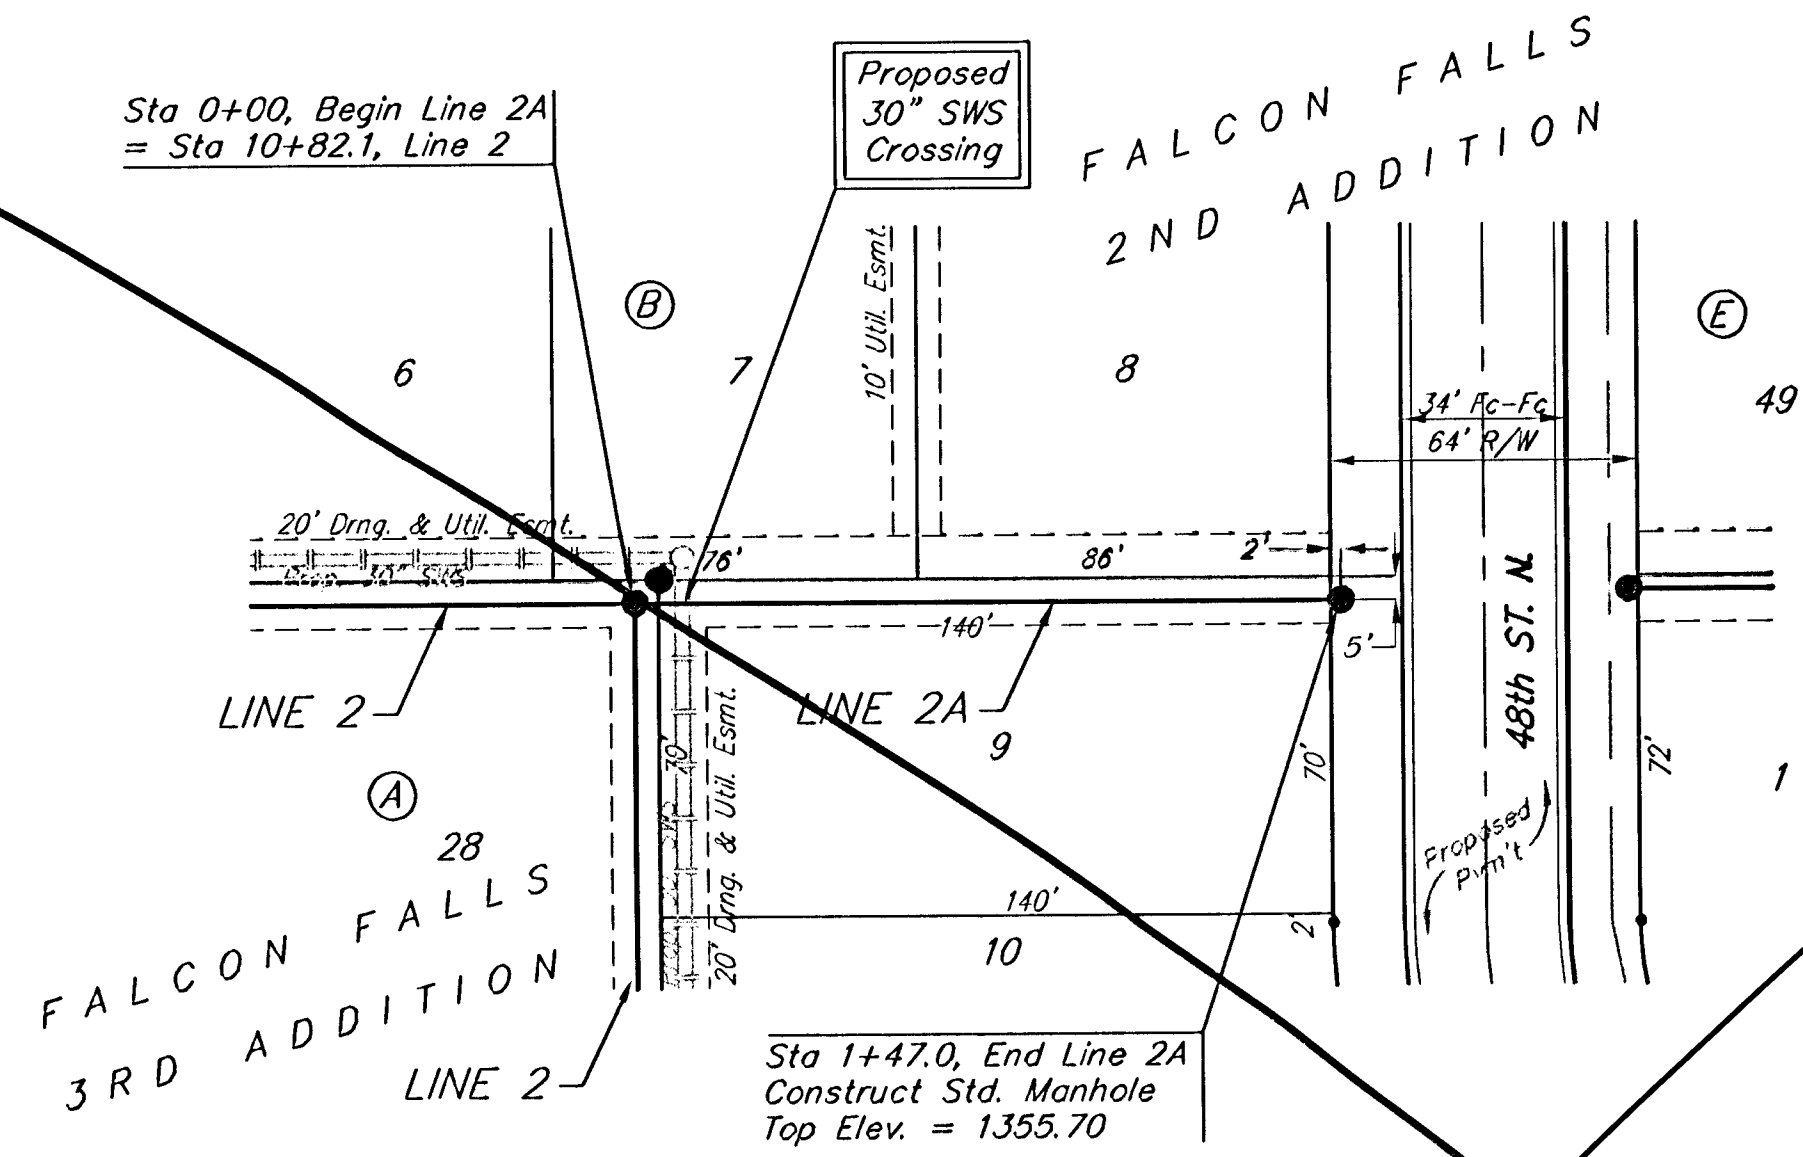

See Revised
Sheet

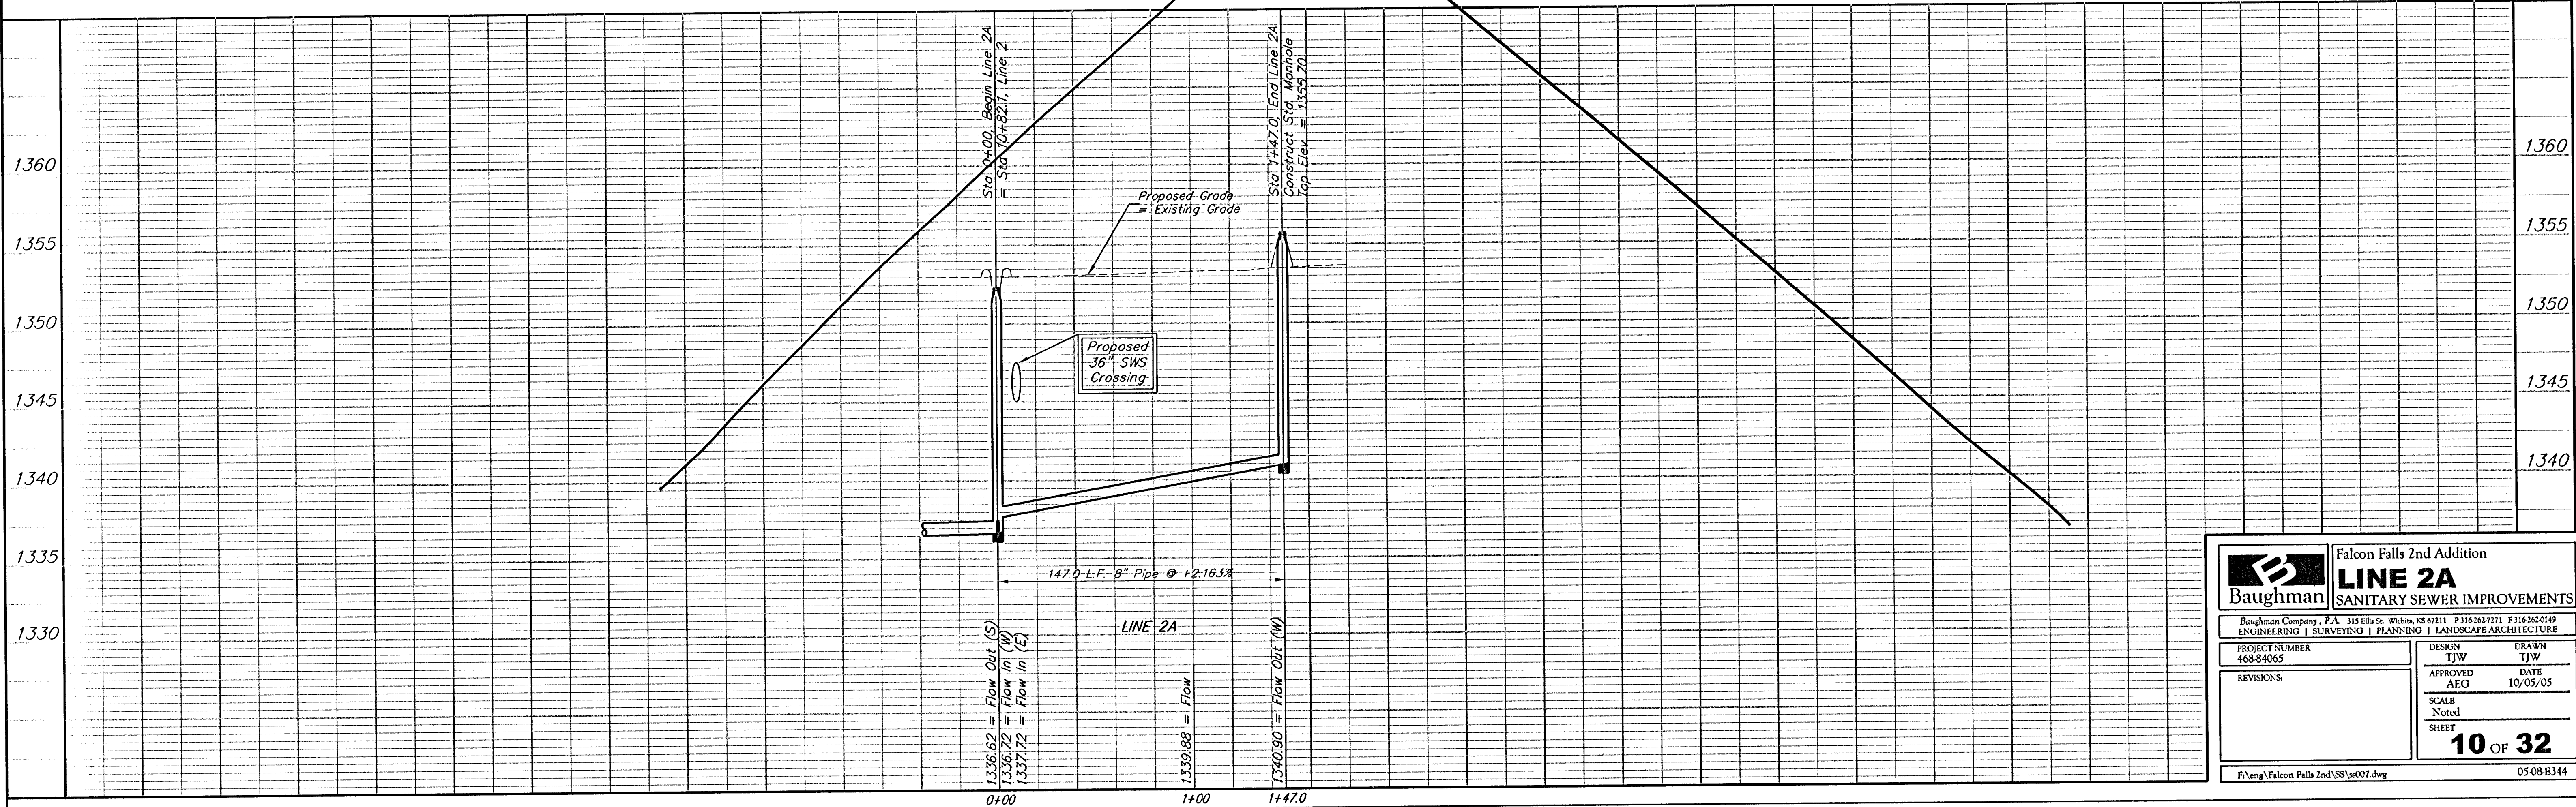

Baughman		Falcon Falls 2nd Addition	
		LINE 2A	
ENGINEERING SURVEYING PLANNING LANDSCAPE ARCHITECTURE		SANITARY SEWER IMPROVEMENTS	
PROJECT NUMBER 468-84065	DESIGN TJW	DRAWN TJW	
REVISIONS:	APPROVED AEG	DATE 10/05/05	
SCALE Noted		SHEET	
		10 OF 32	
F:\eng\Falcon Falls 2nd\SS\ss007.dwg		0508B344	