


# LATERAL 377 OF THE FOUR MILE CREEK SEWER IN THE CITY OF WICHITA

OCA NO. 744153  
CITY OF WICHITA PROJECT NO. 468-84050  
JAMES L. ARMOUR, P.E. - CITY ENGINEER

**INDEX OF SHEETS**

SHEET NO. 1	TITLE SHEET
SHEET NO. 2	KEY MAP AND GENERAL NOTES
SHEET NO. 3-4	PLATS
SHEET NO. 5	PROJECT COORDINATES
SHEET NO. 6	PLAN/PROFILE
SHEET NO. 7	TYPE "P" MANHOLE DETAILS
SHEET NO. 8	TYPE "P" SHALLOW MANHOLE DETAILS
SHEET NO. 9	FRAME & COVER DETAILS
SHEET NO. 10-13	SOIL EROSION BMP DETAILS

*WB Carter Construction Co, Inc. - Contractor  
Strothman, City Inspector  
Released 1/9/06  
As-Built  
Stubs  
.pdf by JDL 5/8/06*

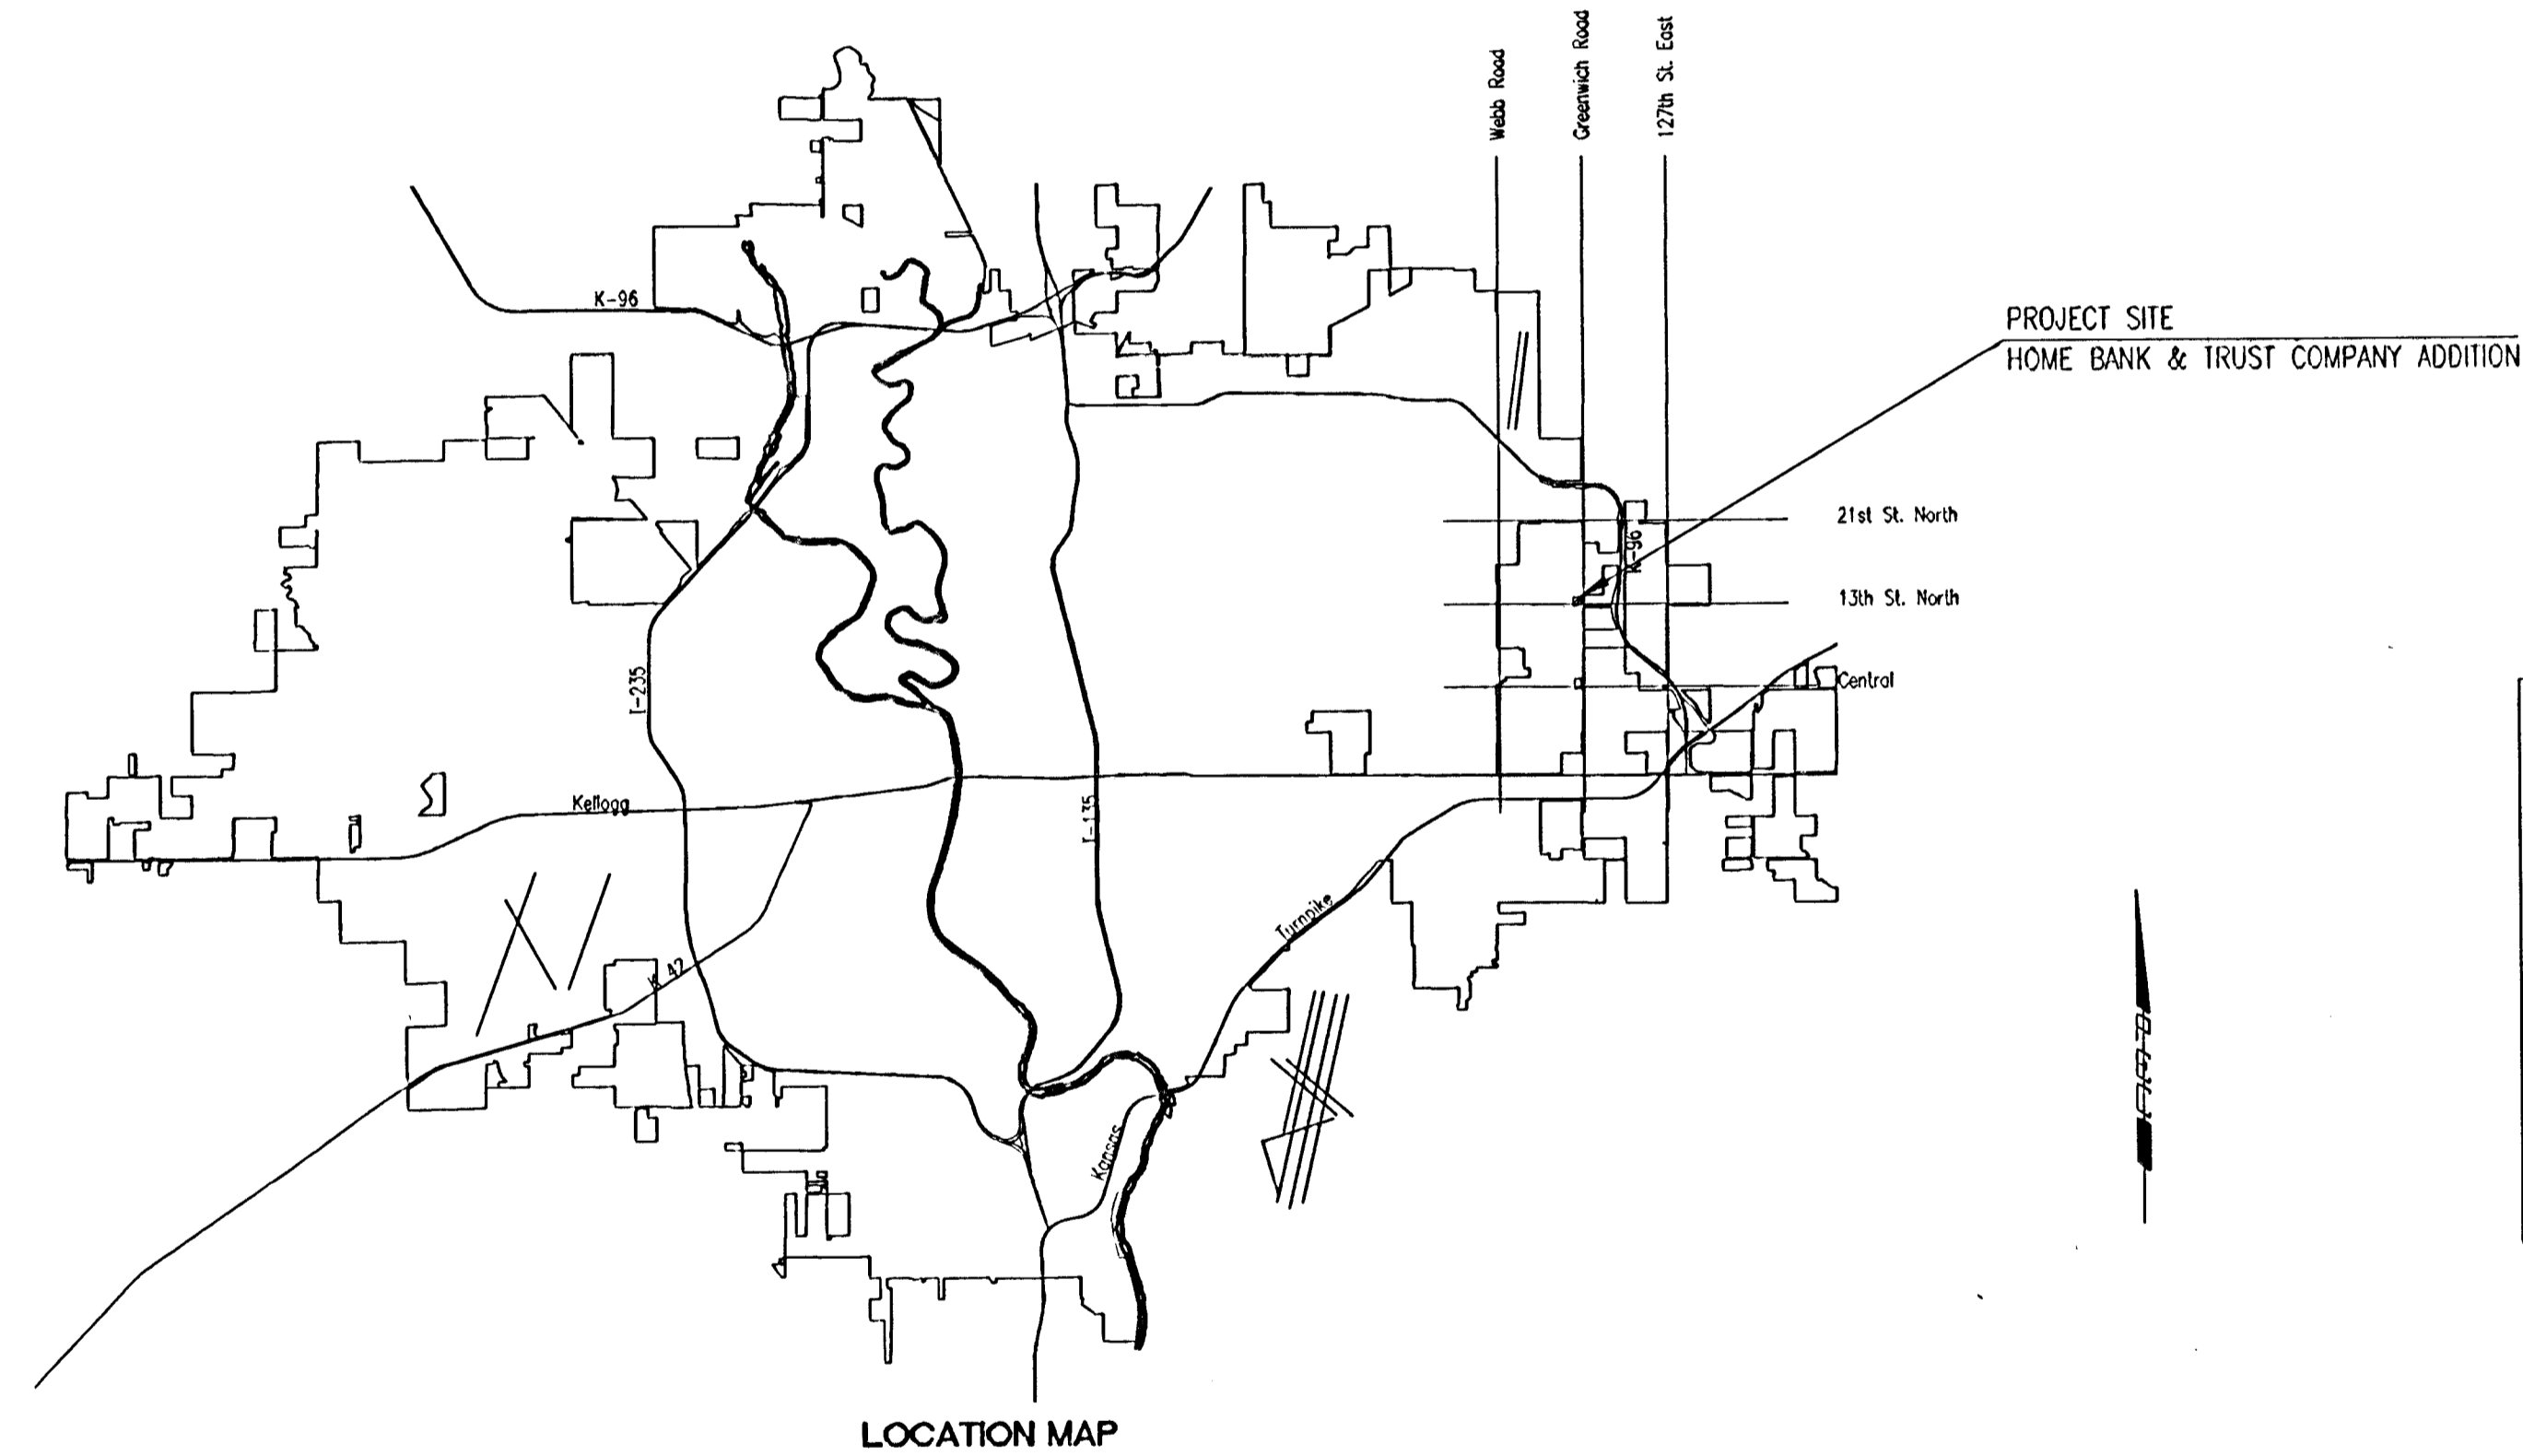

**CONSTRUCTION SCHEDULE/SEQUENCE**

THE CONTRACTOR FOR EACH OF THE FOLLOWING GATEWAY CENTER/KIZER WEST PROJECTS SHALL COORDINATE THEIR EFFORTS WITH OTHER CONTRACTORS PERFORMING WORK IN THIS AREA SUCH THAT ANY NECESSARY SIMULTANEOUS CONSTRUCTION CAN PROCEED CONCURRENTLY WITHOUT CAUSING UNDUE DELAYS SO THAT CONSTRUCTION CAN BE COMPLETED WITHIN THE TIME FRAMES AS NOTED.

**SANITARY SEWER (468-84050):**

THE CONSTRUCTION OF SANITARY SEWER LINE NO. 1 SHALL BE COMPLETED BY DECEMBER 16, 2005.

**OCTOBER 2005**  
PLANS PREPARED BY  
**PROFESSIONAL ENGINEERING CONSULTANTS, P.A.**  
ENGINEERS  
WICHITA, KANSAS

