

DATE
BY
CHECKED
CHECKED
PLAN

DATE
BY
CHECKED
CHECKED
PROFILE

DSNR: BLB OPER: BJS SCALE: 1"=20.00
 Q:\2005\05257\05257-C-SWSLINE 06-16-2005 12:10:29 am

POND #5
 ADDED CONTOUR LINES 135 & 136
 CHANGE ORDER #1 for OCA #765932

Pond #4
 Added contour lines
 135 & 136
 CHANGE ORDER #2



COORDINATE LIST

POINT	NORTH	EAST
100	11,760.3474	11,918.6807
101	11,730.6056	11,780.9167

100 = COORDINATE POINT NO.
 SEE SHEET NO. 3 FOR PLAT COORDINATES

See Special Provisions

James L. Armour
 02 01 06
RECORD DRAWING

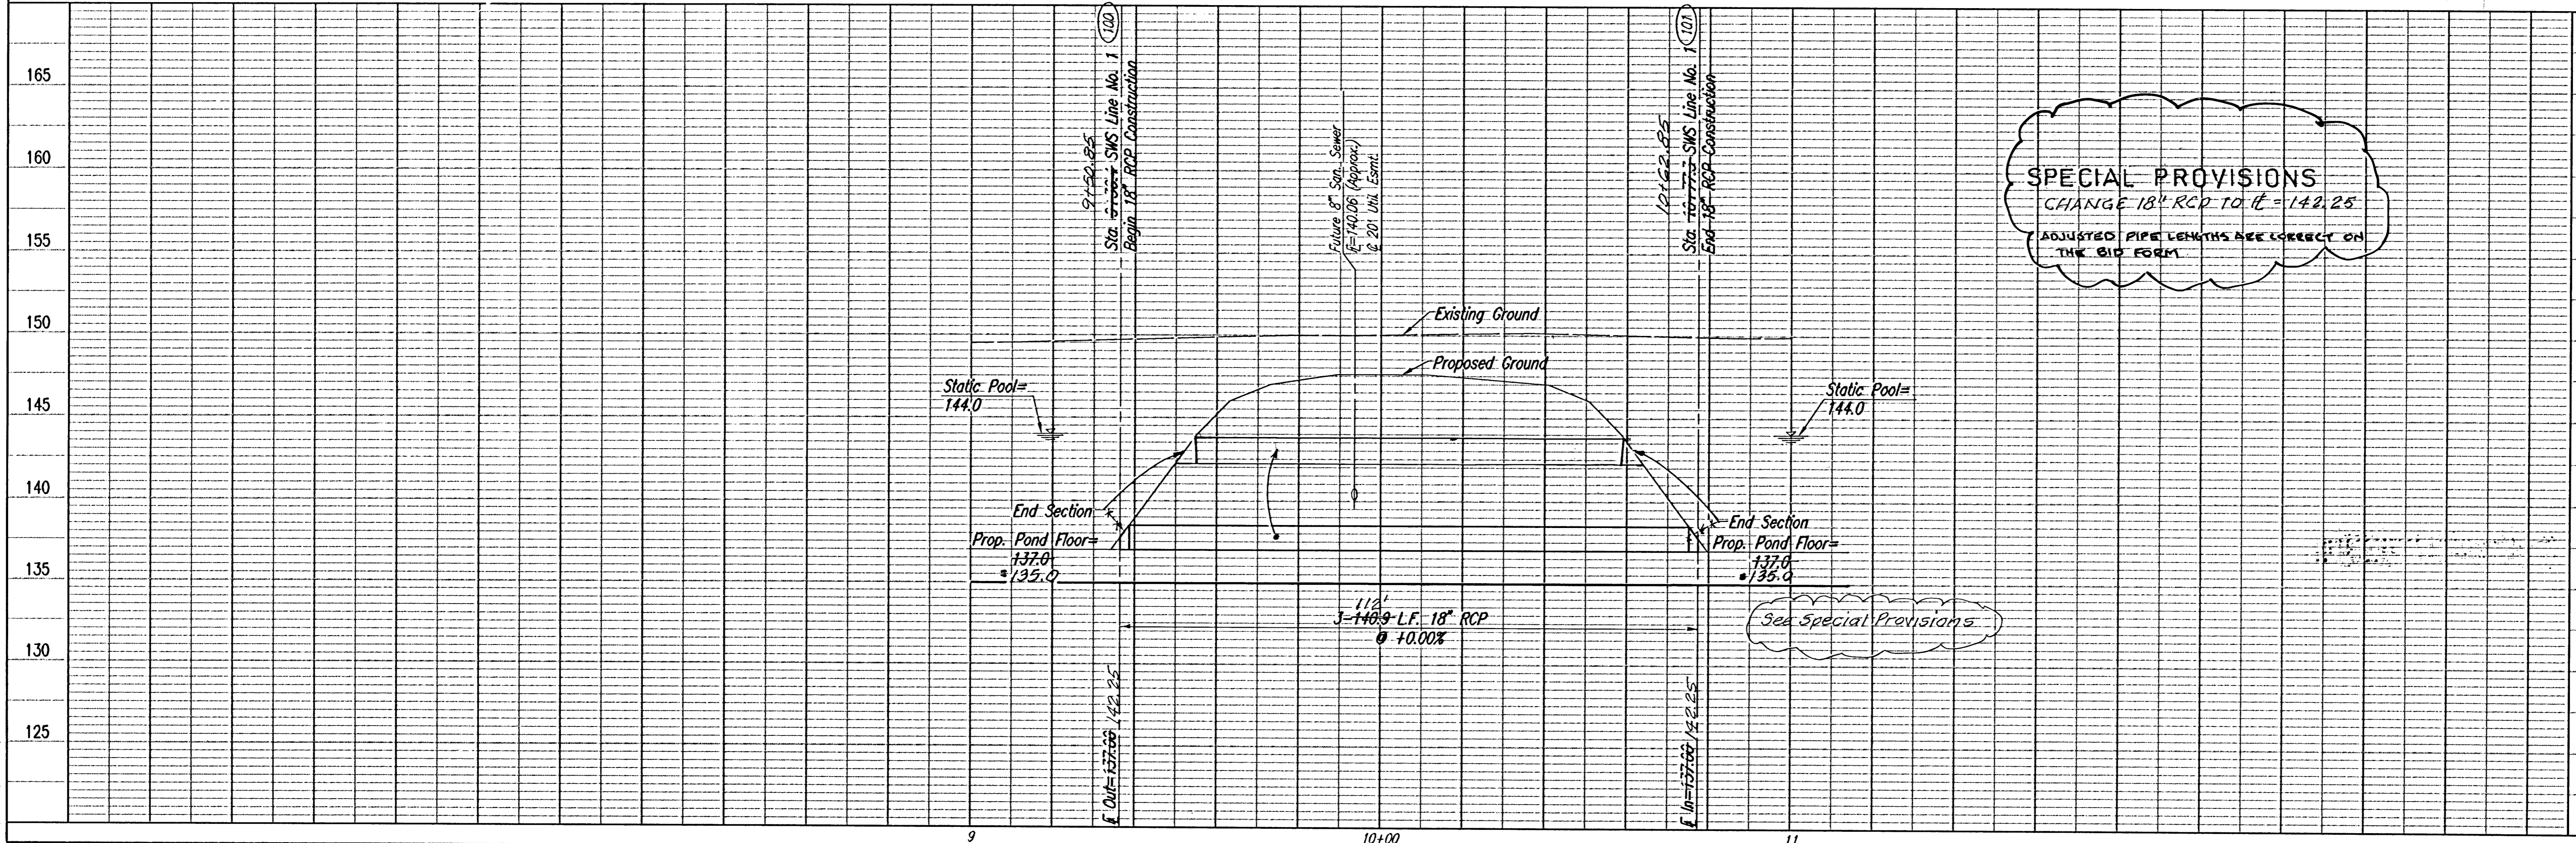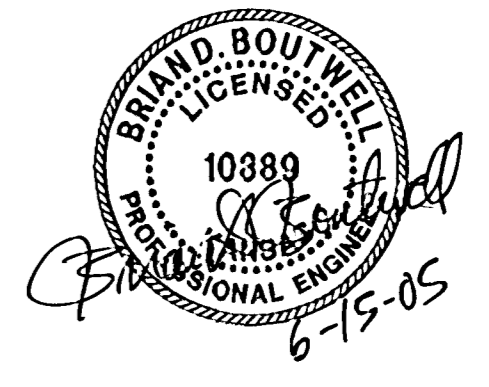

AVILON PARK 3RD
 STORM WATER DRAIN NO. 264
SWS LINE NO. 1

Professional Engineering Consultants, P.A.
 303 S. TOPEKA - WICHITA, KANSAS 67202
 316-262-2691 • FAX 316-262-3003

Designed By: BDB, BLB
 Drawn By: BJS

Job No.: 35-05257
 Date: February 2005

JAMES L. ARMOUR, P.E., CITY ENGINEER
 CITY OF WICHITA PROJECT NO. 488-84011

Sheet 9 of 31