

POND #4
ADDED CONTOUR LINES 135 & 136
CHANGE ORDER #2

Install Pond Slope Protection
Along Full Pond Perimeter.
(See Detail, Sheet No. 8).

POND #5
SIZE & SLOPE WAS CHANGED
CHANGE ORDER #1
ON OCA # 765932

CONSTRUCT HEADWALL
CHANGE ORDER #1

GENERAL NOTES


1. THE EROSION CONTROL DEVICES SHOWN ON THIS SHEET ARE CONSIDERED MINIMUM STANDARDS. WHENEVER SEDIMENT ENTERS THE STREETS, STORM SEWERS, DITCHES, OR PONDS, CONTRACTOR WILL INSTALL ADDITIONAL DEVICES, AS NEEDED, TO CORRECT THE PROBLEM.
2. THE EROSION CONTROL DEVICES SHOWN HEREON MUST BE IN PLACE AT ALL TIMES DURING CONSTRUCTION UNTIL SUCH TIME AS THE SITE IS REESTABLISHED WITH PAVING OR GRASS. TEMPORARY OR PERMANENT AND MULCH WILL BE INSTALLED WHEN EARTHWORK ACTIVITIES CEASE IN AN AREA FOR 14 DAYS OR MORE.
3. ANY MUD INADVERTENTLY TRACKED ONTO ANY STREET WILL BE CLEANED UP BY THE CONTRACTOR, AT THE END OF EACH DAY'S WORK.
4. CONTRACTOR TO FURNISH A TRUCK WASH-OUT PIT TO BE PLACED AT A CONVENIENT AND OBVIOUS LOCATION THAT DOES NOT CONFLICT WITH CONSTRUCTION. CONTRACTOR SHALL CLEAN OUT AND BACKFILL PIT PRIOR TO FINAL INSPECTION.

LEGEND

 Pond Slope Protection
(See Detail, Sheet No. 8)

SCALE: 1"=100'

Richard E. Smith
02 02706
RECORD DRAWING

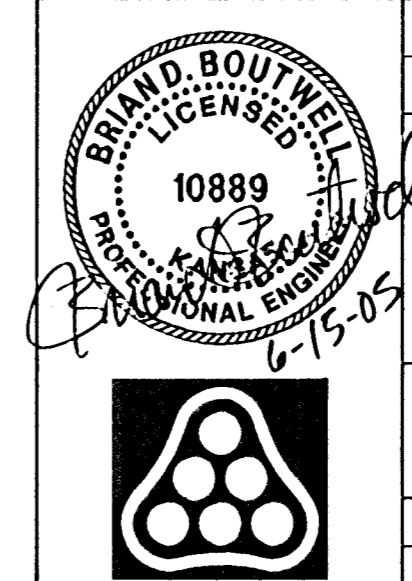

No.	Revision	By	Date
AVALON PARK 3RD STORM WATER DRAIN NO. 264 EROSION CONTROL (BMP) PLAN JAMES L. ARMOUR, P.E.—CITY ENGINEER CITY OF WICHITA PROJECT NO. 468-84011 Professional Engineering Consultants, P.A. 303 S. TOPEKA • WICHITA, KANSAS 67202 316-262-2691 • FAX 316-262-3003			
Designed by	BDB, BLB	Job No.	35-05257
Drawn by	BJS	Date	February 2005
			SH. 12 of 31

OSNR: BLB OPER: BJS SCALE: 1"=100.00
 Q:\2005\05257\05257-C-EROSIONCONTROL 06-16-2005 12:16:22 am