

PLAN	CHECKED	DATE

PROFILE	CHECKED	DATE

DSNR: BLB OPER: BUS SCALE: 1"=20.00
Q:\2005\05258\05258-C-SWS\LINE 1 06-16-2005 10:52:35 am

8+99
Sta. ~~8+99.7~~ SWS Line No. 1
Begin 36" RCP Construction
Install 104.9 L.F. 36" RCP (S)
(Including End Section)
101 L.F.

Sta. 10+00.0 SWS Line No. 1=
@ Lake Ridge Sta. 30+58.00, 20.67' Lt.
Const. Std. Type 1A Curb Inlet (S)
L=11'-0", W=3'-0"
Top Elev.=147.60
Install 41.3 L.F. 36" RCP (SW)
See Sheet No.

Sta. 10+41.3 SWS Line No. 1=
@ Lake Ridge Sta. 30+58.00, 20.67' Lt.
Const. Std. Type 1A Curb Inlet (S)
L=11'-0", W=3'-0"
Top Elev.=147.60
Install 68.4 L.F. 36" RCP (SW)
See Sheet No.

11+05.3
Sta. ~~11+05.7~~ SWS Line No. 1
End 36" RCP Construction
(Install End Section)

CHANGE ORDER #1
ADD CONTOUR LINES



COORDINATE LIST		
POINT	NORTH	EAST
100	11,695.1412	11,357.4317
101	11,590.7241	11,347.3648
102	11,562.4357	11,317.2191
103	11,511.2270	11,271.8734

100 = COORDINATE POINT NO.
SEE SHEET NO. 3 FOR PLAT COORDINATES

② Omit Center Wall.
See Reinf. Lid Details,
See Sheet No. 15.

See Special Provisions

RECORD DRAWING

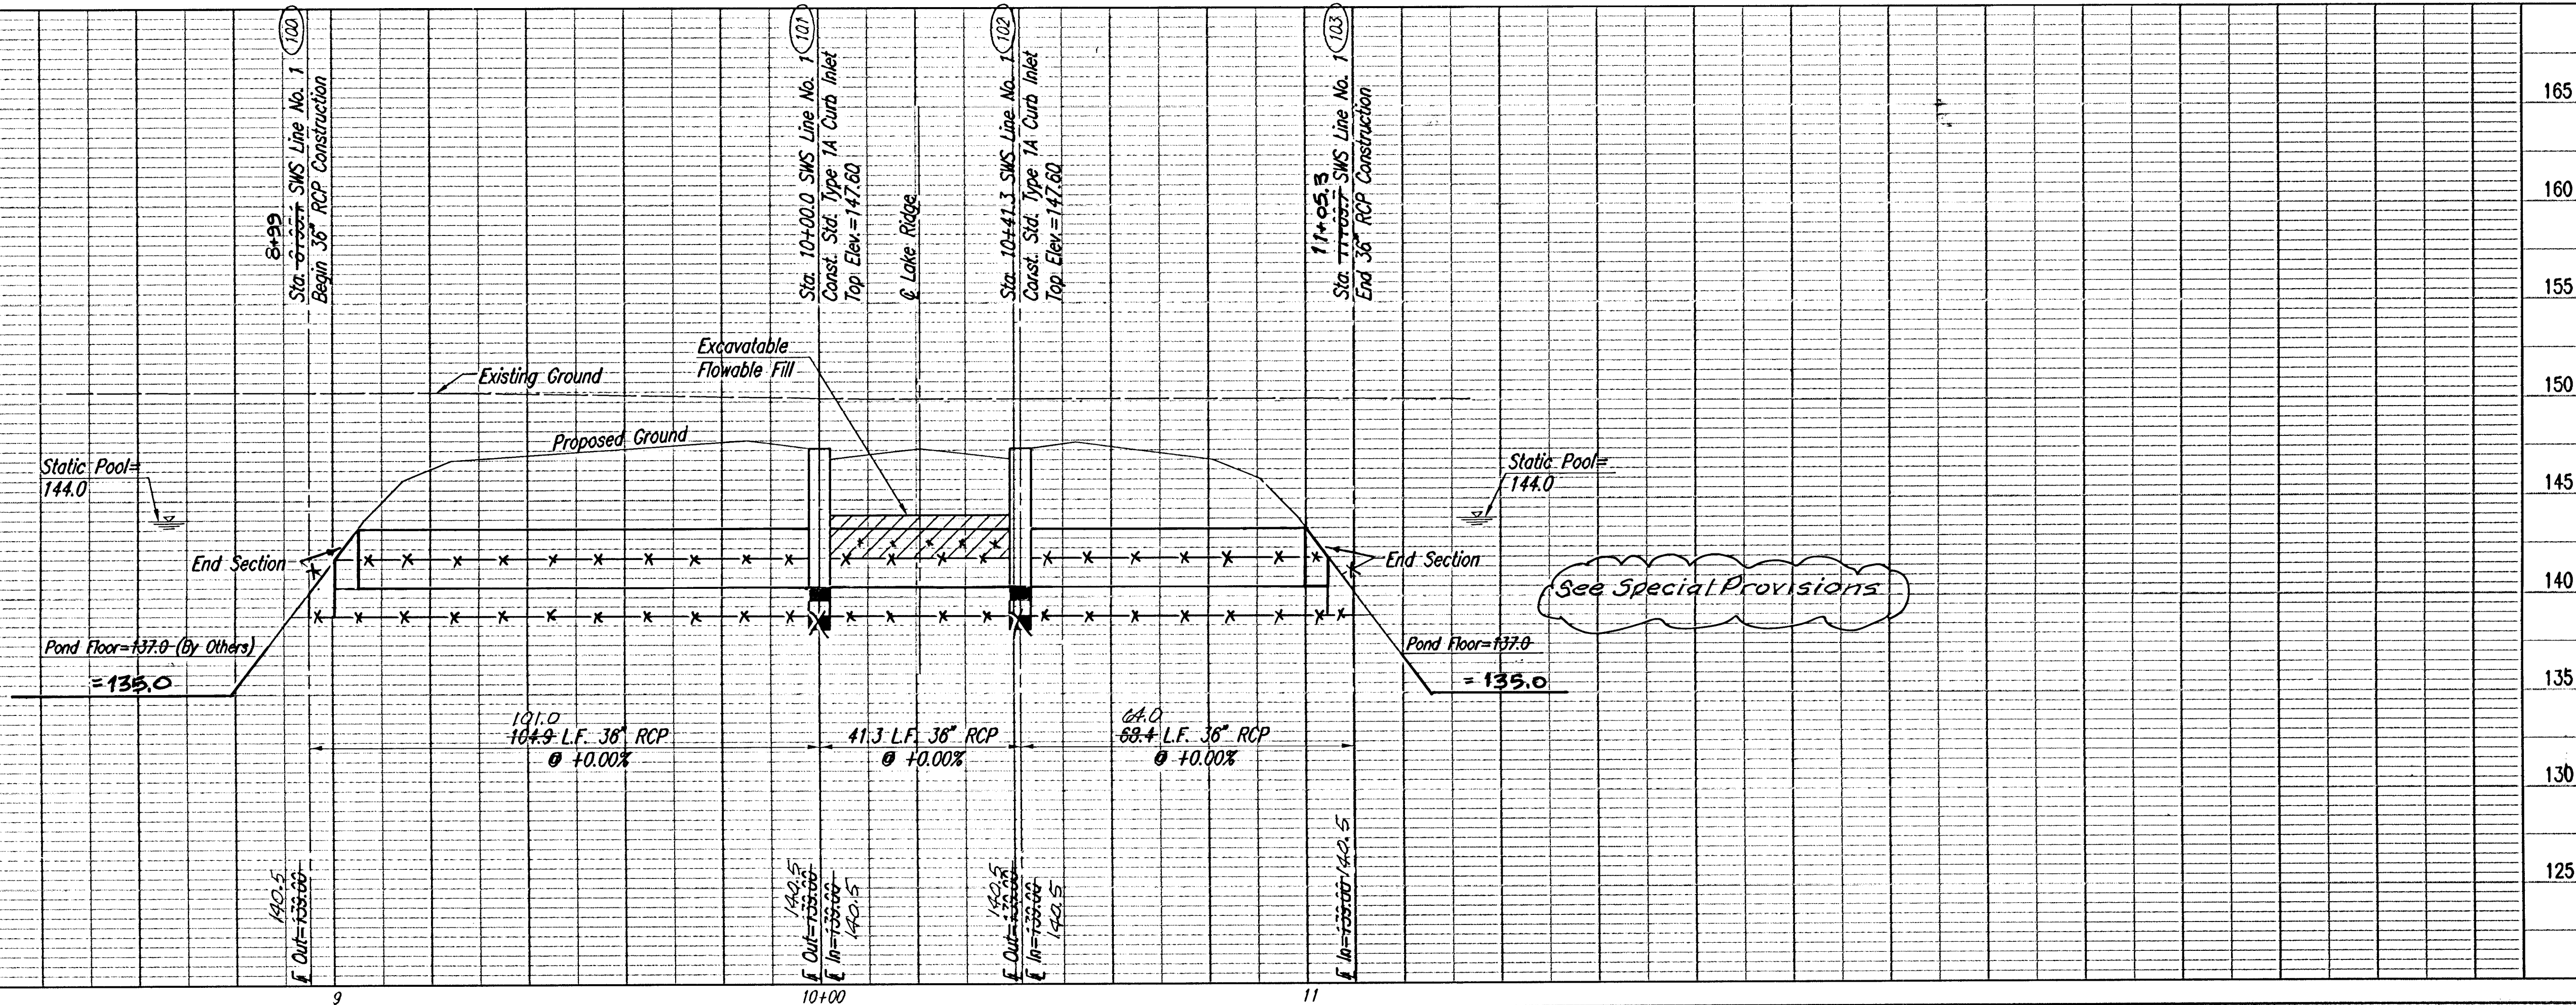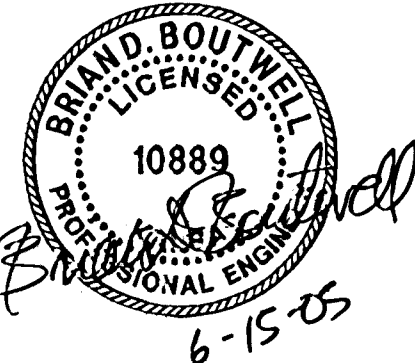

Sheet 10 of 35

Professional Engineering Consultants, P.A.
303 S. TOPKA • WICHITA, KANSAS 67202
316-262-2691 • FAX 316-262-3003

Designed By: BDB, BLB
Drawn By: BUS

Job No.: 35-05258
Date: February 2005

AVOLON PARK JRD
STORM WATER DRAIN NO. 265
SWS LINE NO. 1
JAMES L. ARMOUR, P.E.-CITY ENGINEER
CITY OF WICHITA PROJECT NO. 488-8402