


PLAN	CHECKED	CHECKED
BY		
DATE		

PROFILE	CHECKED	CHECKED
BY		
DATE		

DSNR: BLB OPER: BUS SCALE: 1"=20.00  
 G:\2005\05258\05258-C-SWSLINE2-06-16-2005 10:53:17 am

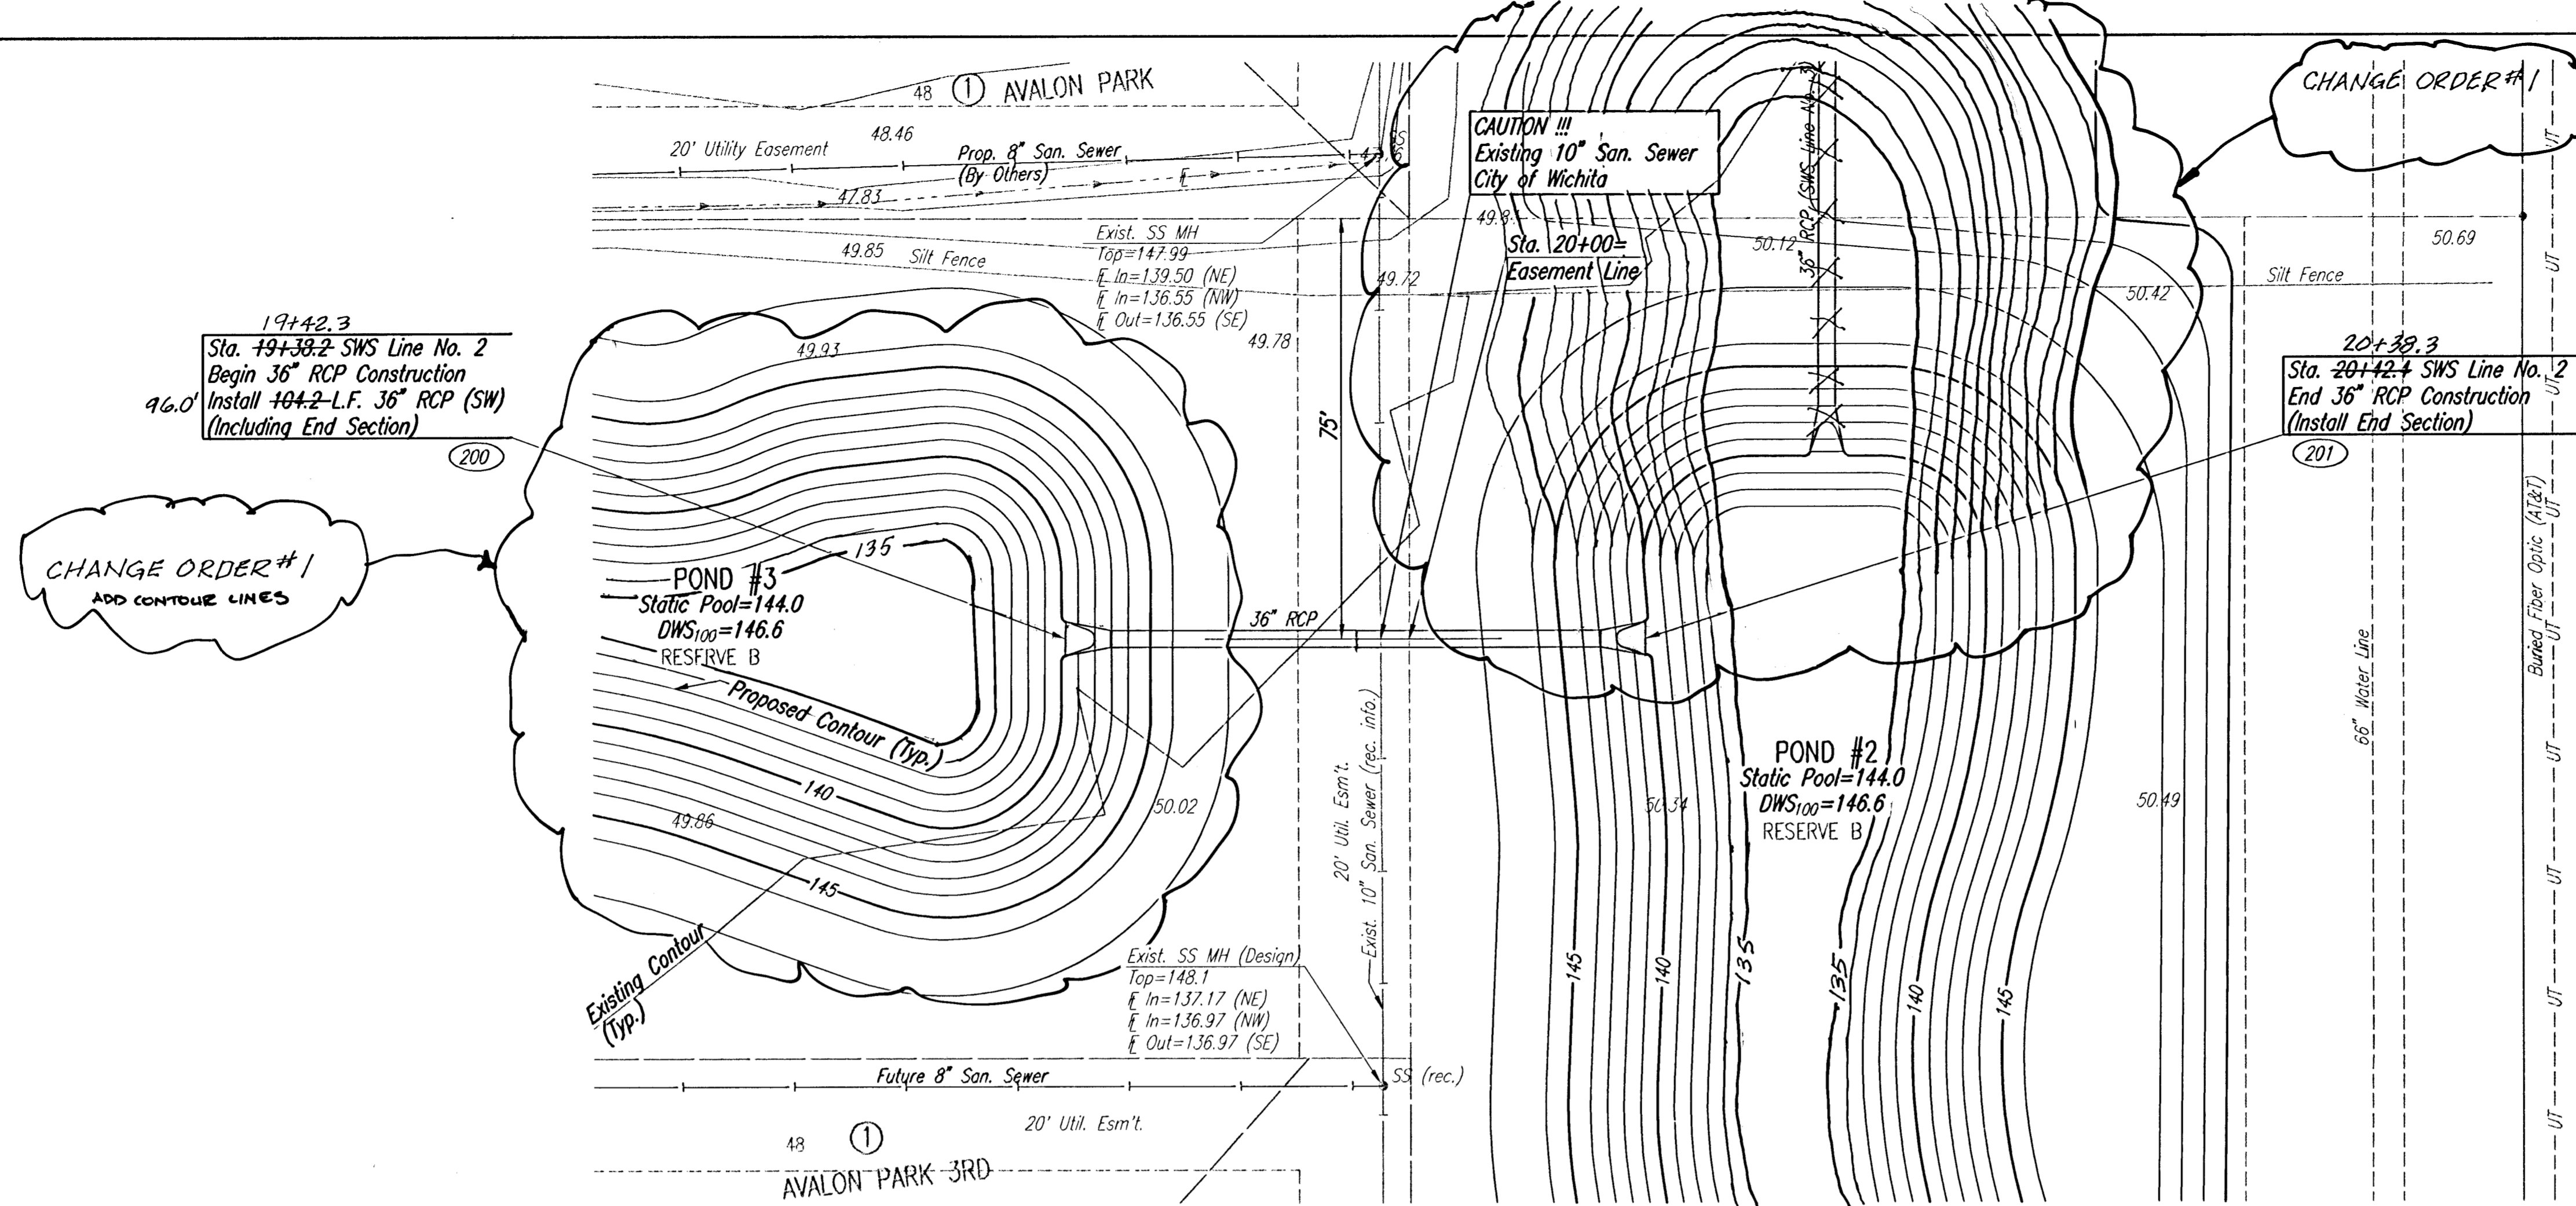


SCALE: 1"=20'

*See Special Provisions*

**RECORD DRAWING**

BRAND BOUTWELL  
 10889  
 PROFESSIONAL ENGINEER  
 6-15-05

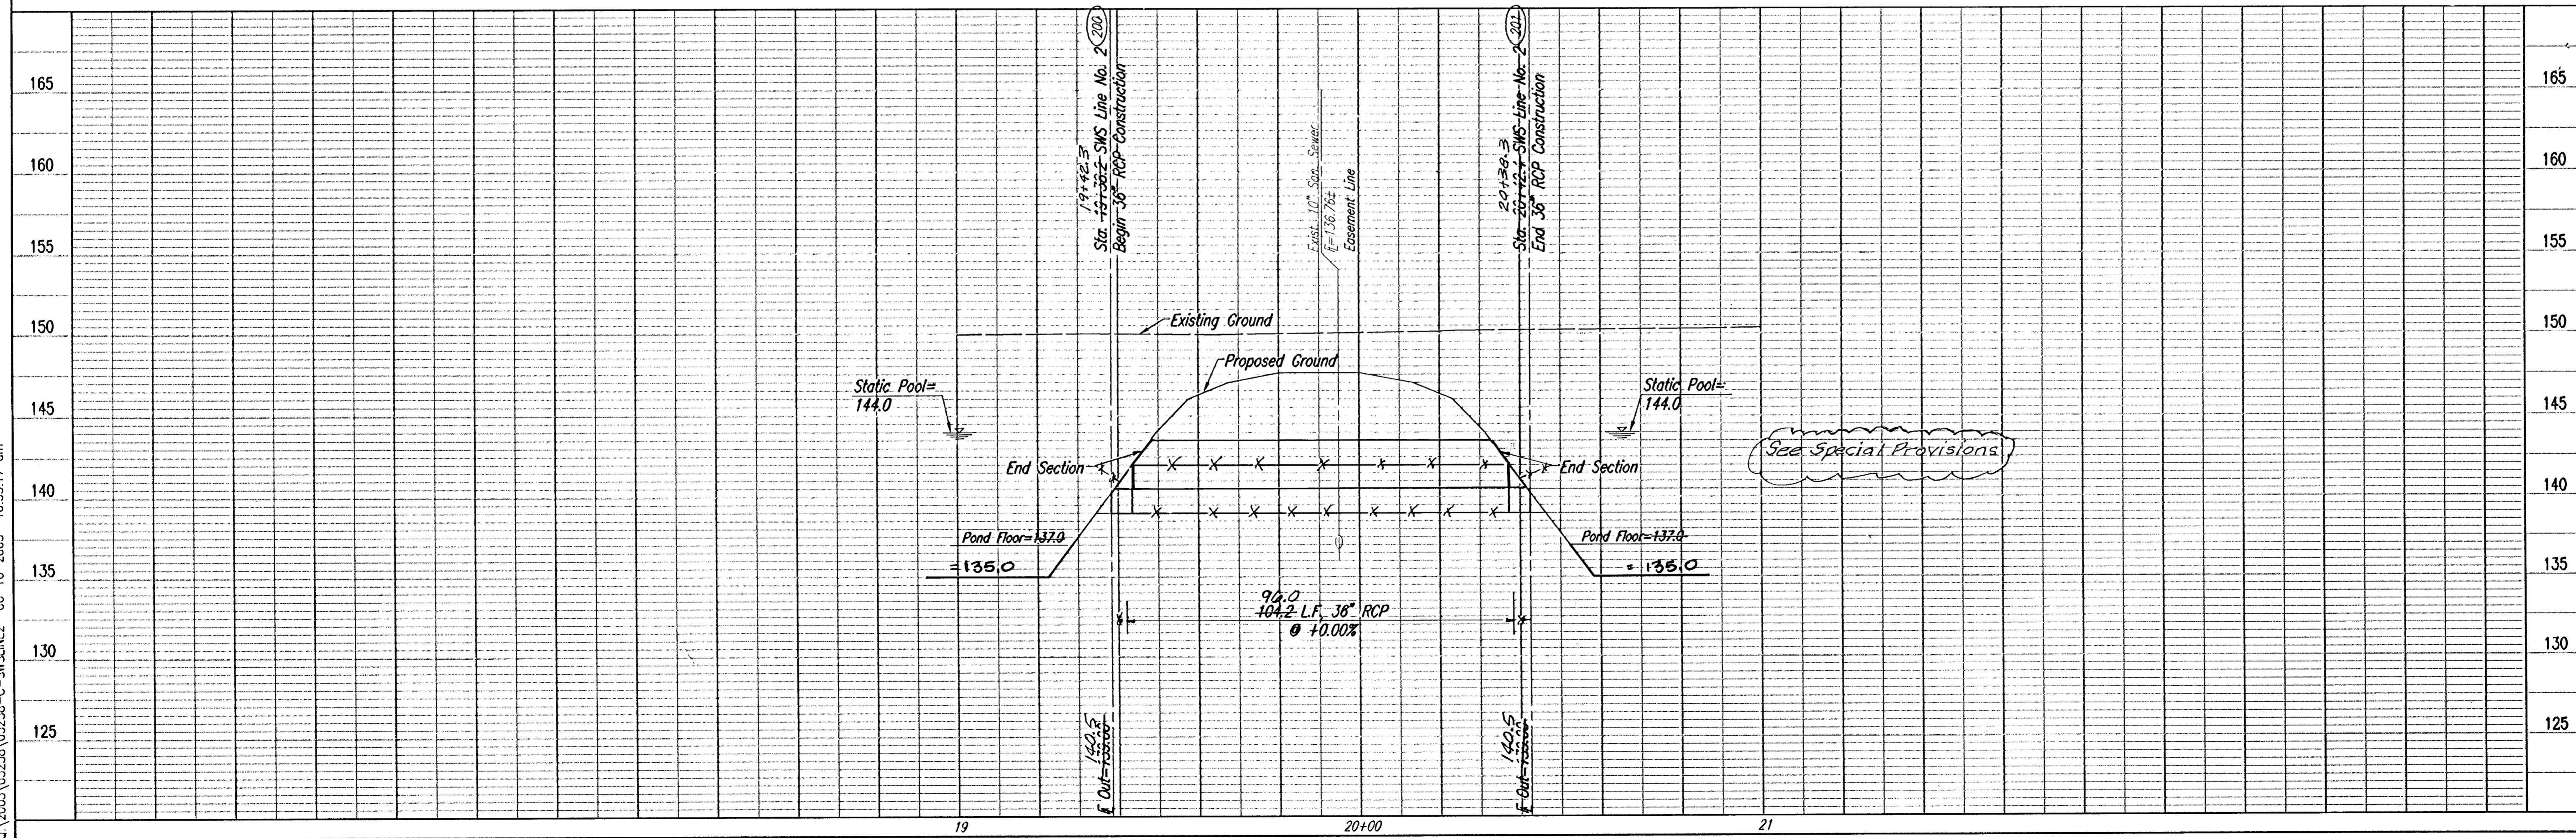

Professional Engineering Consultants, P.A.  
 303 S. TOPEKA • WICHITA, KANSAS 67202  
 316-266-2491 • FAX 316-262-5003

Designed By: BDR, BLB  
 Job No.: 35-05258  
 Date: February 2005

Professional Engineer  
 10889  
 6-15-05

AVALON PARK 3RD  
 STORM WATER DRAIN NO. 265  
**SWS LINE NO. 2**  
 JAMES L. ARMOUR, P.E. - CITY ENGINEER  
 CITY OF WICHITA PROJECT NO. 488-8402