


LATERAL 1, MAIN 16 OF THE FOUR MILE CREEK SEWER IN THE CITY OF WICHITA

OCA NO. 744121
CITY OF WICHITA PROJECT NO. 468-83984
JAMES L. ARMOUR, P.E. - CITY ENGINEER

INDEX OF SHEETS

SHEET NO. 1	TITLE SHEET
SHEET NO. 2	KEY MAP AND GENERAL NOTES
SHEET NO. 3-4	PLATS
SHEET NO. 5-11	PLAN/PROFILE
SHEET NO. 12	TYPE "P" MANHOLE DETAILS
SHEET NO. 13	FRAME & COVER DETAILS
SHEET NO. 14	RISER DETAILS
SHEET NO. 15-18	SOIL EROSION BMP DETAILS

WB Carter Construction Co., Inc. - Contractor
Strothman, City Inspector
Released 11/22/05
As-Built (revised sheets 2, 3, 5, 6, 7, 8 6/29/05)
Stubbs
.pdf by JDL 3/2/06

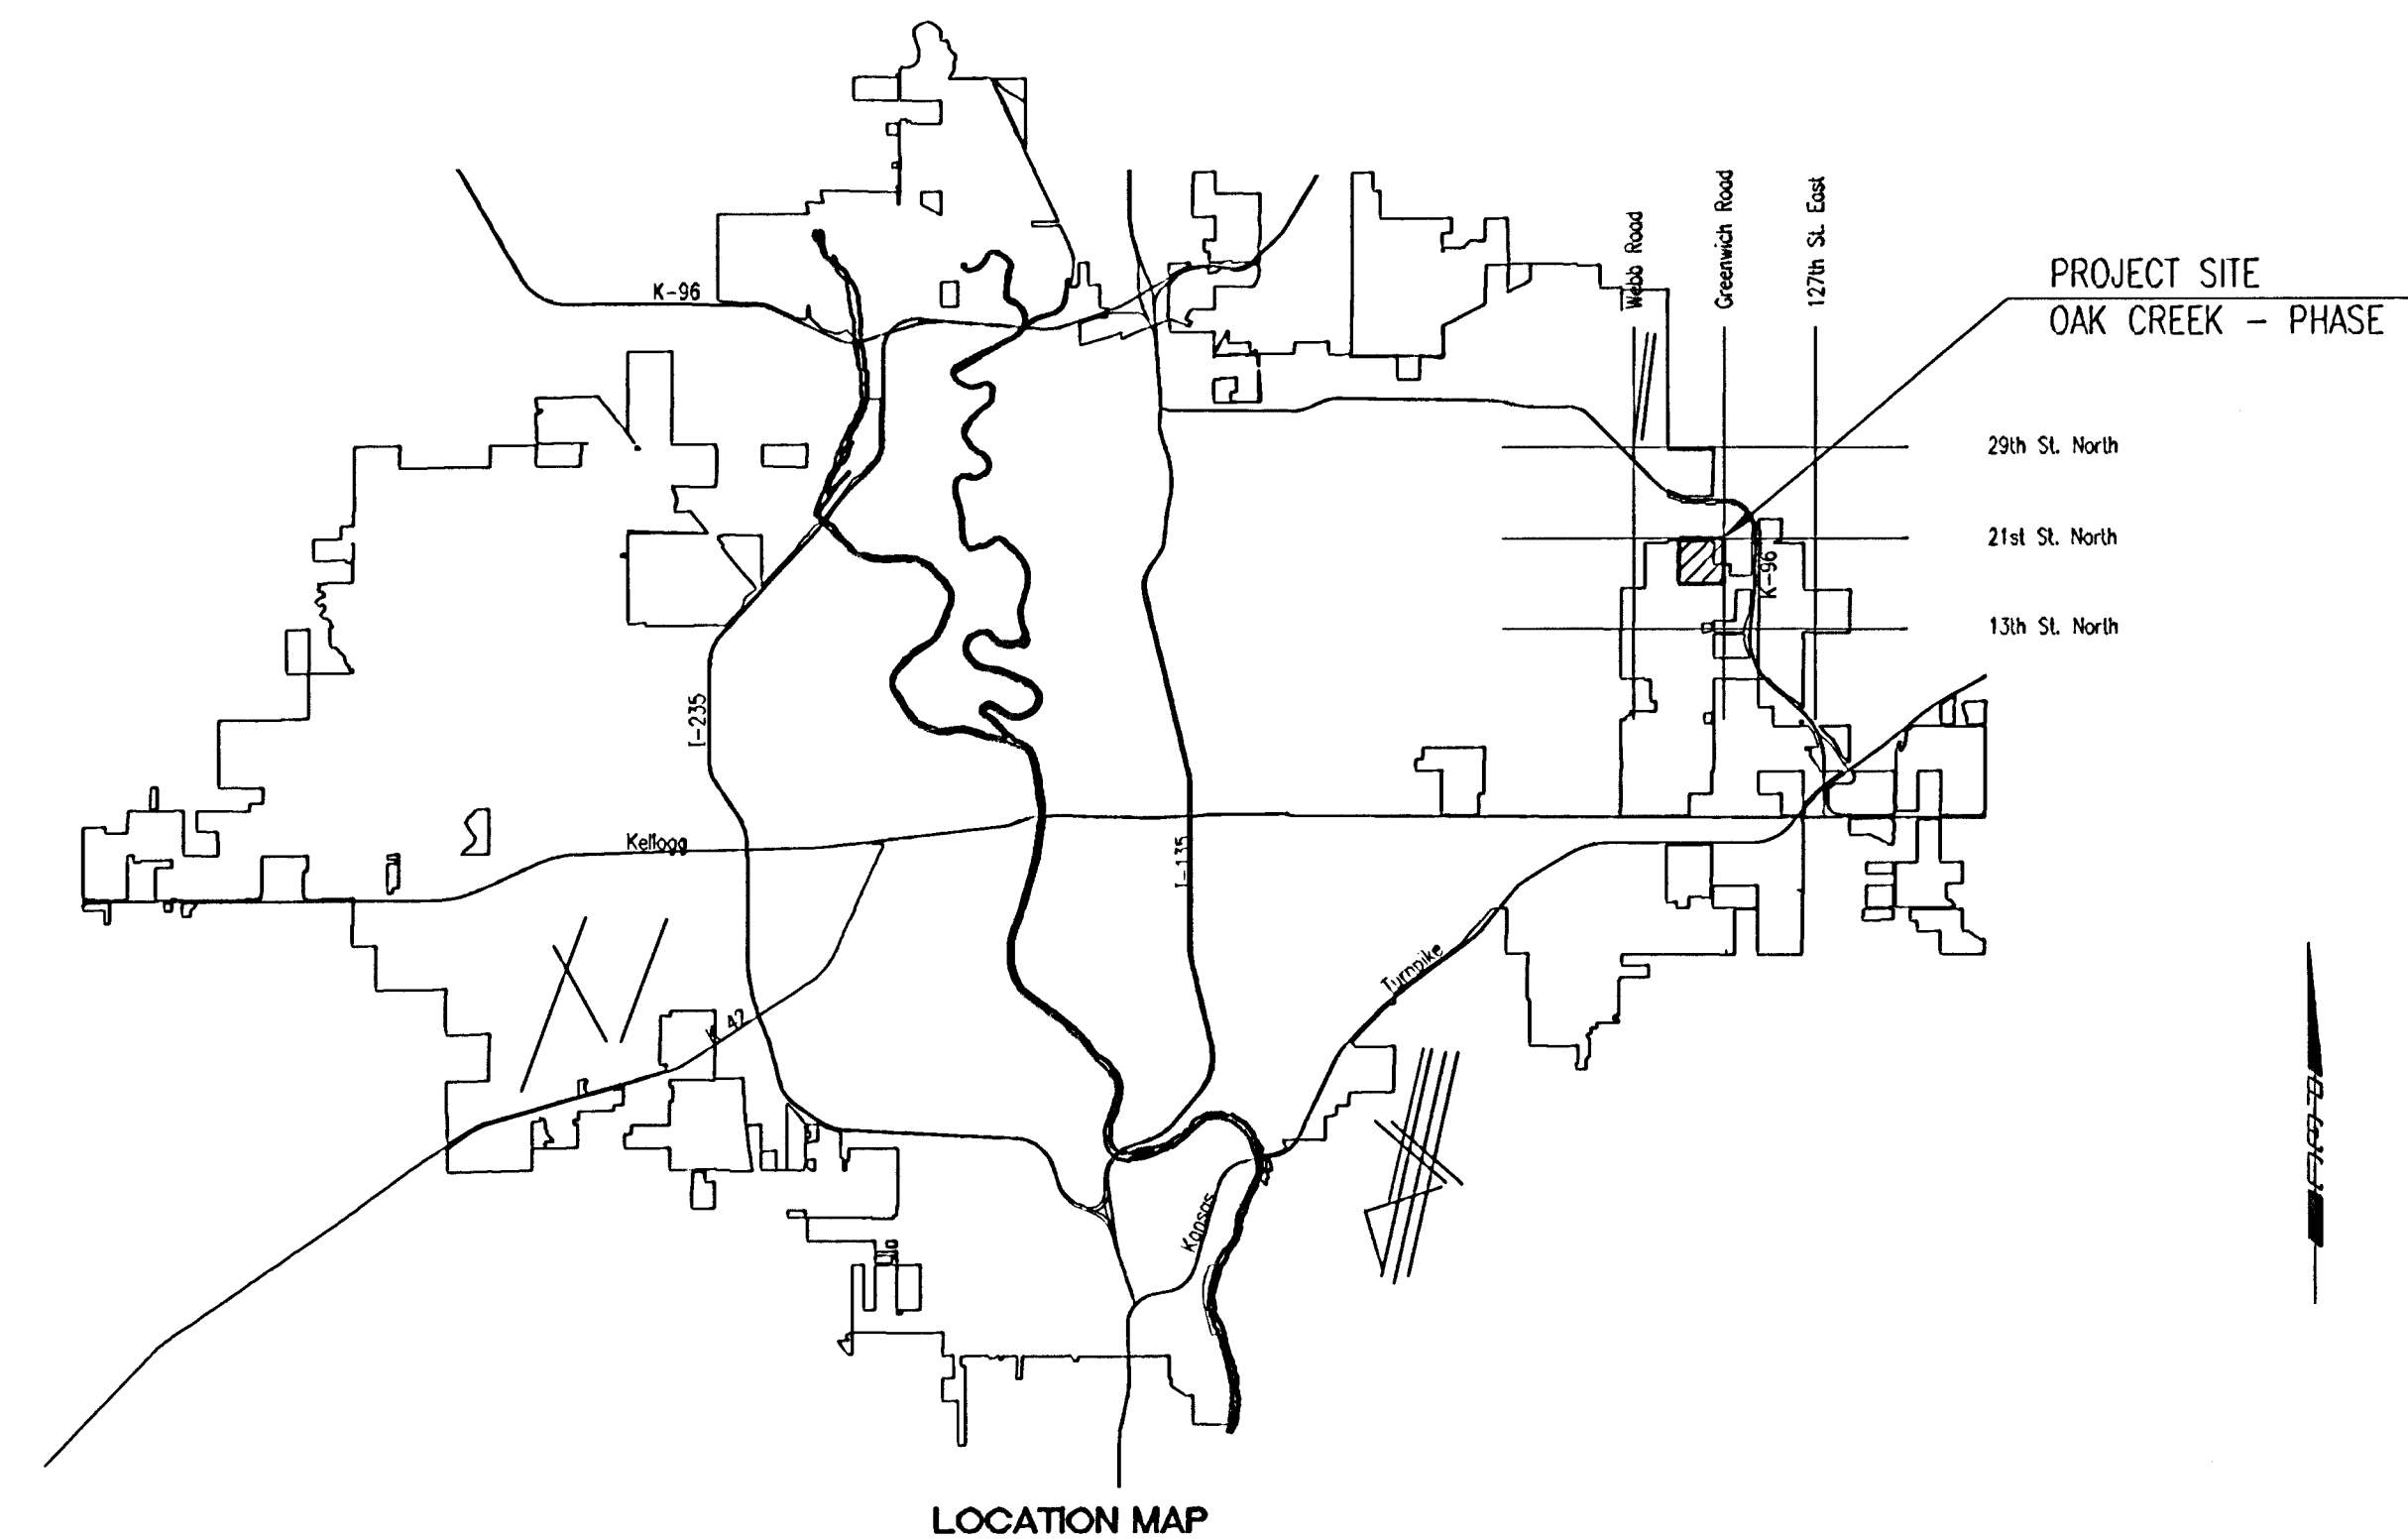

CONSTRUCTION SCHEDULE/SEQUENCE

THE CONTRACTOR FOR EACH OF THE FOLLOWING OAK CREEK PROJECTS SHALL COORDINATE THEIR EFFORTS WITH OTHER CONTRACTORS PERFORMING WORK IN THIS AREA SUCH THAT ANY NECESSARY SIMULTANEOUS CONSTRUCTION CAN PROCEED CONCURRENTLY WITHOUT CAUSING UNDUE DELAYS SO THAT CONSTRUCTION CAN BE COMPLETED WITHIN THE TIME FRAMES AS NOTED.

SANITARY SEWER (468-83984)

THE CONTRACTOR SHALL SEQUENCE HIS WORK TO COMPLETE OAK CREEK - PHASE 1 SANITARY SEWER CONSTRUCTION, INCLUDING TESTING AND ACCEPTANCE, BY 8-22, 2005.

WATER DISTRIBUTION SYSTEM (448-90067)

THE CONTRACTOR SHALL COMPLETE OAK CREEK - PHASE 1 WATERLINE CONSTRUCTION BY 9-27, 2005. THE CONTRACTOR SHALL COORDINATE INSTALLATION OF WATERLINES WITH THE PAVING/INCIDENTAL DRAINAGE CONTRACTOR SO THAT STORM SEWERS CROSSING BELOW PROPOSED WATERLINES WILL BE INSTALLED PRIOR TO THE WATERLINE CONSTRUCTION.

PAVING AND INCIDENTAL DRAINAGE (472-84209)

THE CONTRACTOR SHALL COMPLETE OAK CREEK - PHASE 1 PAVING AND INCIDENTAL DRAINAGE CONSTRUCTION BY 11-27, 2005.

THE CONTRACTOR SHALL COORDINATE INSTALLATION OF THE STORM SEWER WITH THE WATERLINE CONTRACTOR AS NECESSARY SO THAT THE STORM SEWERS CROSSING BELOW PROPOSED WATERLINES WILL BE INSTALLED PRIOR TO THE WATERLINE CONSTRUCTION.



MAY 2005
PLANS PREPARED BY
PROFESSIONAL ENGINEERING CONSULTANTS, P.A.
ENGINEERS
WICHITA, KANSAS