


USNR: MDK OPER: CSI SCALE: 1"=40.00
01/2004/04688/001/04688-001-C-SSRPU300 1 06-14-2005 10:13:44 am

PROFILE		BY	DATE
CHECKED	CHECKED		
CHECKED	CHECKED		

PLAN		BY	DATE
CHECKED	CHECKED		
CHECKED	CHECKED		

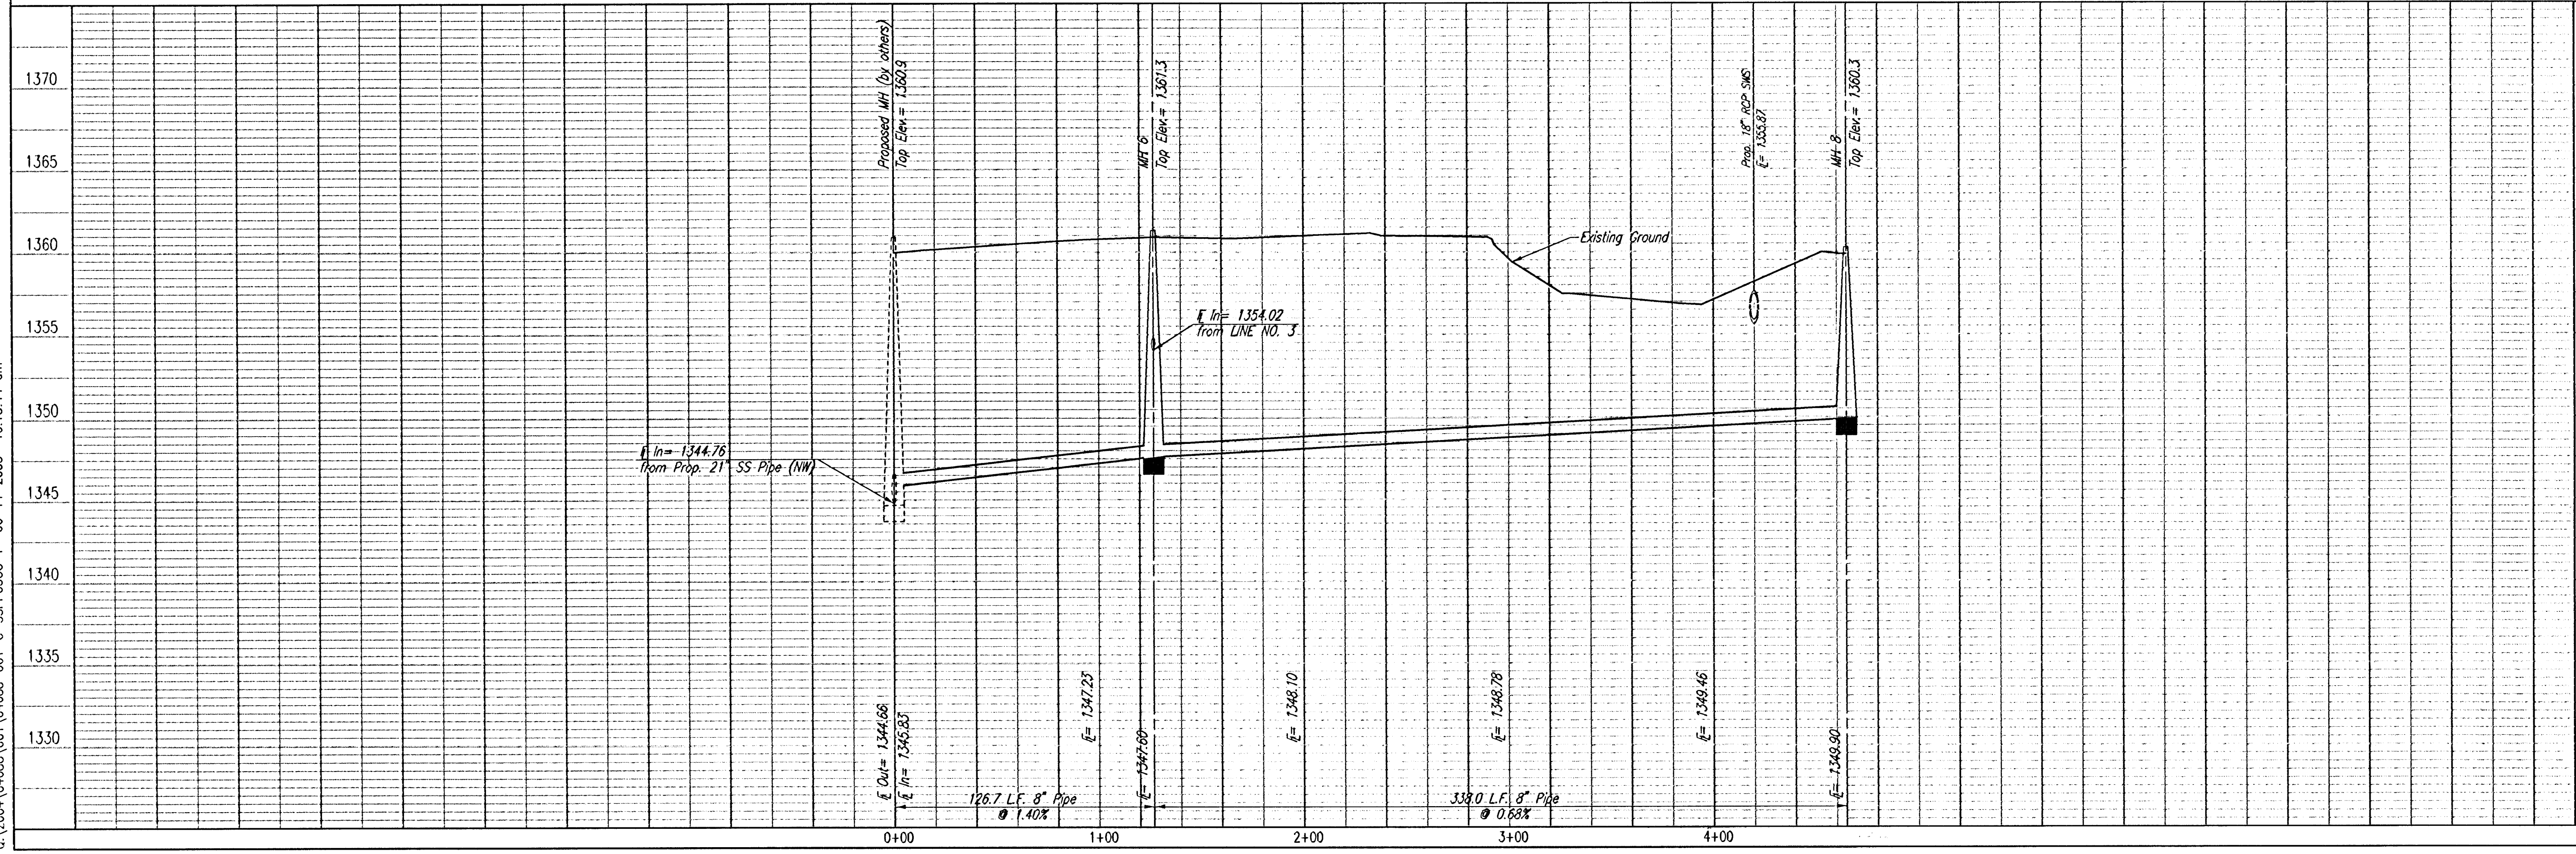

SANITARY SEWER LINE NO. 2

N-386,752.2877, E-2,373,394.0758
Sta. 0+00.0
Proposed Precast Concrete MH (by others).
Plug and stake end of Pipe for future
connection by others. See detail sheet no. 8

N-386,628.5397, E-2,373,366.9898
Sta. 1+26.7
Const. MH 6
Outside Drop MH

~~N-386,528.1371, E-2,373,397.1236~~
~~Sta. 2+24.2~~
~~Const. MH 7~~
~~Standard MH~~
MH 7 OMITTED

CAUTION !!!
Proposed 18" RCP Storm
Sewer (by others)

N-386,304.8246, E-2,373,464.1464
Sta. 4+64.7
Const. MH 8
Standard MH

SCALE:
PLAN: LAT. & LONG. 0 40 80
PROFILE: HORIZ. SAME AS ABOVE
VERT. 0 5

SEE SHEET NO. 3 & 4
FOR PLAT COORDINATES



Revision		By	Date
1	CHANGE ORDER #1- SANITARY SEWER ALIGNMENT CHANGE	MDK	06/14/05

LATERAL 1, MAIN 16
OF THE FOUR MILE CREEK SEWER
SANITARY SEWER LINE NO. 2
JAMES L. ARMOUR, P.E. - ACTING CITY ENGINEER
CITY OF WICHITA PROJECT NO. 488-83984

Professional Engineering Consultants, P.A.
303 S. TOPEKA • WICHITA, KANSAS 67202
316-262-2691 • FAX 316-262-3003
Designed By: MDK
Drawn By: TLB
Job No.: 35-04688-001
Date: January 2005