


BENCHMARK:
R.R. SPIKE IN HLP, 150' E. & 30'
S. OF THE S.W. COR., S.E. 1/4,
SEC. 12-26-1W.
ELEV. = 1338.96 M.S.L.
ELEV. = 151.56 City Datum


"O" IN OPEN, TOP FLANGE OF
FIRE HYDRANT AT THE S.W.
CORNER OF 61ST. ST. N. &
MERIDIAN AVE.
ELEV. = 1339.16 M.S.L.
ELEV. = 151.76 City Datum

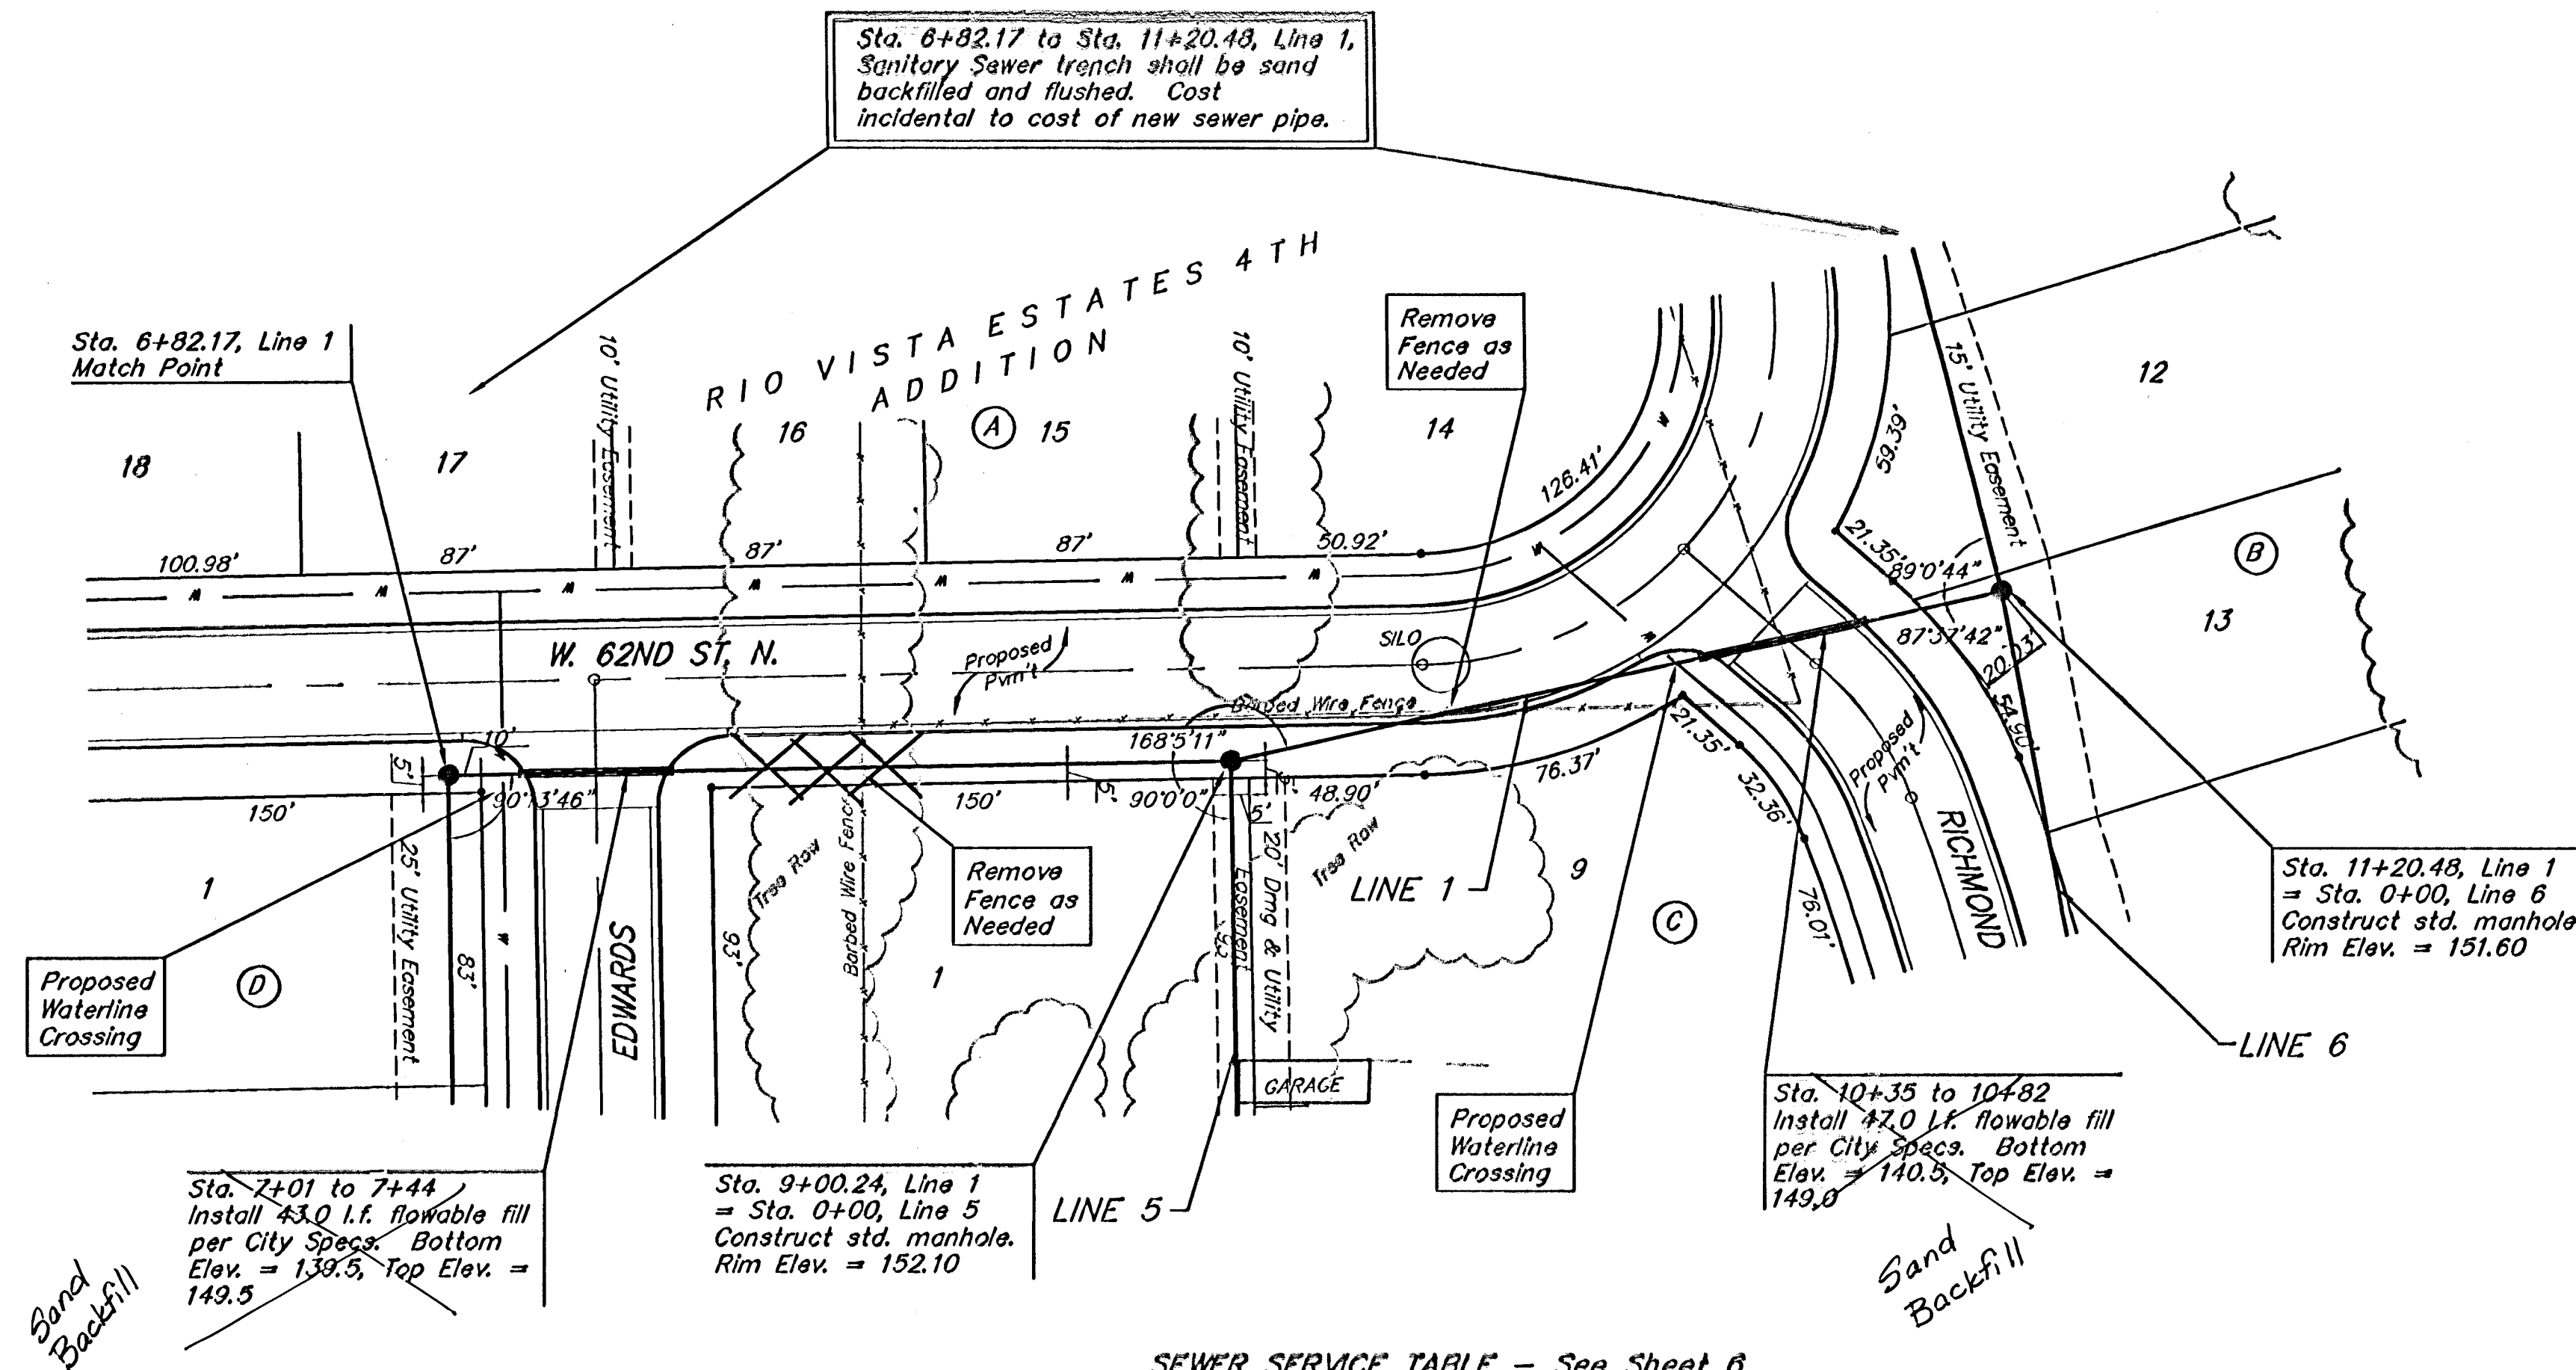

Scale: 1" = 40' Horizontal
1" = 5' Vertical
• = Iron

Denotes Trees to be
Removed by the
Sanitary Sewer Contractor

SEWER SERVICE TABLE - See Sheet 6

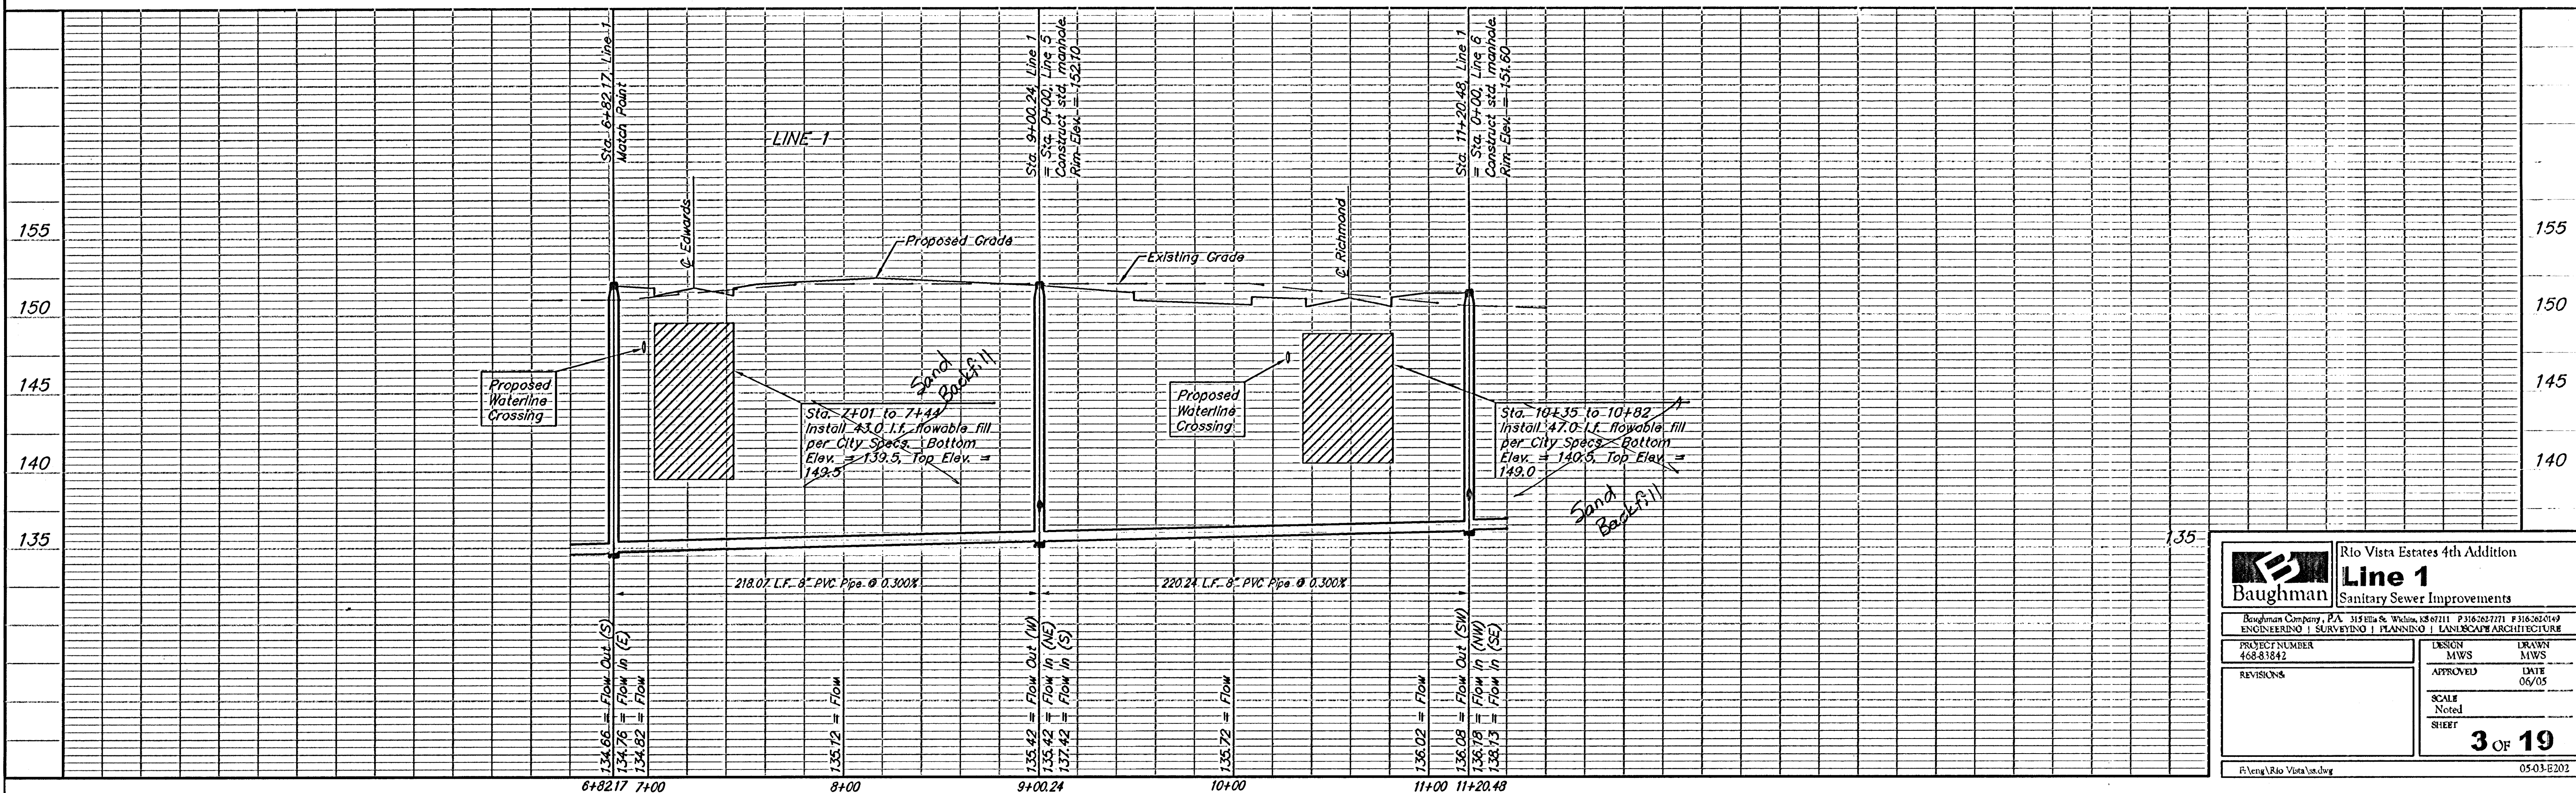

Baughman Rio Vista Estates 4th Addition
Line 1
Sanitary Sewer Improvements

Project Number: 468-0342
Design: MWS
Drawn: MWS
Approved: DATE: 06/05
Scale: Noted
Sheet: 3 OF 19

Revisions:
1. 06/05/05