

LATERAL 16, MAIN 19 OF THE SOUTHWEST INTERCEPTOR SEWER IN THE CITY OF WICHITA

OCA NO. 744067
CITY OF WICHITA PROJECT NO. 468-83748
JAMES L. ARMOUR, P.E. - ACTING CITY ENGINEER

INDEX OF SHEETS

SHEET NO. 1	TITLE SHEET
SHEET NO. 2	KEY MAP AND GENERAL NOTES
SHEET NO. 3	PLAN
SHEET NO. 4-9	PLAN/PROFILE
SHEET NO. 10	TYPE "P" MANHOLE DETAILS
SHEET NO. 11	TYPE "P" & "C" SHALLOW MANHOLE DETAILS
SHEET NO. 12	FRAME & COVER DETAILS
SHEET NO. 13	RISER DETAILS
SHEET NO. 14-17	SOIL EROSION BMP DETAILS

CONSTRUCTION SCHEDULE/SEQUENCE


THE CONTRACTOR FOR EACH OF THE FOLLOWING AVALON PARK 2ND PROJECTS SHALL COORDINATE THEIR EFFORTS WITH OTHER CONTRACTORS WORKING ON-SITE TO PERMIT SIMULTANEOUS CONSTRUCTION WHENEVER POSSIBLE AND TO AVOID UNDUE DELAYS, SO THAT EACH PROJECT CAN BE COMPLETED WITHIN THE TIME FRAMES NOTED BELOW.

SANITARY SEWER - LATERAL 16, MAIN 19 OF THE SOUTHWEST INTERCEPTOR SEWER
(CITY OF WICHITA PROJECT NO. 468-83748)
THE CONTRACTOR SHALL SEQUENCE HIS WORK TO COMPLETE, INCLUDING TESTING AND ACCEPTANCE, LINE 1 FROM BEGINNING TO MH 2 AND LINE 2 FROM BEGINNING TO MH 4 FIRST, THEN PROCEED WITH COMPLETION OF THE BALANCE OF LINE 2 THRU MH 10. AFTER THIS WORK IS COMPLETE, COMPLETE ALL REMAINING WORK. ALL WORK ON THE PROJECT SHALL BE COMPLETED BY APRIL 29, 2005.

WATER DISTRIBUTION SYSTEM
(CITY OF WICHITA PROJECT NO. 448-89908)
THE CONTRACTOR SHALL COMMENCE WORK ON THIS PROJECT UPON COMPLETION OF PROTECTIVE FILL PLACEMENT BY THE STORM WATER DRAIN CONTRACTOR AND ALSO COMPLETION OF PORTIONS OF SANITARY SEWER LINE 1 AND LINE 2 AS NOTED ABOVE. THE CONTRACTOR SHALL COORDINATE INSTALLATION OF WATERLINES WITH THE STORM WATER DRAIN AND STREETS CONTRACTOR SO THAT STORM SEWERS CROSSING BELOW PROPOSED WATERLINES WILL BE INSTALLED PRIOR TO WATERLINE CONSTRUCTION. THE CONTRACTOR SHALL COMPLETE ALL AVALON PARK 2ND WATERLINE CONSTRUCTION BY MAY 20, 2005.

STREETS AND INCIDENTAL DRAINAGE
(CITY OF WICHITA PROJECT NO. 472-83899)
THE CONTRACTOR SHALL COORDINATE CONSTRUCTION OF STREETS WITH THE STORM WATER DRAIN AND WATERLINE CONTRACTOR SO THAT STORM SEWERS CROSSING BELOW PROPOSED WATERLINES WILL BE INSTALLED PRIOR TO WATERLINE CONSTRUCTION. THE CONTRACTOR SHALL COMPLETE ALL AVALON PARK 2ND STREETS AND INCIDENTAL DRAINAGE CONSTRUCTION BY JUNE 17, 2005.

STORM WATER DRAIN - STORM WATER DRAIN NO. 224
(CITY OF WICHITA PROJECT NO. 468-83750)
THE CONTRACTOR SHALL COORDINATE CONSTRUCTION TO COMPLETE THE PLACEMENT OF PROTECTIVE FILL FOR WATERLINE CONSTRUCTION BY APRIL 15, 2005. THE CONTRACTOR SHALL ALSO COORDINATE CONSTRUCTION OF THE STORM WATER DRAIN WITH THE STREETS AND WATERLINE CONTRACTOR SO THAT STORM SEWERS CROSSING BELOW PROPOSED WATERLINES WILL BE INSTALLED PRIOR TO WATERLINE CONSTRUCTION. THE CONTRACTOR SHALL COMPLETE THE AVALON PARK 2ND STORM WATER DRAIN CONSTRUCTION BY APRIL 29, 2005.

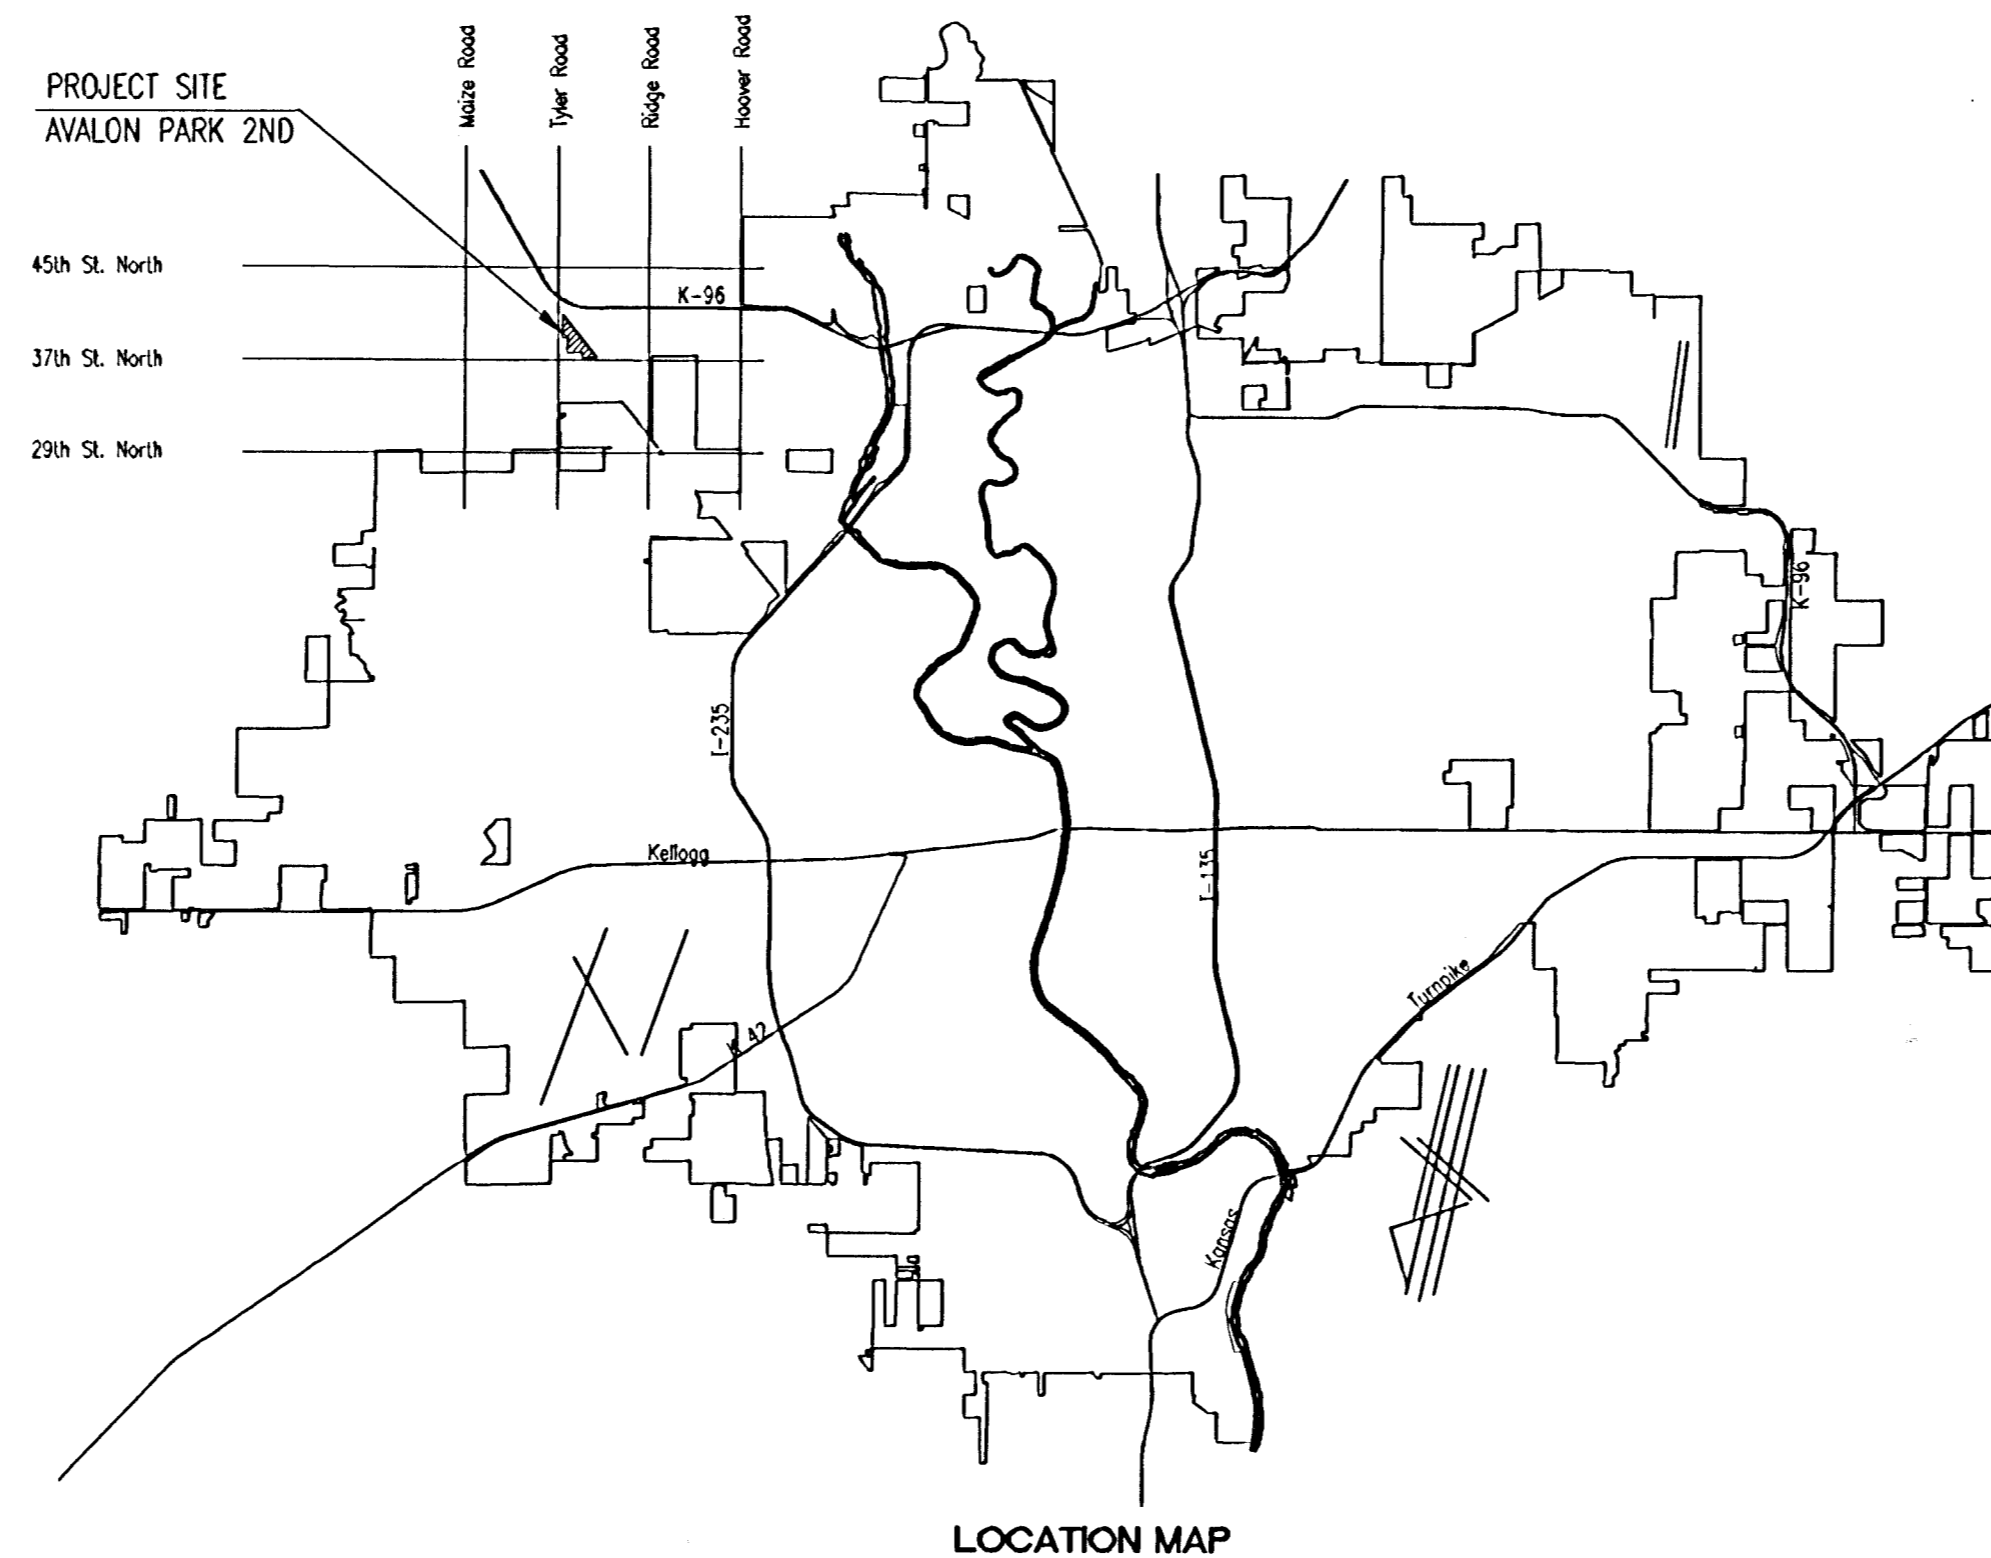

*Utility Contractors, Inc. - Contractors
Friesen, PEC - Inspector
Released 6/27/05
As-Built
Risers
.pdf by JDL 10/18/05*

JANUARY 2005

PLANS PREPARED BY
PROFESSIONAL ENGINEERING CONSULTANTS, P.A.
ENGINEERS
WICHITA, KANSAS



RECORD DRAWING

3rd Edition 23 JUN 05