

PLAN	CHECKED	DATE
	CHECKED	

PROFILE	CHECKED	DATE
	CHECKED	

DSNR: OPER. ILS SCALE: 1"=40.00'
 Q:\2004\04442\001\ssup01 10-05-2004 10:48:35 am

* PRIOR TO BEGINNING CONSTRUCTION, THE CONTRACTOR SHALL EXCAVATE THE EXISTING 8" PIPE AT SANITARY SEWER STATION 0+00.0 TO VERIFY ITS HORIZONTAL AND VERTICAL LOCATION. THE PIPE LOCATION SHALL BE REPORTED TO THE ENGINEER SO THAT ANY NECESSARY PLAN MODIFICATIONS CAN BE MADE. ANY ADDITIONAL LABOR OR MATERIALS NECESSARY TO COMPLETE THE CONNECTION SHALL BE CONSIDERED SUBSIDIARY TO THE PROJECT.

N-10,145.3039, E-11,142.2275
 Sta. 0+00.0
 Existing Precast Concrete MH.
 Connect new 8" PVC Pipe to
 existing 8" PVC Stub.

CAUTION !!!
 Proposed 36" RCP Storm
 Sewer (by others)

N-10,145.3039, E-11,142.2275
 Sta. 0+00.0
 Const. MH 1
 Standard MH (Type "P")

N-10,263.9926, E-11,103.9926
 Sta. 2+00.4
 Const. MH 2
 Outside Drop MH (Type "P")

N-10,073.6977, E-11,104.7777
 Sta. 3+90.7
 Const. MH 3
 Shallow MH (Type "P")

58.6
 Install 138.18' L.F.
 8" PVC Pipe

LINE NO. 3
 See sheet no. 8

SANITARY SEWER PIPE SLOPES HAVE
 NOT BEEN REVISED TO REFLECT AS
 CONSTRUCTED CONDITIONS.

141.4
 Install 137.6' L.F.
 8" PVC Pipe

LINE NO. 2
 See sheet no. 5




190.3
 Install 190.3' L.F.
 8" Pipe

SANITARY SEWER LINE NO. 1

ALL PIPE INSTALLED
 IS PVC PIPE.

①
 DENOTES SEWER SERVICE.
 SEE SHEET NO. 13 FOR SEWER
 SERVICE SCHEDULE AND DETAILS

RECORD DRAWING

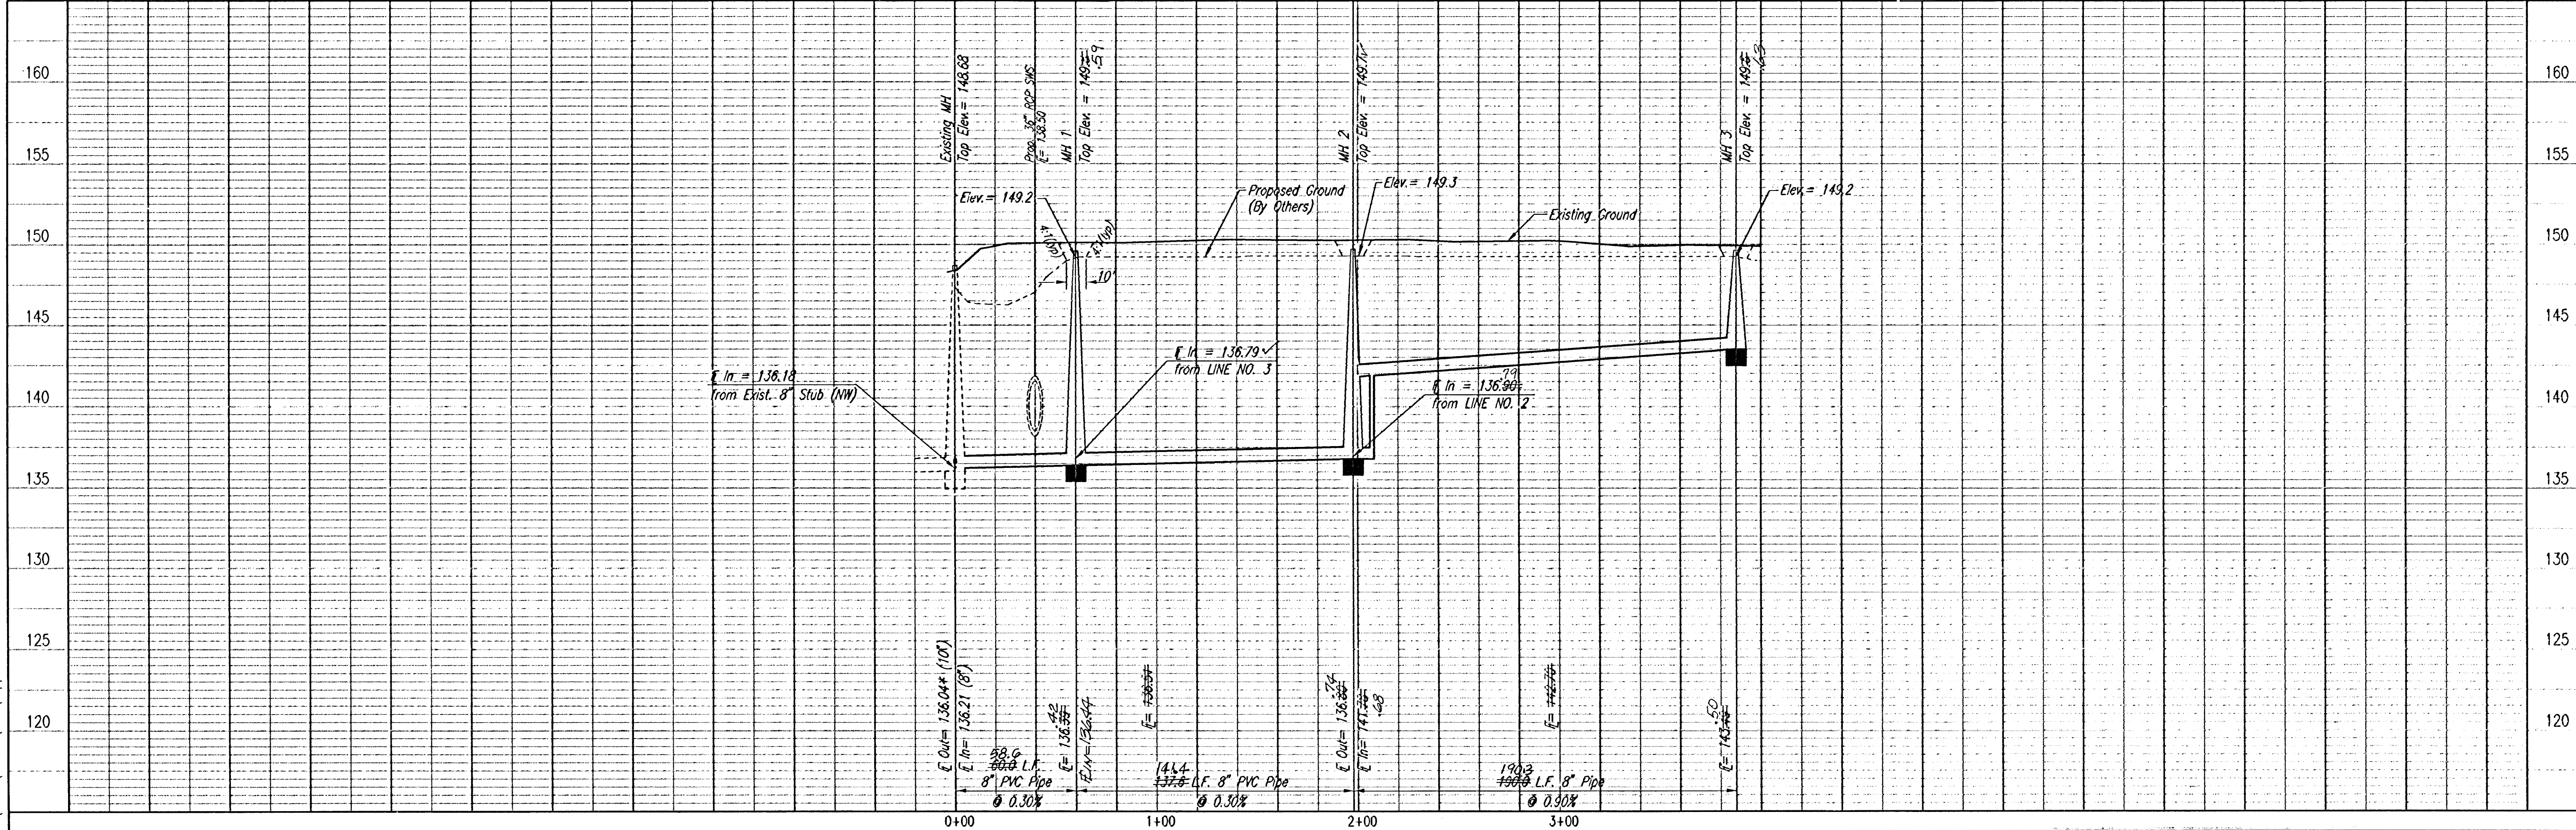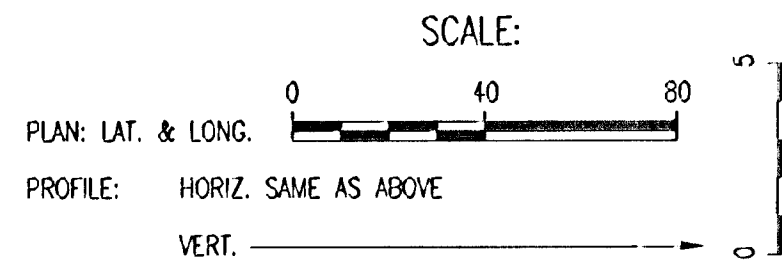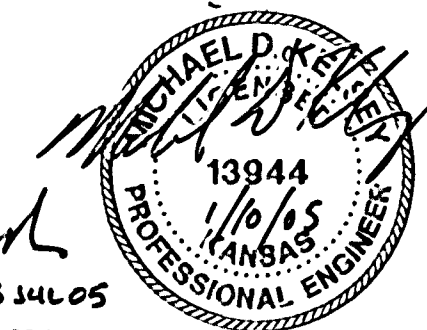

LATERAL 16 MAIN 19 OF THE
 SOUTHWEST INTERCEPTOR SEWER

SANITARY SEWER LINE NO. 1

JAMES L. ARNOLD, P.E. - ACTING CITY ENGINEER
 CITY OF WICHITA PROJECT NO. 443-83748

Professional Engineering Consultants, P.A.
 303 S. TOPEKA • WICHITA, KANSAS 67202
 316-262-2691 • FAX 316-262-3003

Designed By: MDK
 Drawn By: JCA

Job No.: 35-04442-001-042
 Date: July 2004

Sheet 4 of 17