
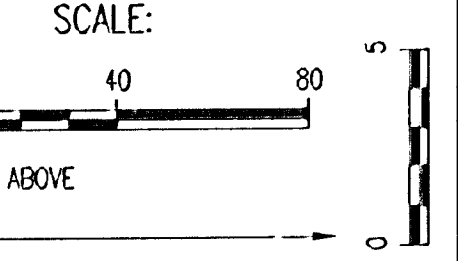



PLAN	CHECKED	DATE

PROFILE	CHECKED	DATE

DSNR: OPER ILS SCALE: 1"=40.00
Q:\2004\0442\001\sspp02 10-05-2004 10:46:29 am

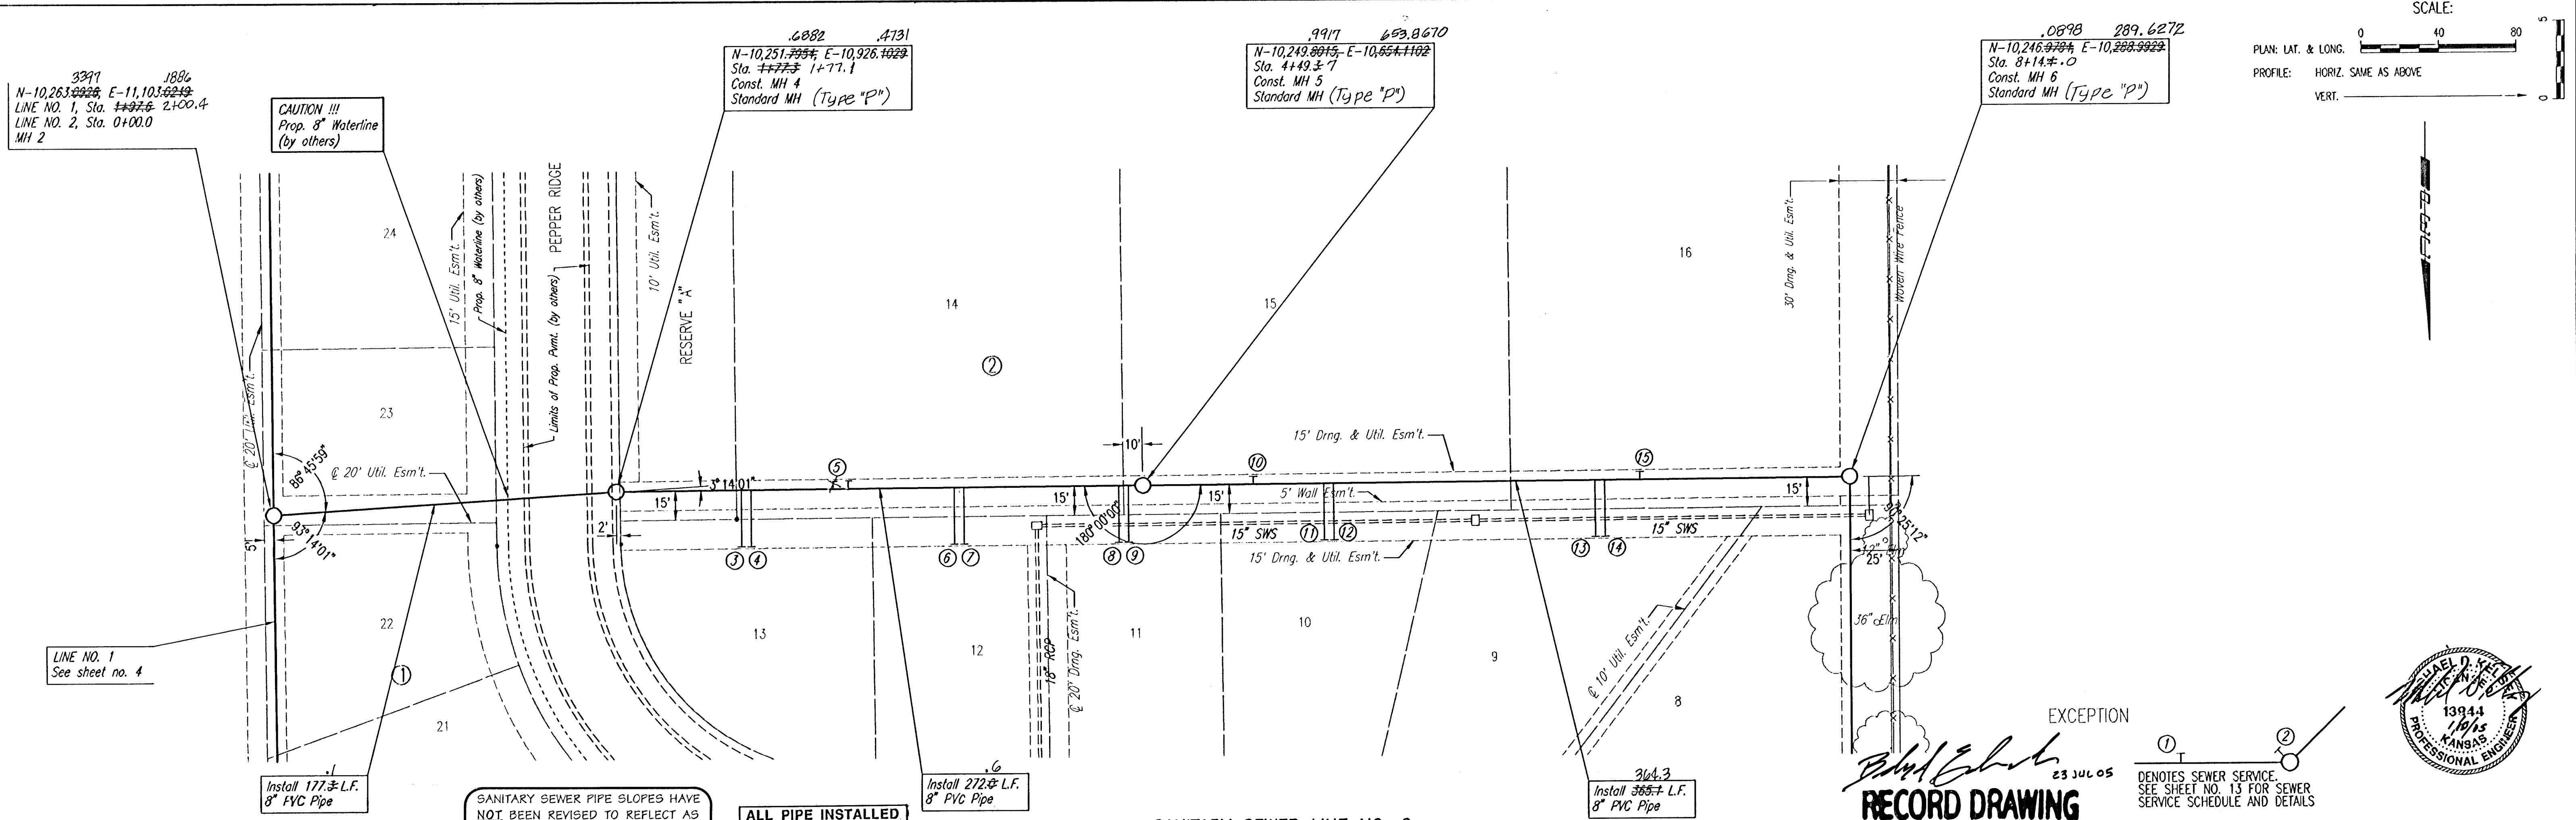

EXCEPTION
23 JUL 05
RECORD DRAWING
DENOTES SEWER SERVICE. SEE SHEET NO. 13 FOR SEWER SERVICE SCHEDULE AND DETAILS

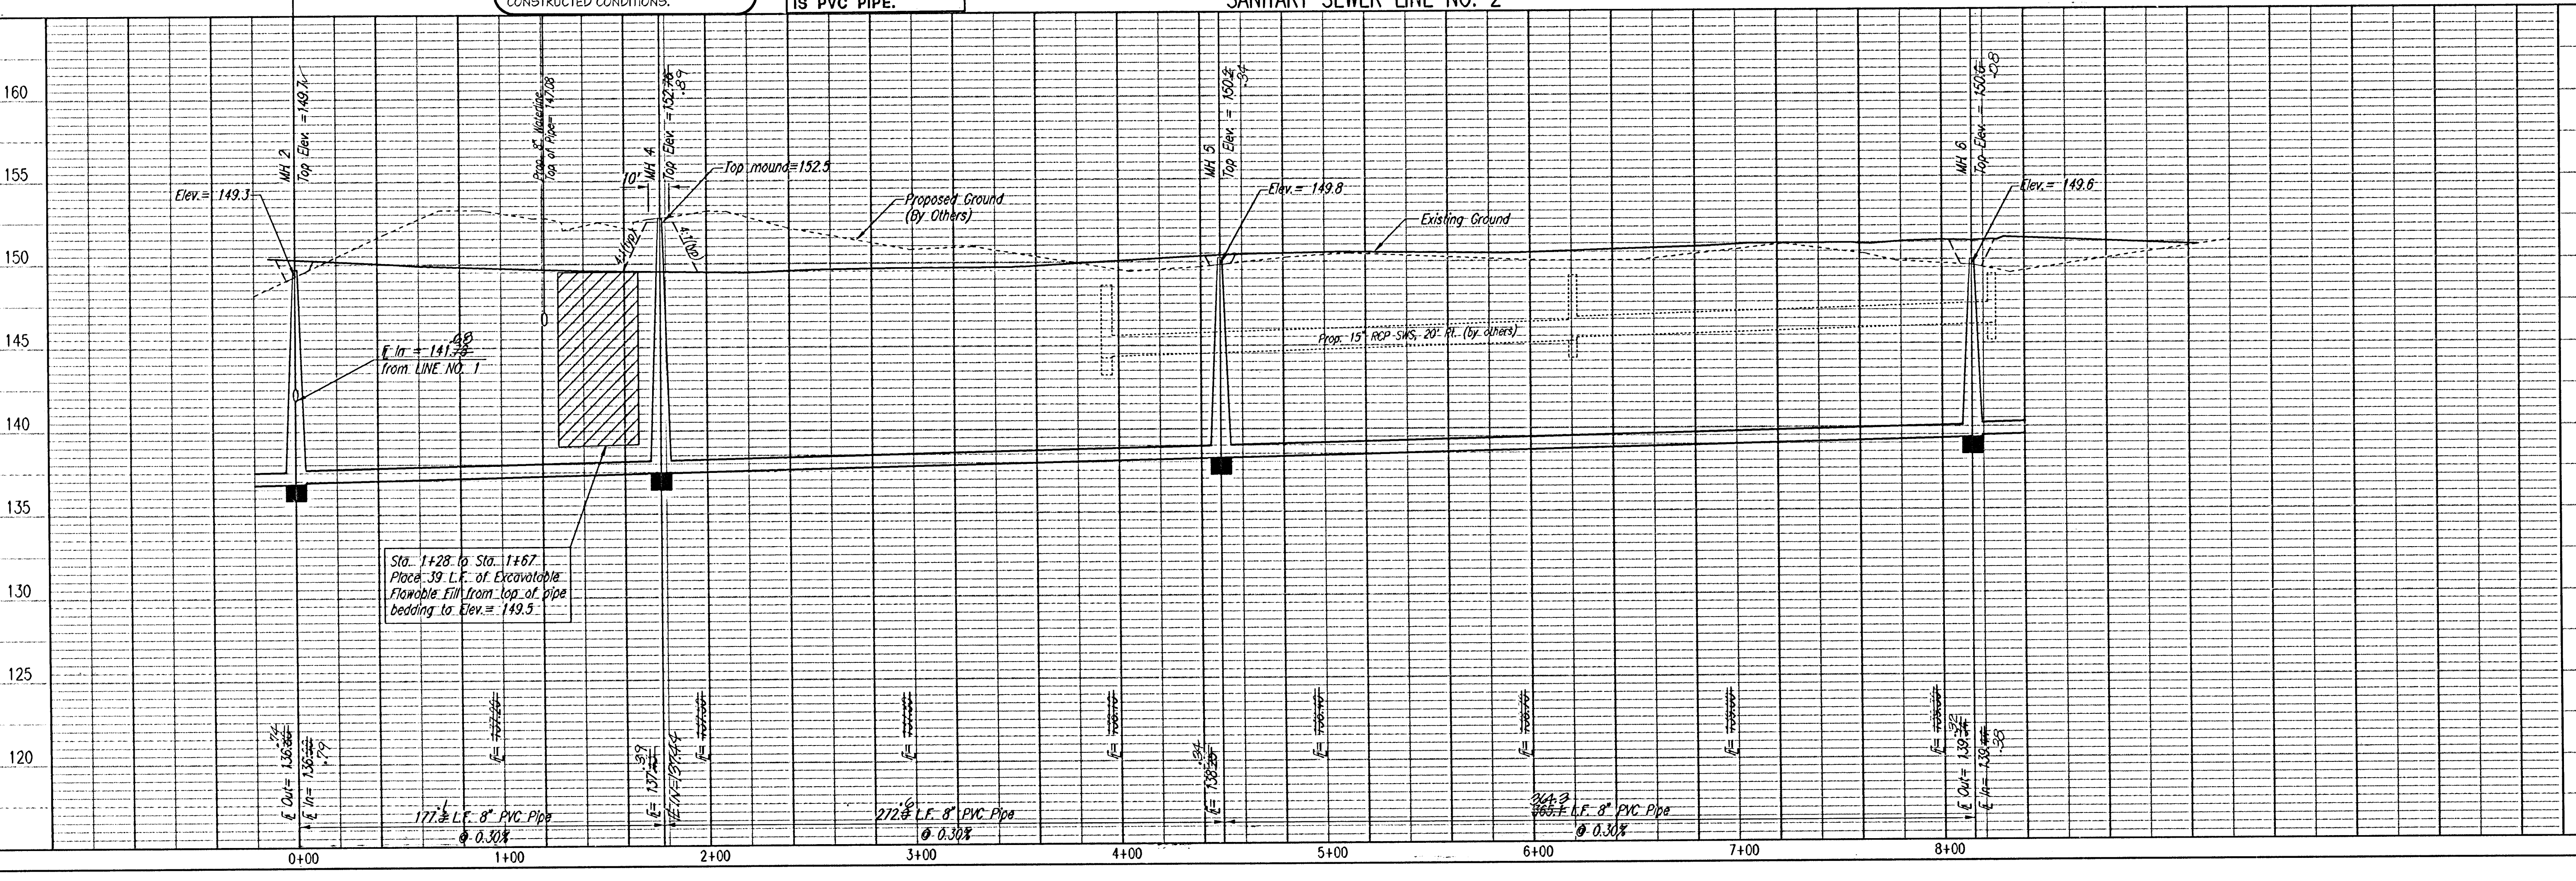

LATERAL 16, MAIN 19 OF THE
SOUTHWEST INTERCEPTOR SEWER

SANITARY SEWER LINE NO. 2

JAMES L. ARMOUR, P.E. - ACTING CITY ENGINEER
CITY OF WICHITA PROJECT NO. 488-5725

Professional Engineering Consultants, P.A.
303 S. TOPEKA • WICHITA, KANSAS 67202
316-262-2691 • FAX 316-262-3003

Designed By: MDK
Drawn By: JCA
Job No.: 35-04442-001-042
Date: July 2004

Sheet 5 of 17