
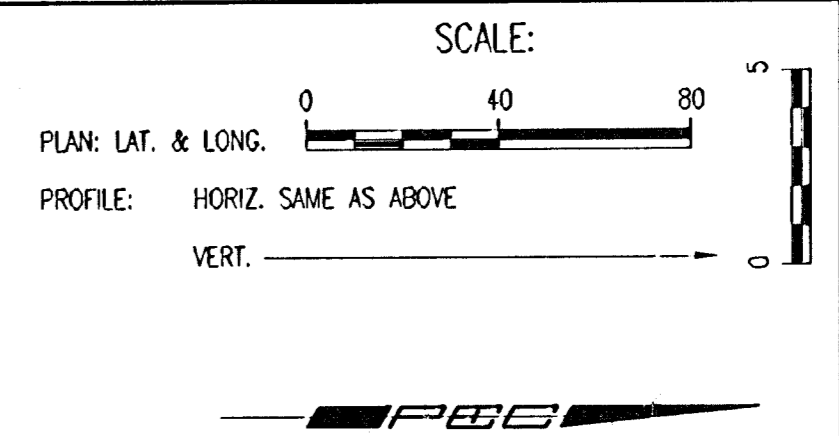



PLAN	CHECKED	DATE
	CHECKED	

PROFILE	CHECKED	DATE
	CHECKED	

DSNR: OPER. ILS SCALE: 1=40.00
 Q:\2004\04442\001\sspp03 08-27-2004 02:25:27 pm

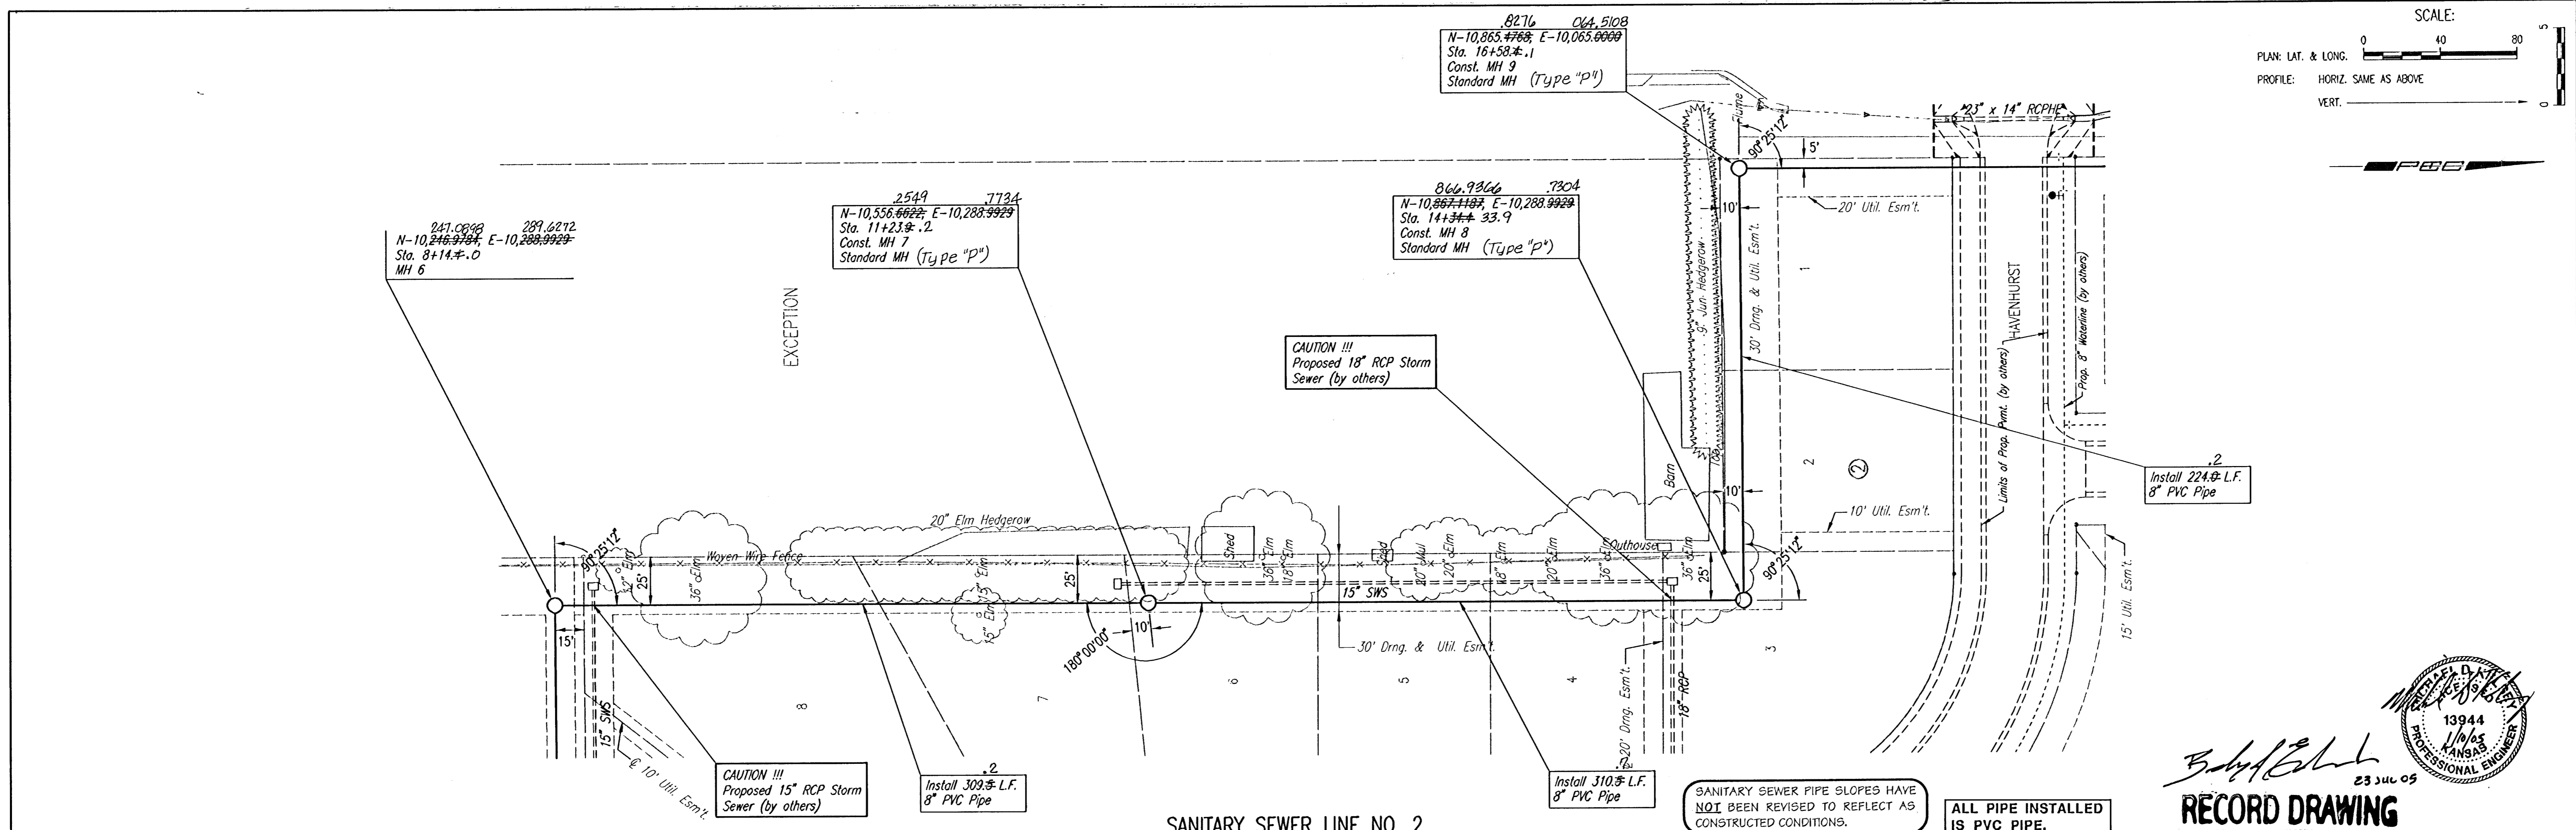

SANITARY SEWER LINE NO. 2

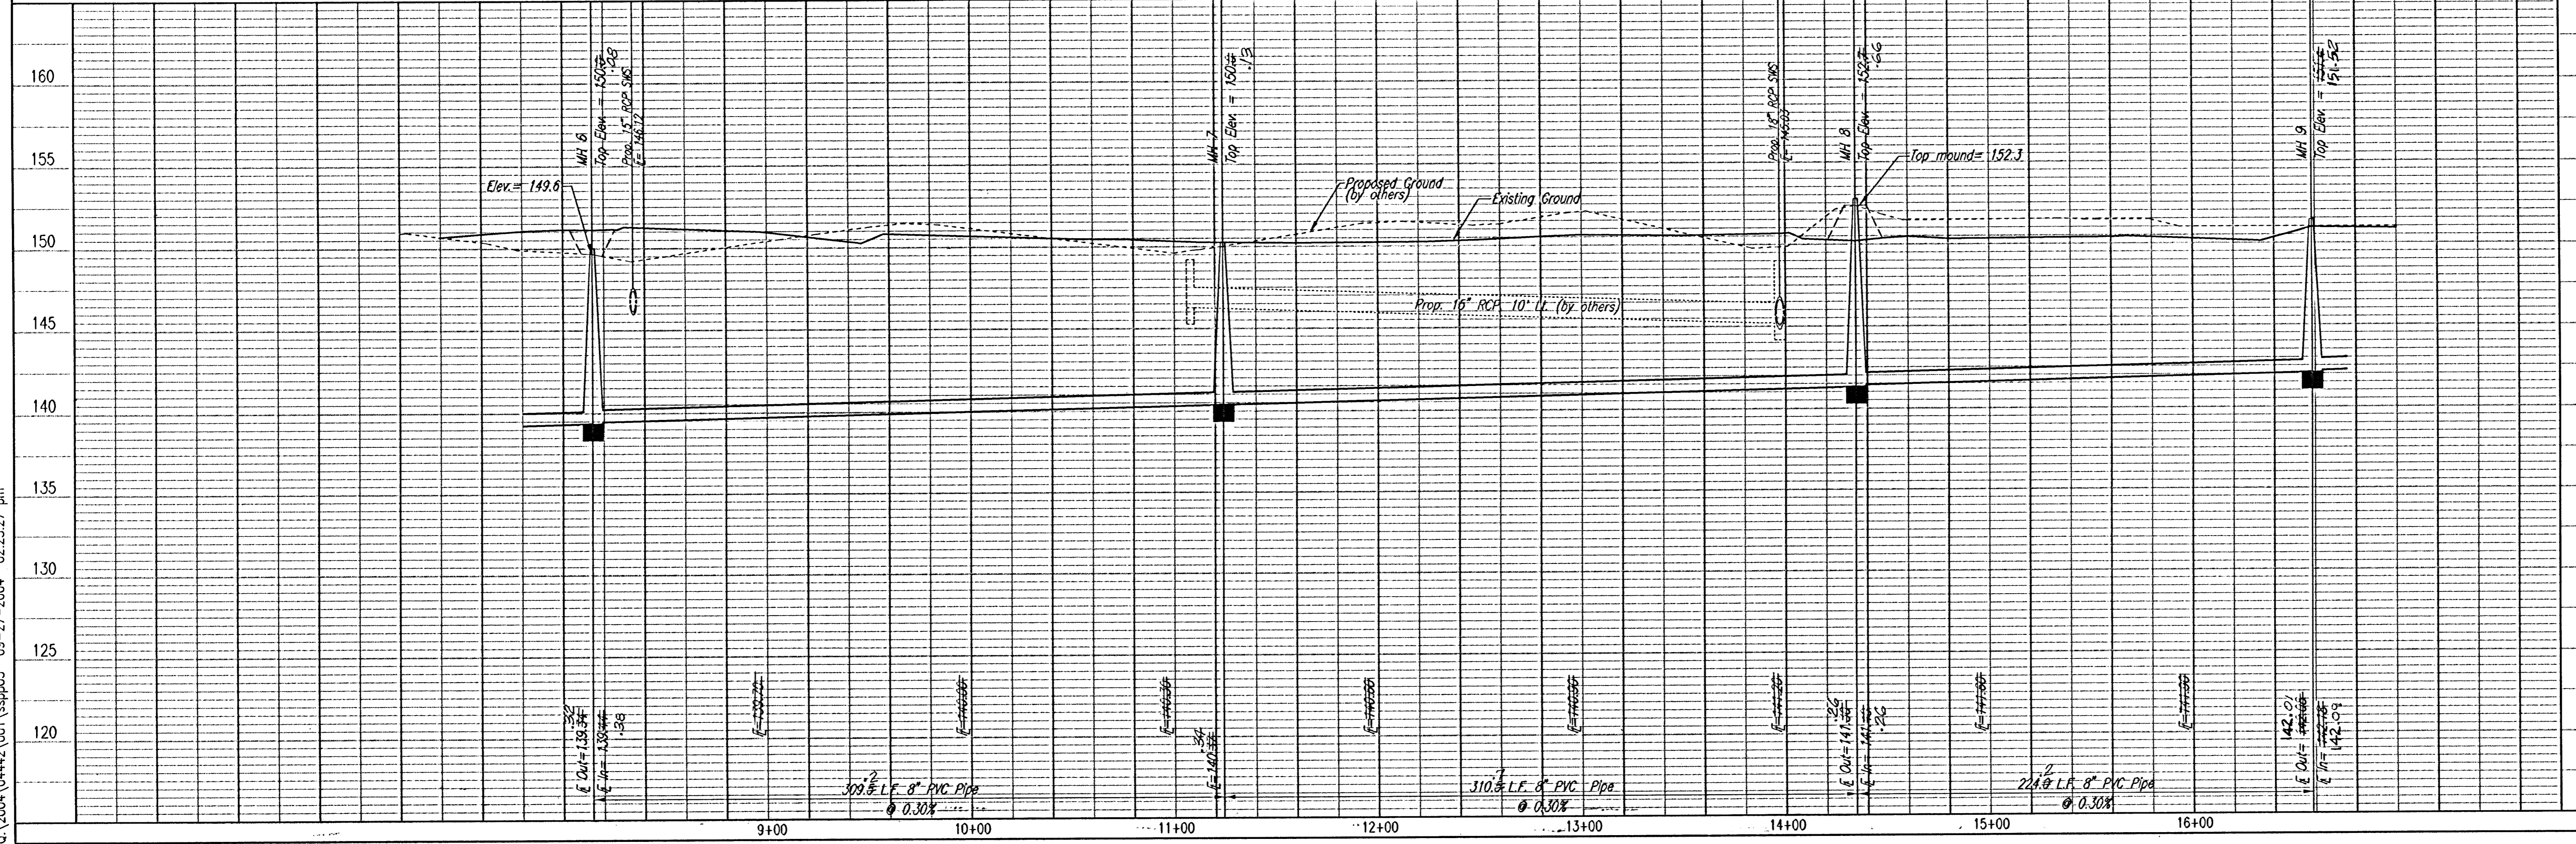

SANITARY SEWER PIPE SLOPES HAVE NOT BEEN REVISED TO REFLECT AS CONSTRUCTED CONDITIONS.
 ALL PIPE INSTALLED IS PVC PIPE.

James L. Armour
 23 JUL 05
RECORD DRAWING
 13944
 1/6/05
 KANSAS
 PROFESSIONAL ENGINEER

Professional Engineering Consultants, P.A.
 503 S. TORRESA AVENUE, WICHITA, KANSAS 67202
 316-262-2891 • FAX 316-262-3003

Job No. 35-04442-001-042
 Date July 2004

Designed By MDK
 Drawn By JCA

LATERAL 16, MAIN 19 OF THE
 SOUTHWEST INTERCEPTOR SEWER
 SANITARY SEWER LINE NO. 2
 JAMES L. ARMOUR, P.E., ACTING CITY ENGINEER
 CITY OF WICHITA PROJECT NO. 442-8748