
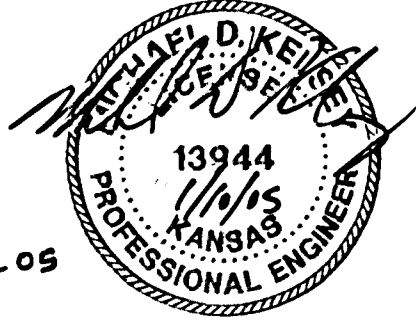


PLAN	CHECKED	DATE

PROFILE	CHECKED	DATE

DSNR: OPER. ILS SCALE: 1"=40.00
Q:\2004\04442\001\sspp04 08-27-2004 02:26:51 pm

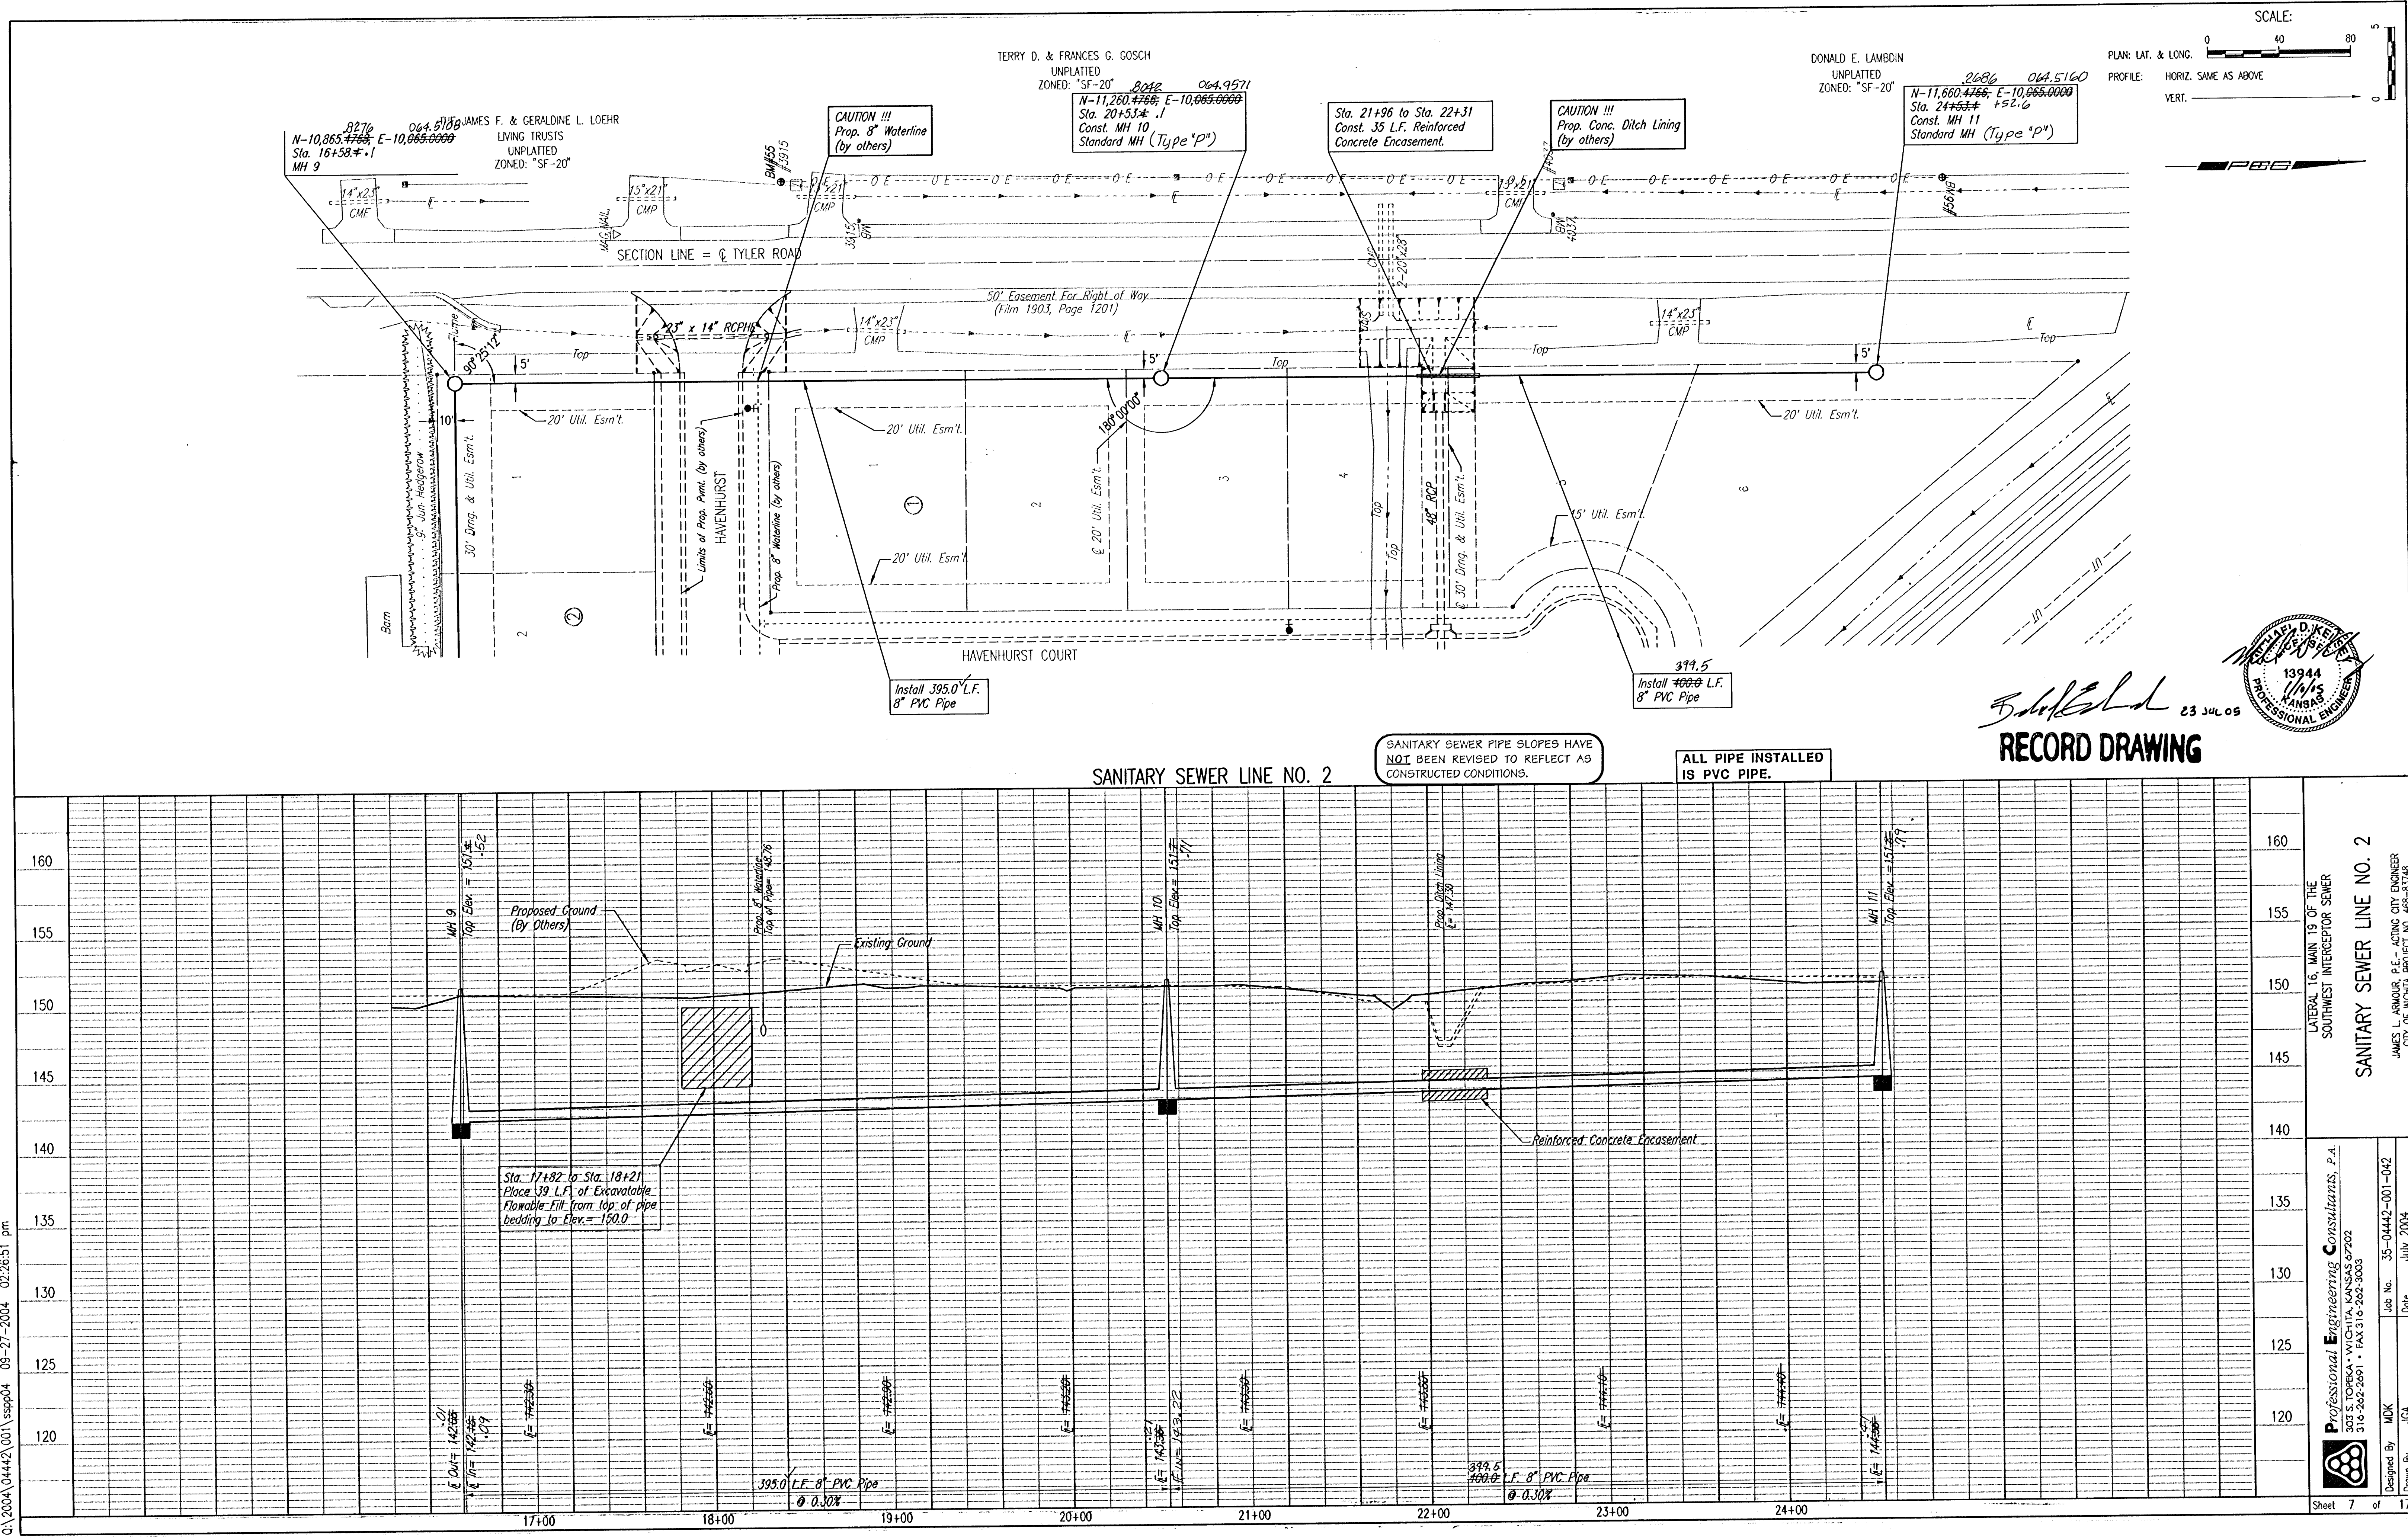

RECORD DRAWING
23 JUL 05

SANITARY SEWER LINE NO. 2
LATERAL 16, MAIN 19 OF THE
SOUTHWEST INTERCEPTOR SEWER
JAMES L. ARMOUR, P.E. - ACTING CITY ENGINEER
CITY OF WICHITA PROJECT NO. 455-83748

Professional Engineering Consultants, P.A.
303 S. TOPKA • WICHITA, KANSAS 67202
316-262-2691 • FAX 316-362-3063
Designed By: MDK
Drawn By: JCA
Job No.: 35-04442-001-042
Date: July 2004